

Teeple Architects INC.

Reviewed
Reviewed as noted

Revise and resubmit
Not Reviewed

Date:


Aug 9/15

Reviewed by:

M. Baum

This review by Teeple Architects Inc. is for the sole purpose of ascertaining conformance with the general design concept. This review shall not mean that Teeple Architects Inc. approves the detailed design inherent in the shop drawings, responsibility for which shall remain with the Contractor submitting same, and such review shall not relieve the Contractor of the responsibility for errors or omissions in the shop drawings or of the responsibility for meeting all requirements of the Contract Documents. The Contractor is responsible for dimensions to be confirmed and correlated at the job site, for information that pertains solely to fabrication processes or to techniques of construction and installation, and for coordination of the work of all trades.

Package 4 - Level 3.

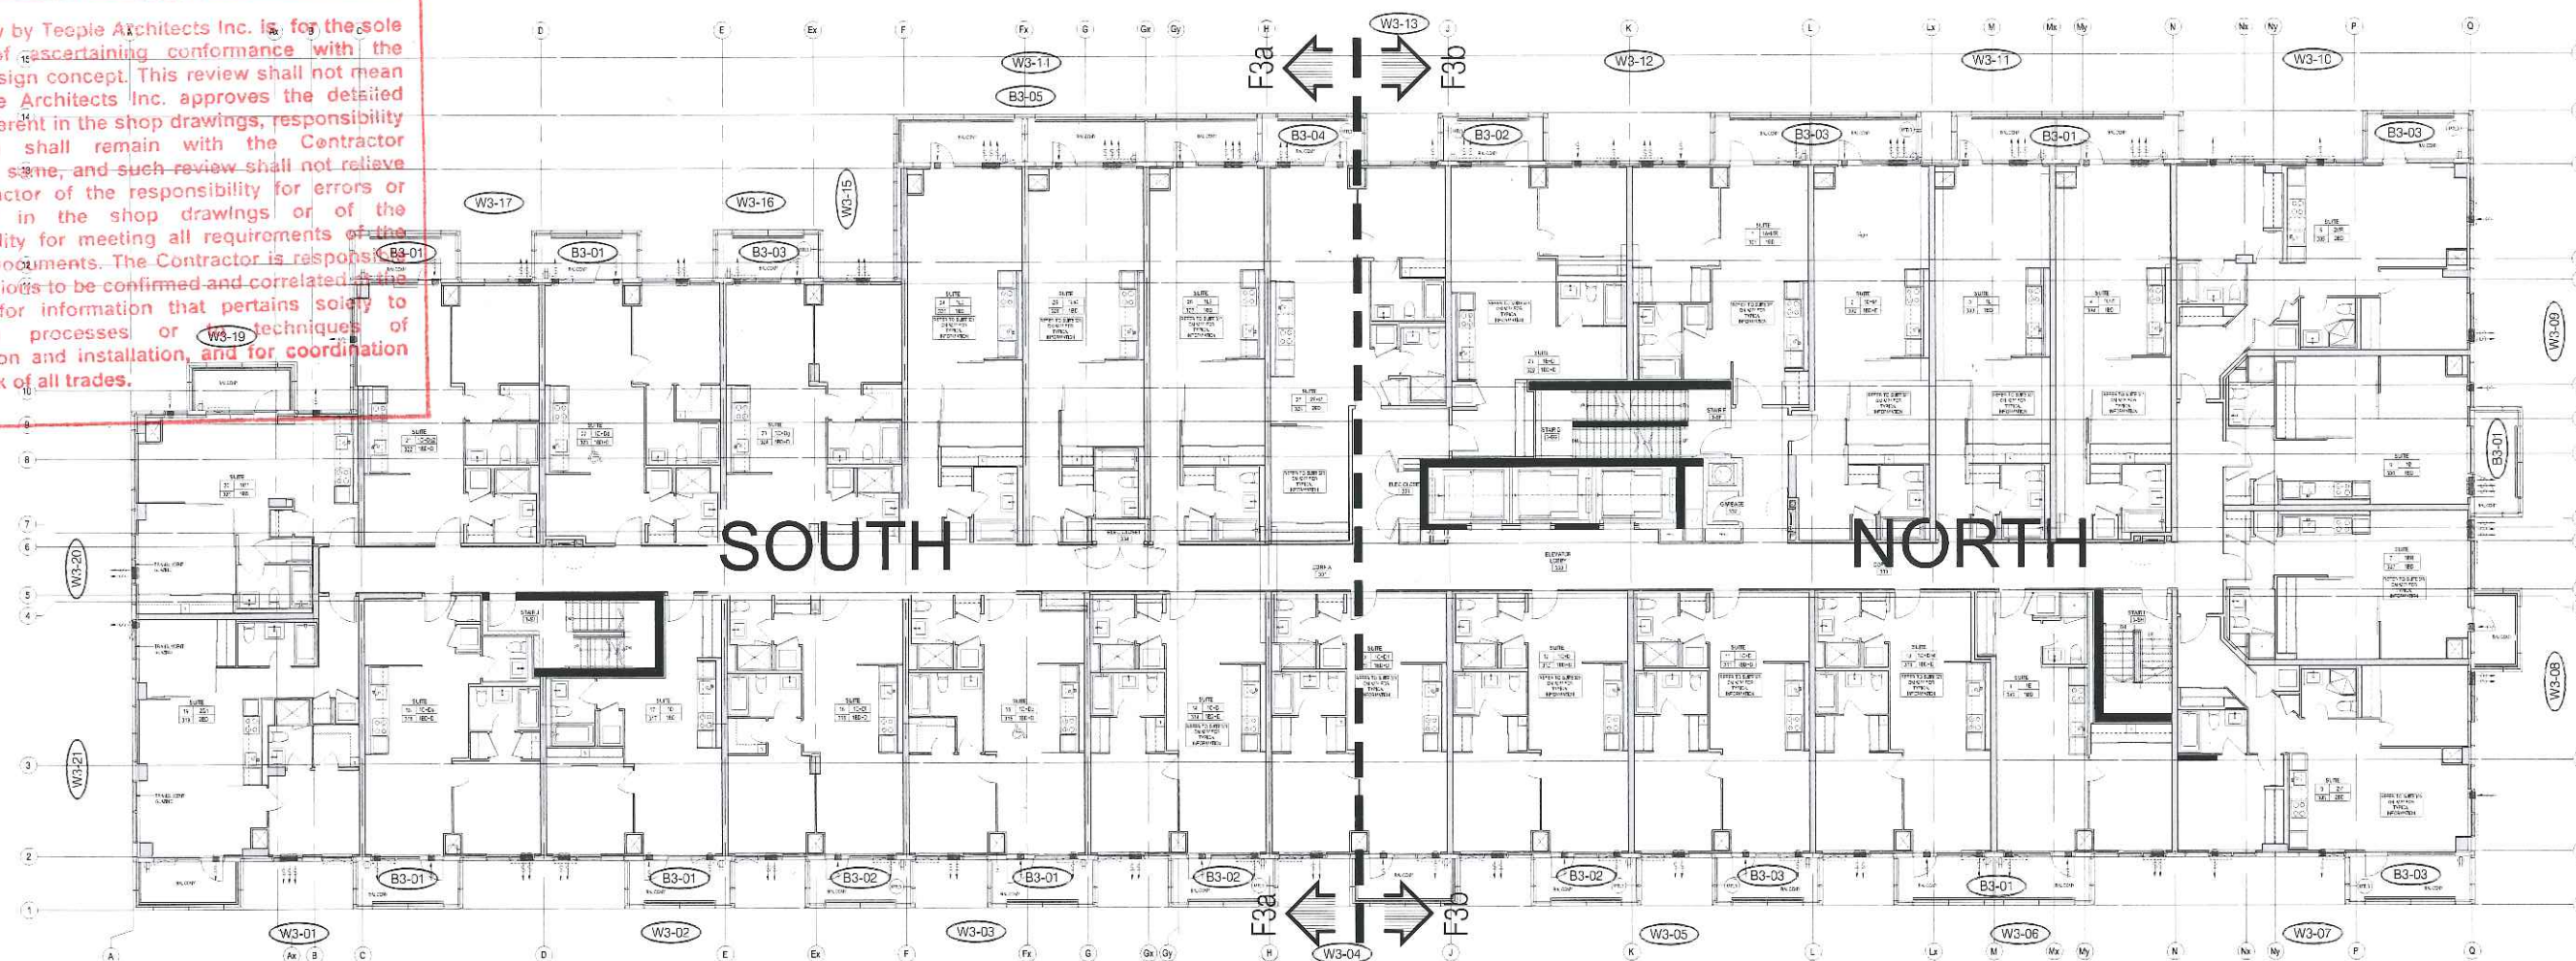

PROJECT NAME: SQ ALEXANDRA PARK - BLOCK11

DRAWING TITLE: 3rd FLOOR KEY PLAN

ARCHITECT: TEEPLE ARCHITECTS

CONTRACTOR: TRIDEL


SCALE: N/T/S

DRAWN BY: S.C.

DATE: MARCH 4, 2015


DRAWING No

F3

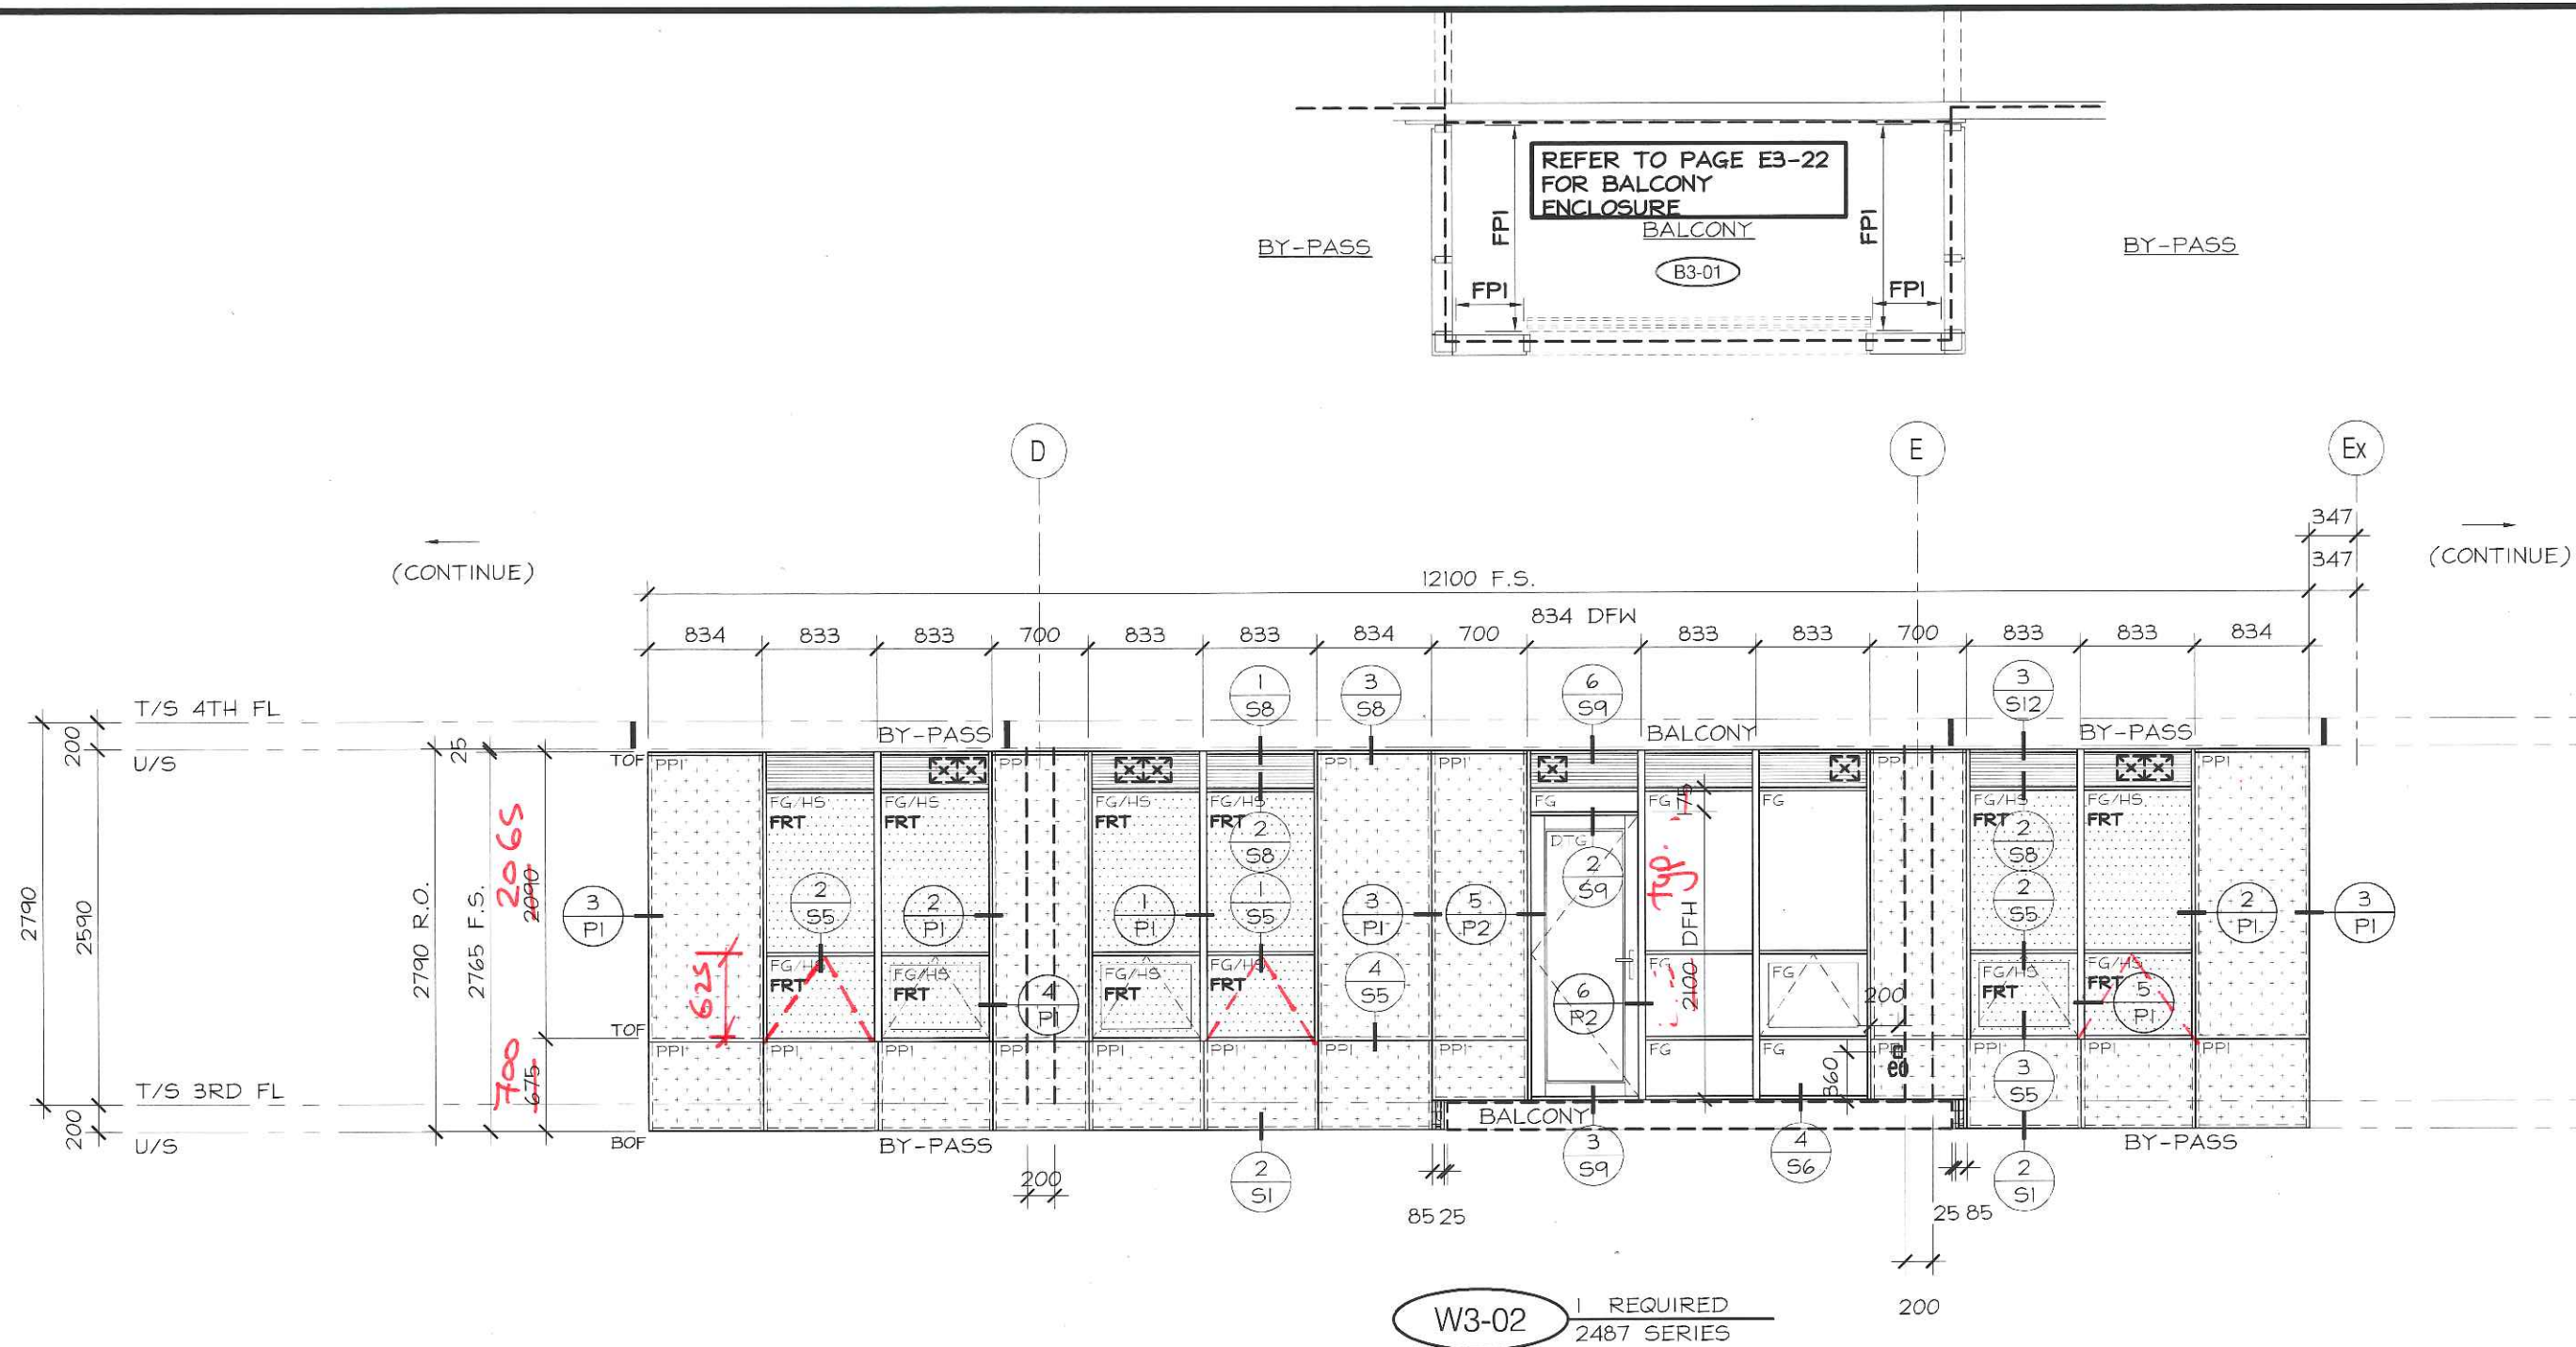


No.	REVISION	BY	DATE

PROJECT NAME:	SQ ALEXANDRA PARK - BLOCK 11
DRAWING TITLE:	3rd FLOOR ELEVATIONS
ARCHITECT:	TEEPLE ARCHITECTS
CONTRACTOR:	TRIDEL
SCALE:	1:50
DRAWN BY:	S.C.
DATE:	MARCH 4, 2015

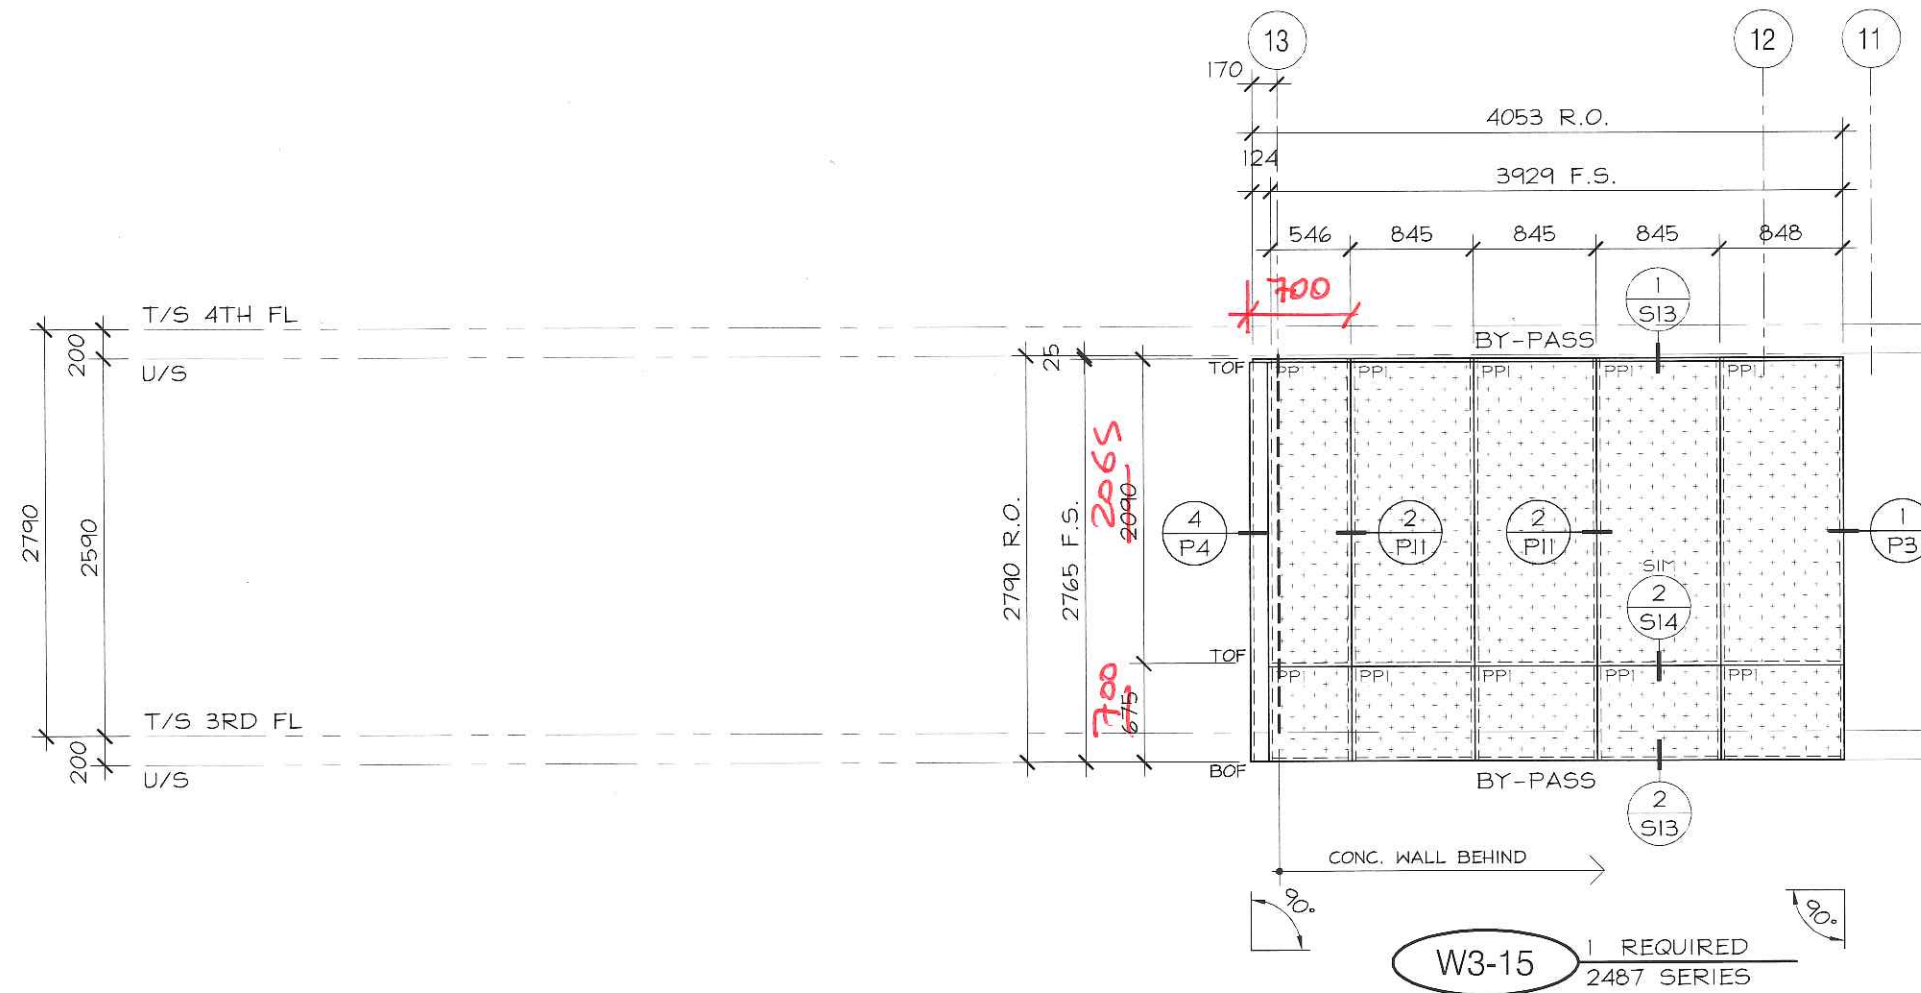



No.	REVISION	BY	DATE

PROJECT NAME:	SQ ALEXANDRA PARK - BLOCK11		
DRAWING TITLE:	3rd FLOOR ELEVATIONS		
ARCHITECT:	TEEPLE ARCHITECTS		
CONTRACTOR:	TRIDEL		
SCALE:	1:50	DRAWN BY:	S.C.
DATE:	MARCH 4, 2015	DRAWING No.:	E3-15

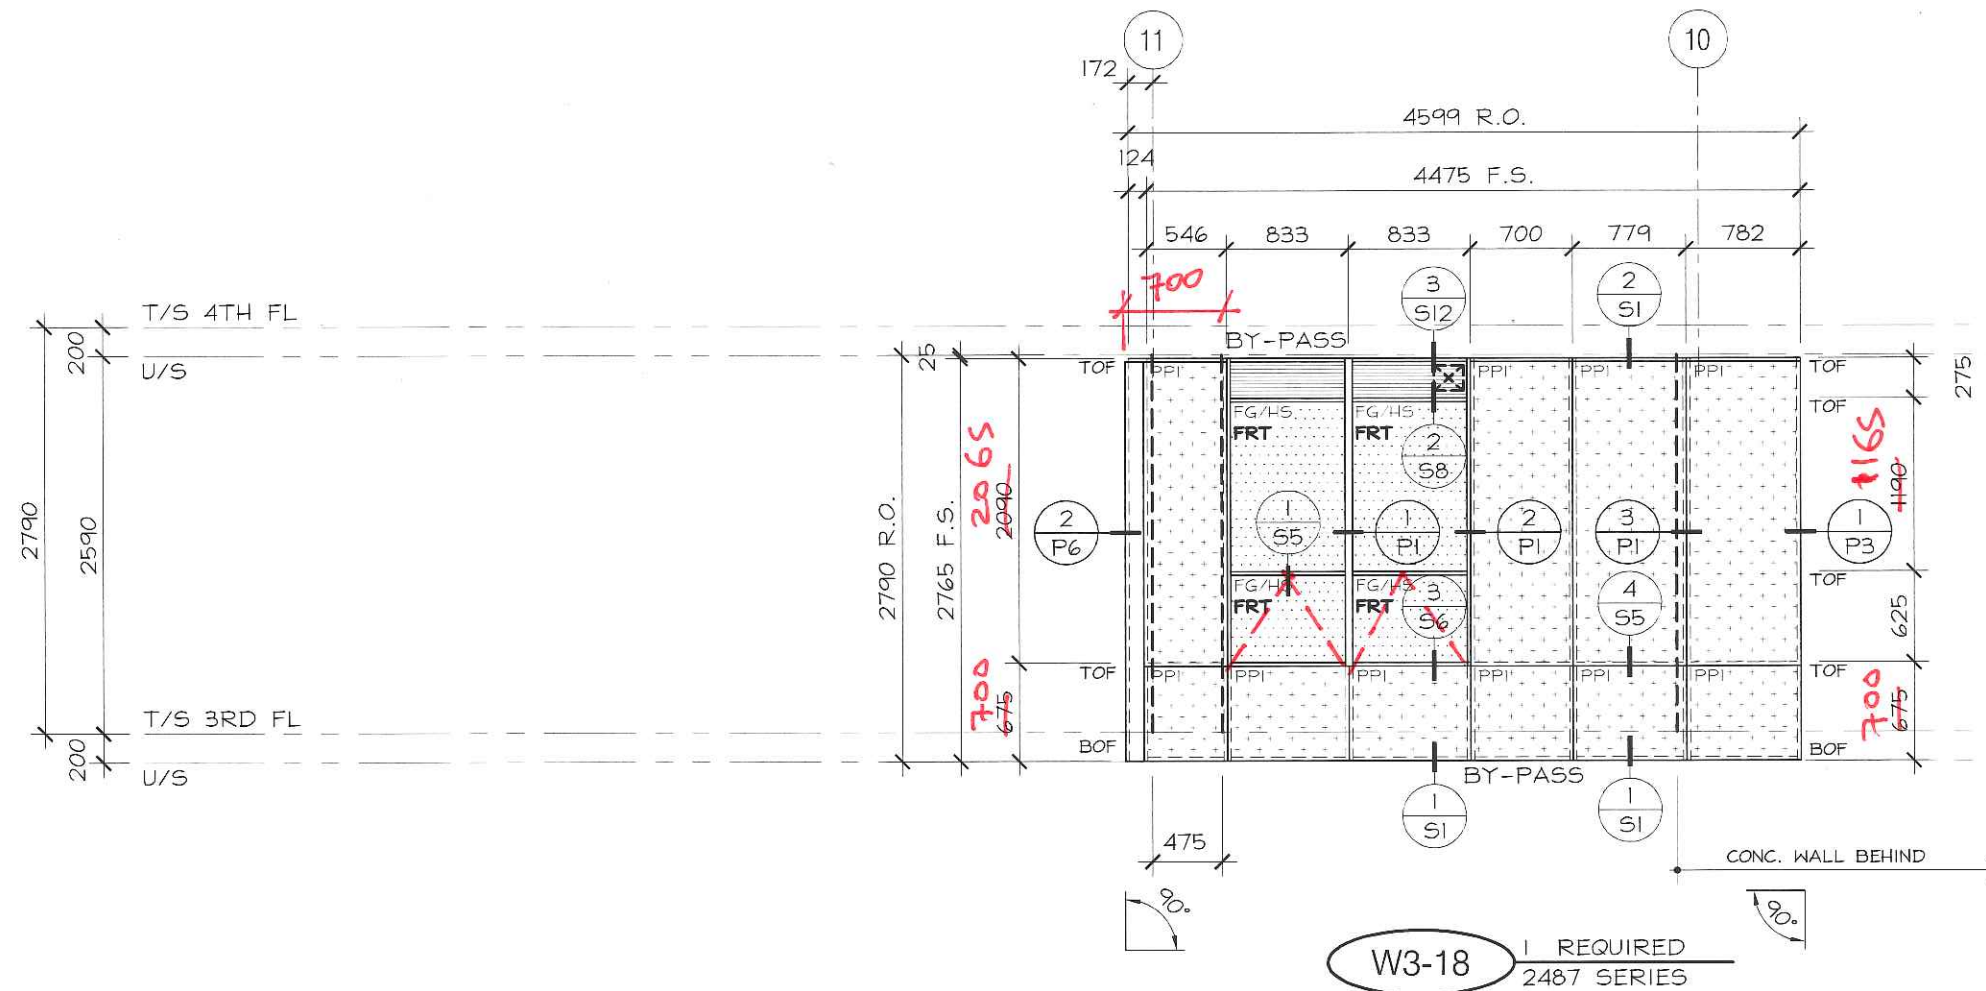


No.	REVISION	BY	DATE

PROJECT NAME:	SQ ALEXANDRA PARK - BLOCK11		
DRAWING TITLE:	3rd FLOOR ELEVATIONS		
ARCHITECT:	TEEPLE ARCHITECTS		
CONTRACTOR:	TRIDEL		
SCALE:	1:50	DRAWN BY:	S.C.
DATE:	MARCH 4, 2015	DRAWING No.:	E3-18

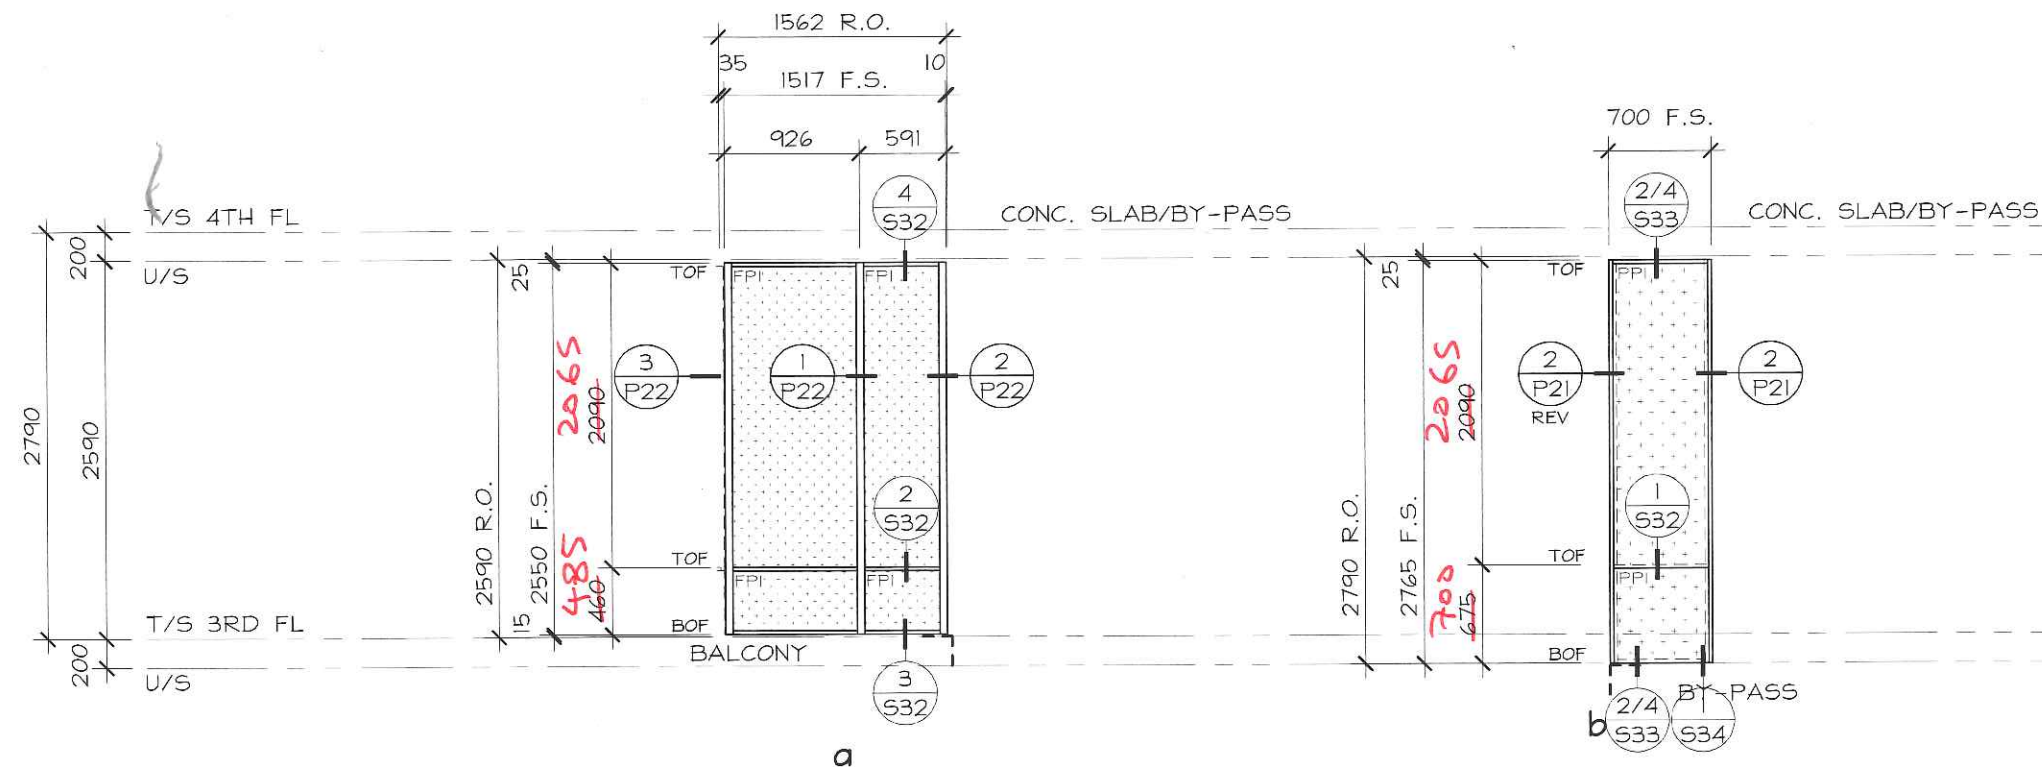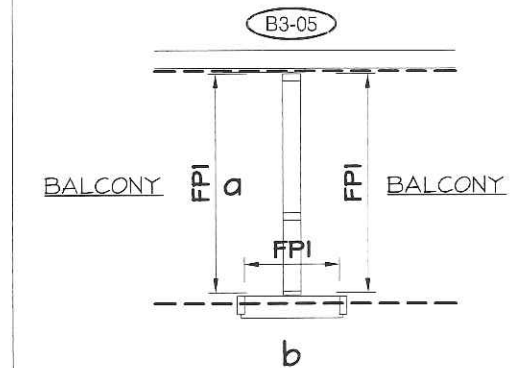

B3-05

1 REQUIRED
2487 SERIES
EXT. FINISH: PPG ACRYNAR PLATINUM UCFXIII85
INT. FINISH: PPG ACRYNAR PLATINUM UCFXIII85

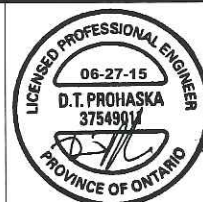

No.	REVISION	BY	DATE

PROJECT NAME:	SQ ALEXANDRA PARK - BLOCK11
DRAWING TITLE:	3rd FLOOR ELEVATIONS
ARCHITECT:	TEEPLE ARCHITECTS
CONTRACTOR:	TRIDEL
SCALE:	1:50
DRAWN BY:	S.C.
DATE:	MARCH 4, 2015
DRAWING No.:	E3-26