

Teeple Architects INC.


Package 8 - Level 7

Reviewed
Reviewed as noted

Revise and resubmit
Not Reviewed

Date: Aug 9/18
Reviewed by: M. Bann

This review by Teeple Architects Inc. is for the sole purpose of ascertaining conformance with the general design concept. This review shall not mean that Teeple Architects Inc. approves the detailed design inherent in the shop drawings, responsibility for which shall remain with the Contractor submitting same, and such review shall not relieve the Contractor of the responsibility for errors or omissions in the shop drawings or of the responsibility for meeting all requirements of the Contract Documents. The Contractor is responsible for dimensions to be confirmed and correlated on job site, for information that pertains to the fabrication processes or to technical aspects of construction and installation, and for coordination of the work of all trades.

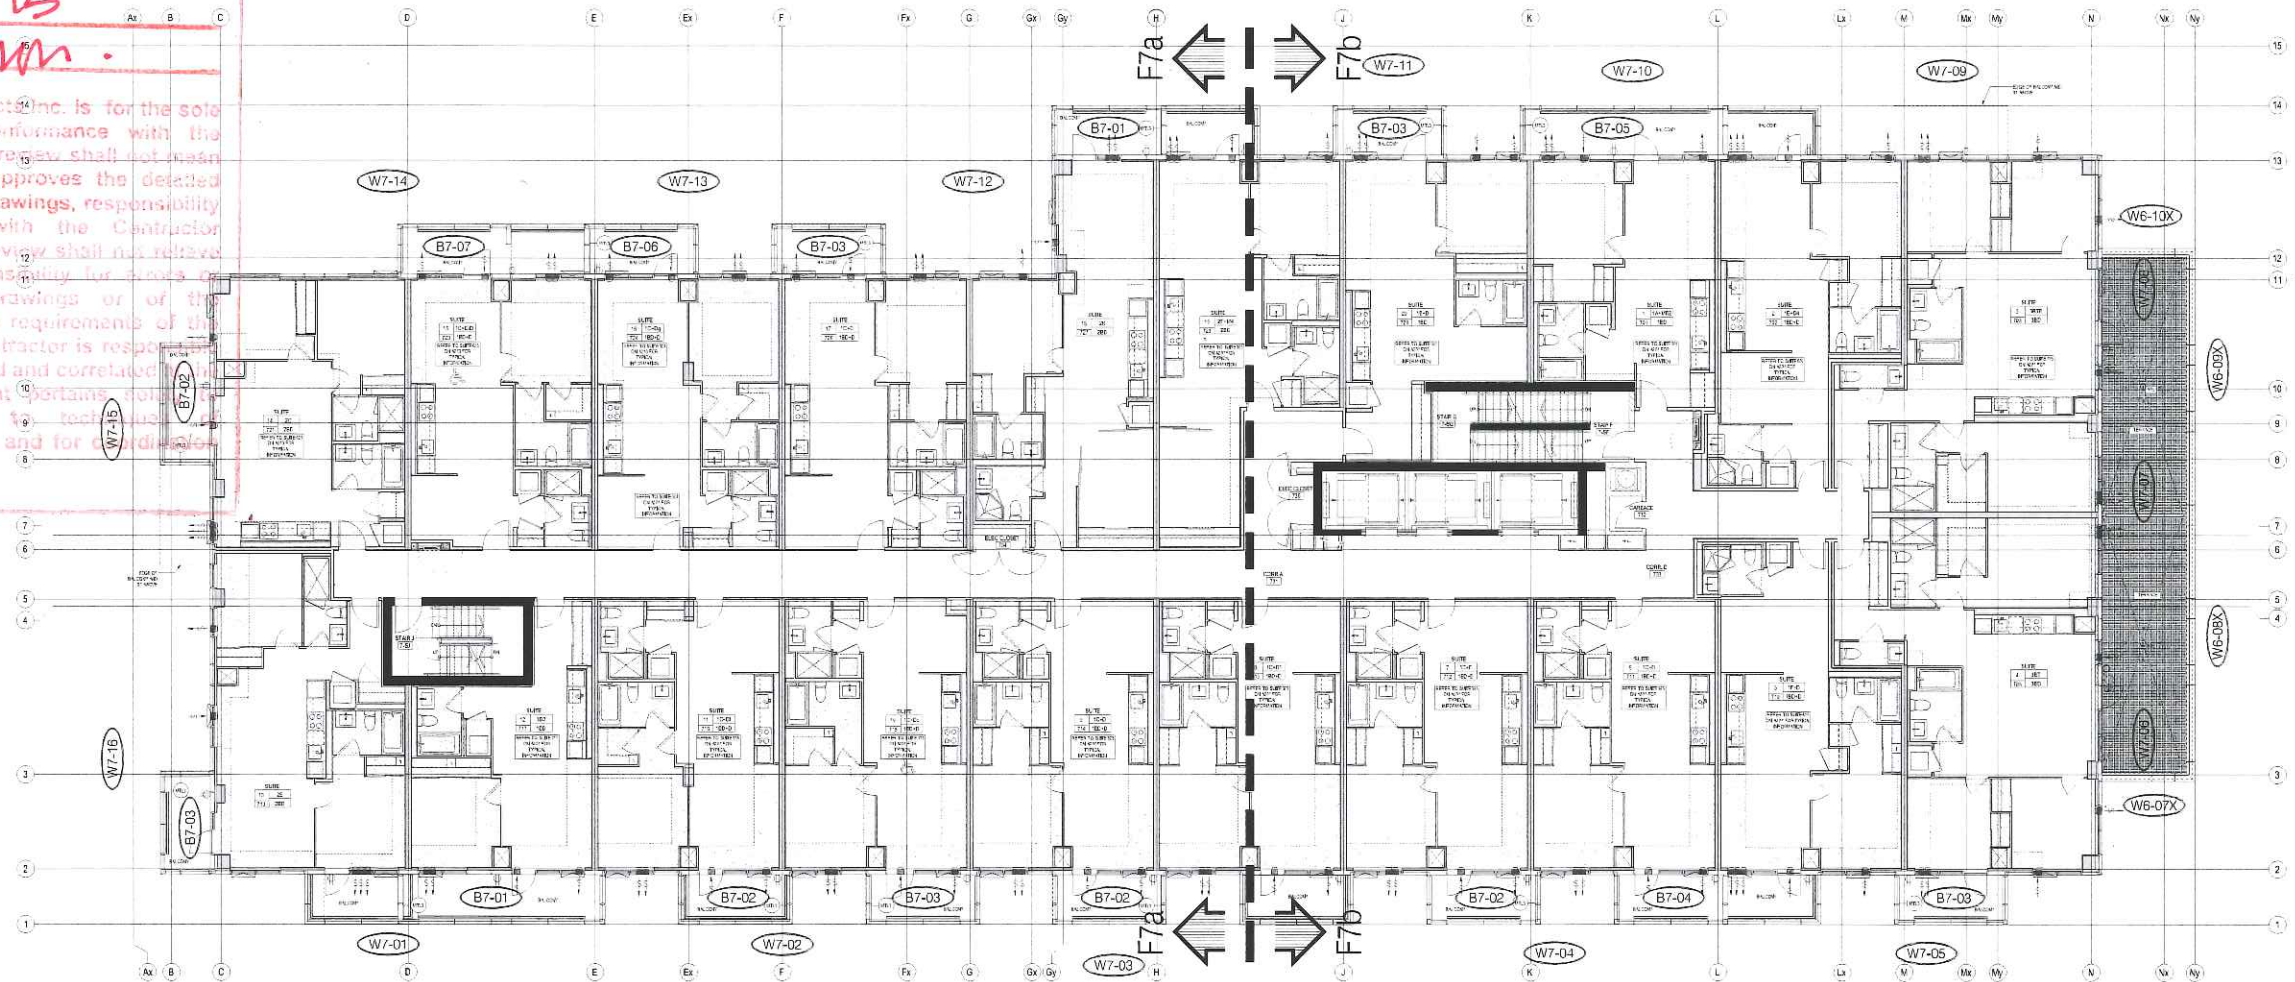

PROJECT NAME: SQ ALEXANDRA PARK - BLOCK11

DRAWING TITLE: 7th FLOOR KEY PLAN

ARCHITECT: TEEPLE ARCHITECTS

CONTRACTOR: TRIDEL


SCALE: N/T/S

DRAWN BY: S.C.

DATE: MARCH 4, 2018


DRAWING No.

F7

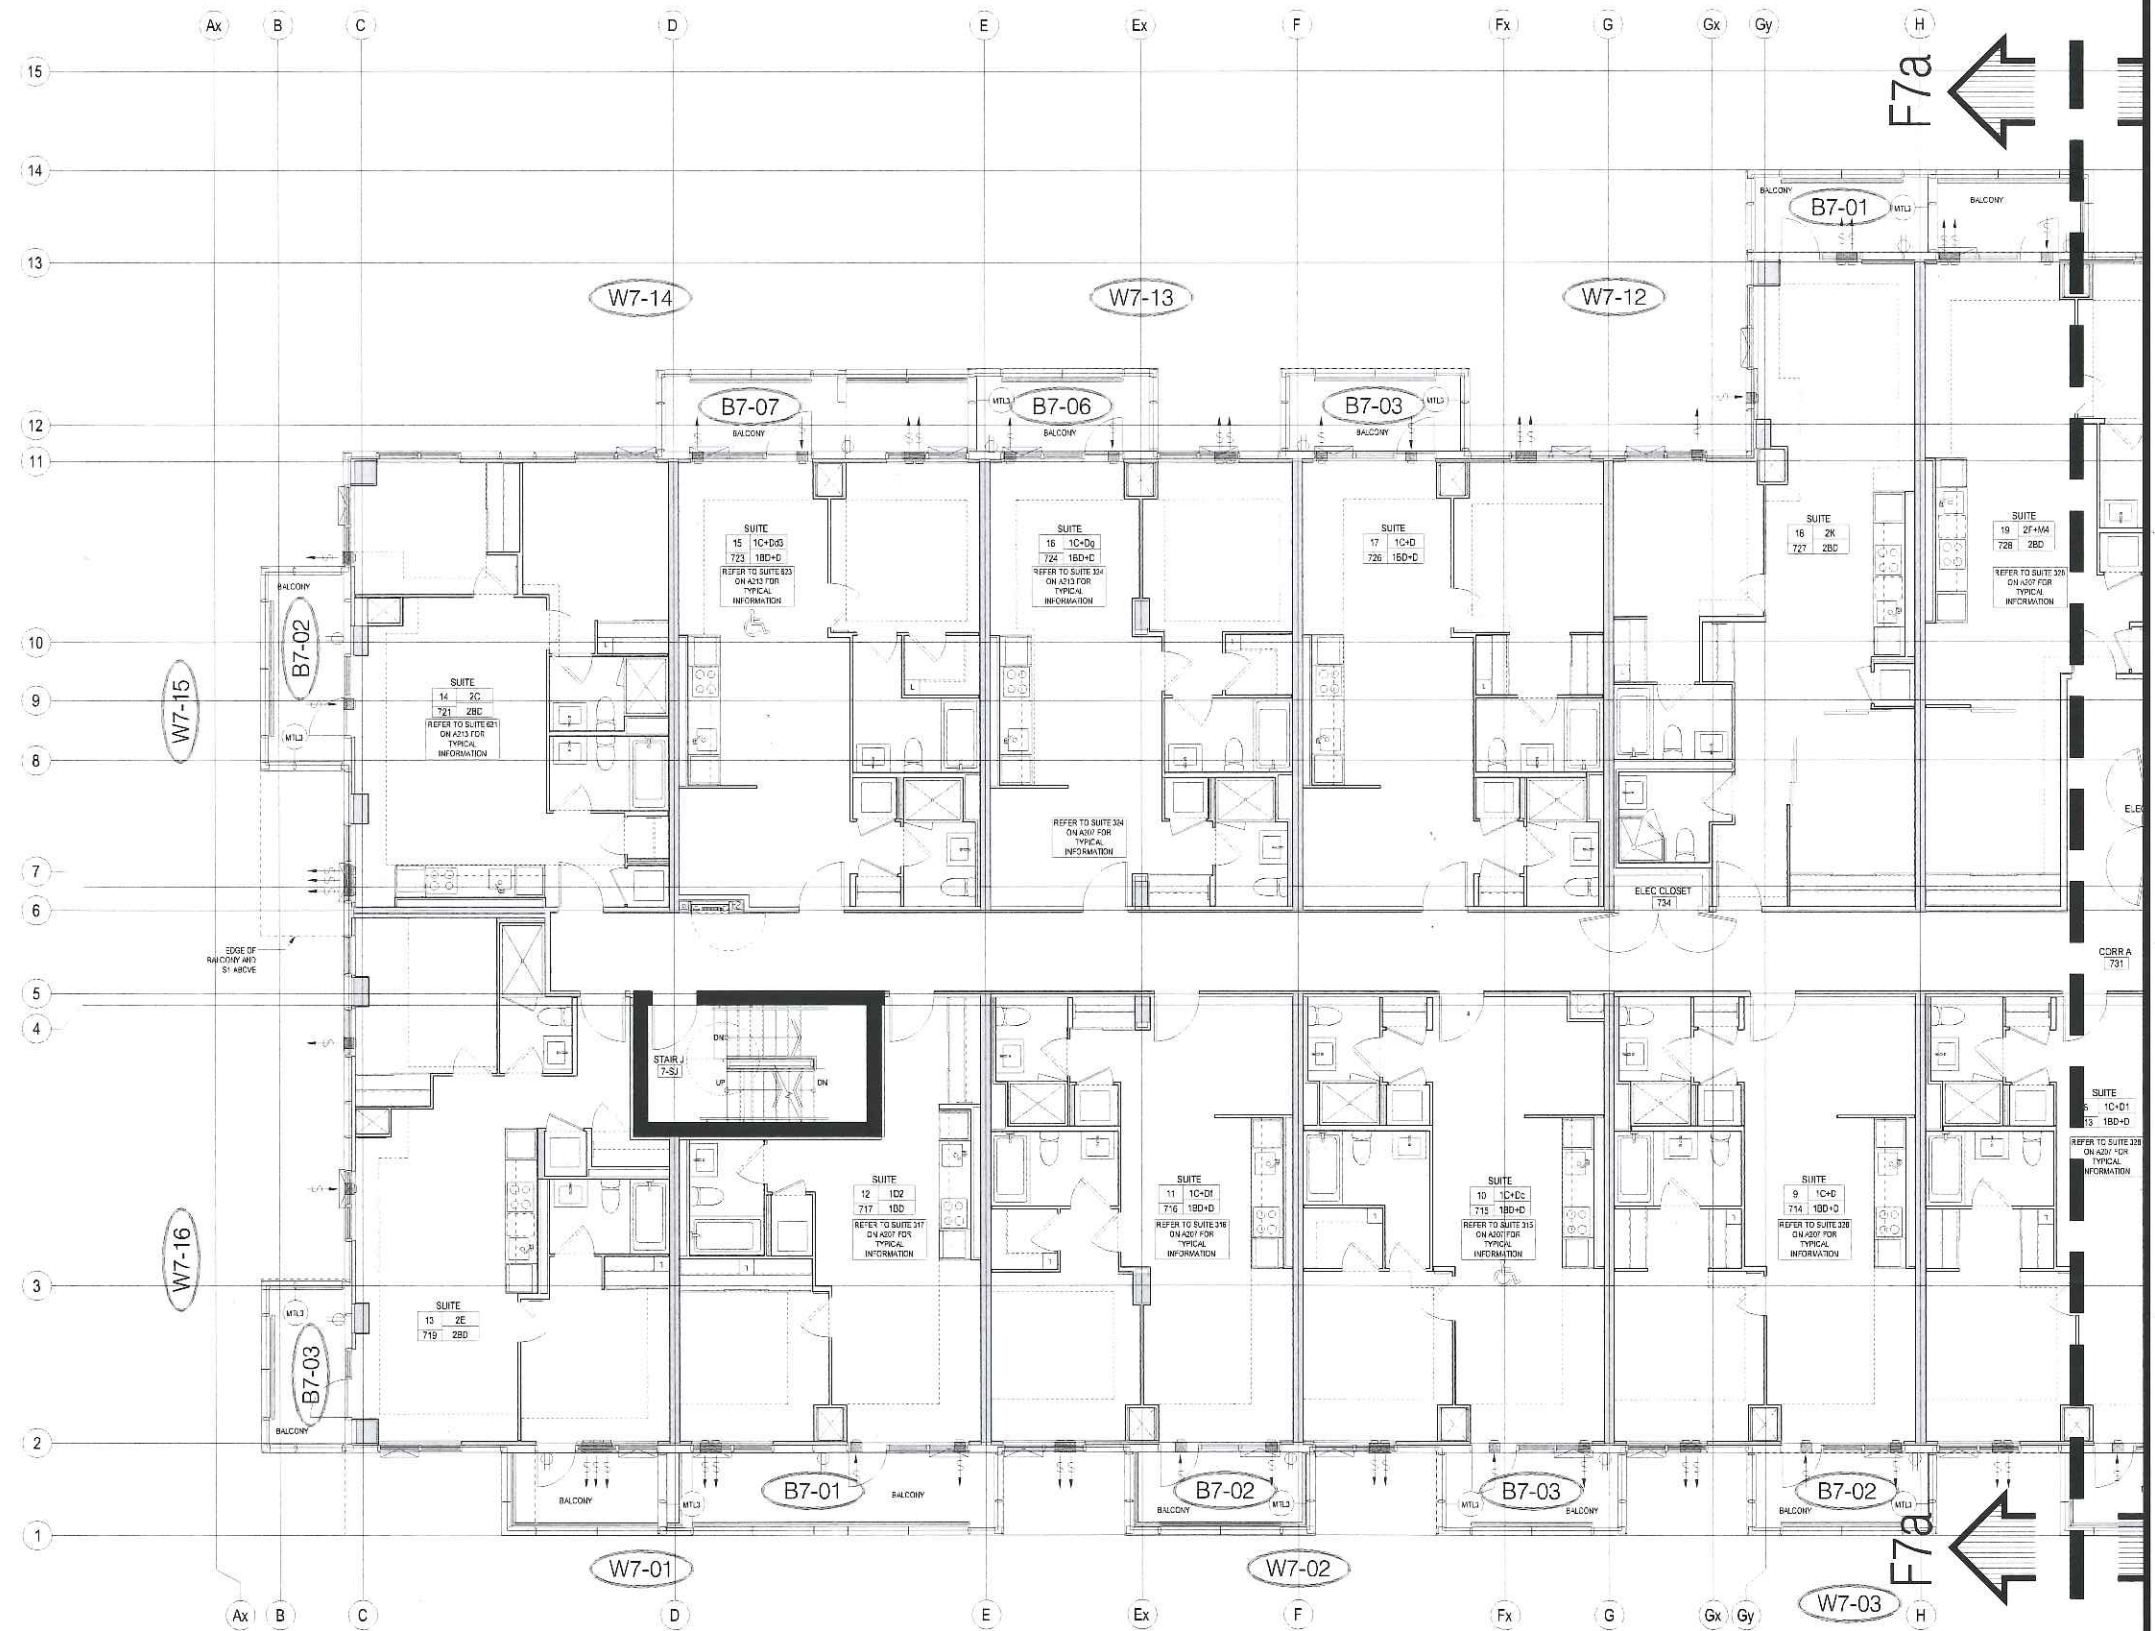


No.	REVISION	BY	DATE

PROJECT NAME:	SQ ALEXANDRA PARK - BLOCK 11		
DRAWING TITLE	7th FLOOR PARTIAL PLAN		
ARCHITECT:	TEEPLE ARCHITECTS		
CONTRACTOR:	TRIDEL		
SCALE:	N/T/S	DRAWN BY:	SC
DATE:	MARCH 4, 2015	DRAWING No:	F7a

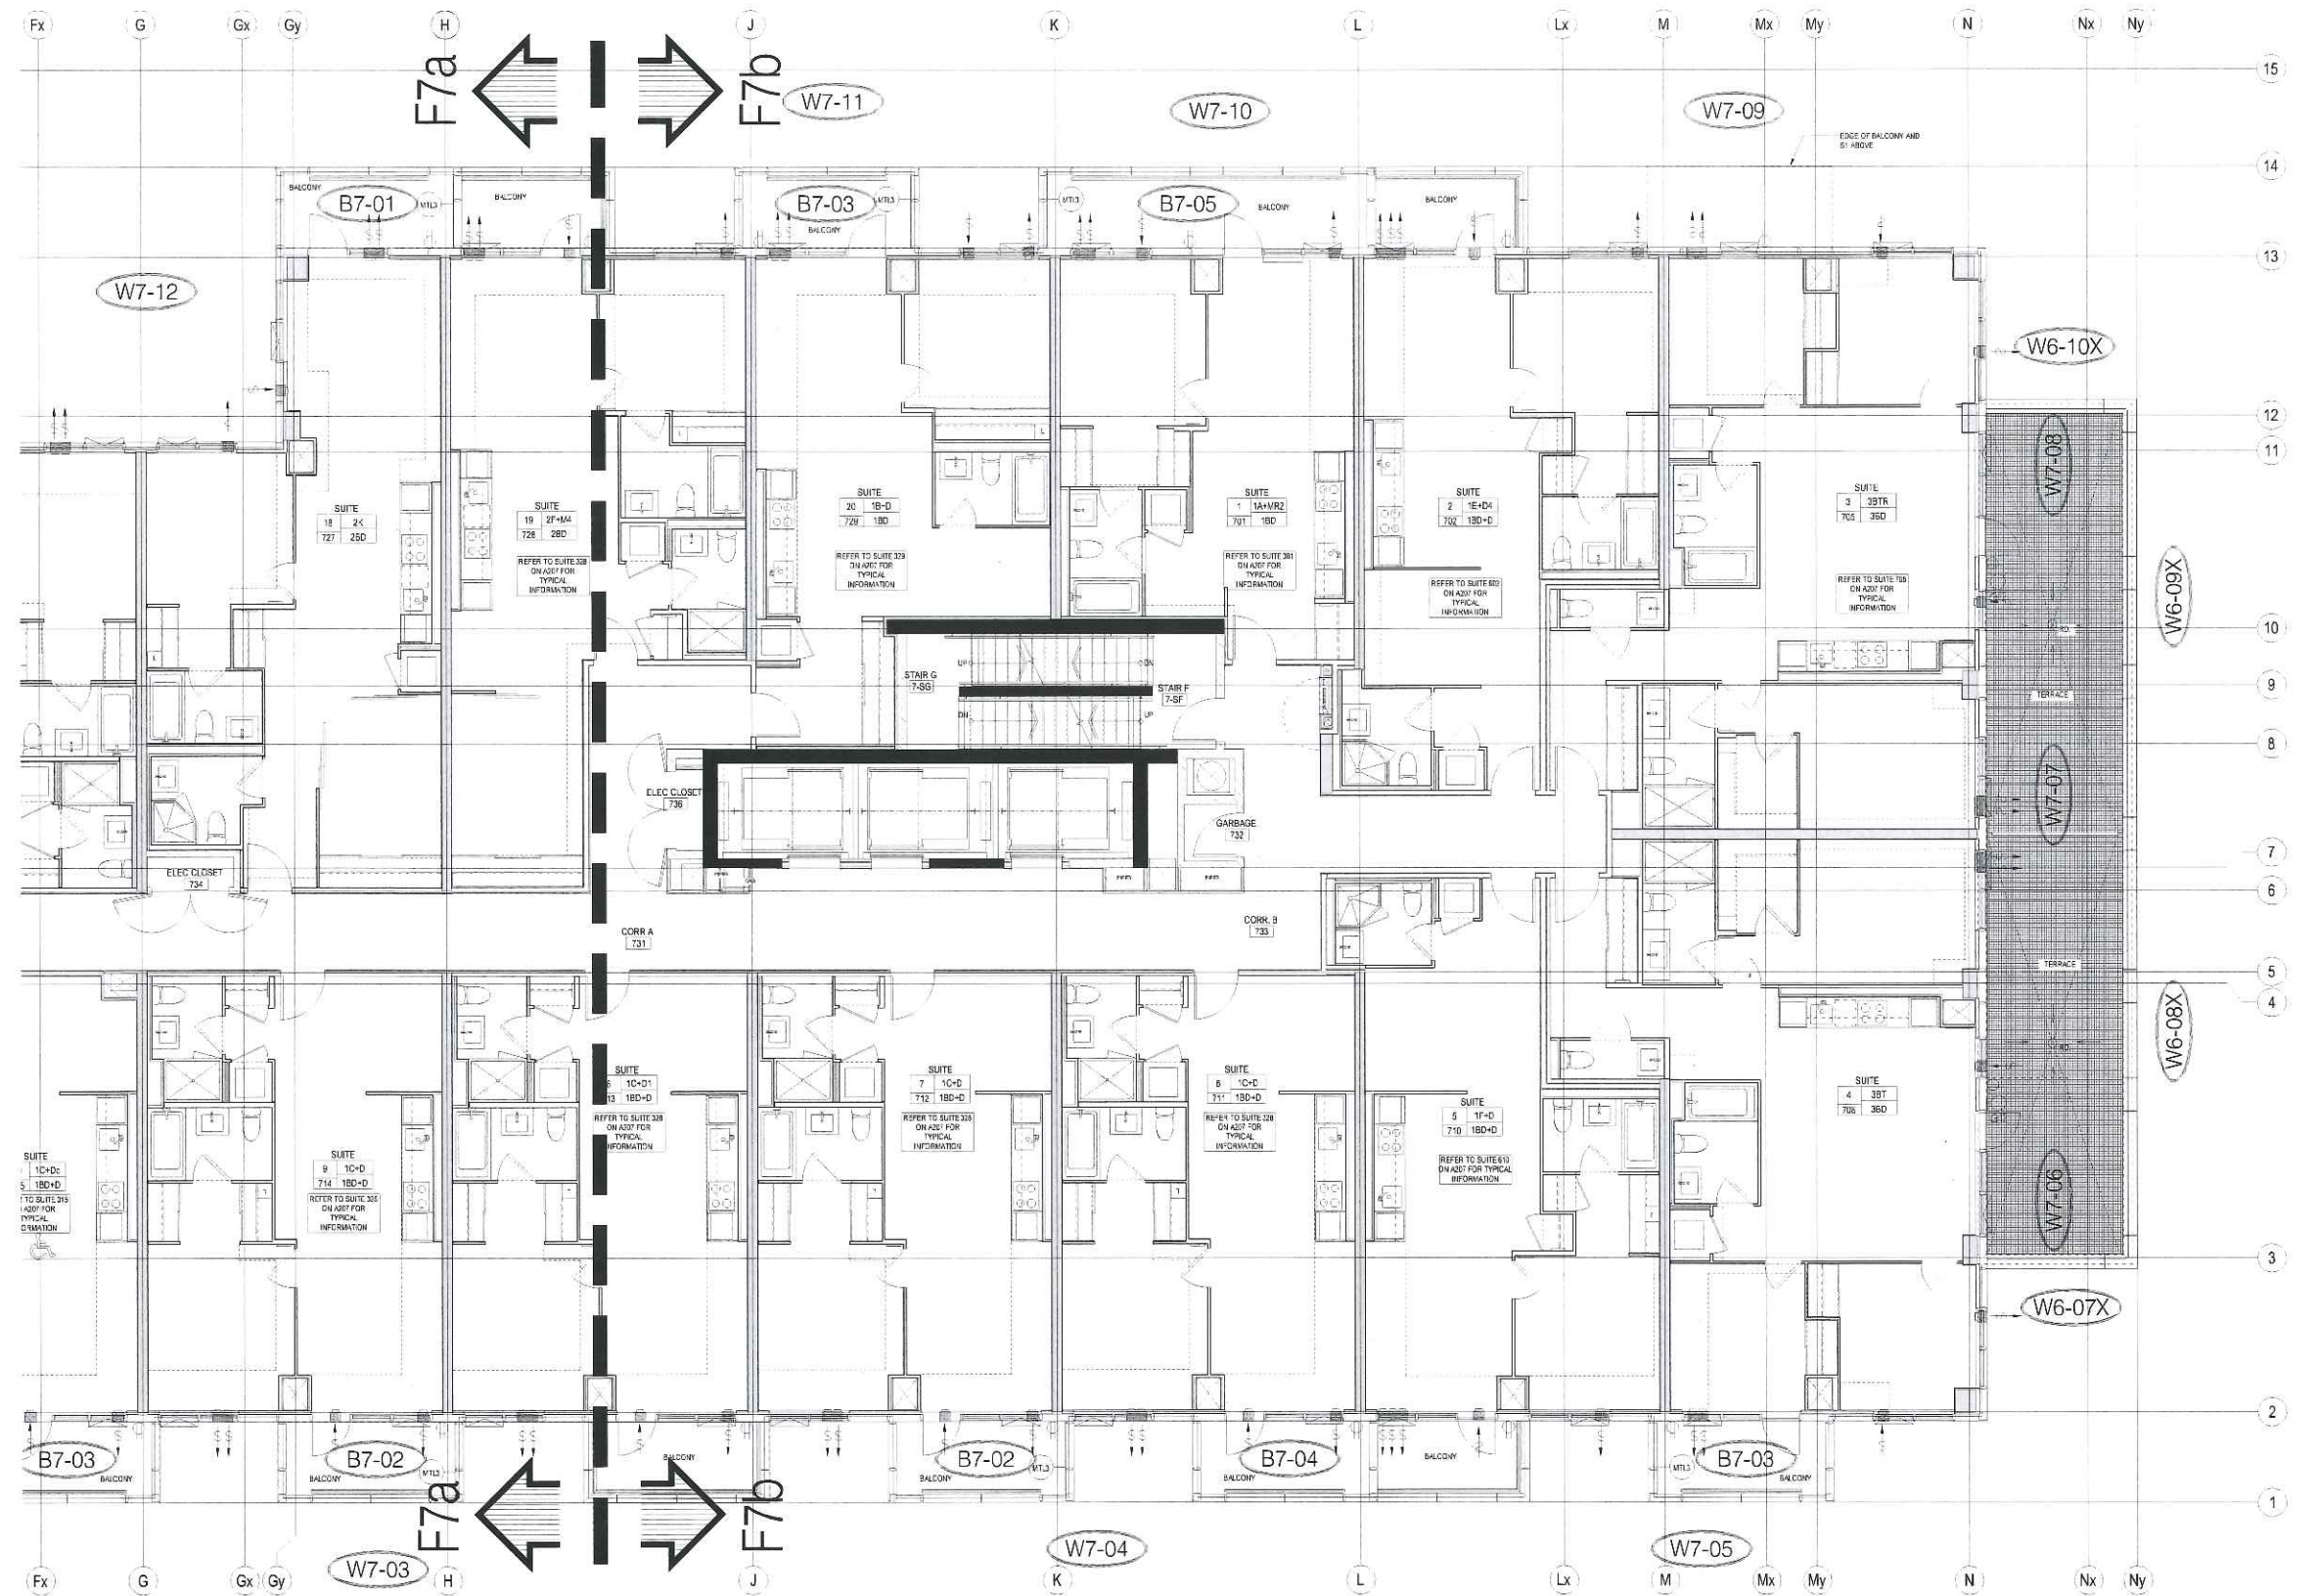


No.	REVISION	BY	DATE

PROJECT NAME:	SQ ALEXANDRA PARK - BLOCK 11		
DRAWING TITLE:	7th FLOOR PARTIAL PLAN		
ARCHITECT:	TEEPLE ARCHITECTS		
CONTRACTOR:	TRIDEL		
SCALE:	N/T/S	DRAWN BY:	S.C.
DATE:	MARCH 4, 2015	DRAWING No.	F7b

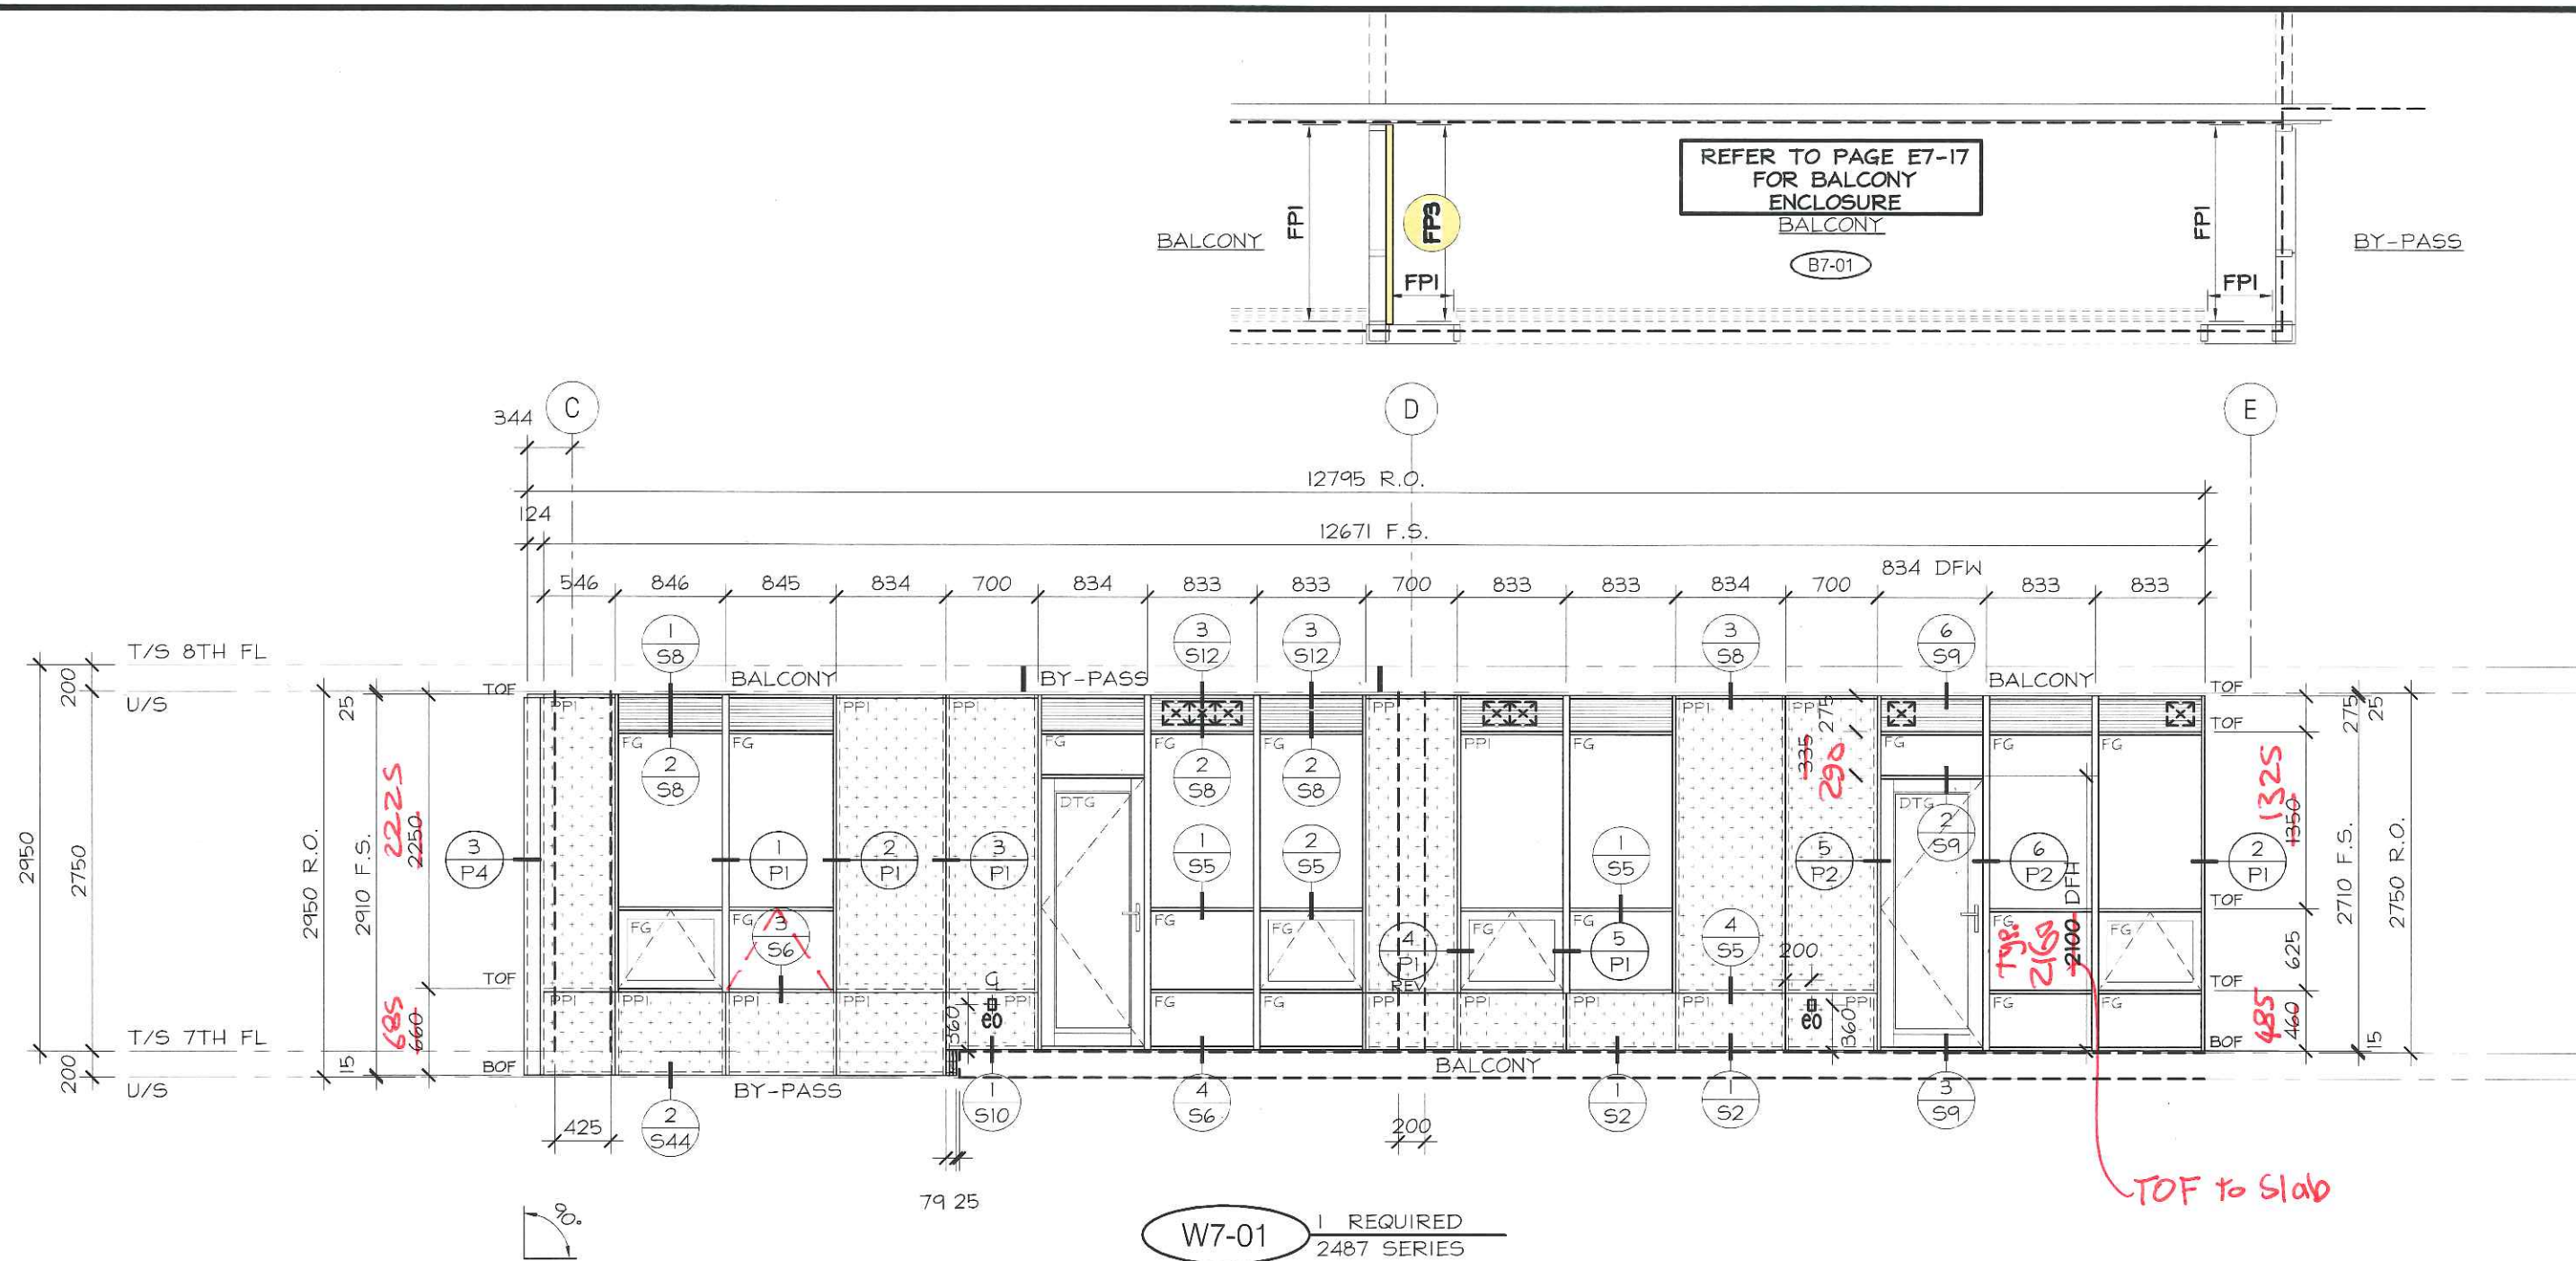


No.	REVISION	BY	DATE

PROJECT NAME:	SQ ALEXANDRA PARK - BLOCK 11
DRAWING TITLE:	7th FLOOR ELEVATIONS
ARCHITECT:	TEEPLE ARCHITECTS
CONTRACTOR:	TRIDEL
SCALE:	1:50
DRAWN BY:	S.C.
DATE:	MARCH 4, 2015
DRAWING No.:	E7-1

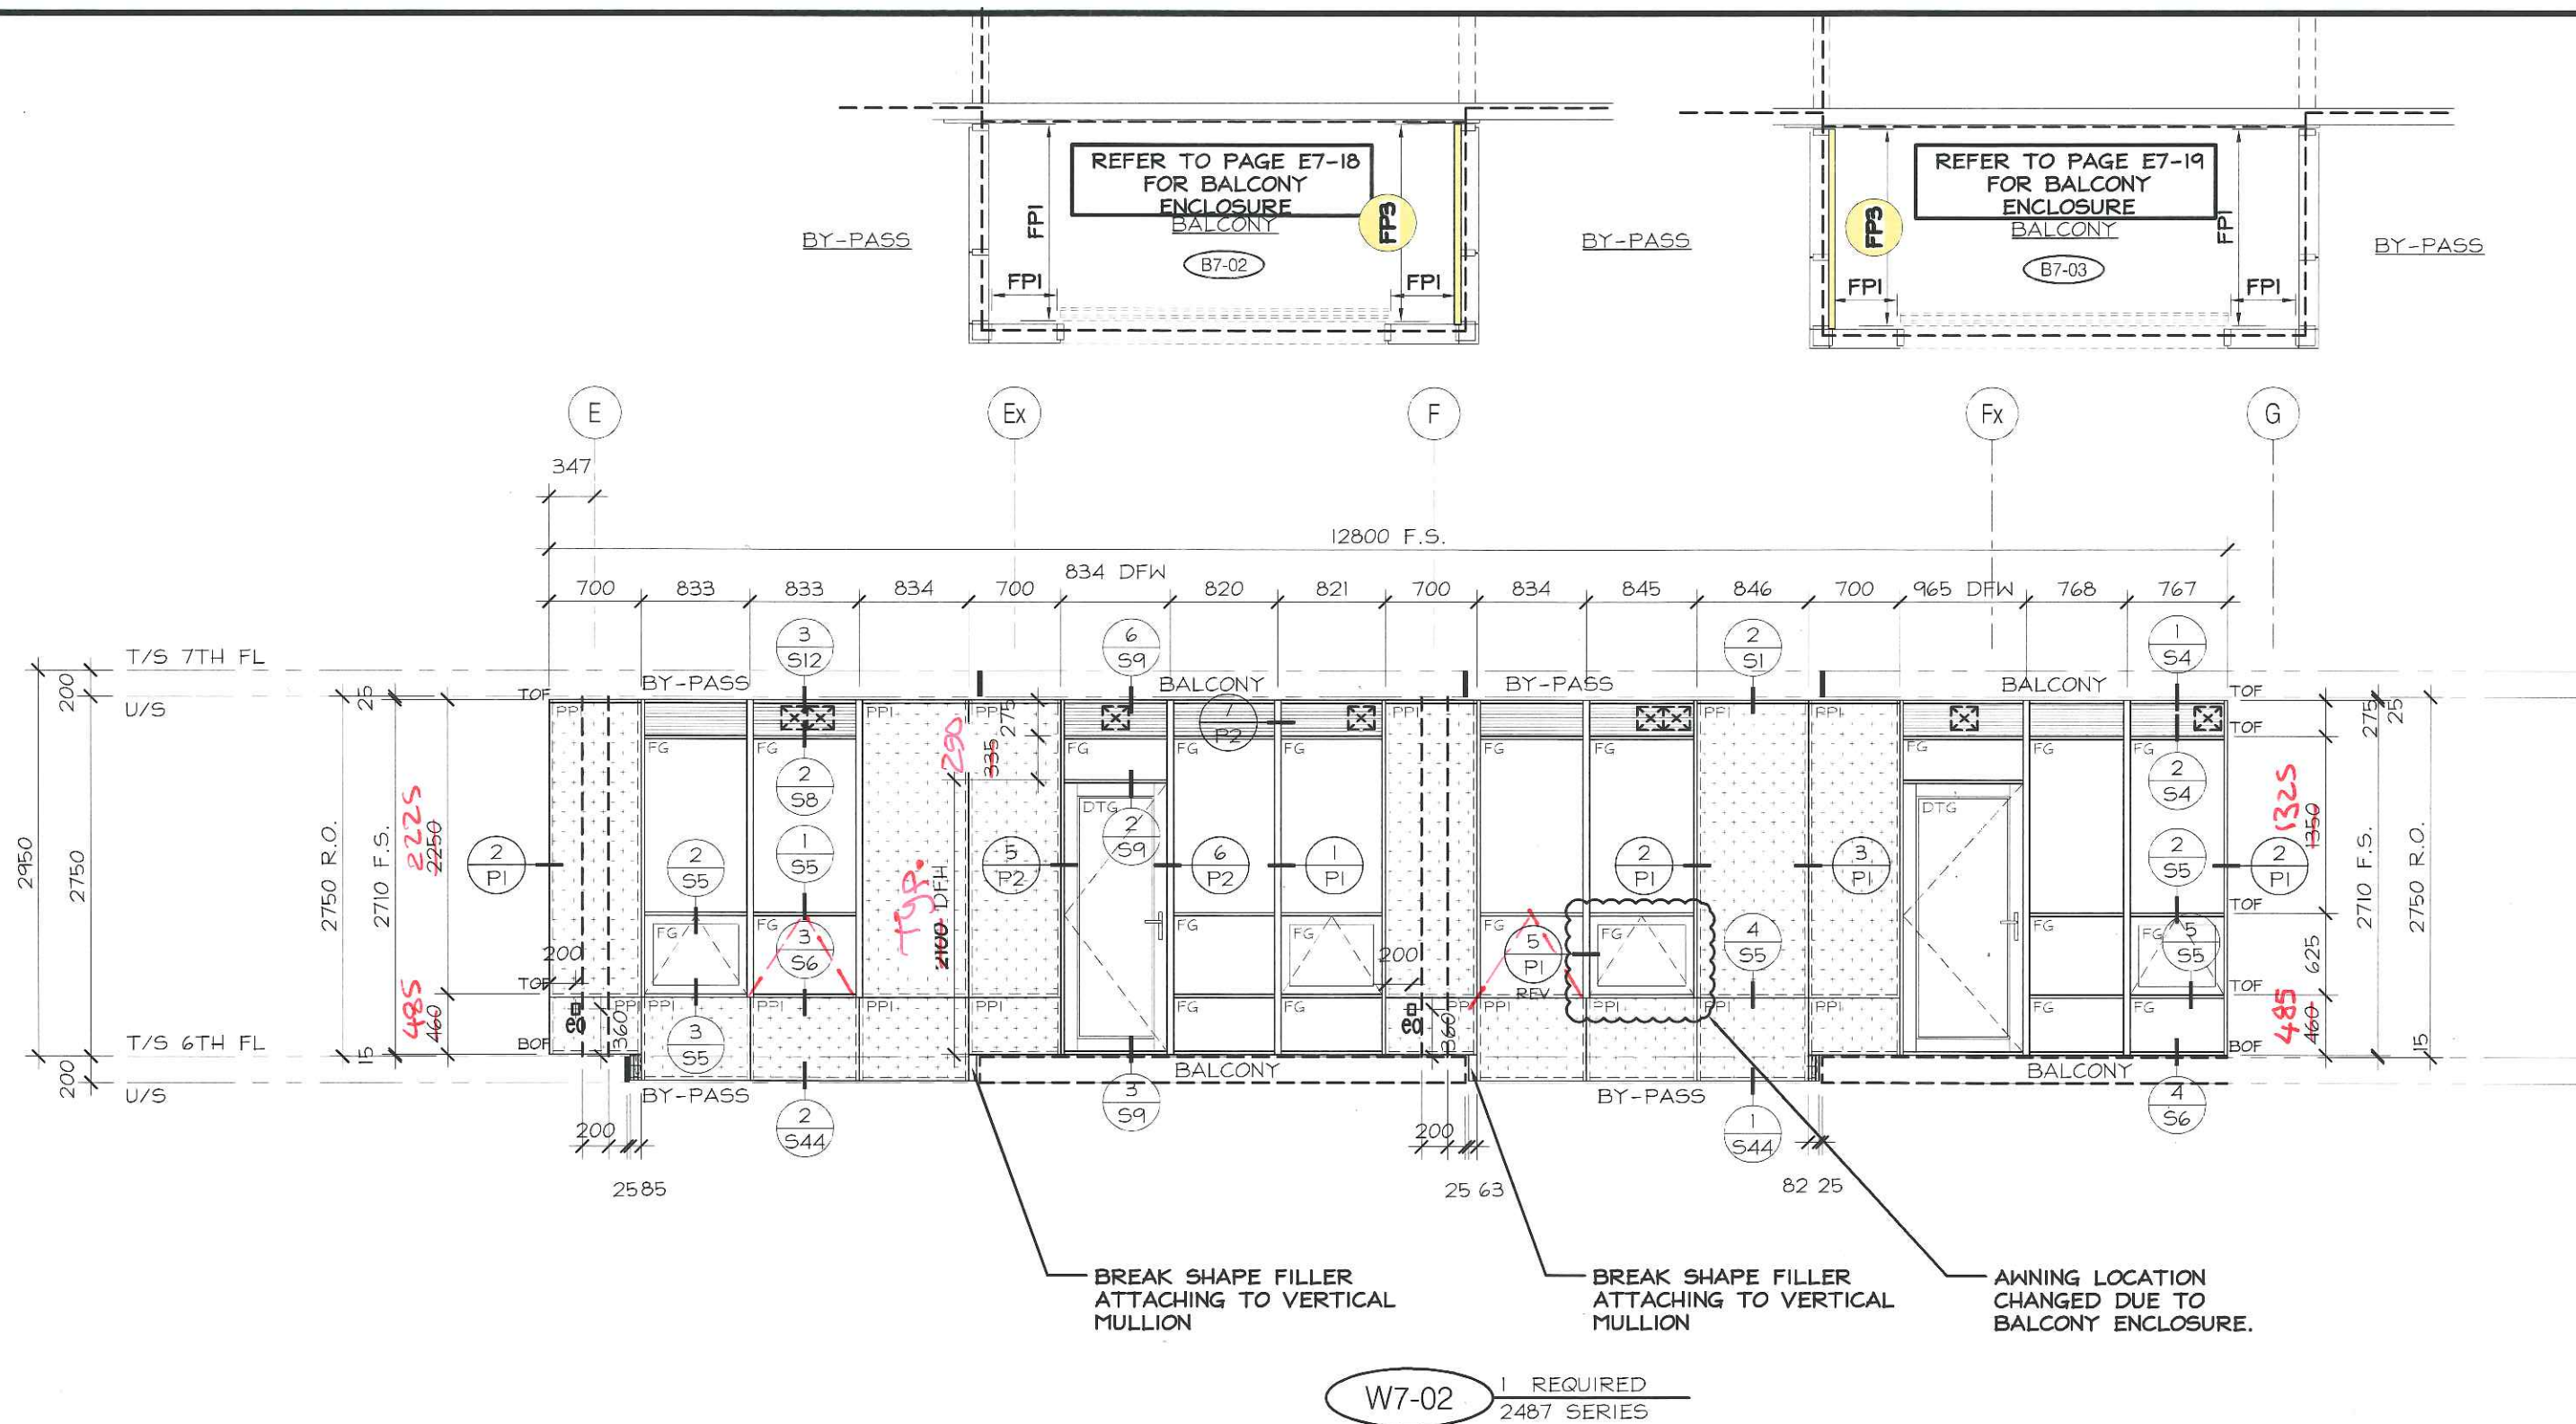


No.	REVISION	BY	DATE

PROJECT NAME:	SQ ALEXANDRA PARK - BLOCK 11
DRAWING TITLE:	7th FLOOR ELEVATIONS
ARCHITECT:	TEEPLE ARCHITECTS
CONTRACTOR:	TRIDEL
SCALE:	1:50
DRAWN BY:	S.C.
DATE:	MARCH 4, 2015

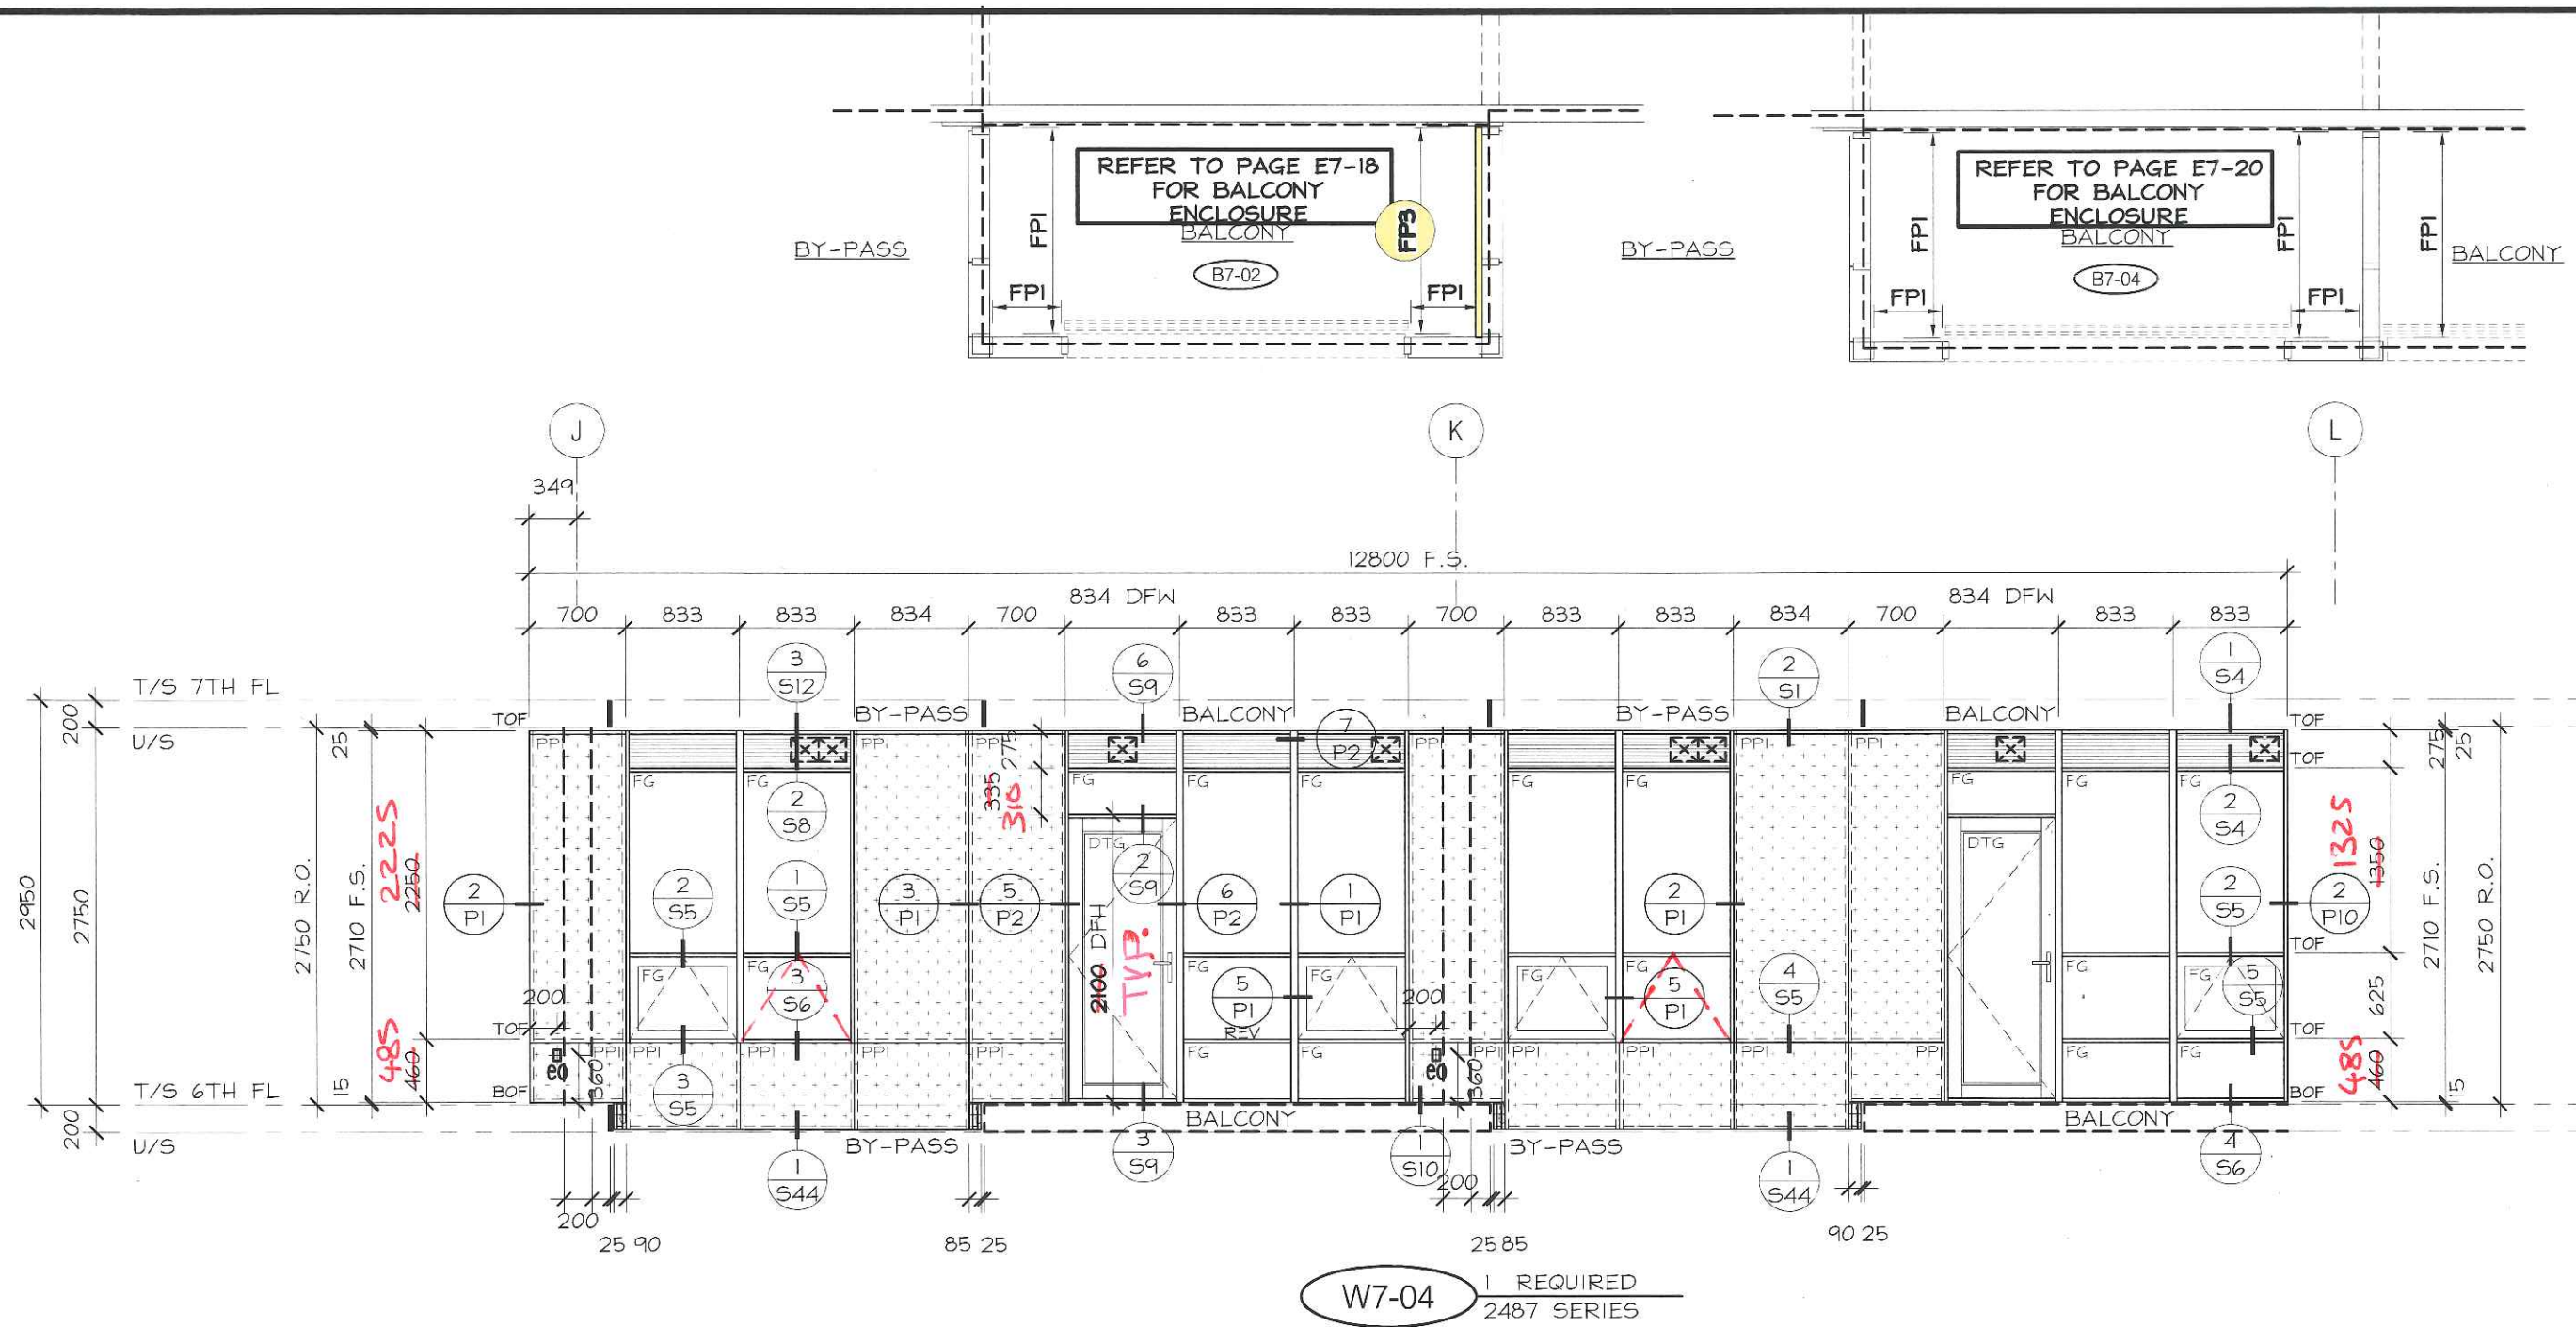


No.	REVISION	BY	DATE

PROJECT NAME:	SQ ALEXANDRA PARK - BLOCK 11
DRAWING TITLE:	7th FLOOR ELEVATIONS
ARCHITECT:	TEEPLE ARCHITECTS
CONTRACTOR:	TRIDEL
SCALE:	1:50
DRAWN BY:	S.C.
DATE:	MARCH 4, 2015
DRAWING No.:	E7-4

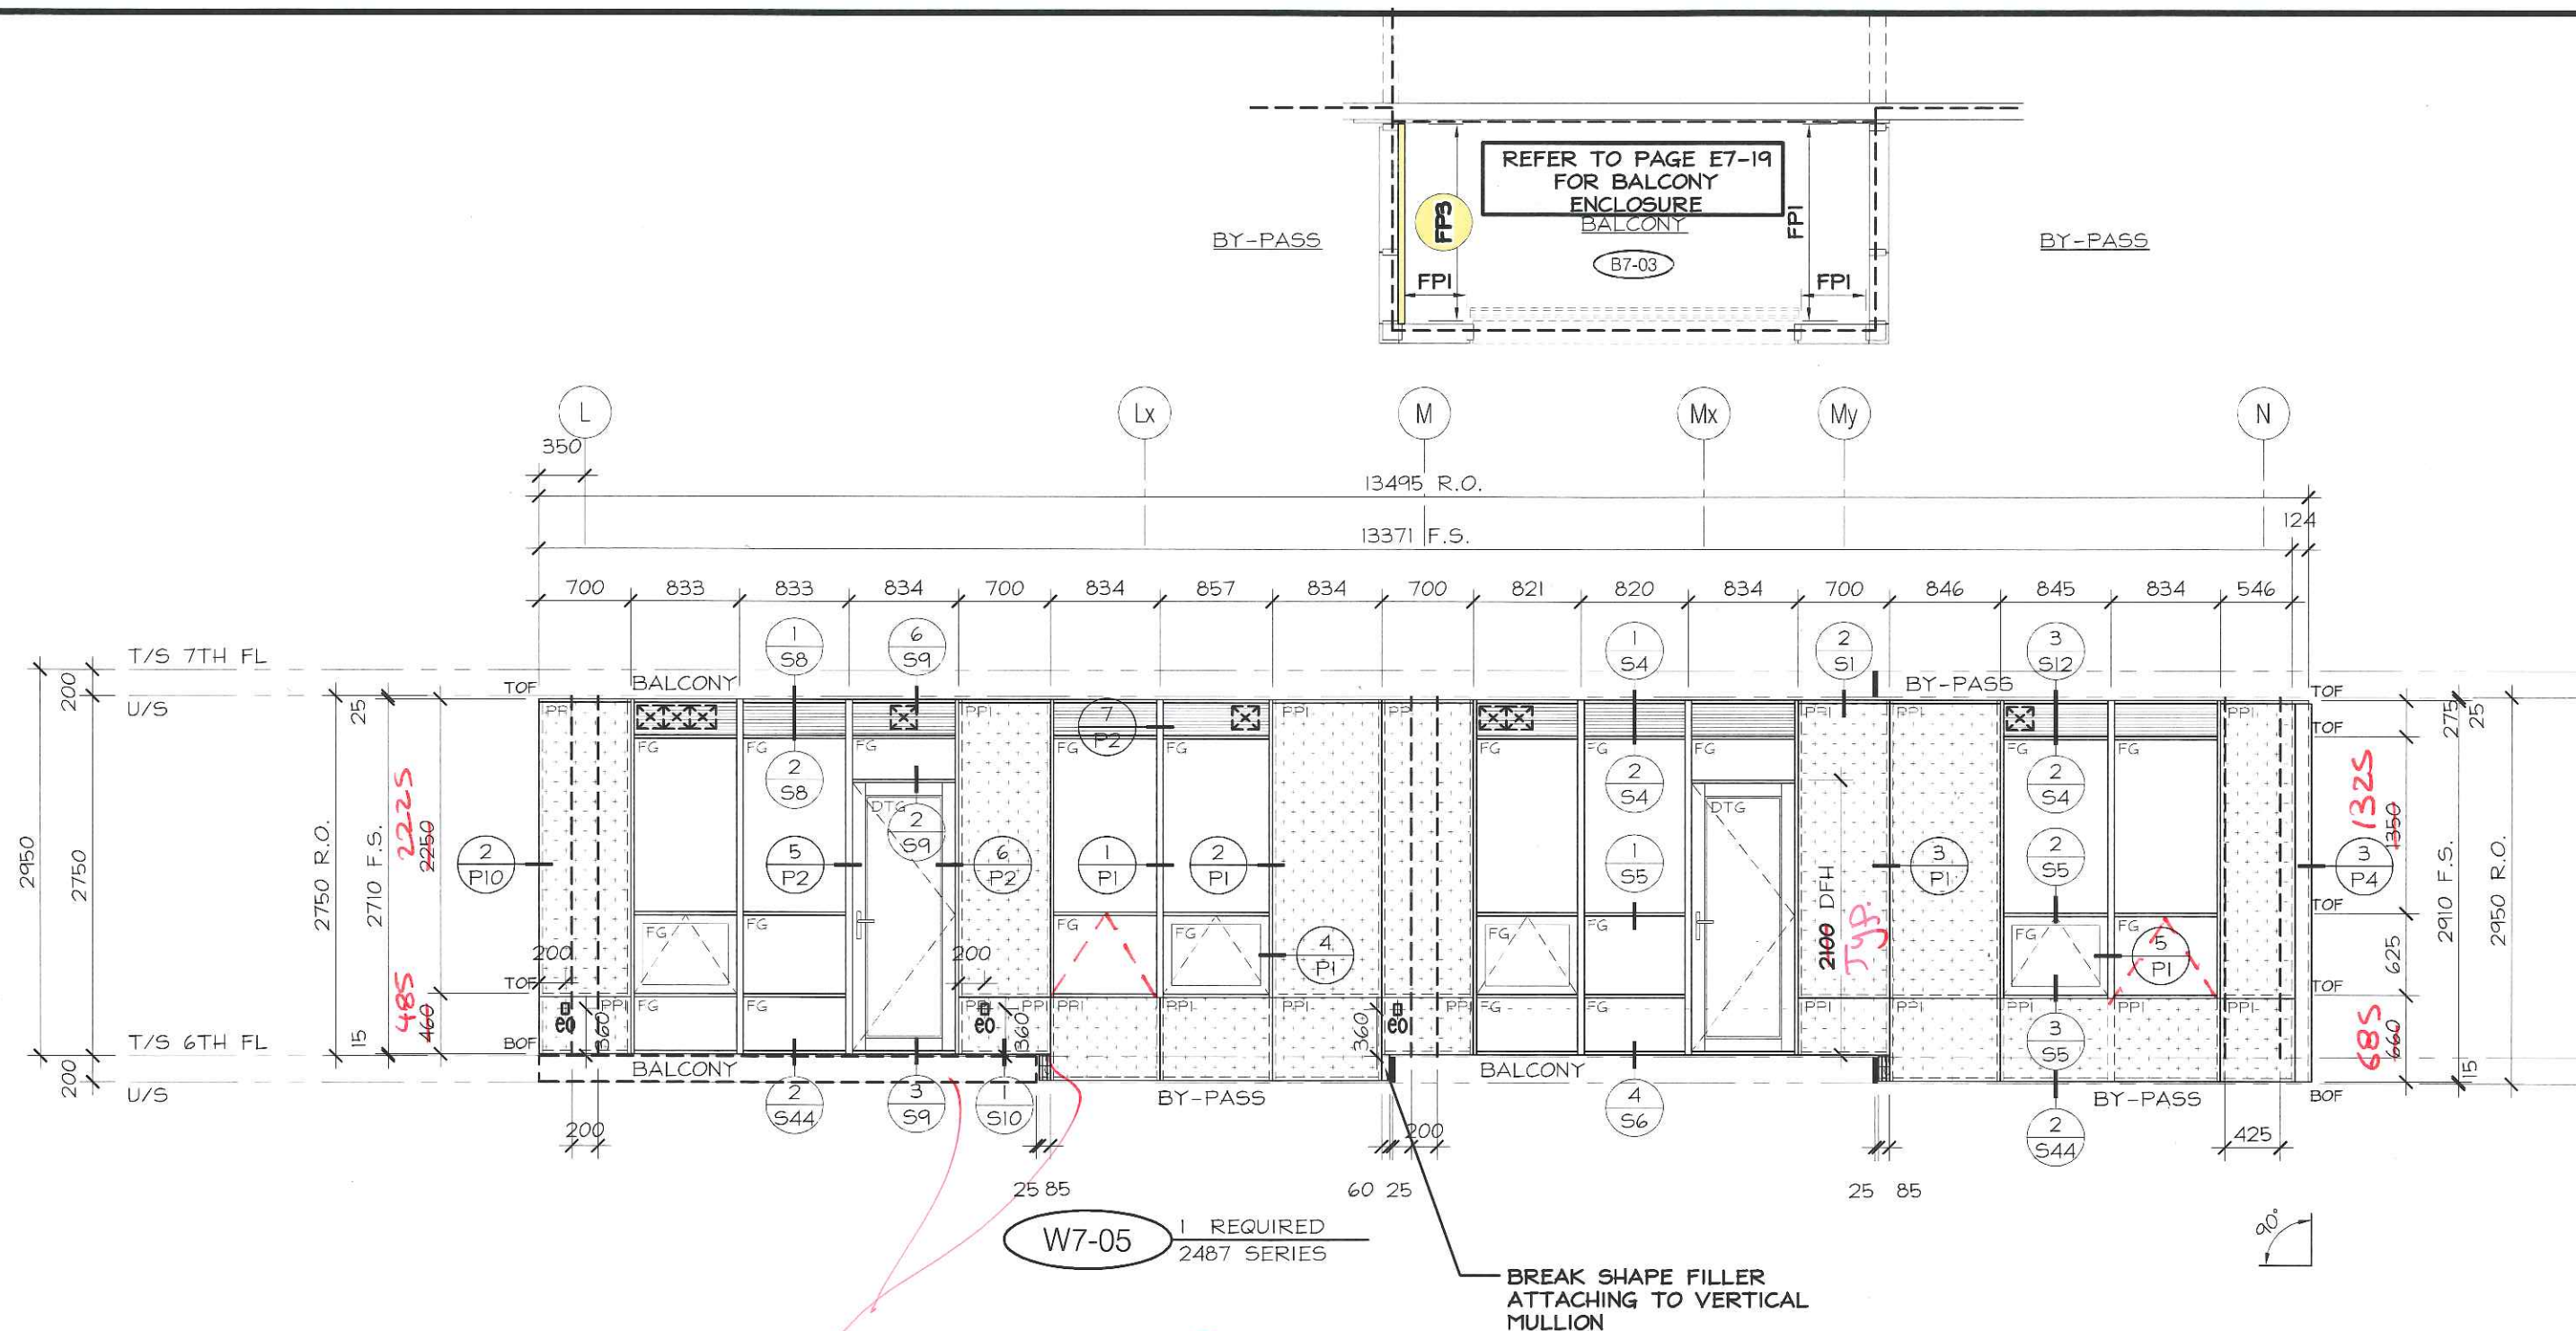


No.	REVISION	BY	DATE

PROJECT NAME:	SQ ALEXANDRA PARK - BLOCK 11
DRAWING TITLE:	7th FLOOR ELEVATIONS
ARCHITECT:	TEEPLE ARCHITECTS
CONTRACTOR:	TRIDEL
SCALE:	1:50
DRAWN BY:	S.C.
DATE:	MARCH 4, 2015
DRAWING No.:	E7-5

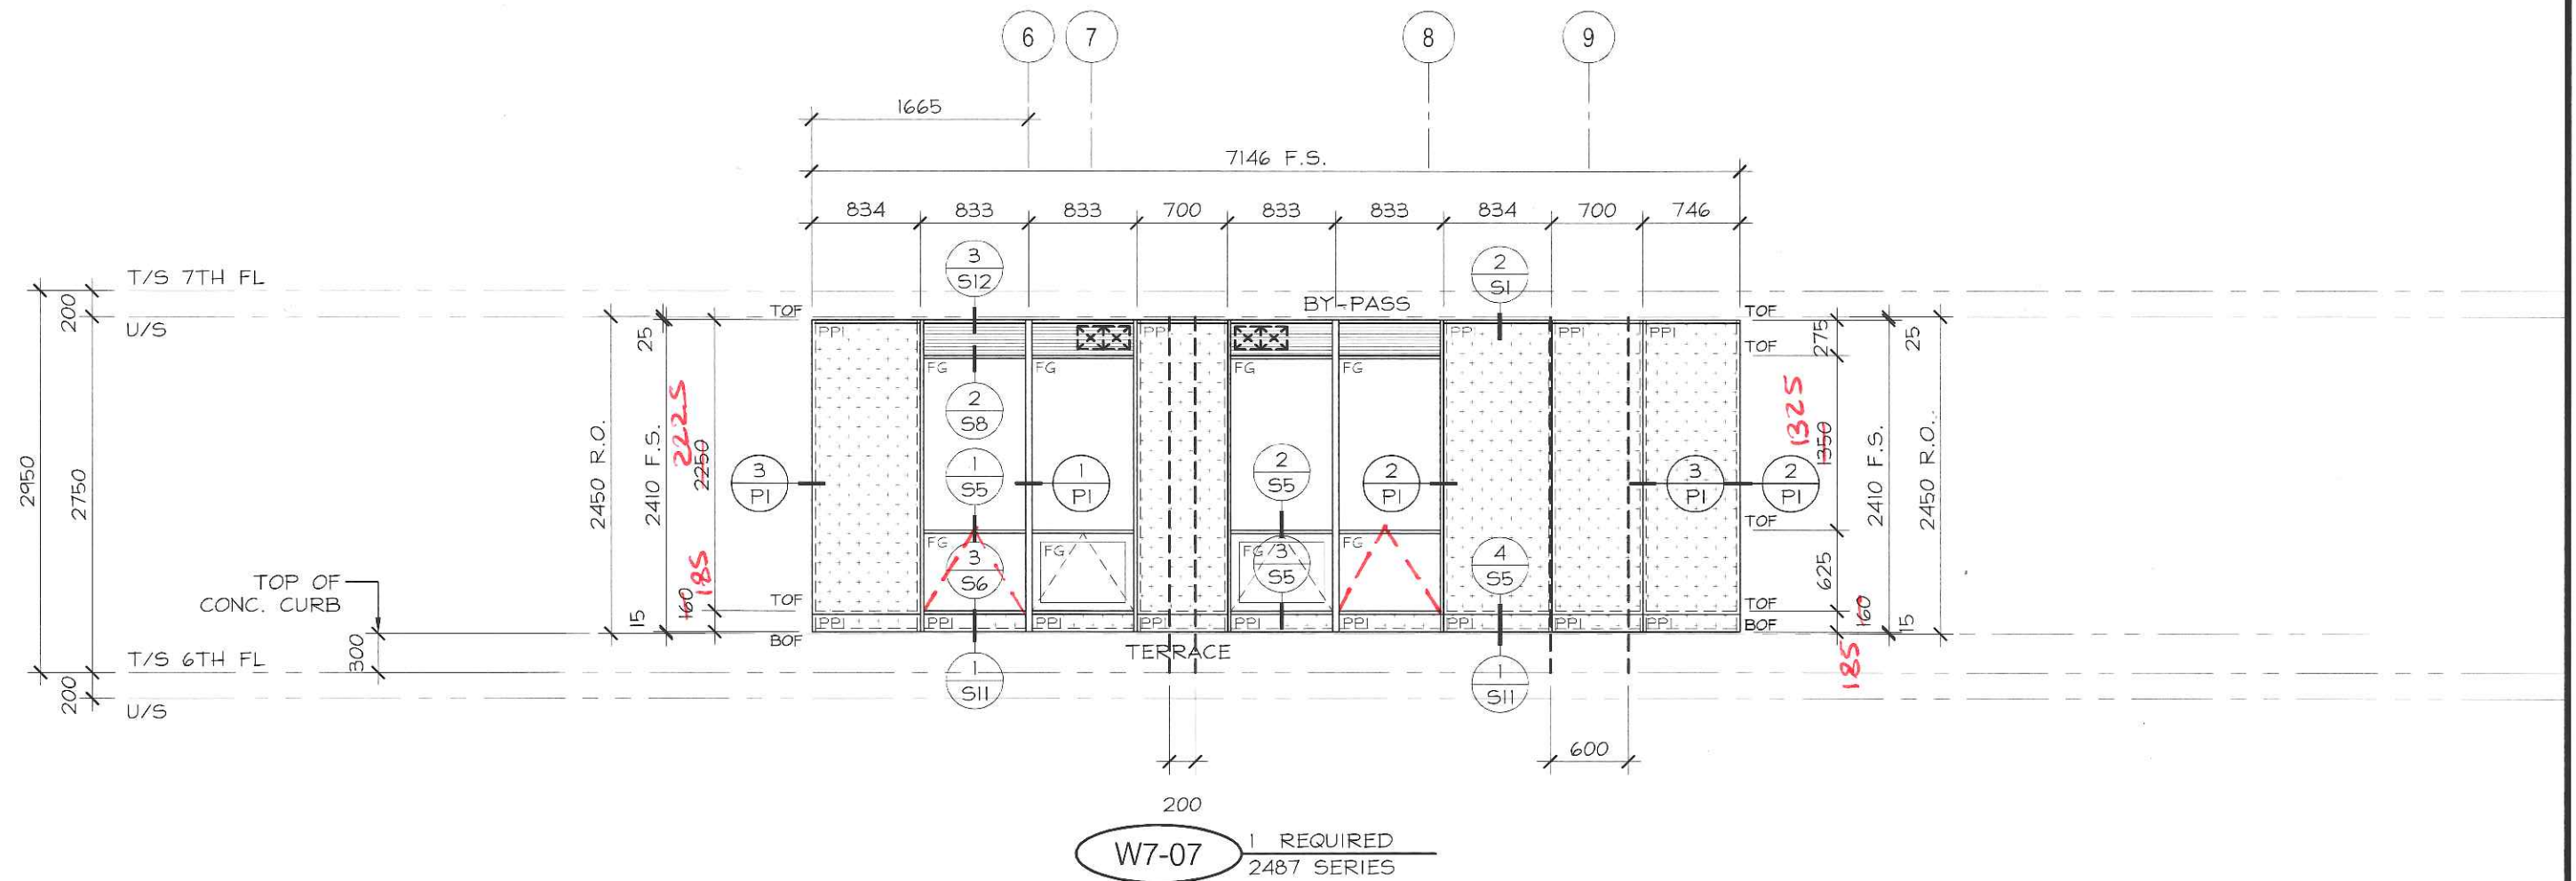


No.	REVISION	BY	DATE

PROJECT NAME:	SQ ALEXANDRA PARK - BLOCK 11
DRAWING TITLE:	7th FLOOR ELEVATIONS
ARCHITECT:	TEEPLE ARCHITECTS
CONTRACTOR:	TRIDEL
SCALE:	1:50
DRAWN BY:	S.C.
DATE:	MARCH 4, 2015
DRAWING No.:	E7-7

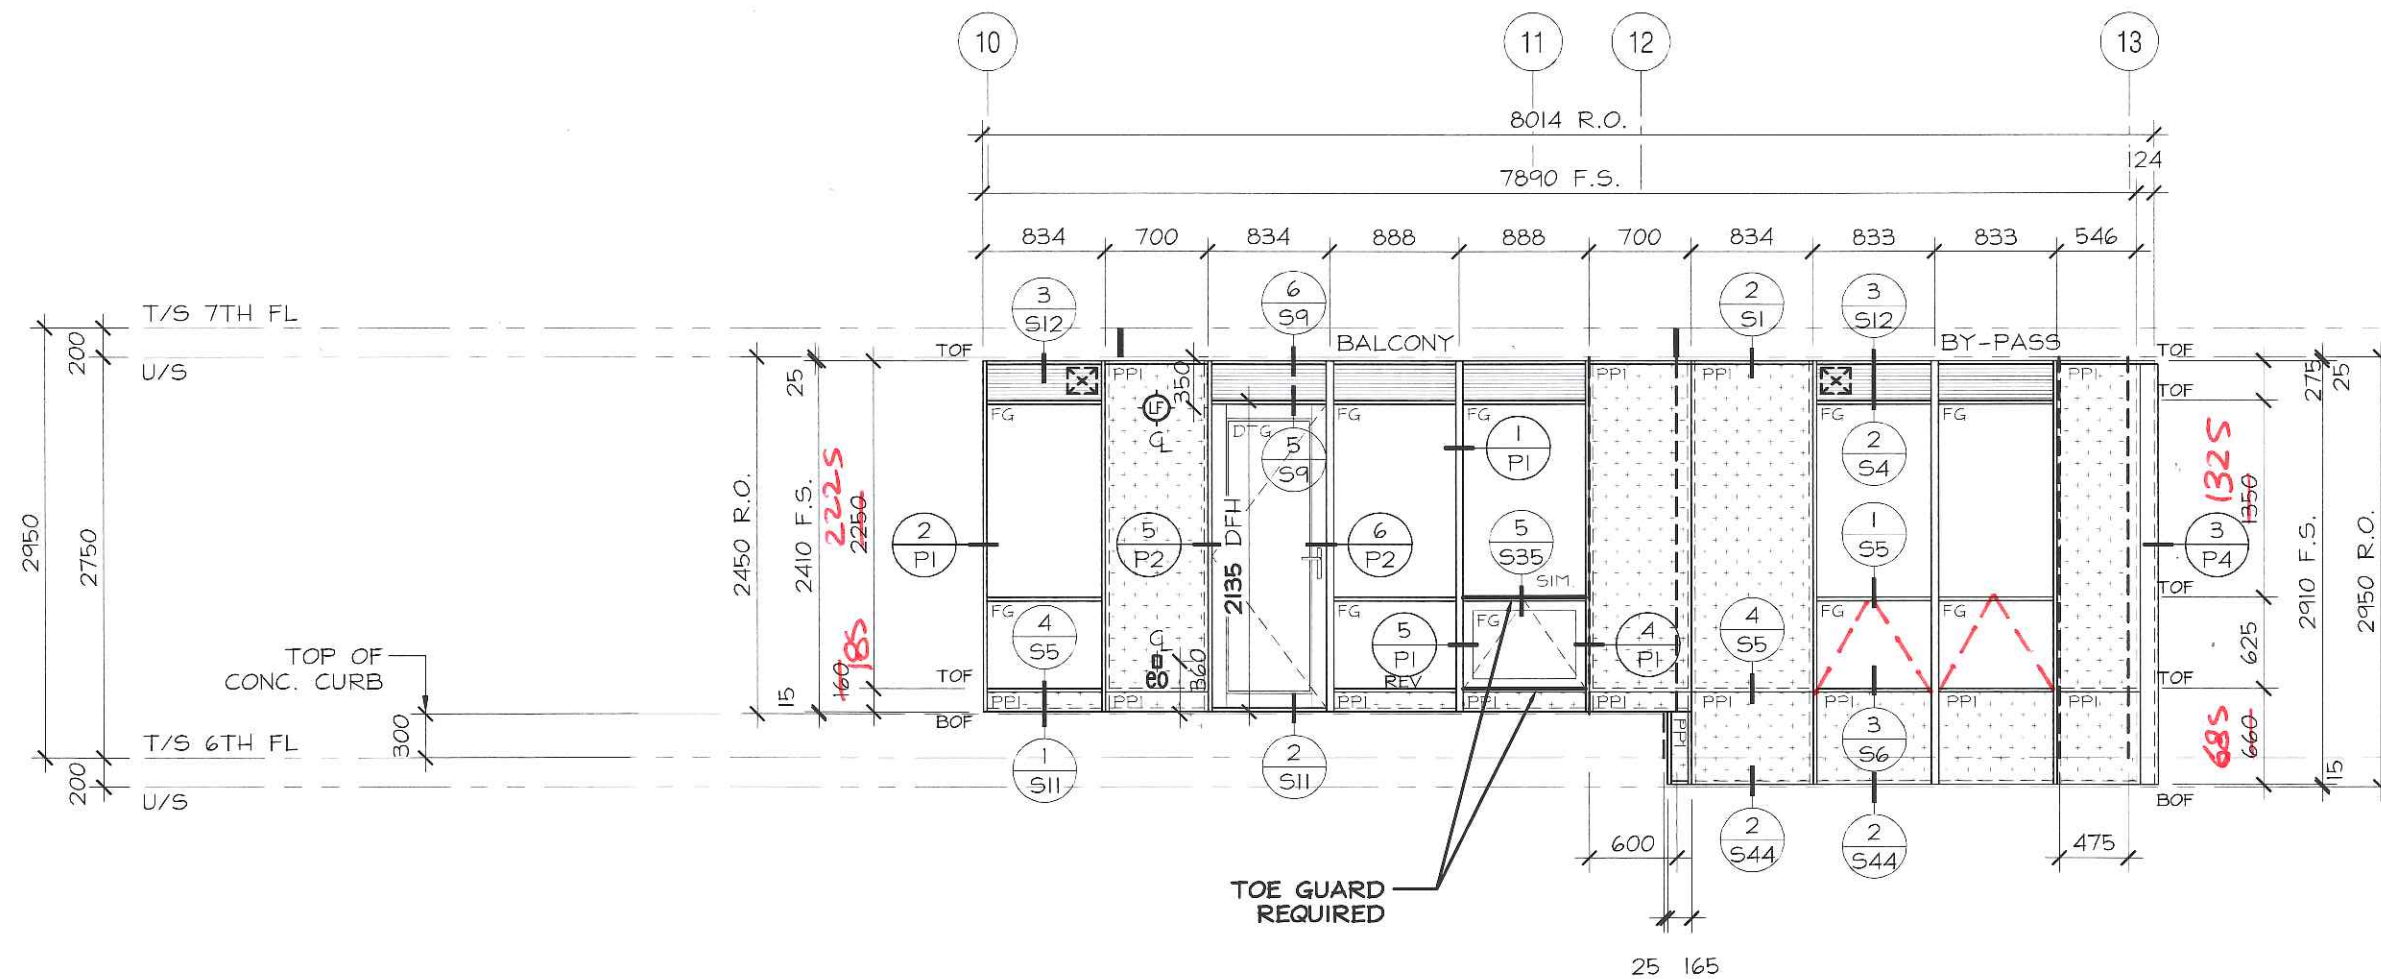


No.	REVISION	BY	DATE


PROJECT NAME:	SQ ALEXANDRA PARK - BLOCK 11		
DRAWING TITLE:	7th FLOOR ELEVATIONS		
ARCHITECT:	TEEPLE ARCHITECTS		
CONTRACTOR:	TRIDEL		
SCALE:	1:50	DRAWN BY:	S.C.
DATE:	MARCH 4, 2015		
DRAWING No.:	E7-8		

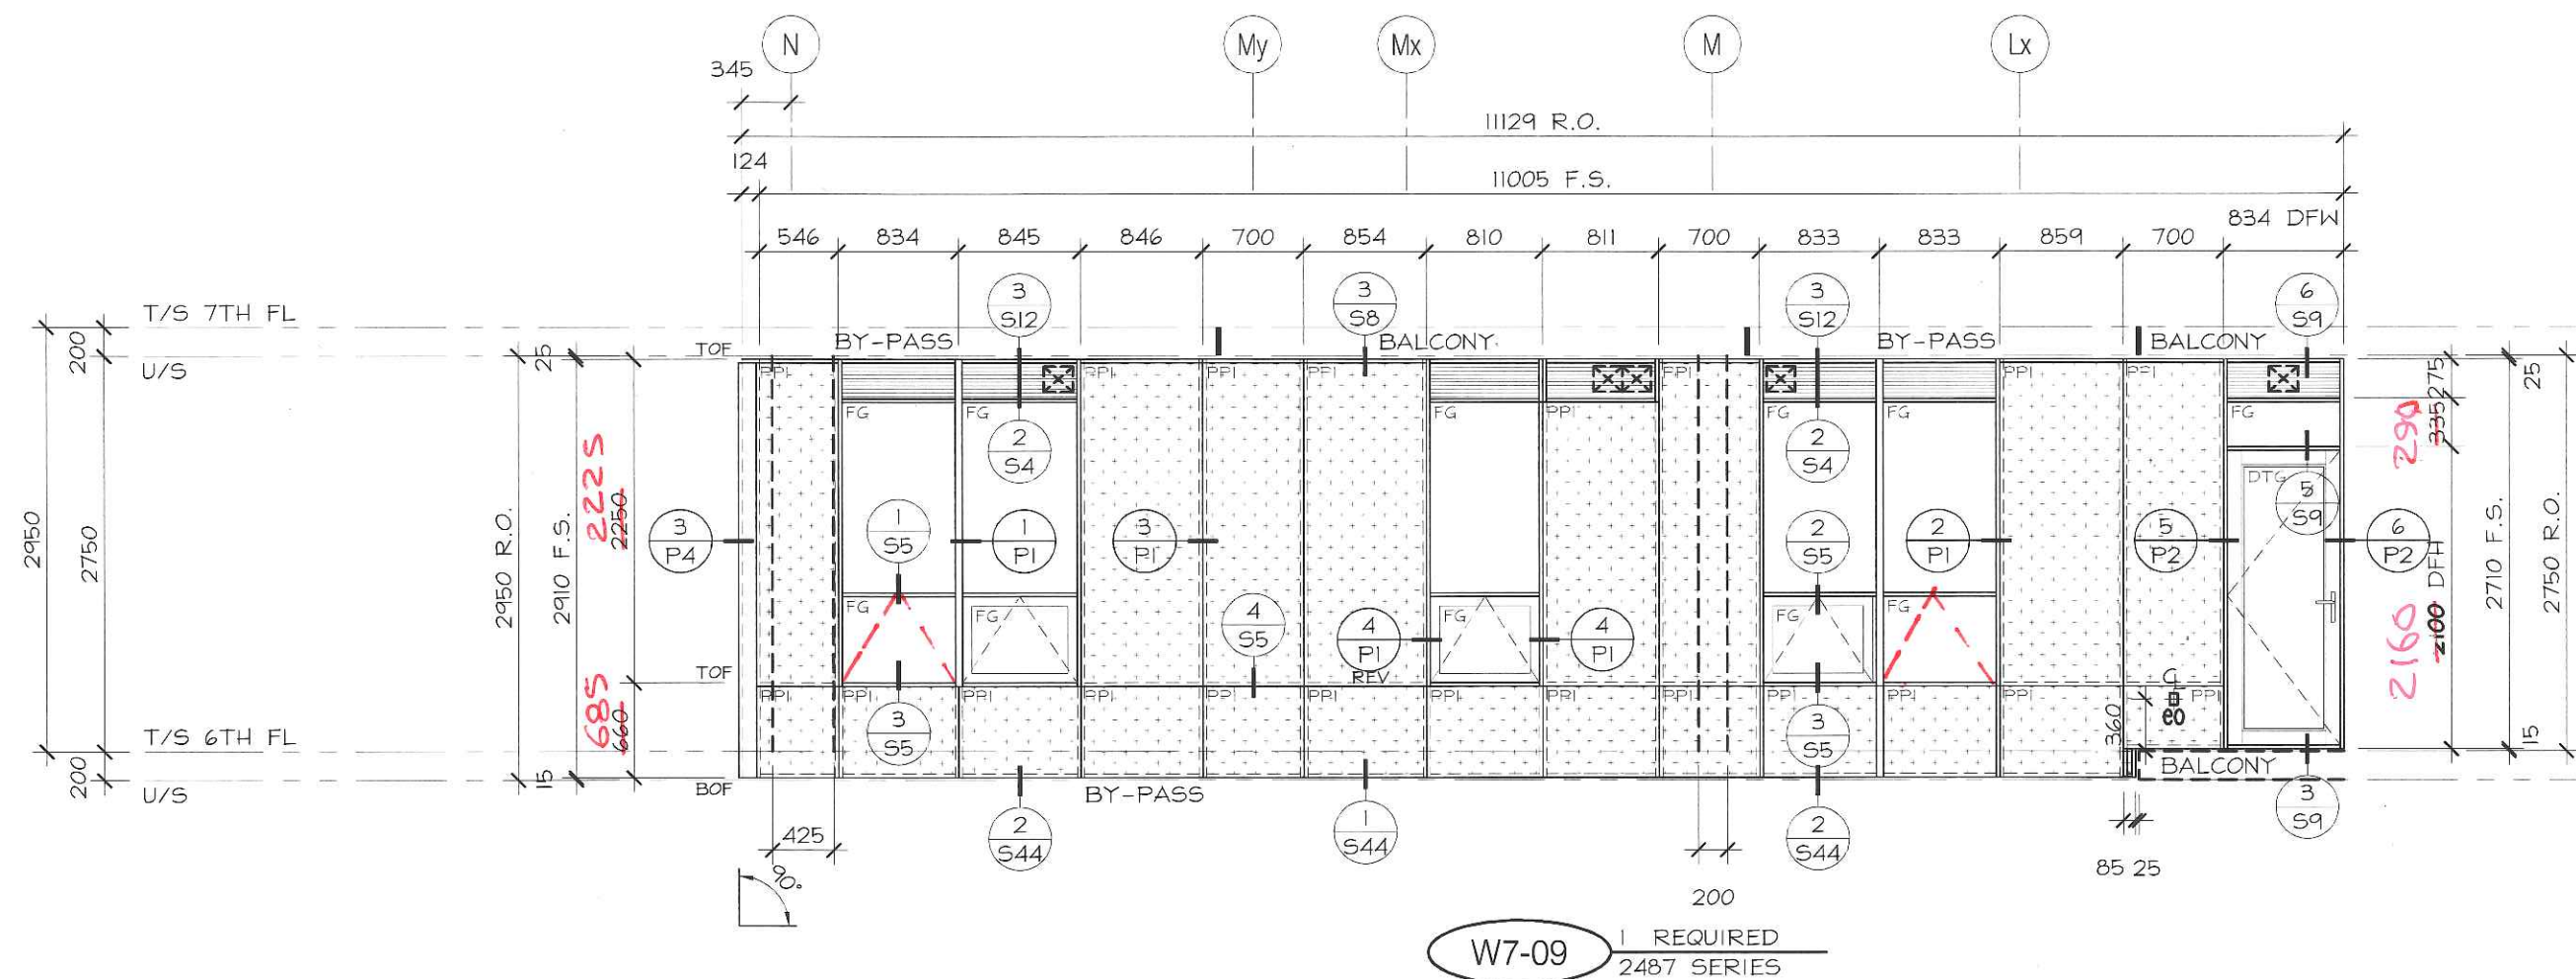

No.	REVISION	BY	DATE

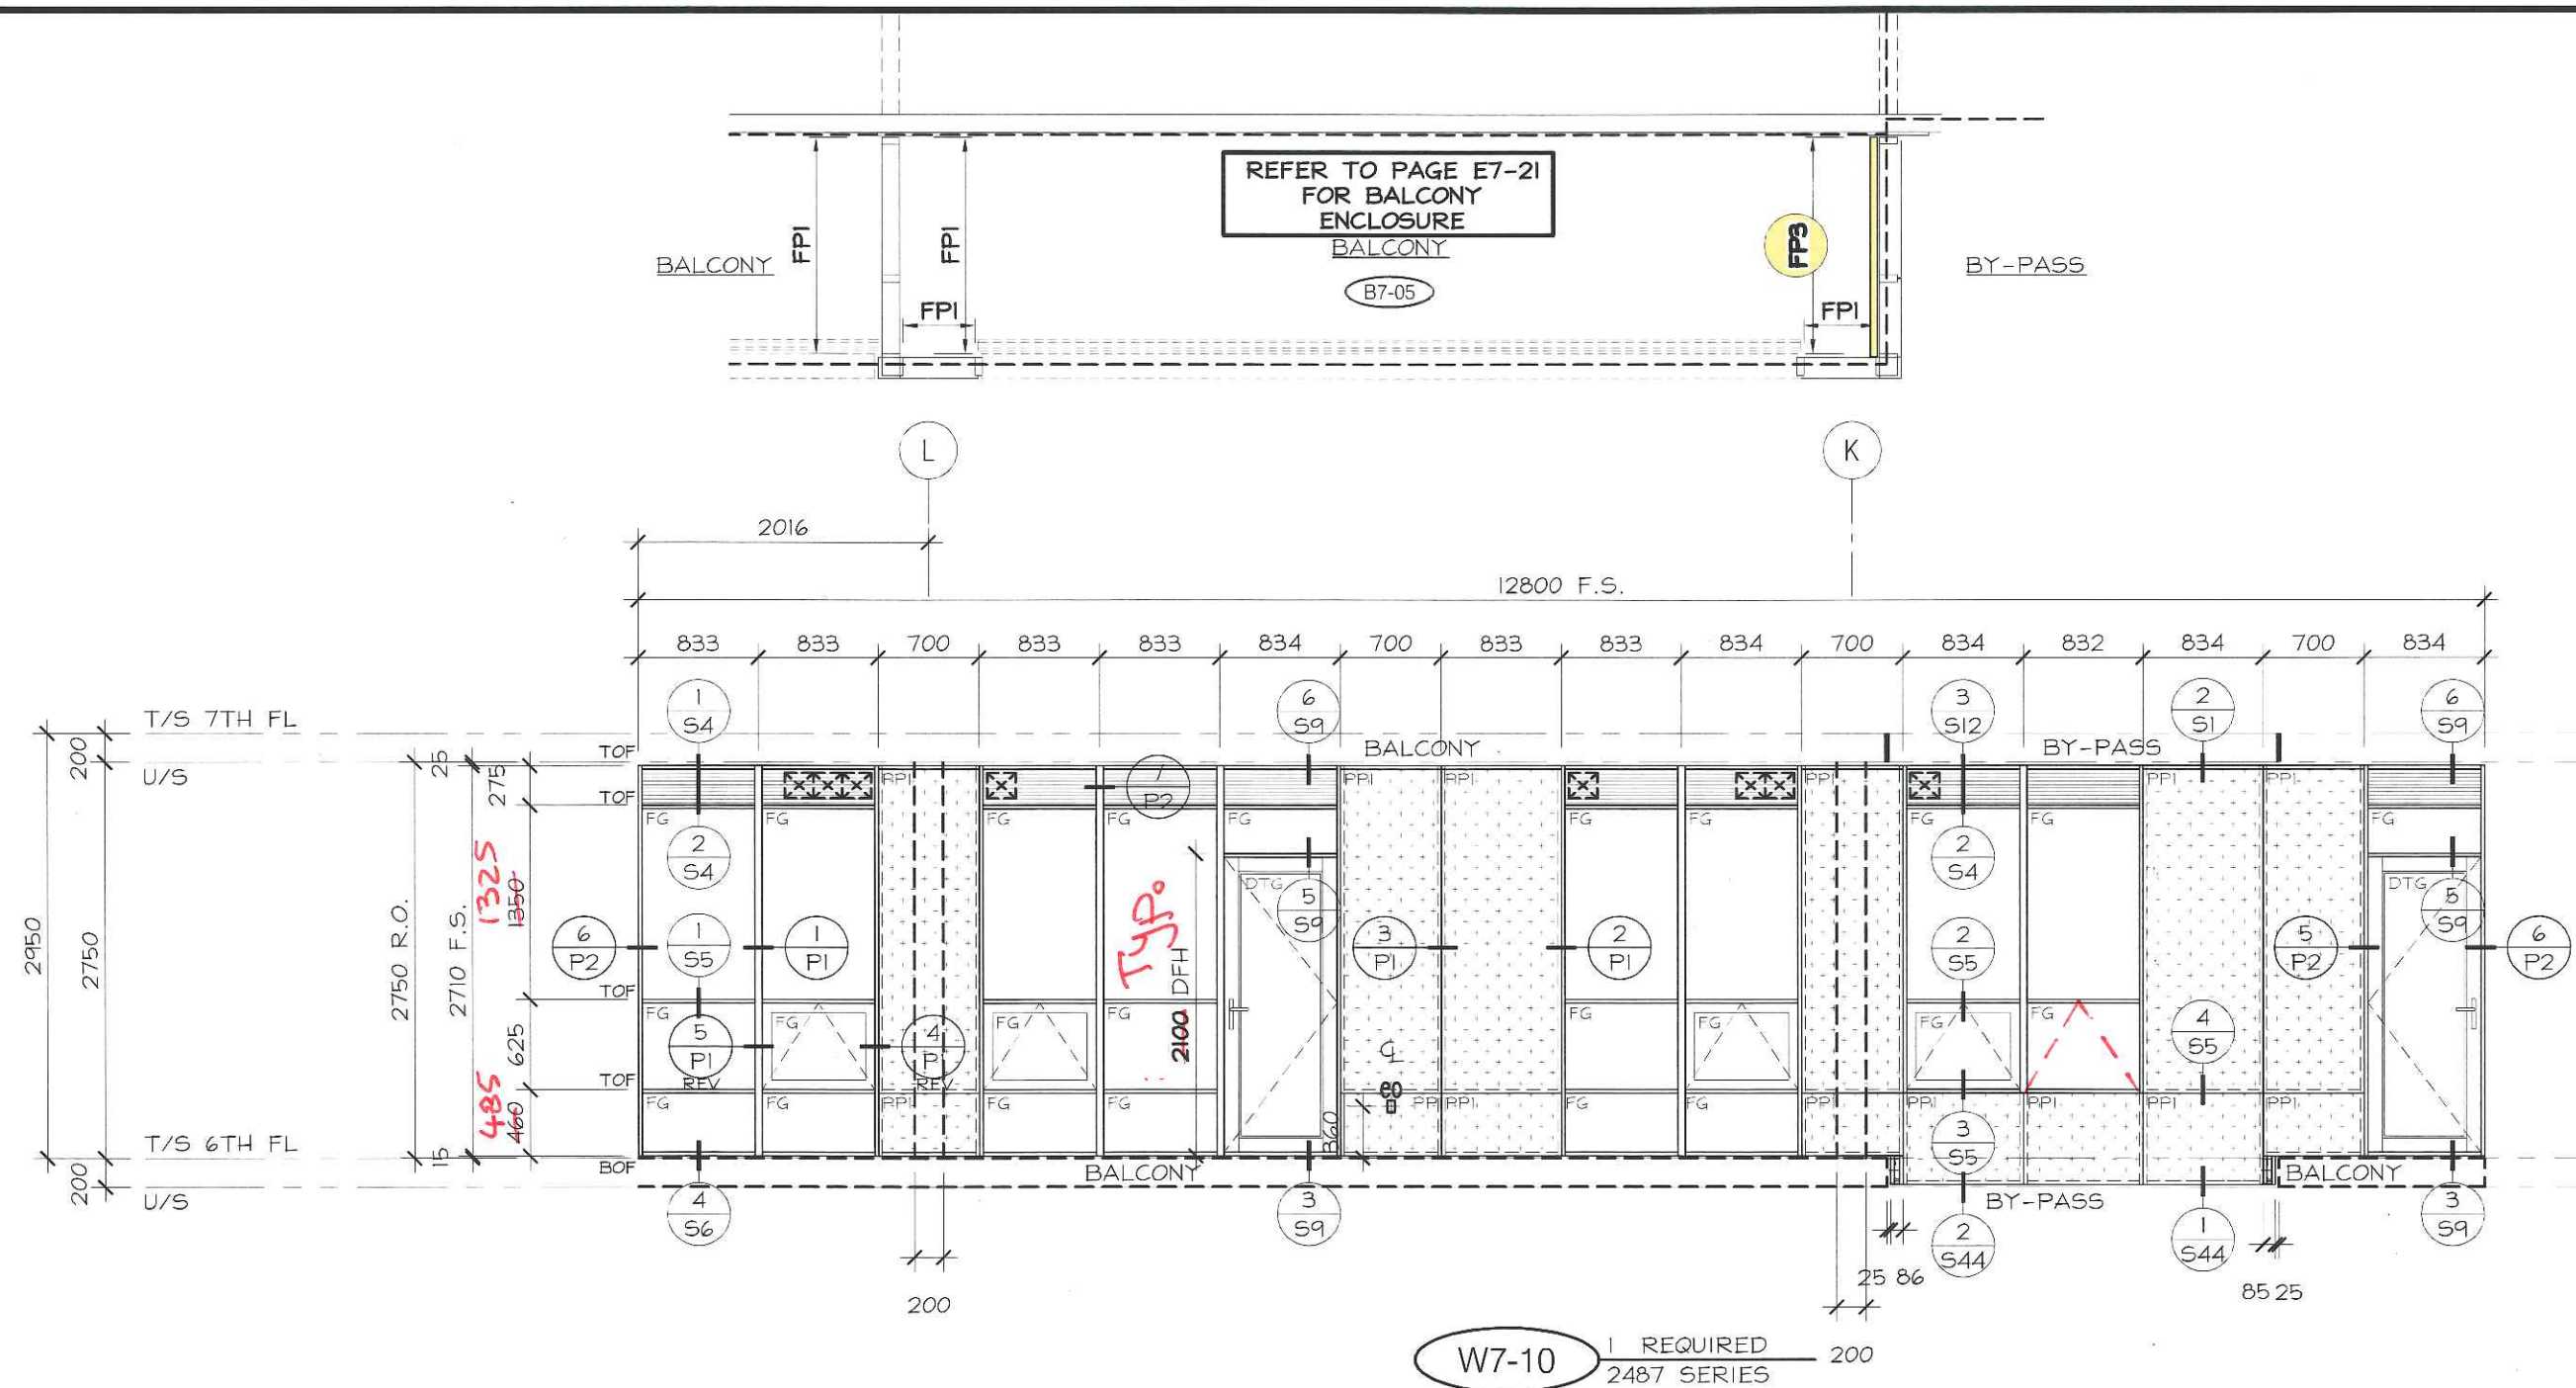


No.	REVISION	BY	DATE

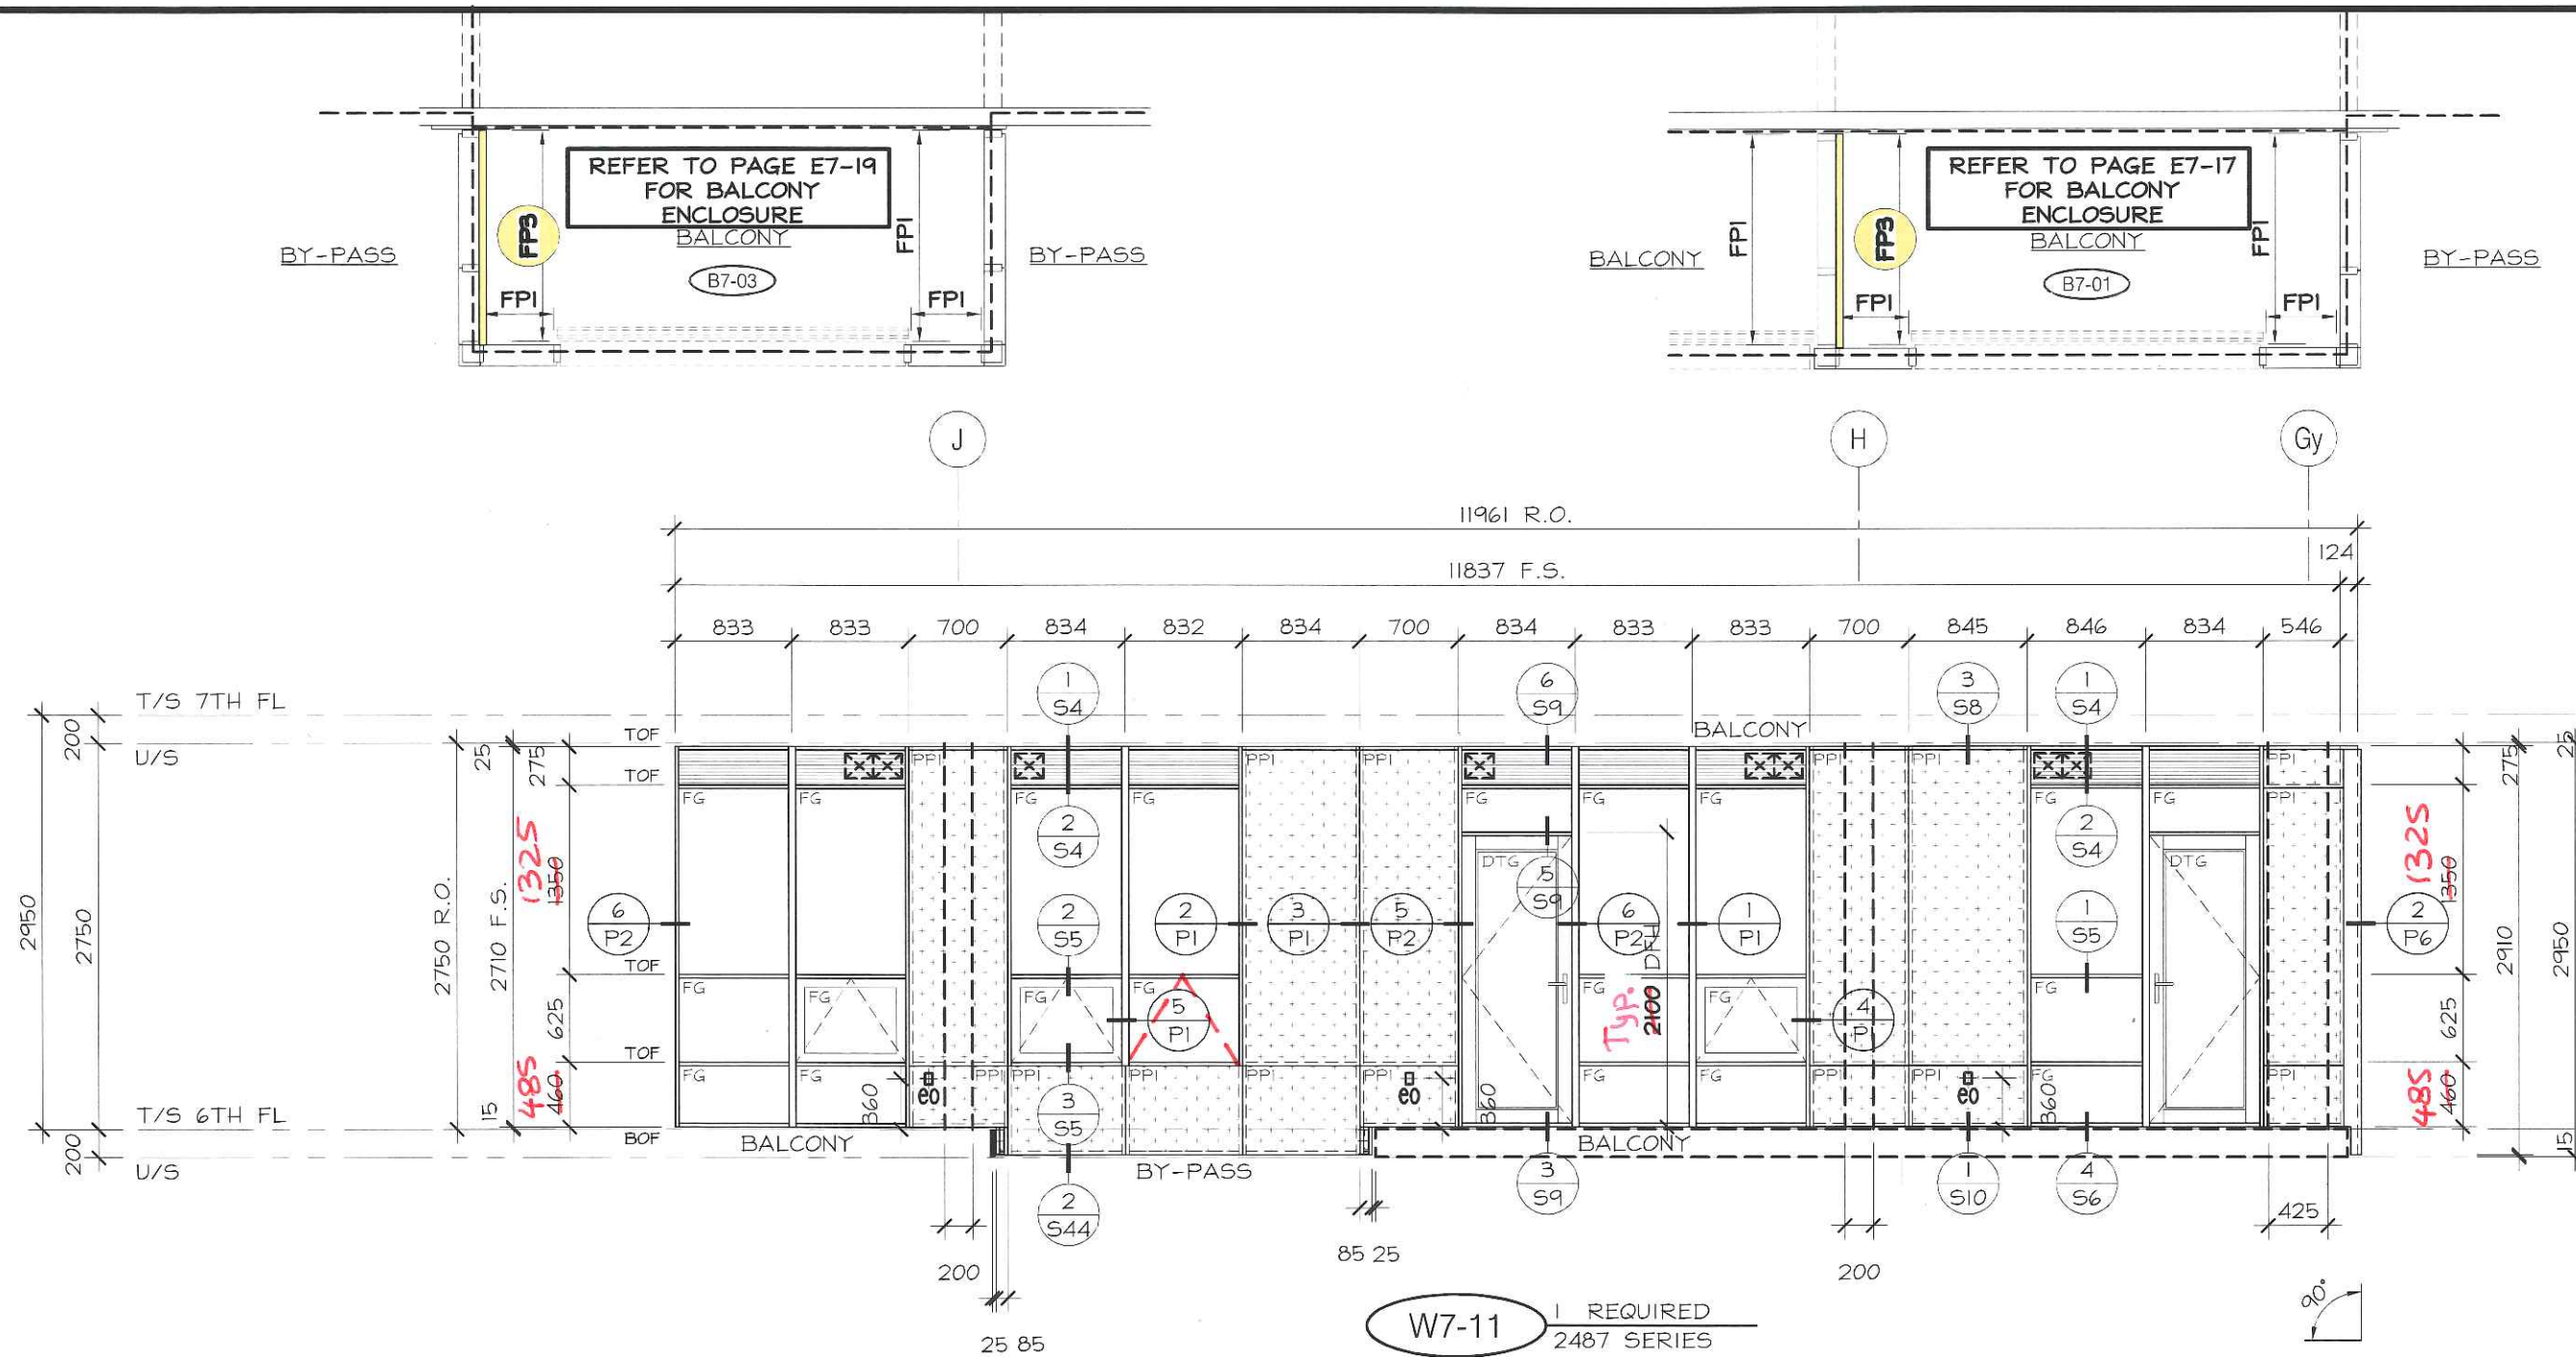


No.	REVISION	BY	DATE

PROJECT NAME:	SQ ALEXANDRA PARK - BLOCK 11
DRAWING TITLE:	7th FLOOR ELEVATIONS
ARCHITECT:	TEEPLE ARCHITECTS
CONTRACTOR:	TRIDEL
SCALE:	1:50
DRAWN BY:	S.C.
DATE:	MARCH 4, 2015


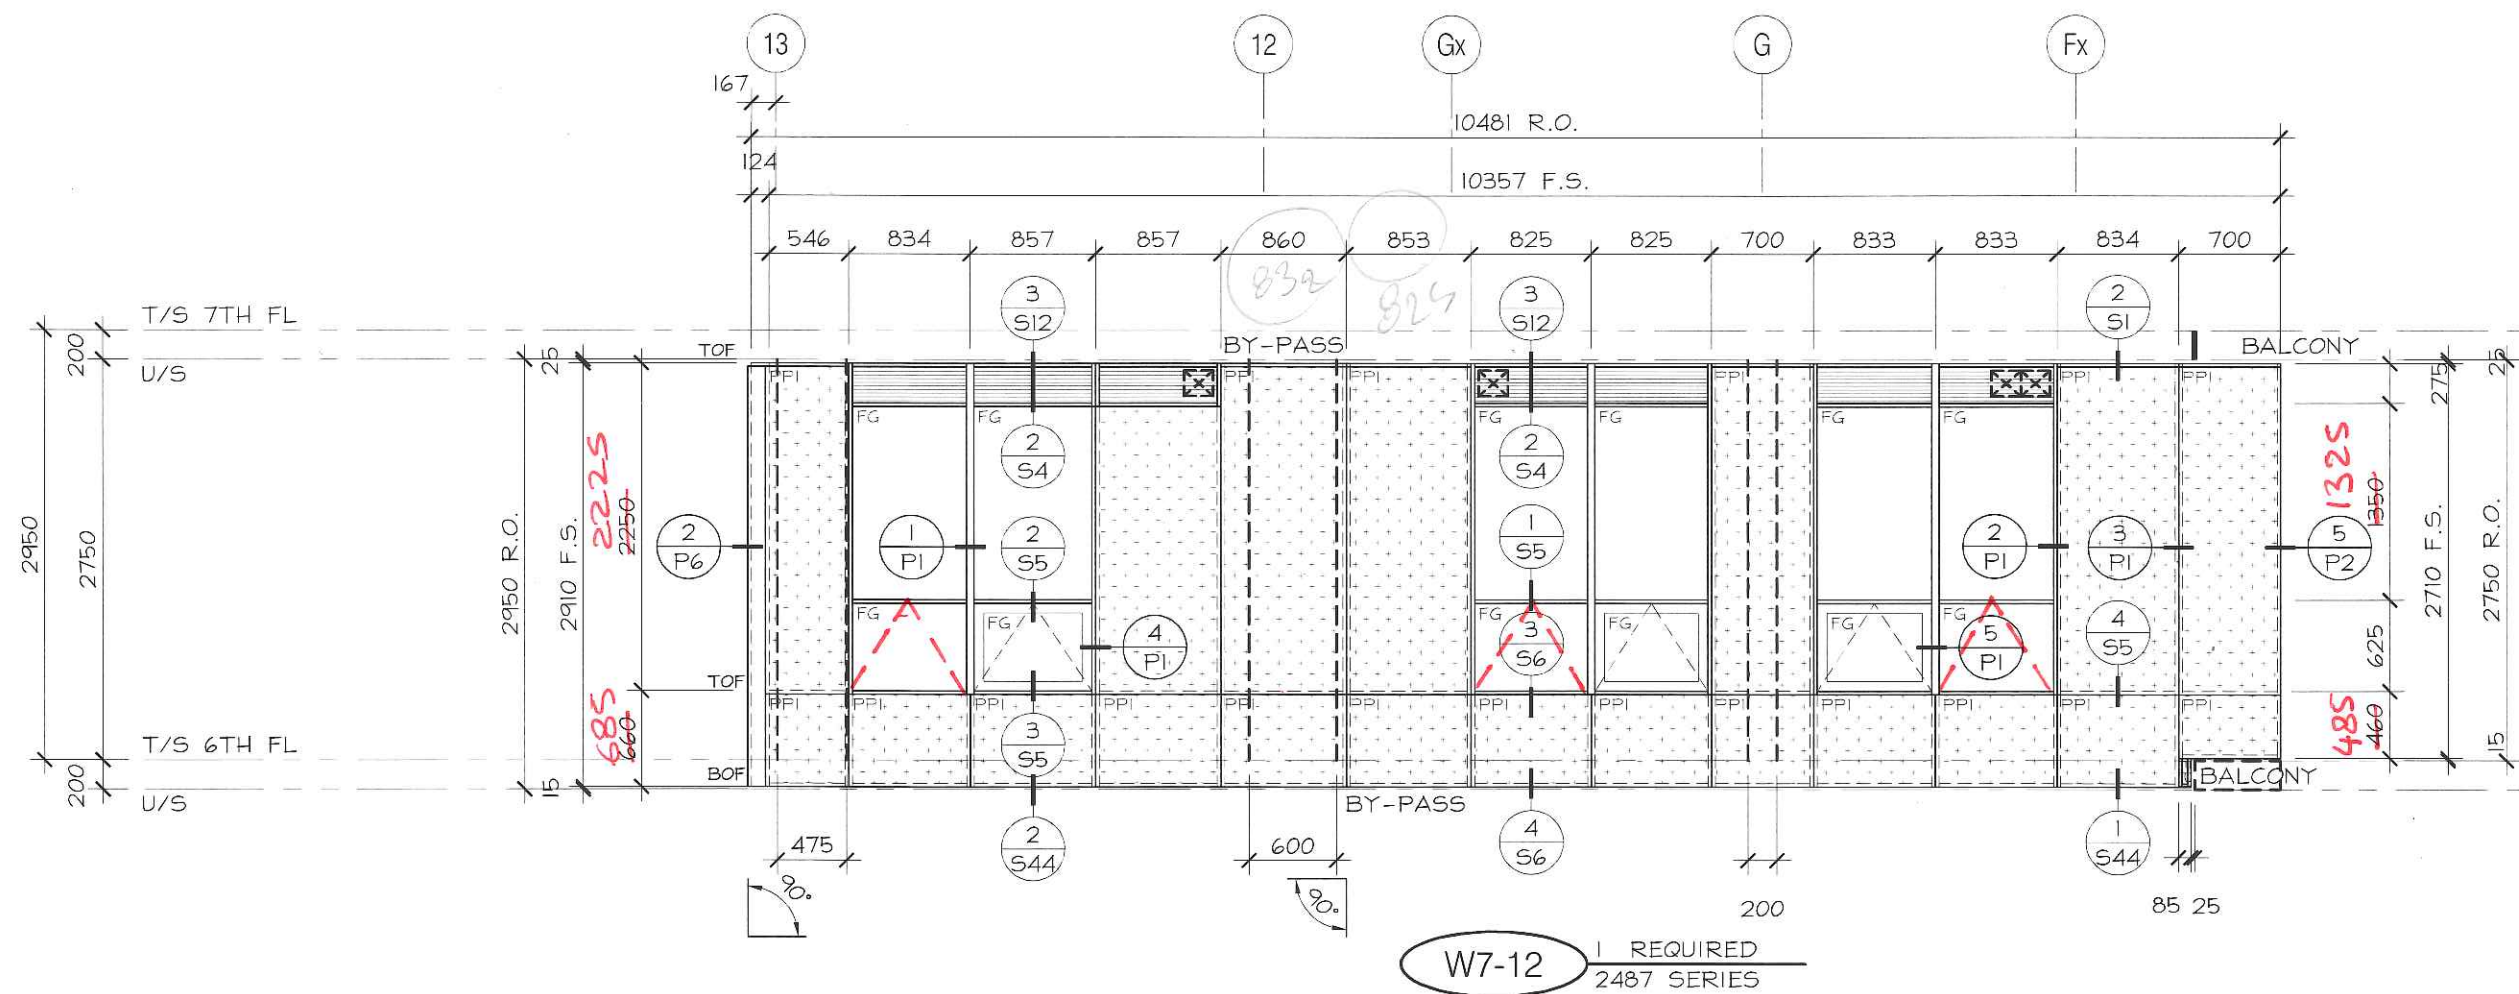


No.	REVISION	BY	DATE

PROJECT NAME:	SQ ALEXANDRA PARK - BLOCK11
DRAWING TITLE:	7th FLOOR ELEVATIONS
ARCHITECT:	TEEPLE ARCHITECTS
CONTRACTOR:	TRIDEL
SCALE:	1:50
DRAWN BY:	S.C.
DATE:	MARCH 4, 2015
DRAWING No.:	E7-12

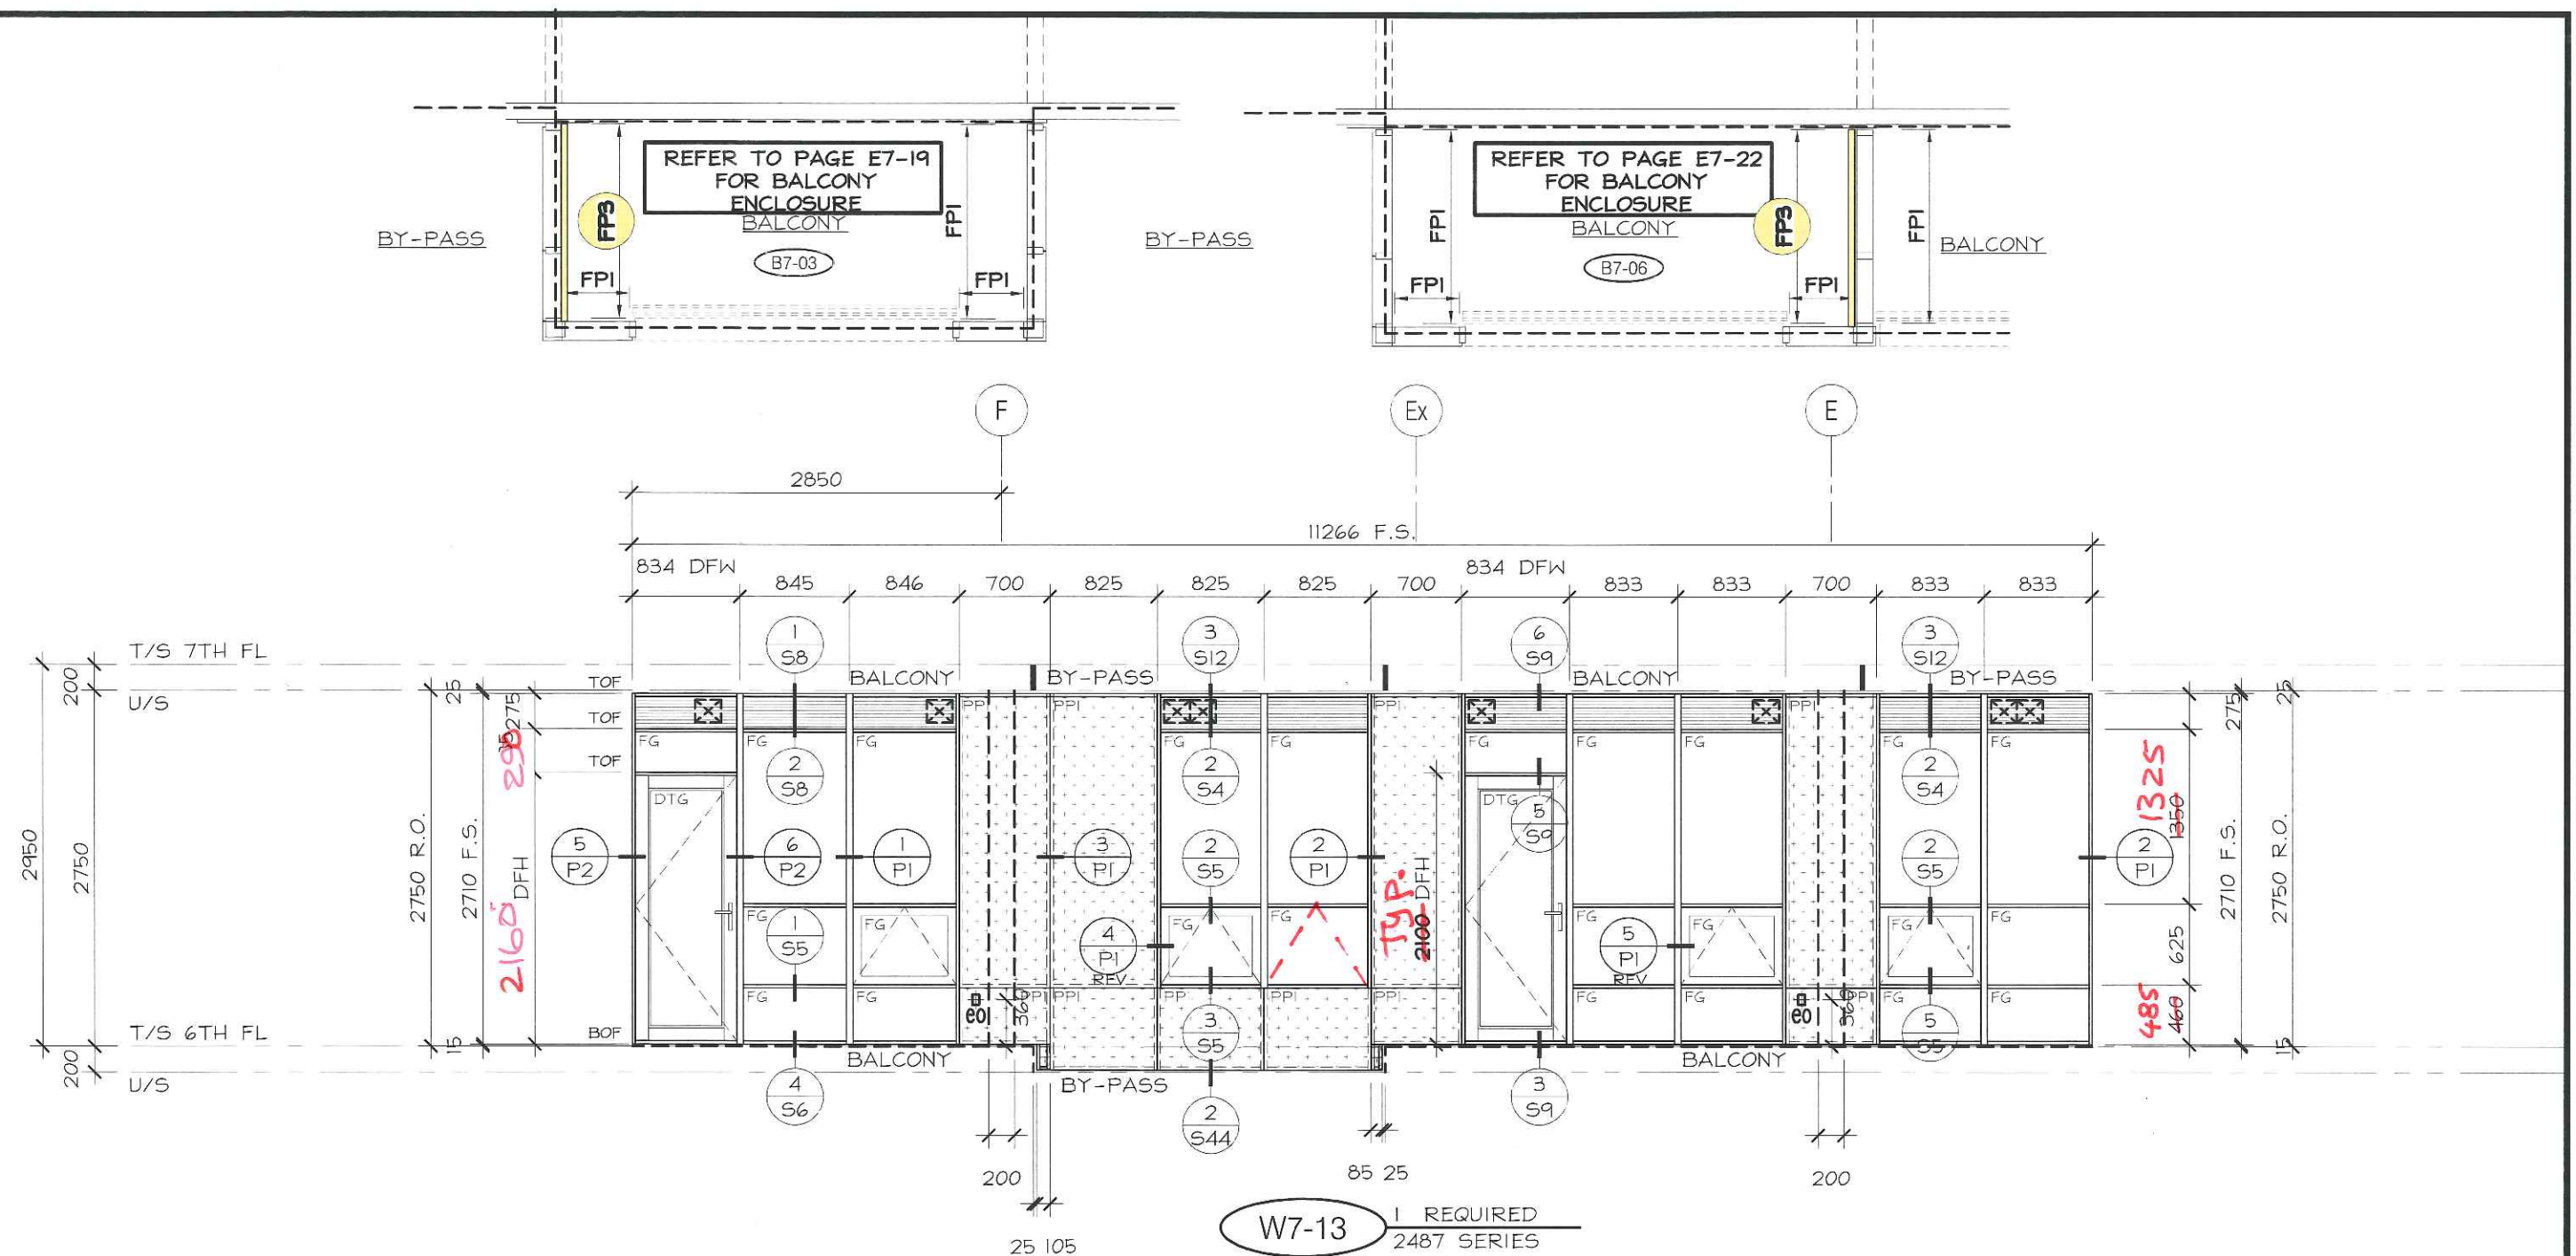

PROJECT NAME: SQ ALEXANDRA PARK - BLOCK11

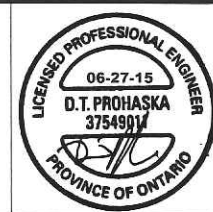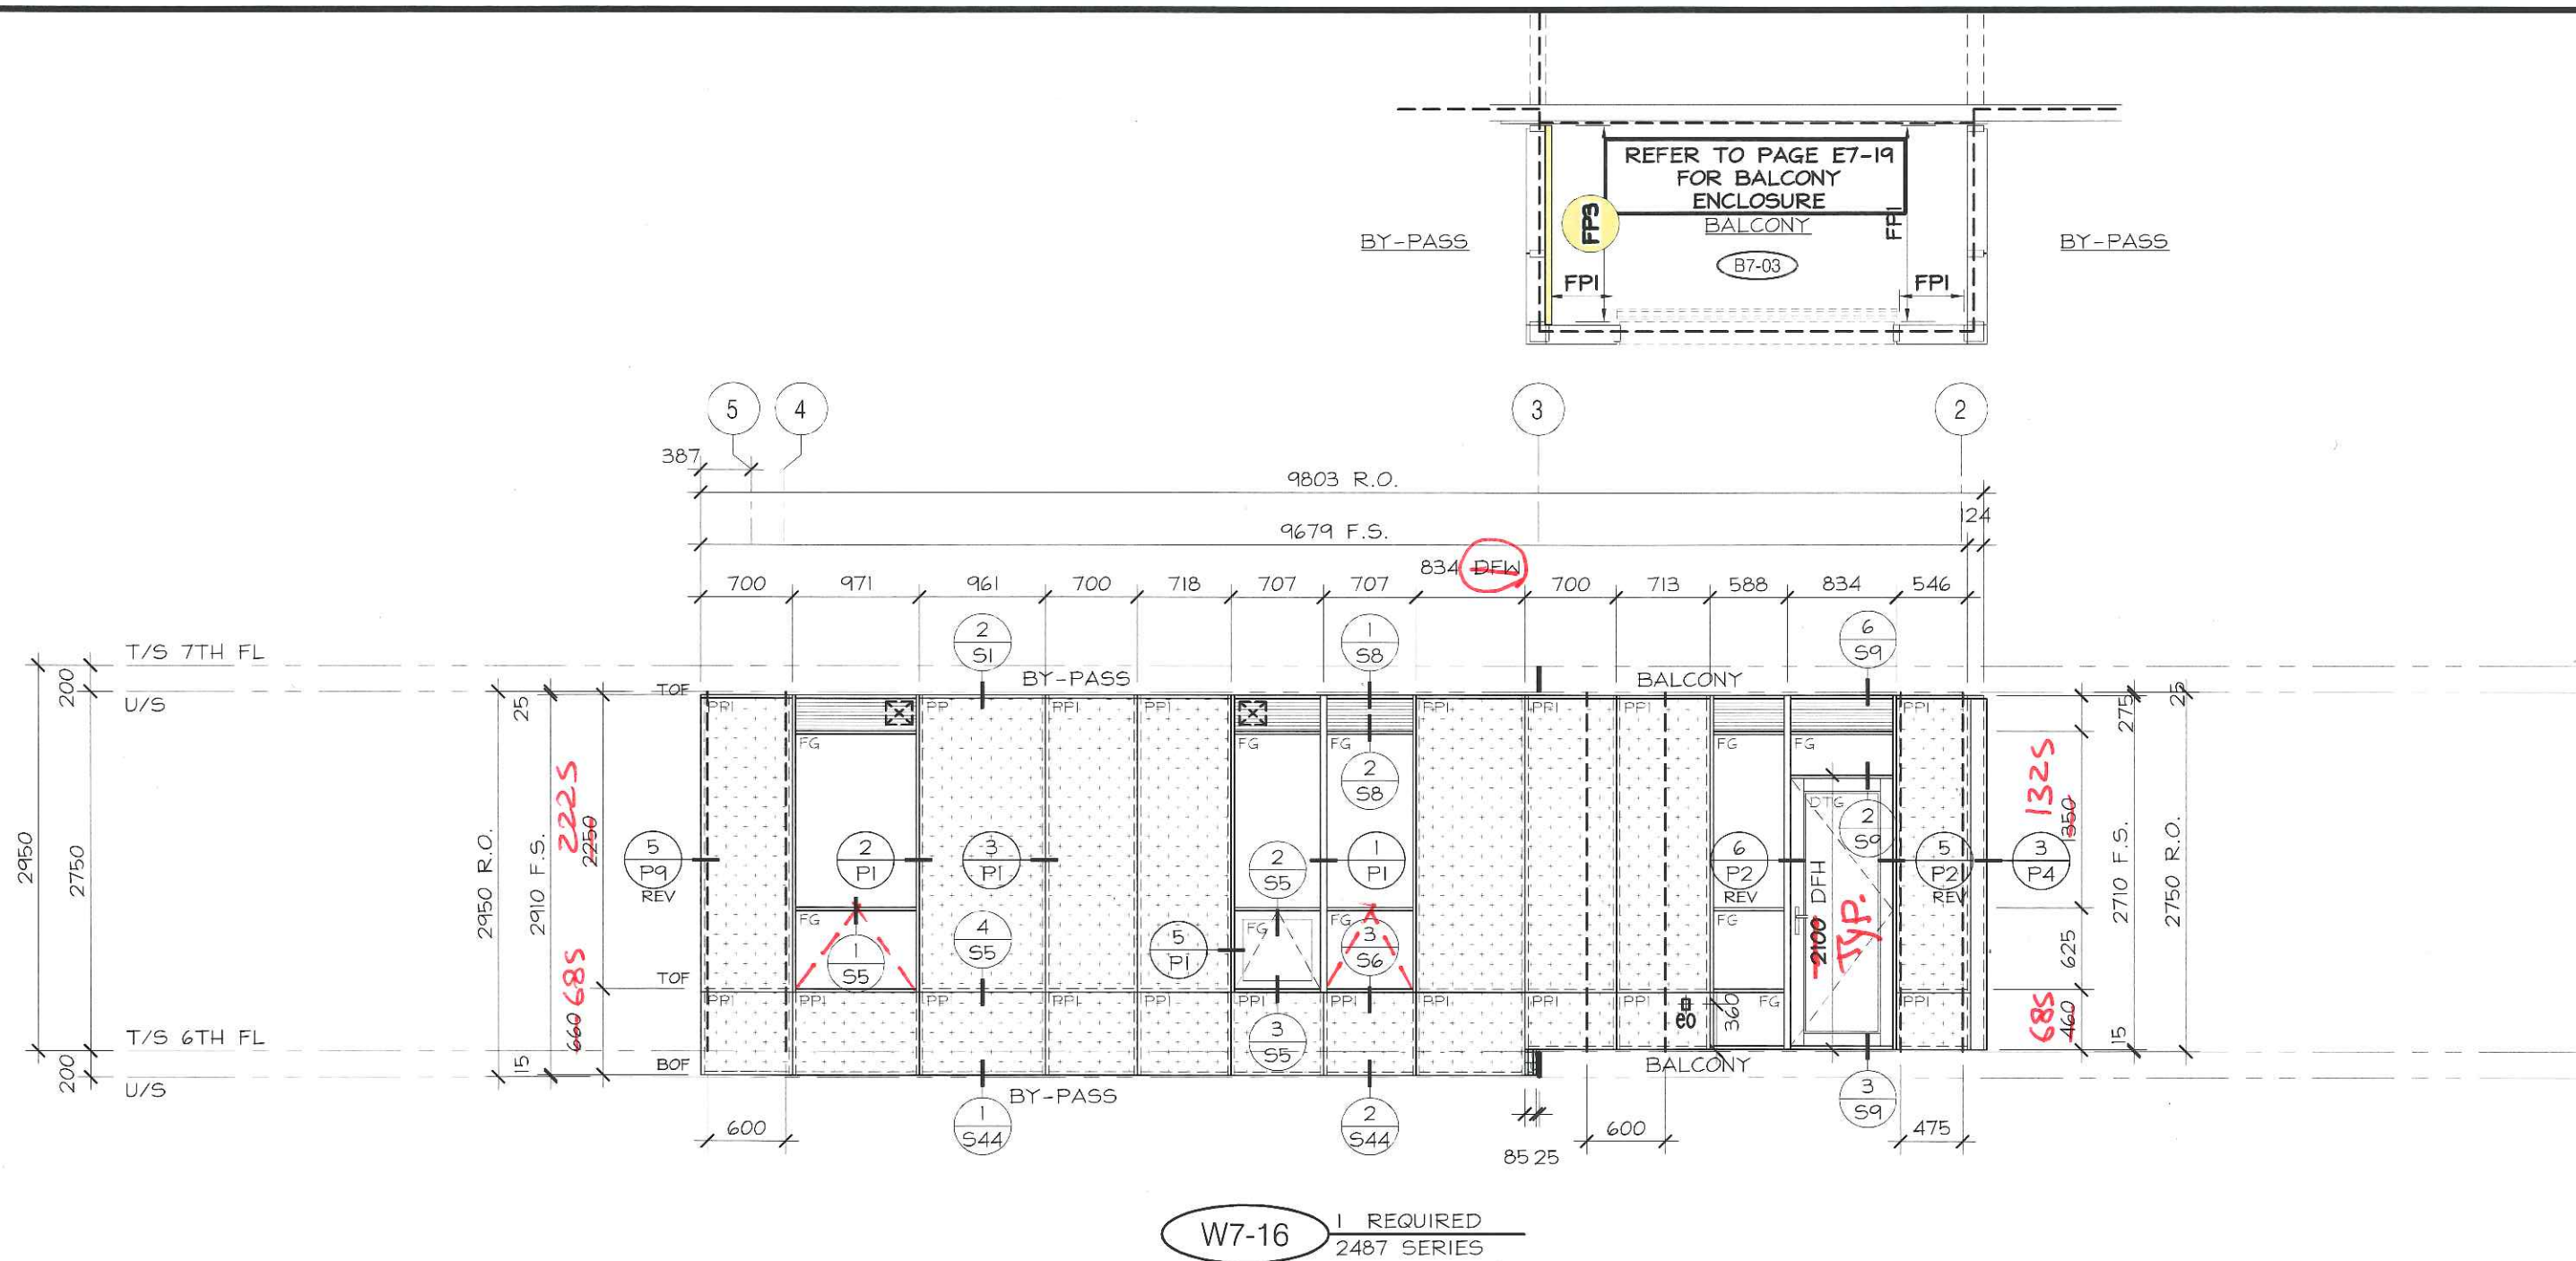



No.	REVISION	BY	DATE

PROJECT NAME:	SQ ALEXANDRA PARK - BLOCK11
DRAWING TITLE:	7th FLOOR ELEVATIONS
ARCHITECT:	TEEPLE ARCHITECTS
CONTRACTOR:	TRIDEL
SCALE:	1:50
DRAWN BY:	S.C.
DATE:	MARCH 4, 2015
DRAWING No.:	E7-16



PROJECT NAME:		SQ ALEXANDRA PARK - BLOCK11	
DRAWING TITLE:		7th FLOOR ELEVATIONS	
ARCHITECT:			DRAWING No.: E7-17
TEEPL ARCHITECTS			
CONTRACTOR:			
TRIDEL			
SCALE:	1:50	DRAWN BY:	S.C.
DATE:		MARCH 4, 2015	

FOR ALUMINUM BALCONY
& TERRACE RAILINGS
REFER TO TORO
ALUMINUM RAILING SHOP
DRAWINGS

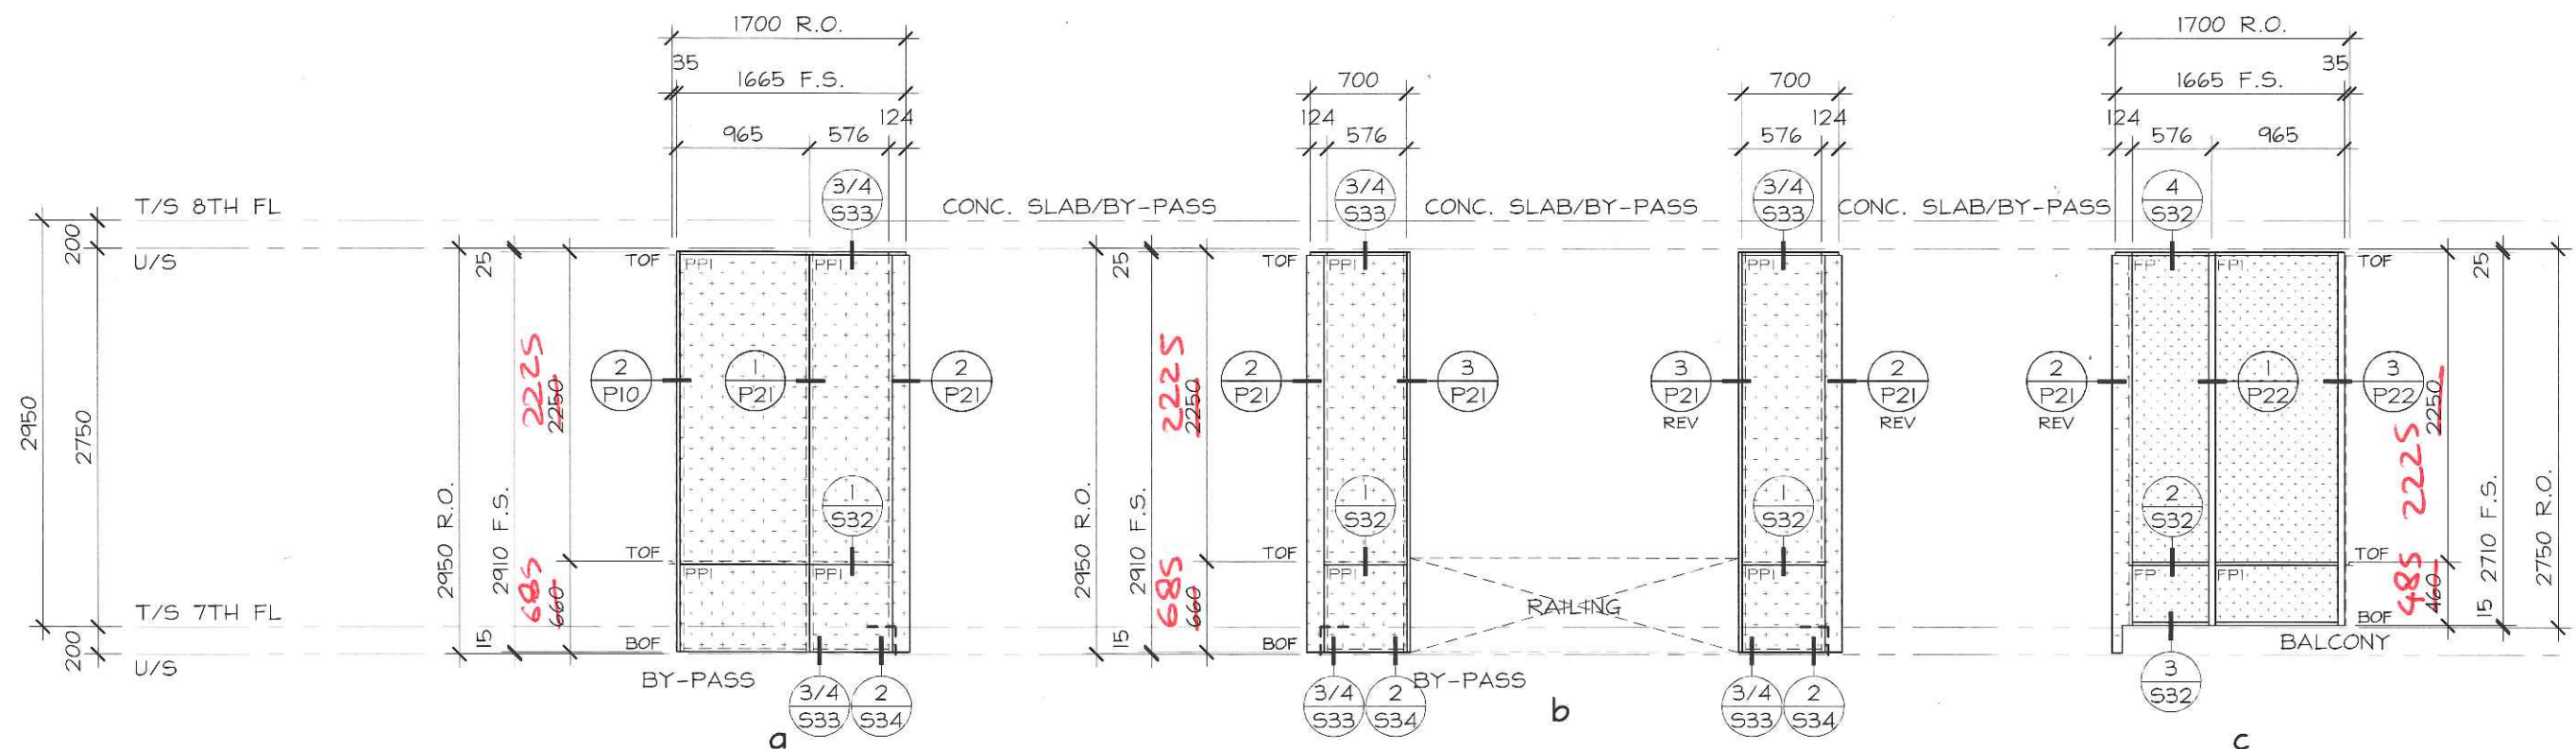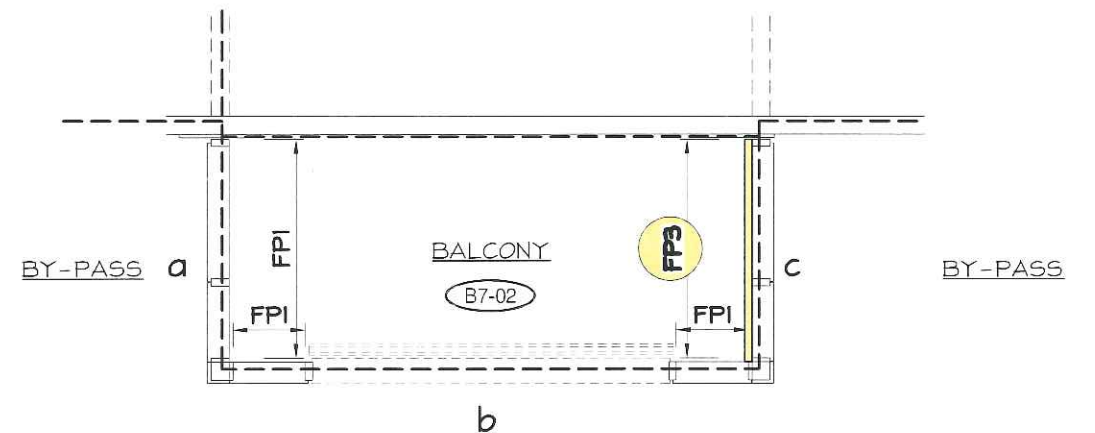

B7-02

4 REQUIRED

2487 SERIES

EXT. FINISH: PPG ACRYNAR PLATINUM UCFX11185

INT. FINISH: PPG ACRYNAR PLATINUM UCFX11185



INT. FINISH: PPG ACRYNAR T.B.D.



No.	REVISION	BY	DATE

PROJECT NAME:	SQ ALEXANDRA PARK - BLOCK11		
DRAWING TITLE:	7th FLOOR ELEVATIONS		
ARCHITECT:	TEEPLE ARCHITECTS		
CONTRACTOR:	TRIDEL		
SCALE: 1:50	DRAWN BY: S.C.	DATE: MARCH 4, 2015	
DRAWING No.:			E7-18

FOR ALUMINUM BALCONY
& TERRACE RAILINGS
REFER TO TORO
ALUMINUM RAILING SHOP
DRAWINGS

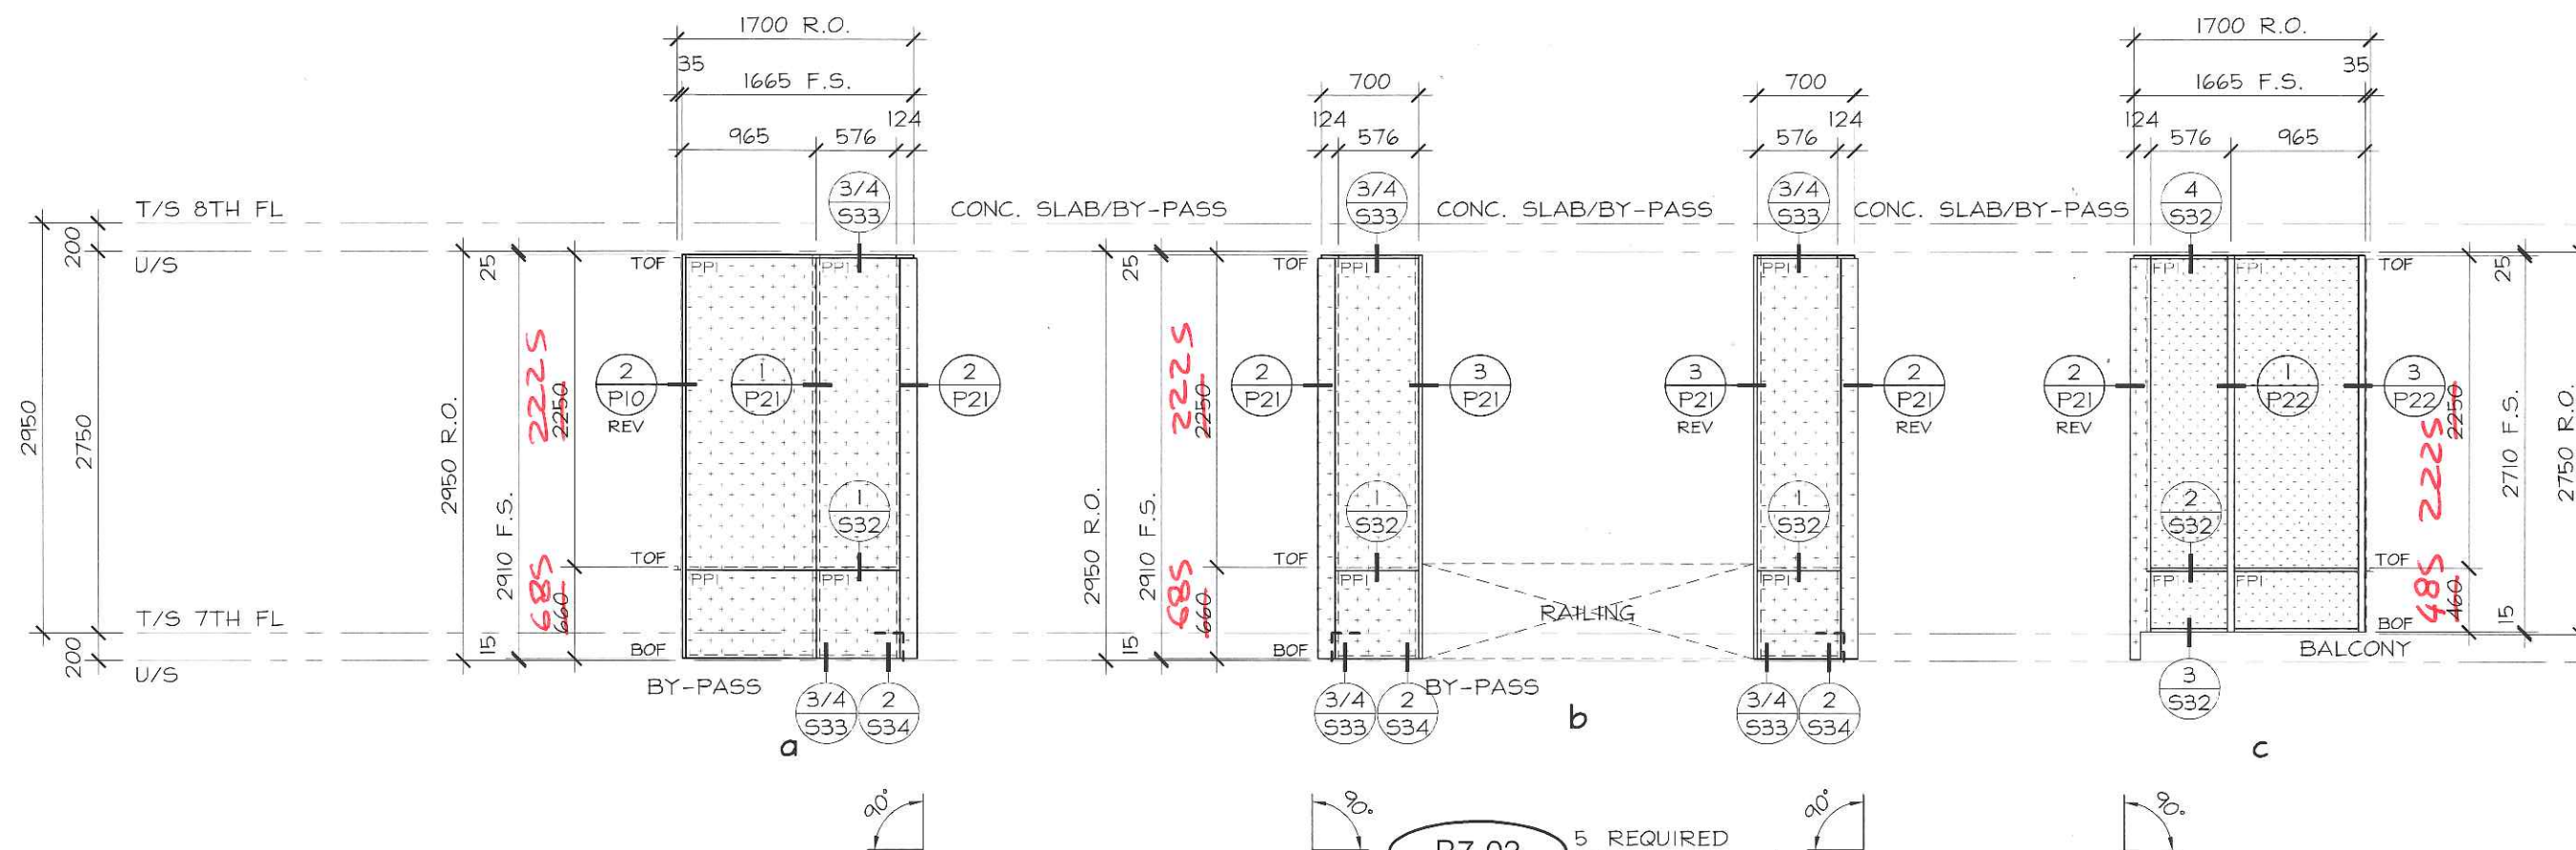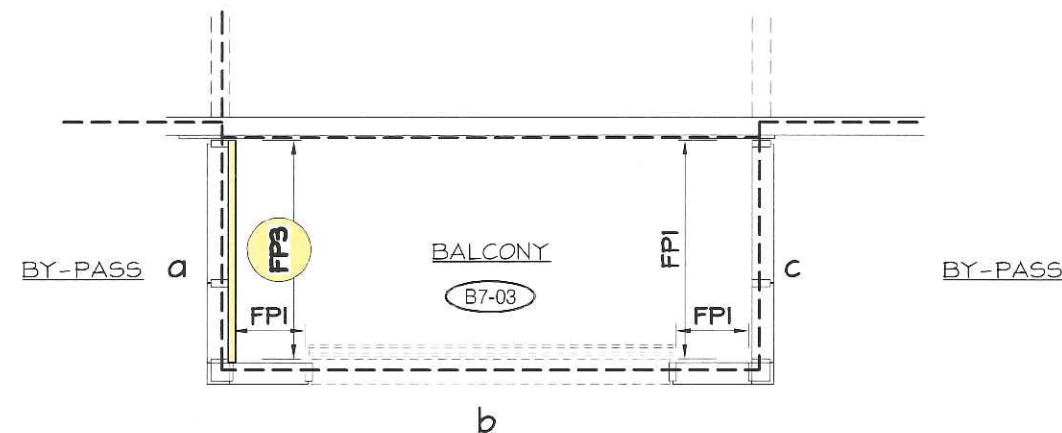

B7-03

5 REQUIRED

2487 SERIES
EXT. FINISH: PPG ACRYNAR PLATINUM UCFX11185
INT. FINISH: PPG ACRYNAR PLATINUM UCFX11185
INT. FINISH: PPG ACRYNAR T.B.D.



No.	REVISION	BY	DATE

PROJECT NAME: SQ ALEXANDRA PARK - BLOCK11

DRAWING TITLE: 7th FLOOR ELEVATIONS

ARCHITECT: TEEPLE ARCHITECTS

CONTRACTOR: TRIDEL


SCALE: 1:50

DRAWN BY: S.C.

DATE: MARCH 4, 2015

DRAWING No.:

E7-19

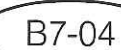



**TORO
ALUMINUM**

COMMERCIAL INDUSTRIAL RESIDENTIAL

330 APPLEWOOD CRESCENT TEL: (905) 738-5220
CONCORD, ON, CANADA FAX: (905) 738-5481
L4K 4V2 WWW.TOROALUMINUM.COM

E7-20

FOR ALUMINUM BALCONY
& TERRACE RAILINGS
REFER TO TORO
ALUMINUM RAILING SHOP
DRAWINGS

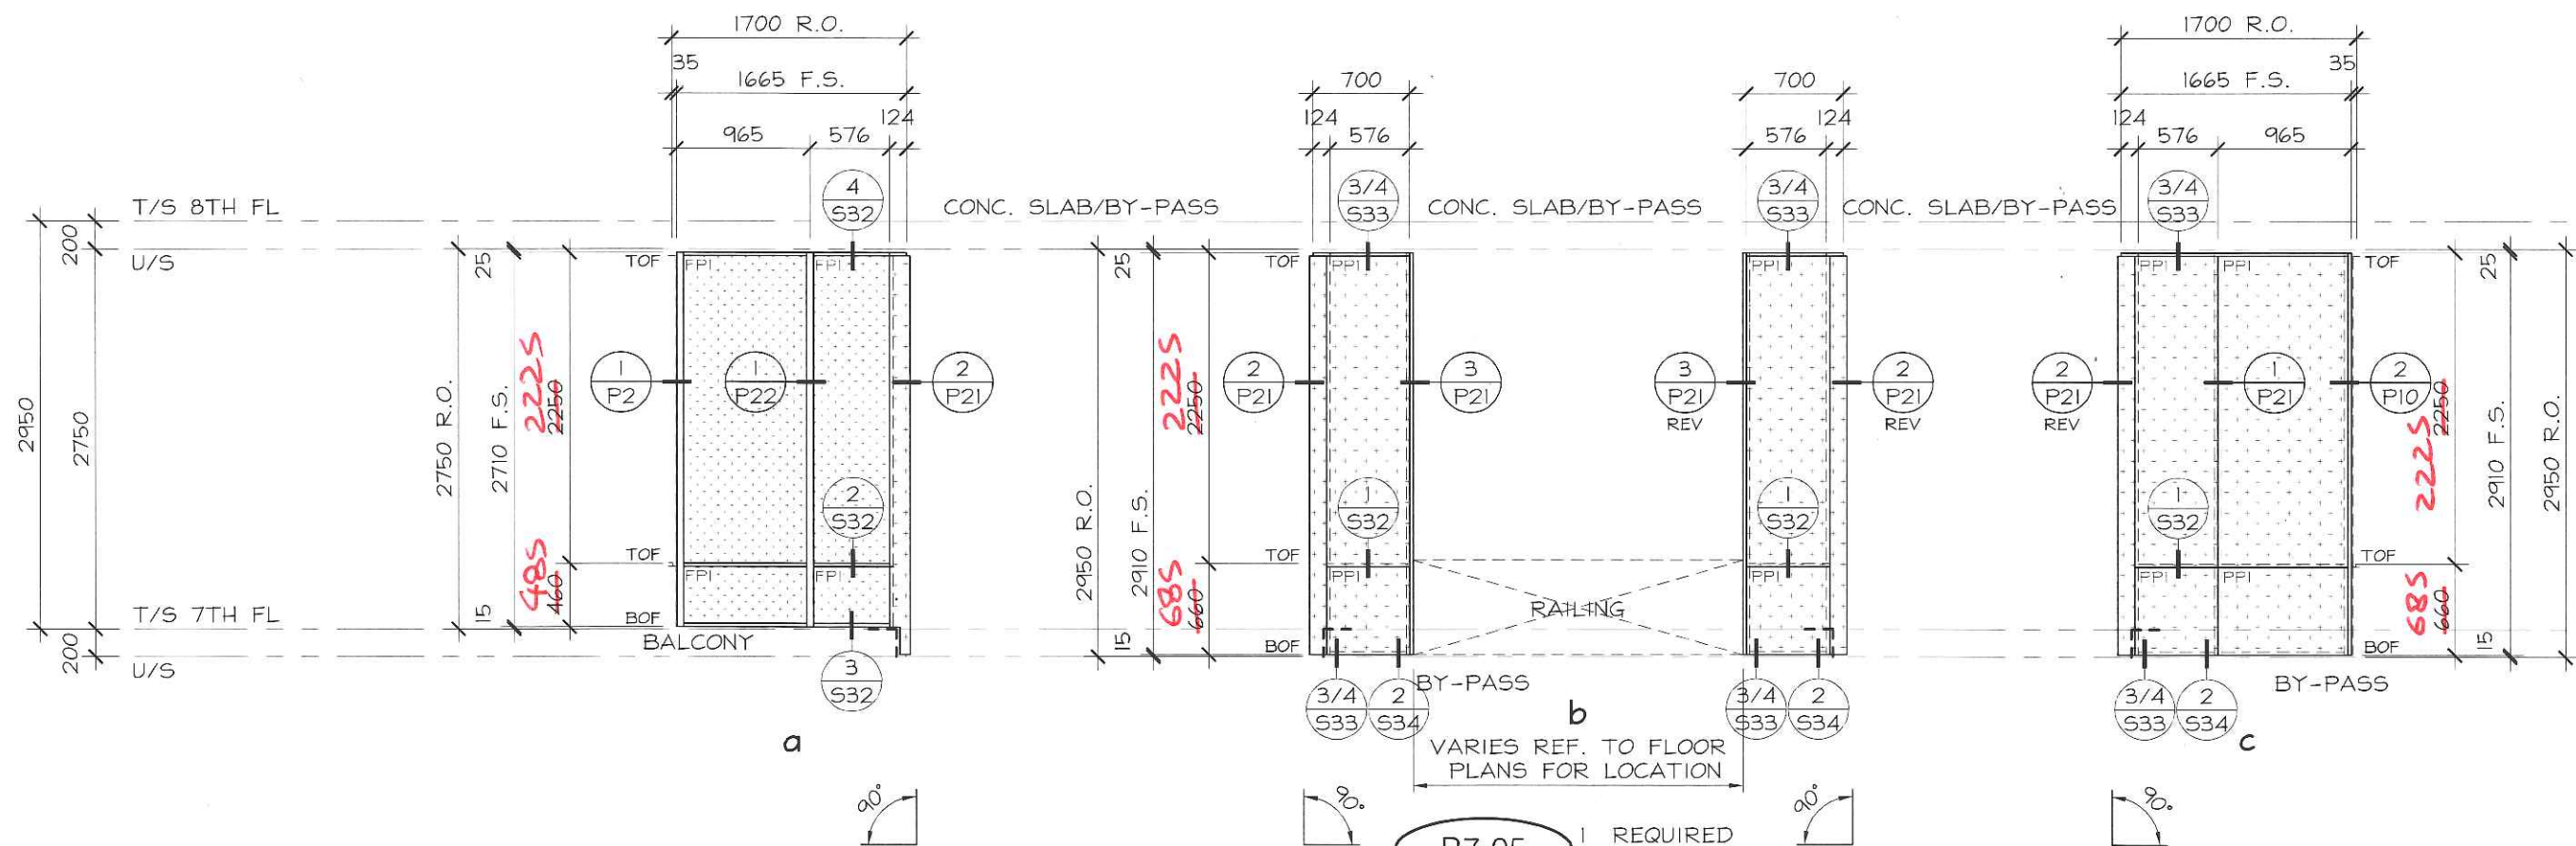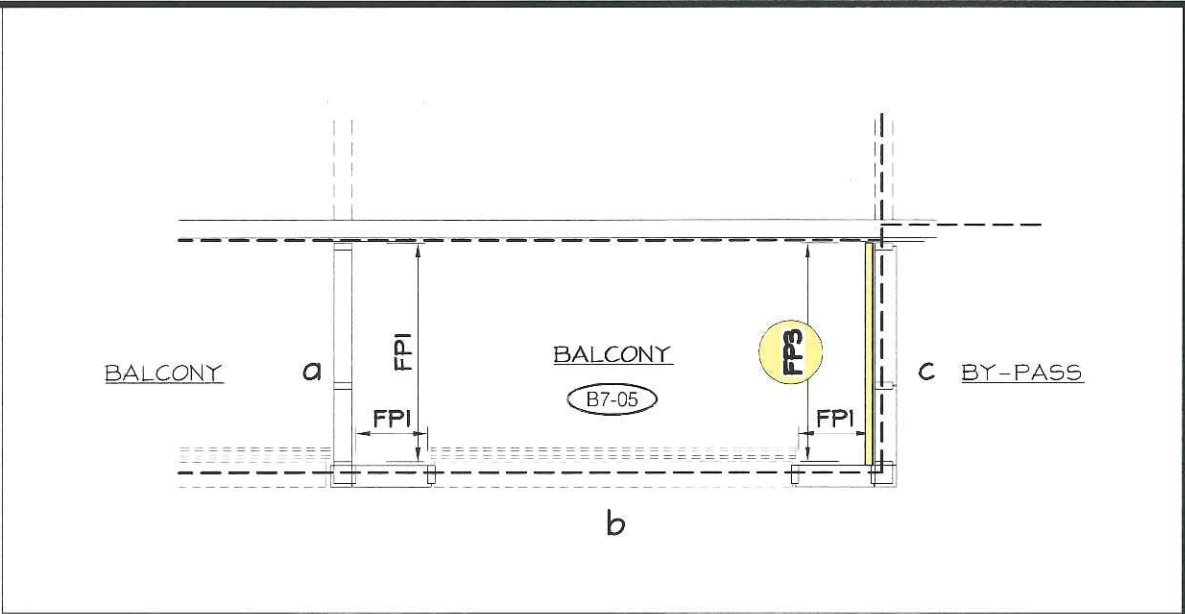



B7-05 1 REQUIRED
2487 SERIES
EXT. FINISH: PPG ACRYNAR PLATINUM UCFX11185
INT. FINISH: PPG ACRYNAR PLATINUM UCFX11185
c INT. FINISH: PPG ACRYNAR T.B.D.



No.	REVISION	BY	DATE

PROJECT NAME:	SQ ALEXANDRA PARK - BLOCK11
DRAWING TITLE:	7th FLOOR ELEVATIONS
ARCHITECT:	TEEPLE ARCHITECTS
CONTRACTOR:	TRIDEL
SCALE:	1:50
DRAWN BY:	S.C.
DATE:	MARCH 4, 2015
DRAWING No.:	E7-21

FOR ALUMINUM BALCONY
& TERRACE RAILINGS
REFER TO TORO
ALUMINUM RAILING SHOP
DRAWINGS

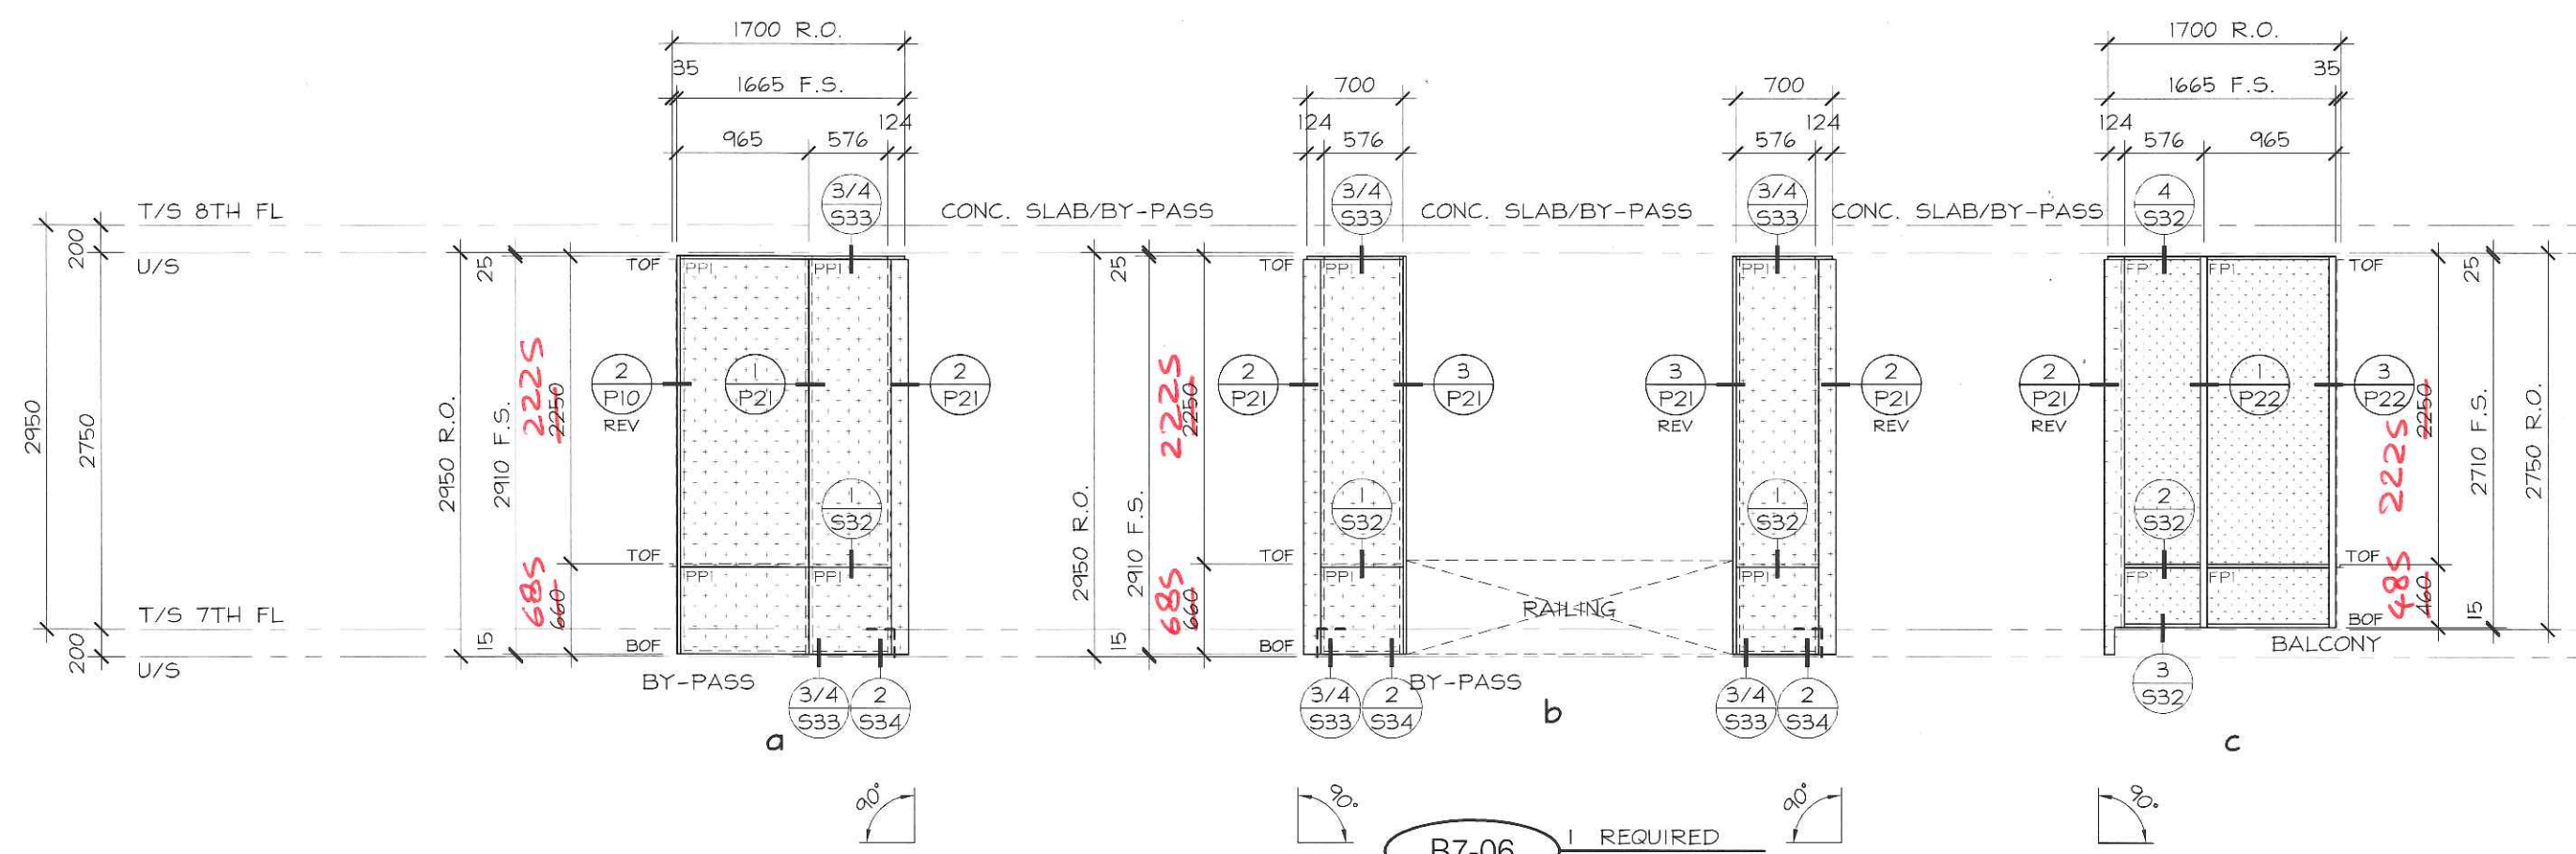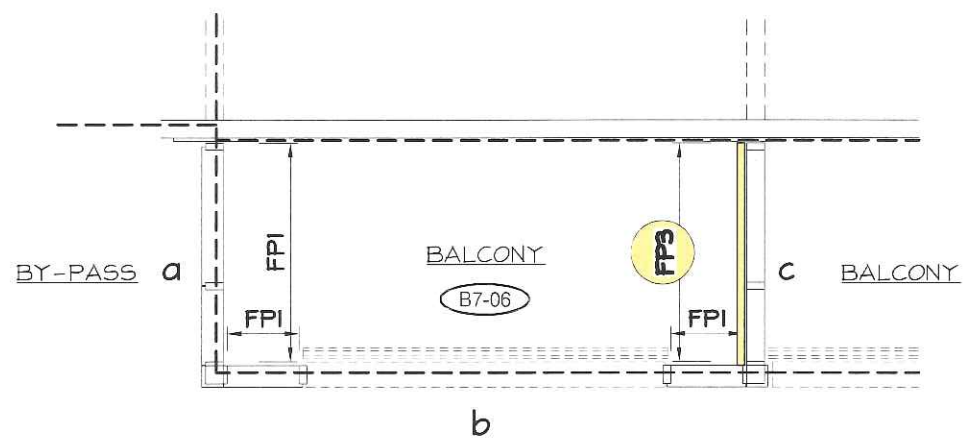

B7-06 1 REQUIRED
2487 SERIES
EXT. FINISH: PPG ACRYNAR PLATINUM UCFXIII85
INT. FINISH: PPG ACRYNAR PLATINUM UCFXIII85
C INT. FINISH: PPG ACRYNAR T.B.D.


TORO ALUMINUM
COMMERCIAL INDUSTRIAL RESIDENTIAL
330 APPLEWOOD CRESCENT TEL: (905) 738-5220
CONCORD, ON, CANADA FAX: (905) 738-5481
L4K 4V2 WWW.TOROALUMINUM.COM

LICENSED PROFESSIONAL ENGINEER
06-27-15
D.T. PROHASKA
37549917
PROVINCE OF ONTARIO


No.	REVISION	BY	DATE

PROJECT NAME: SQ ALEXANDRA PARK - BLOCK11	
DRAWING TITLE: 7th FLOOR ELEVATIONS	
ARCHITECT: TEEPLE ARCHITECTS	DRAWING No.:
CONTRACTOR: TRIDEL	E7-22
SCALE: 1:50	DRAWN BY: S.C.
DATE: MARCH 4, 2015	

FOR ALUMINUM BALCONY
& TERRACE RAILINGS
REFER TO TORO
ALUMINUM RAILING SHOP
DRAWINGS

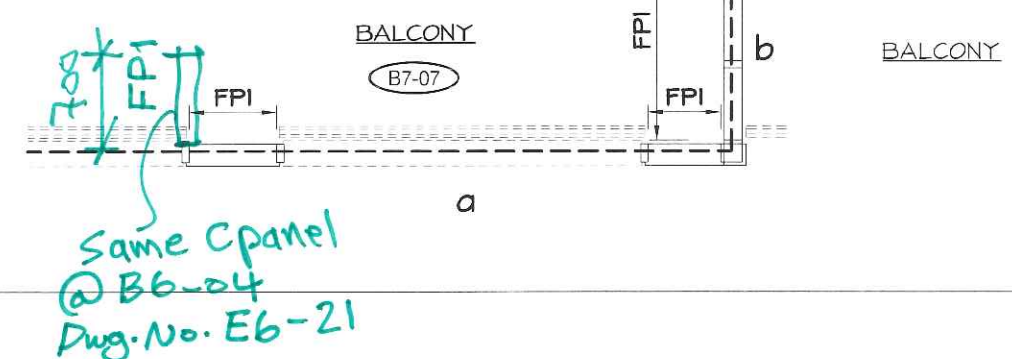

Same Cpanel
@ B6-04
Dwg. No. E6-21

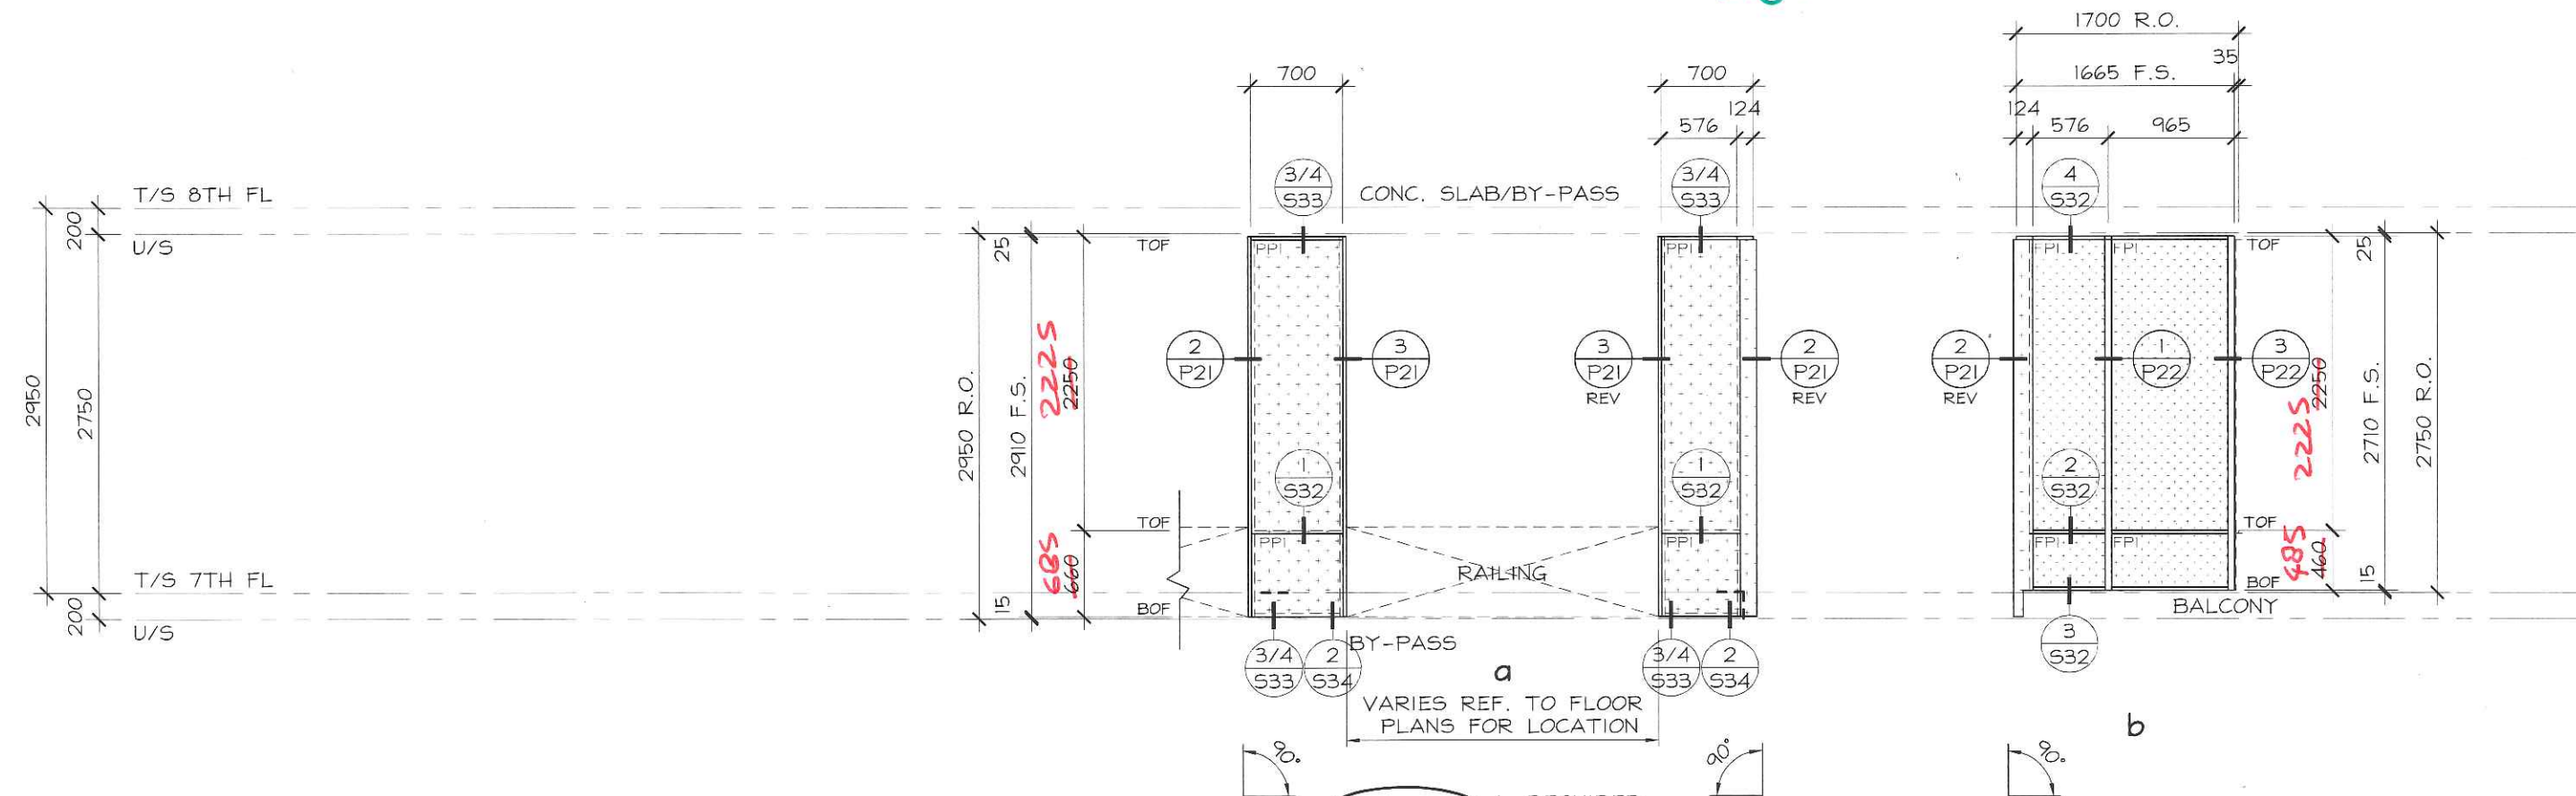

B7-07 1 REQUIRED
2487 SERIES
EXT. FINISH: PPG ACRYNAR PLATINUM UCFX11185
INT. FINISH: PPG ACRYNAR PLATINUM UCFX11185

TORO ALUMINUM
COMMERCIAL INDUSTRIAL RESIDENTIAL
330 APPLEWOOD CRESCENT TEL: (905) 738-5220
CONCORD, ON, CANADA FAX: (905) 738-5481
L4K 4V2 WWW.TOROALUMINUM.COM

LICENSED PROFESSIONAL ENGINEER
06-27-15
D.T. PROHASKA
37549817
PROVINCE OF ONTARIO

No.	REVISION	BY	DATE

PROJECT NAME: **SQ ALEXANDRA PARK - BLOCK11**
DRAWING TITLE: **7th FLOOR ELEVATIONS**
ARCHITECT: **TEEPLE ARCHITECTS**
CONTRACTOR: **TRIDEL**
SCALE: **1:50** DRAWN BY: **S.C.** DATE: **MARCH 4, 2015**
DRAWING No.: **E7-23**