
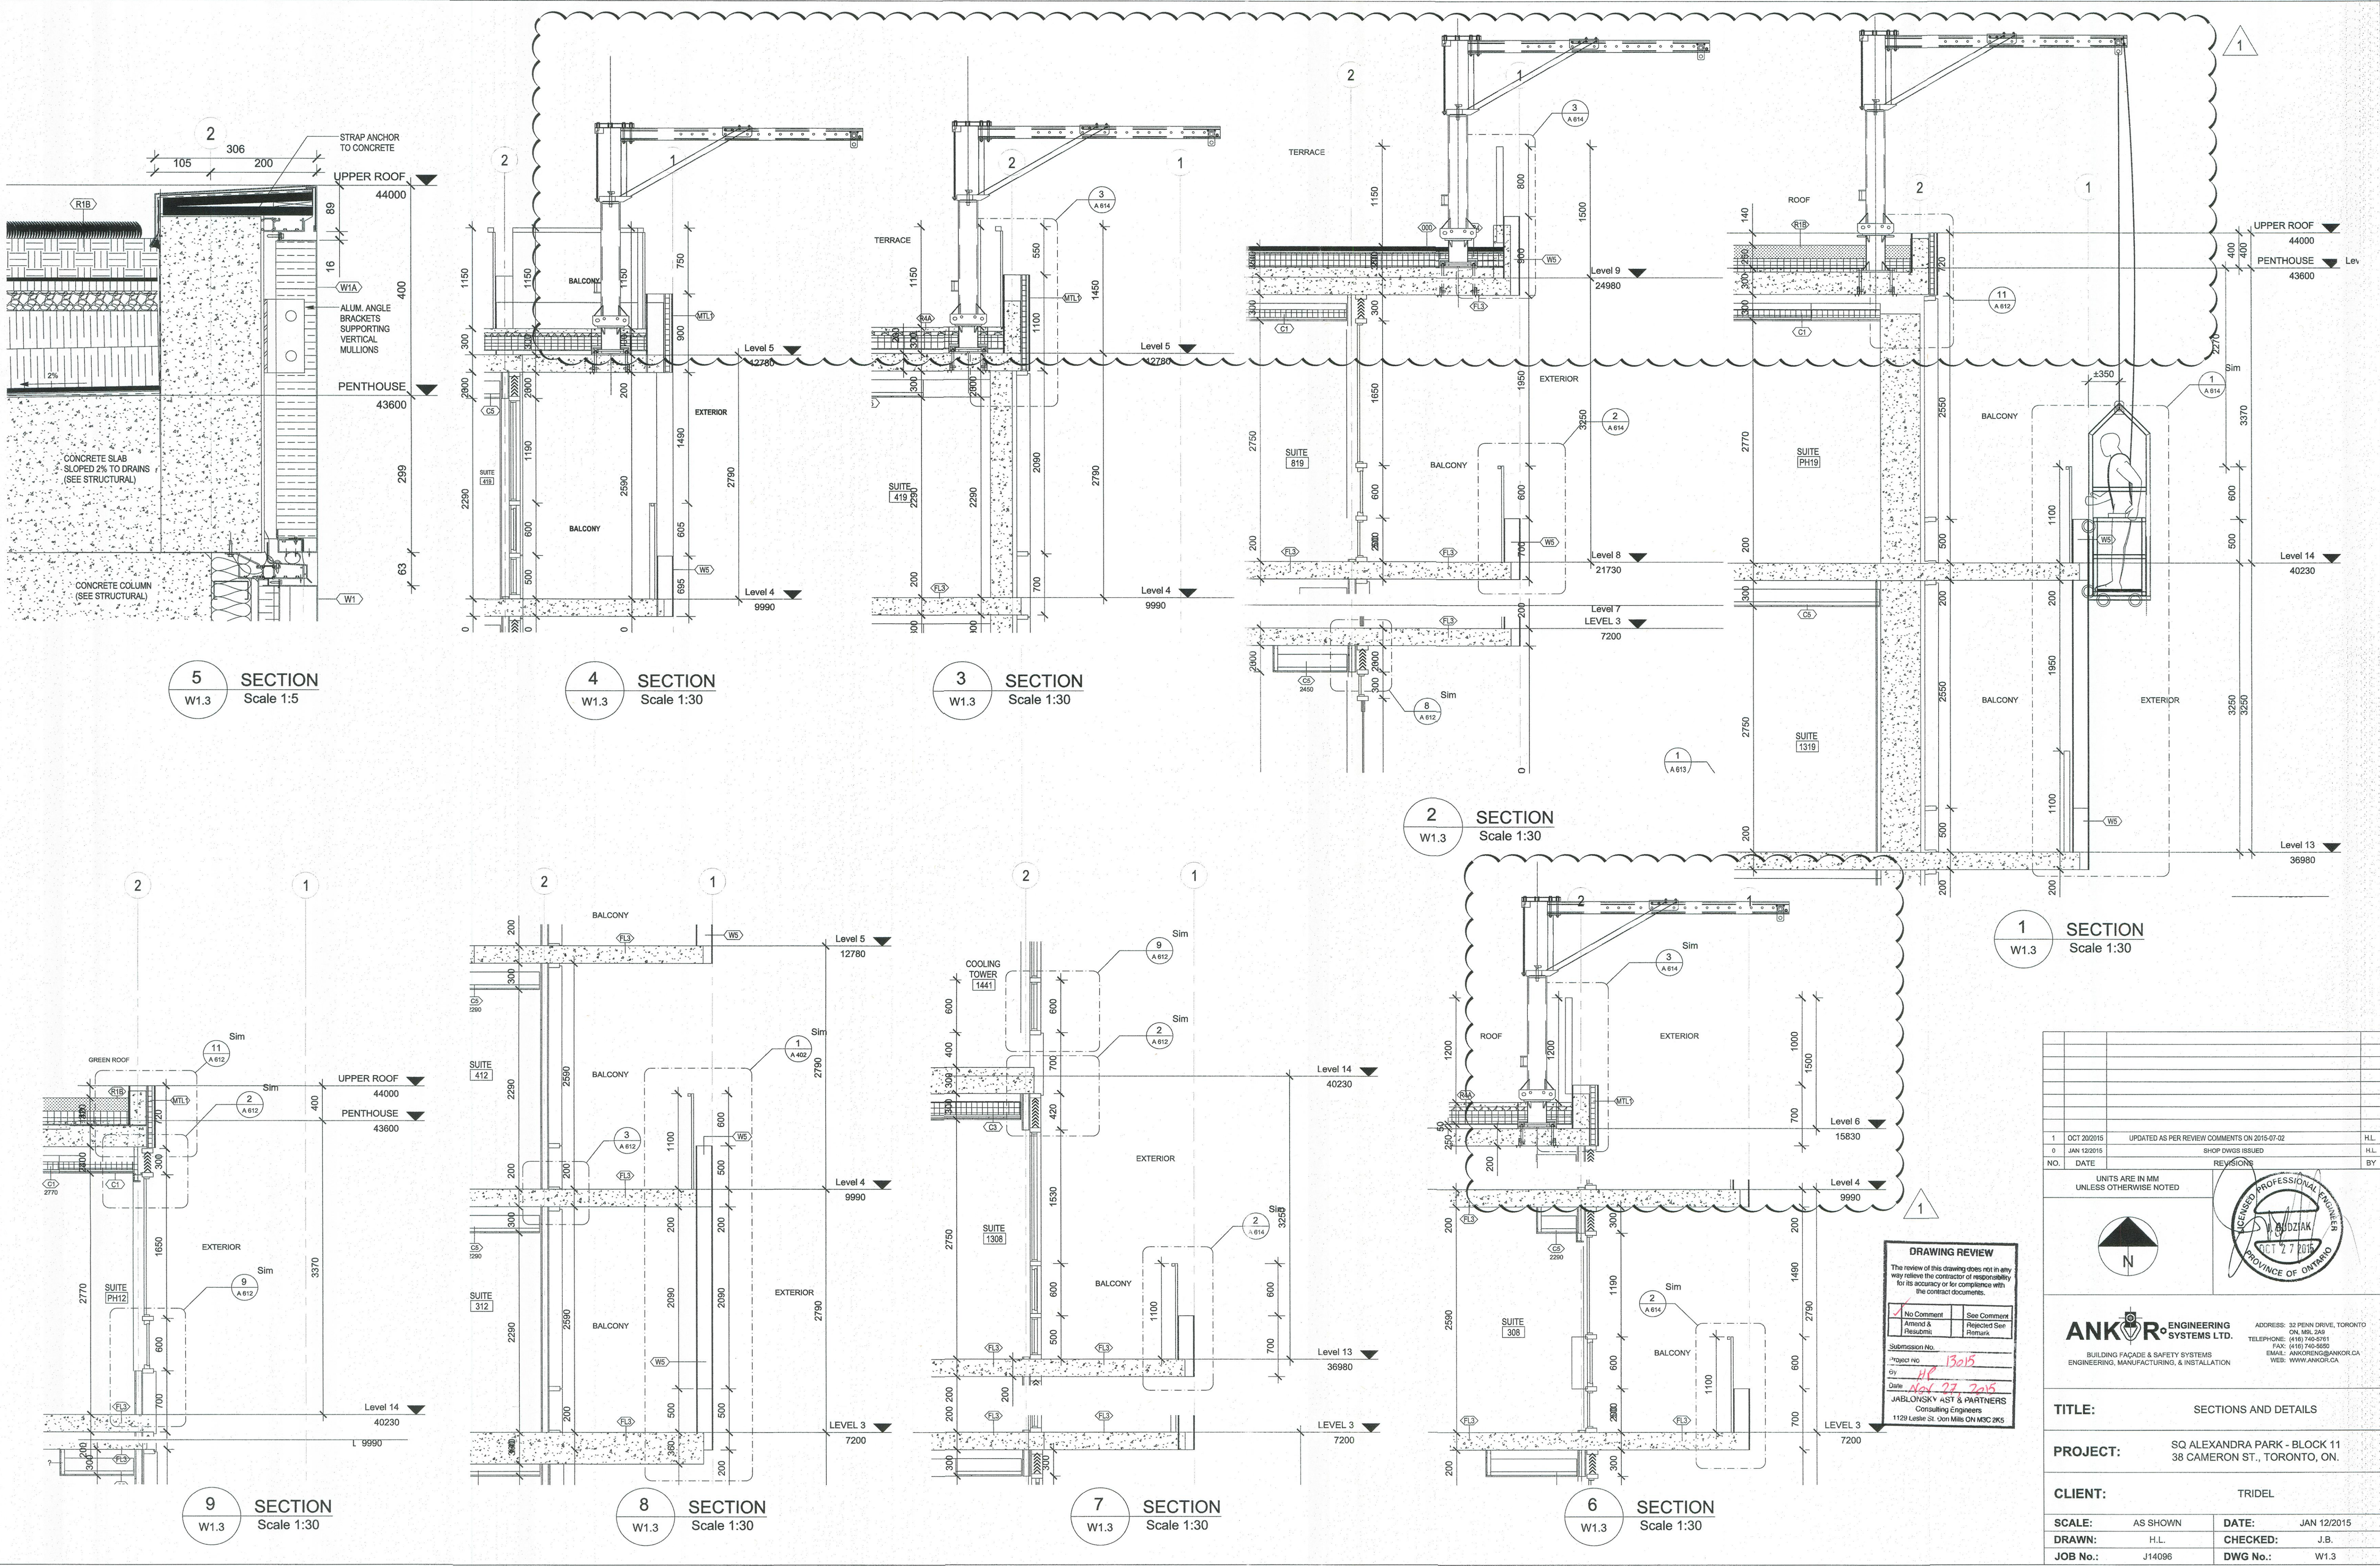
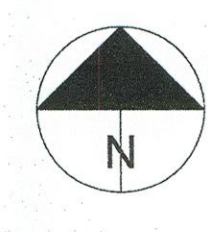


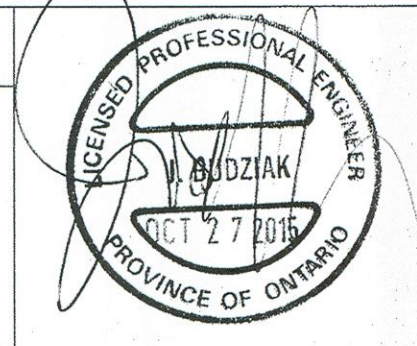

1	OCT 2020/15	UPDATED AS PER REVIEW COMMENTS ON 2015-07-02	H.L.
0	JAN 12/2015	SHOP DWGS ISSUED	H.L.
NO.	DATE	REVISIONS	BY
UNITS ARE IN MM UNLESS OTHERWISE NOTED			
			
			
ANKOR ENGINEERING SYSTEMS LTD. BUILDING FACADE & SAFETY SYSTEMS ENGINEERING, MANUFACTURING, & INSTALLATION			
ADDRESS: 32 PENN DRIVE, TORONTO, ON M6H 2M6 TELEPHONE: (416) 740-8391 FAX: (416) 740-8392 EMAIL: ANKORENG@ANKOR.CA WEB: WWW.ANKOR.CA			
TITLE: SECTIONS AND DETAILS			
PROJECT: SQ ALEXANDRA PARK - BLOCK 11 38 CAMERON ST., TORONTO, ON.			
CLIENT: TRIDEL			
SCALE: AS SHOWN	DATE: JAN 12/2015		
DRAWN: H.L.	CHECKED: J.B.		
JOB No.: J14096	DWG No.: W1.3		