




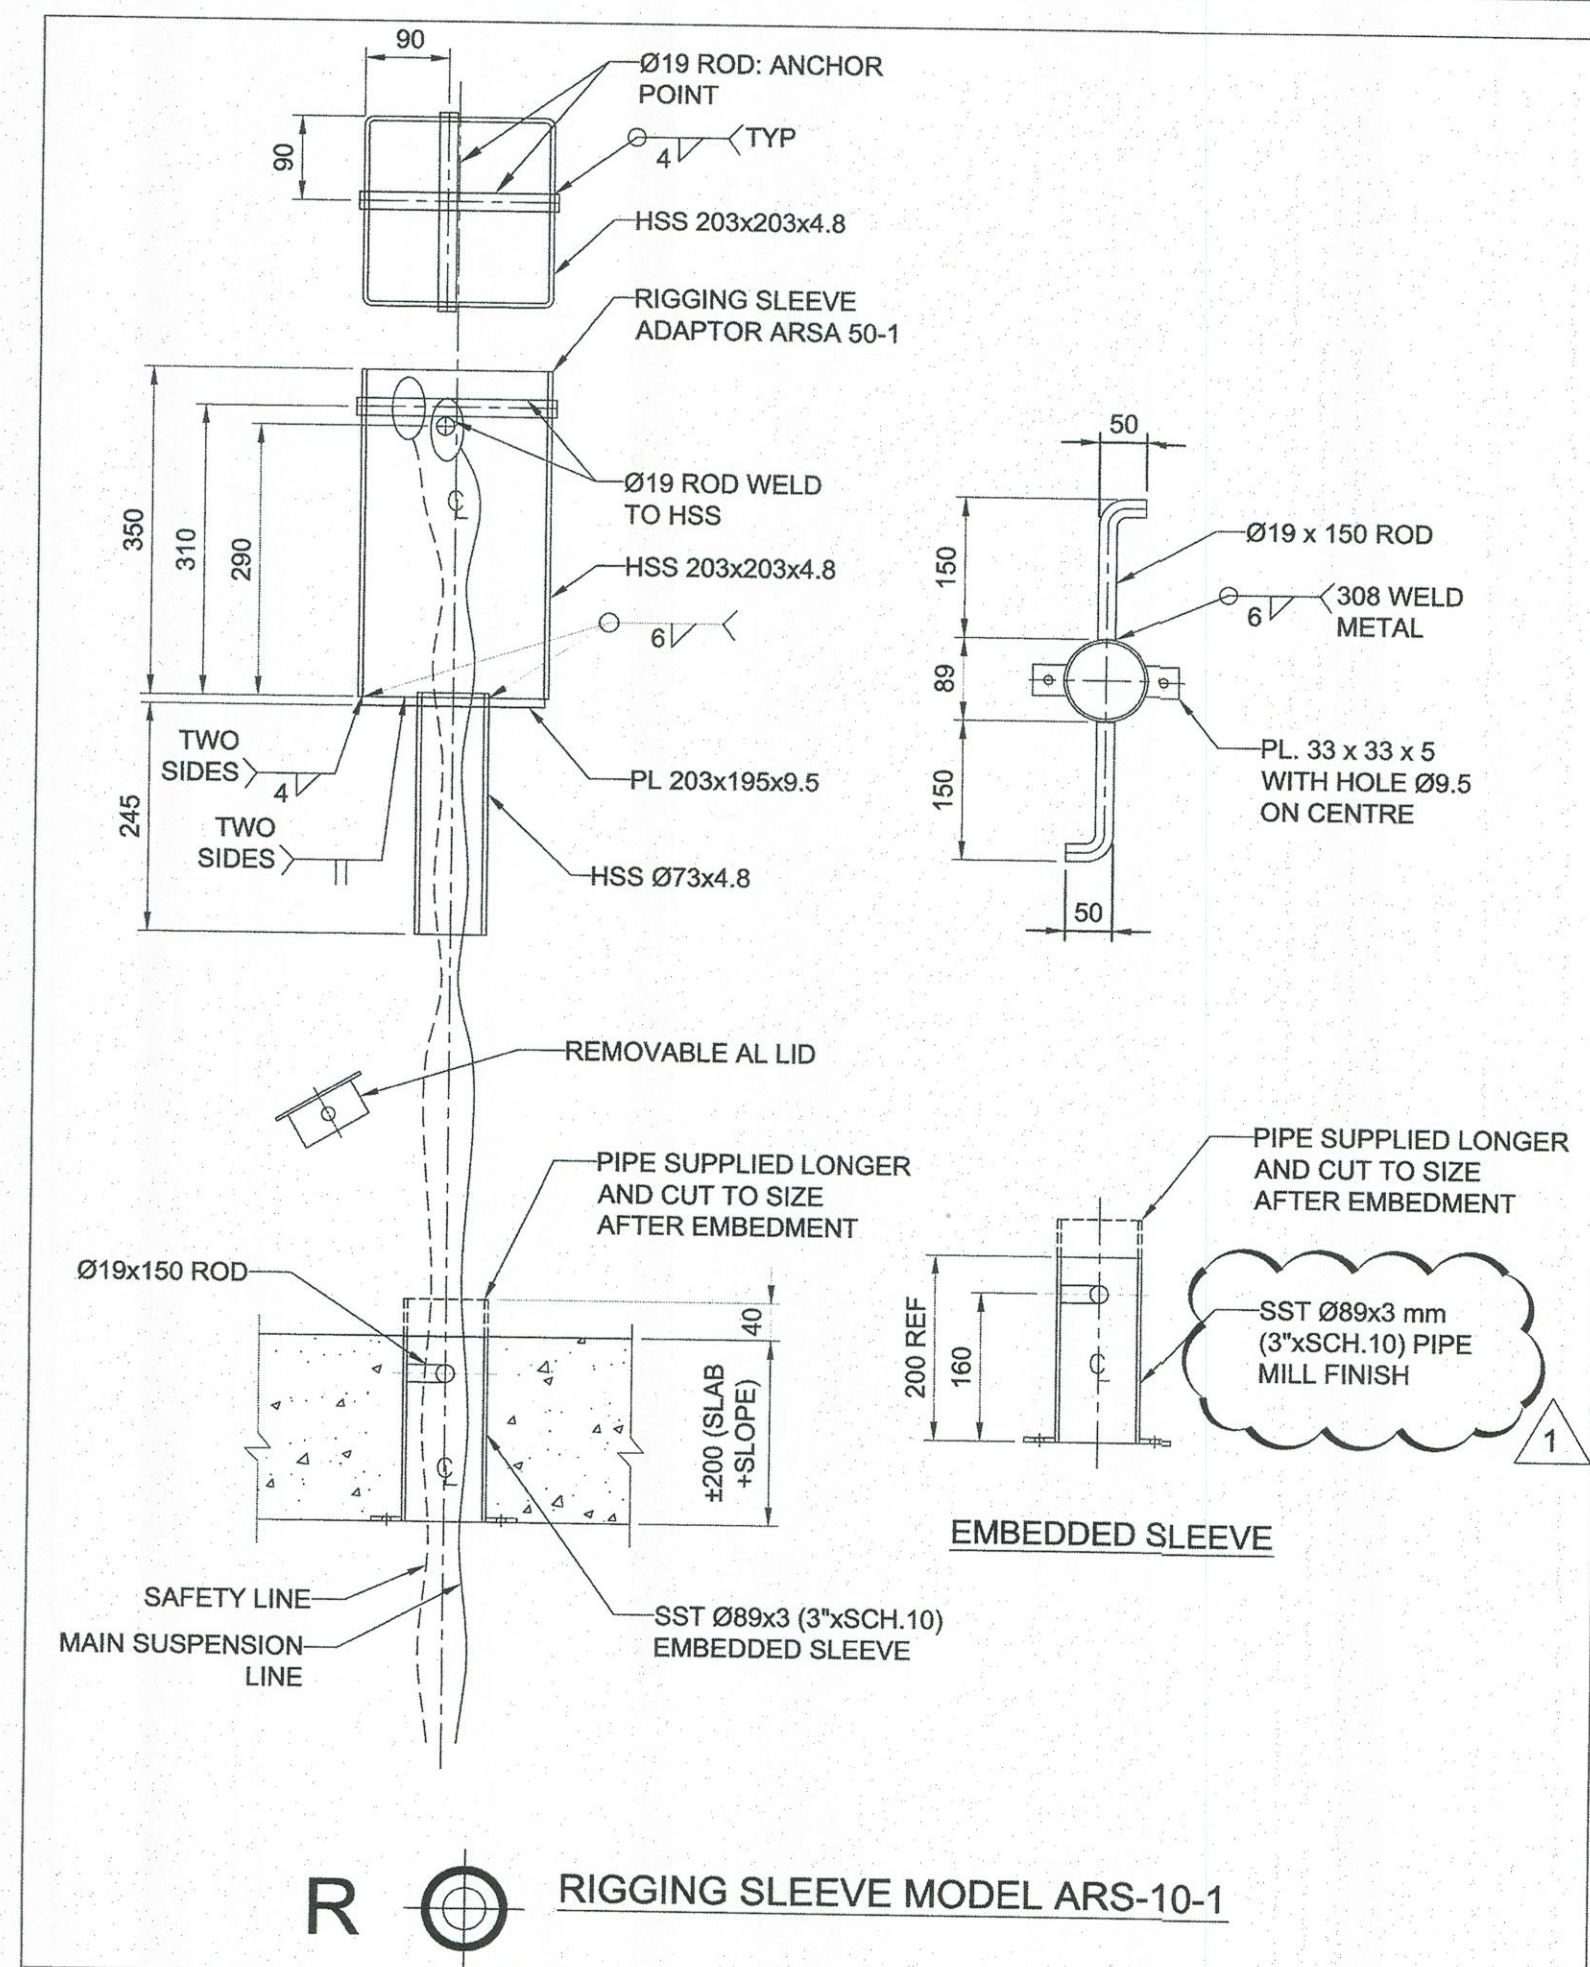


1
WC5.02
DETAIL
Scale 1:8

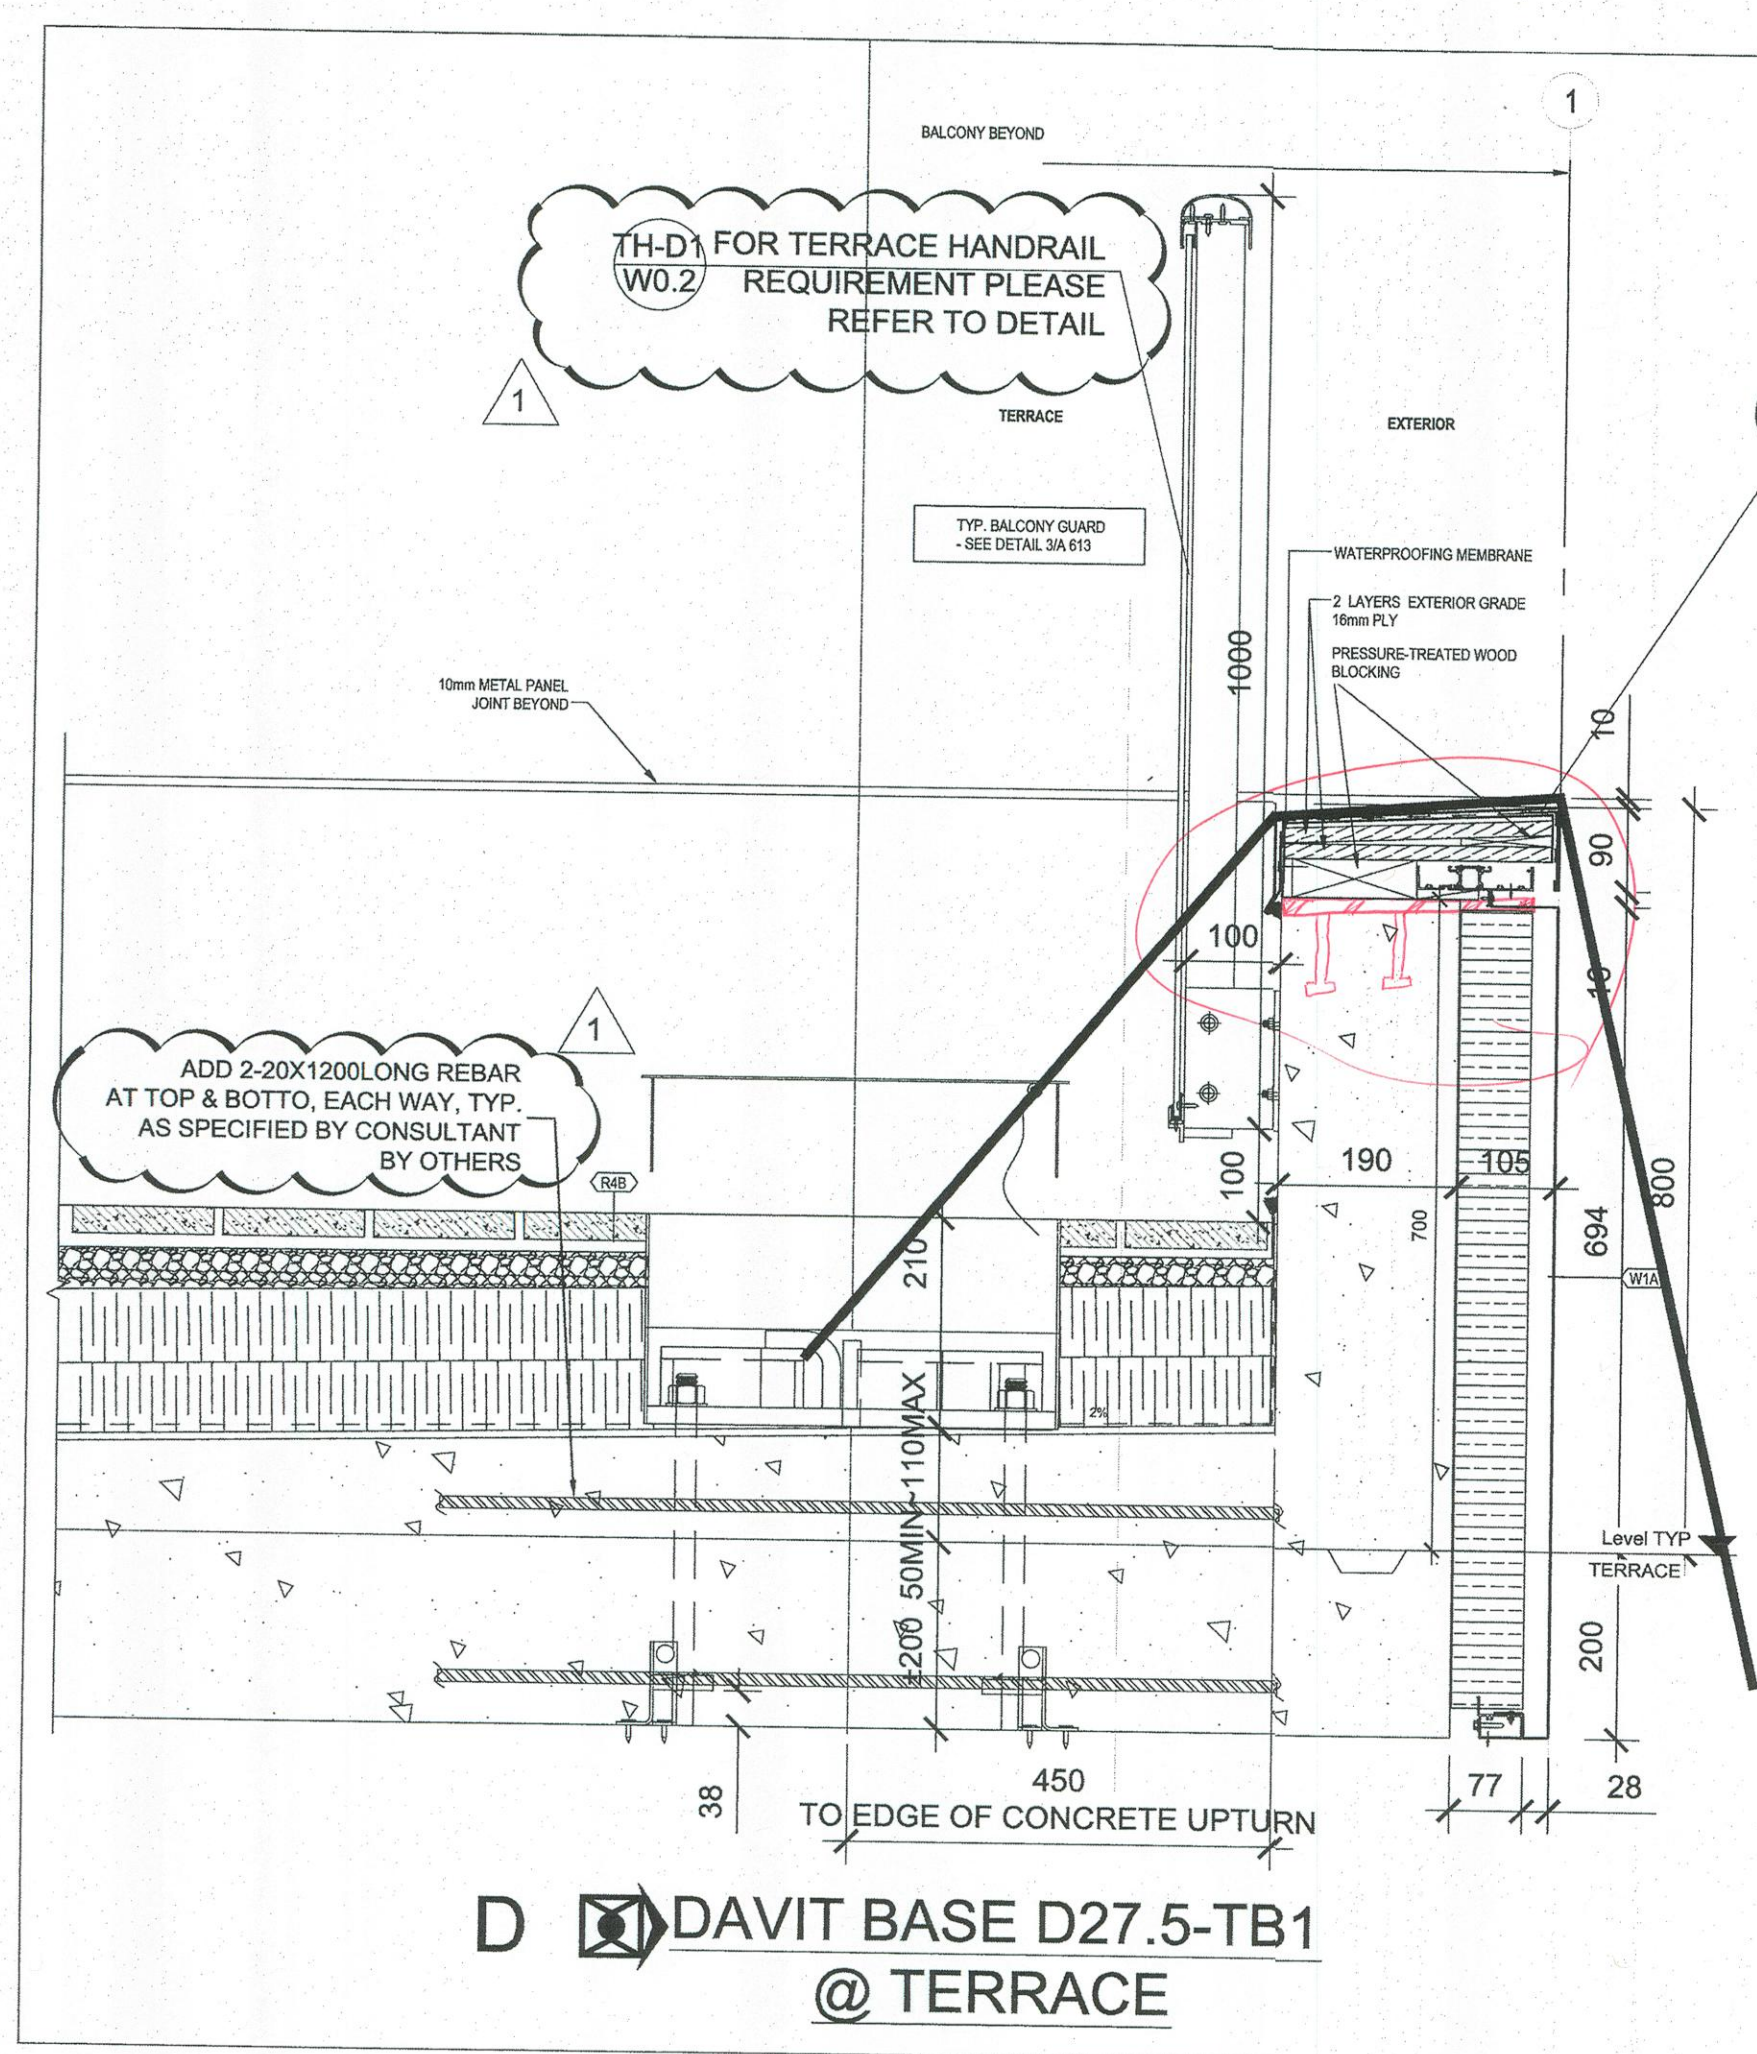


4
WC5.02
SECTION
Scale 1:8

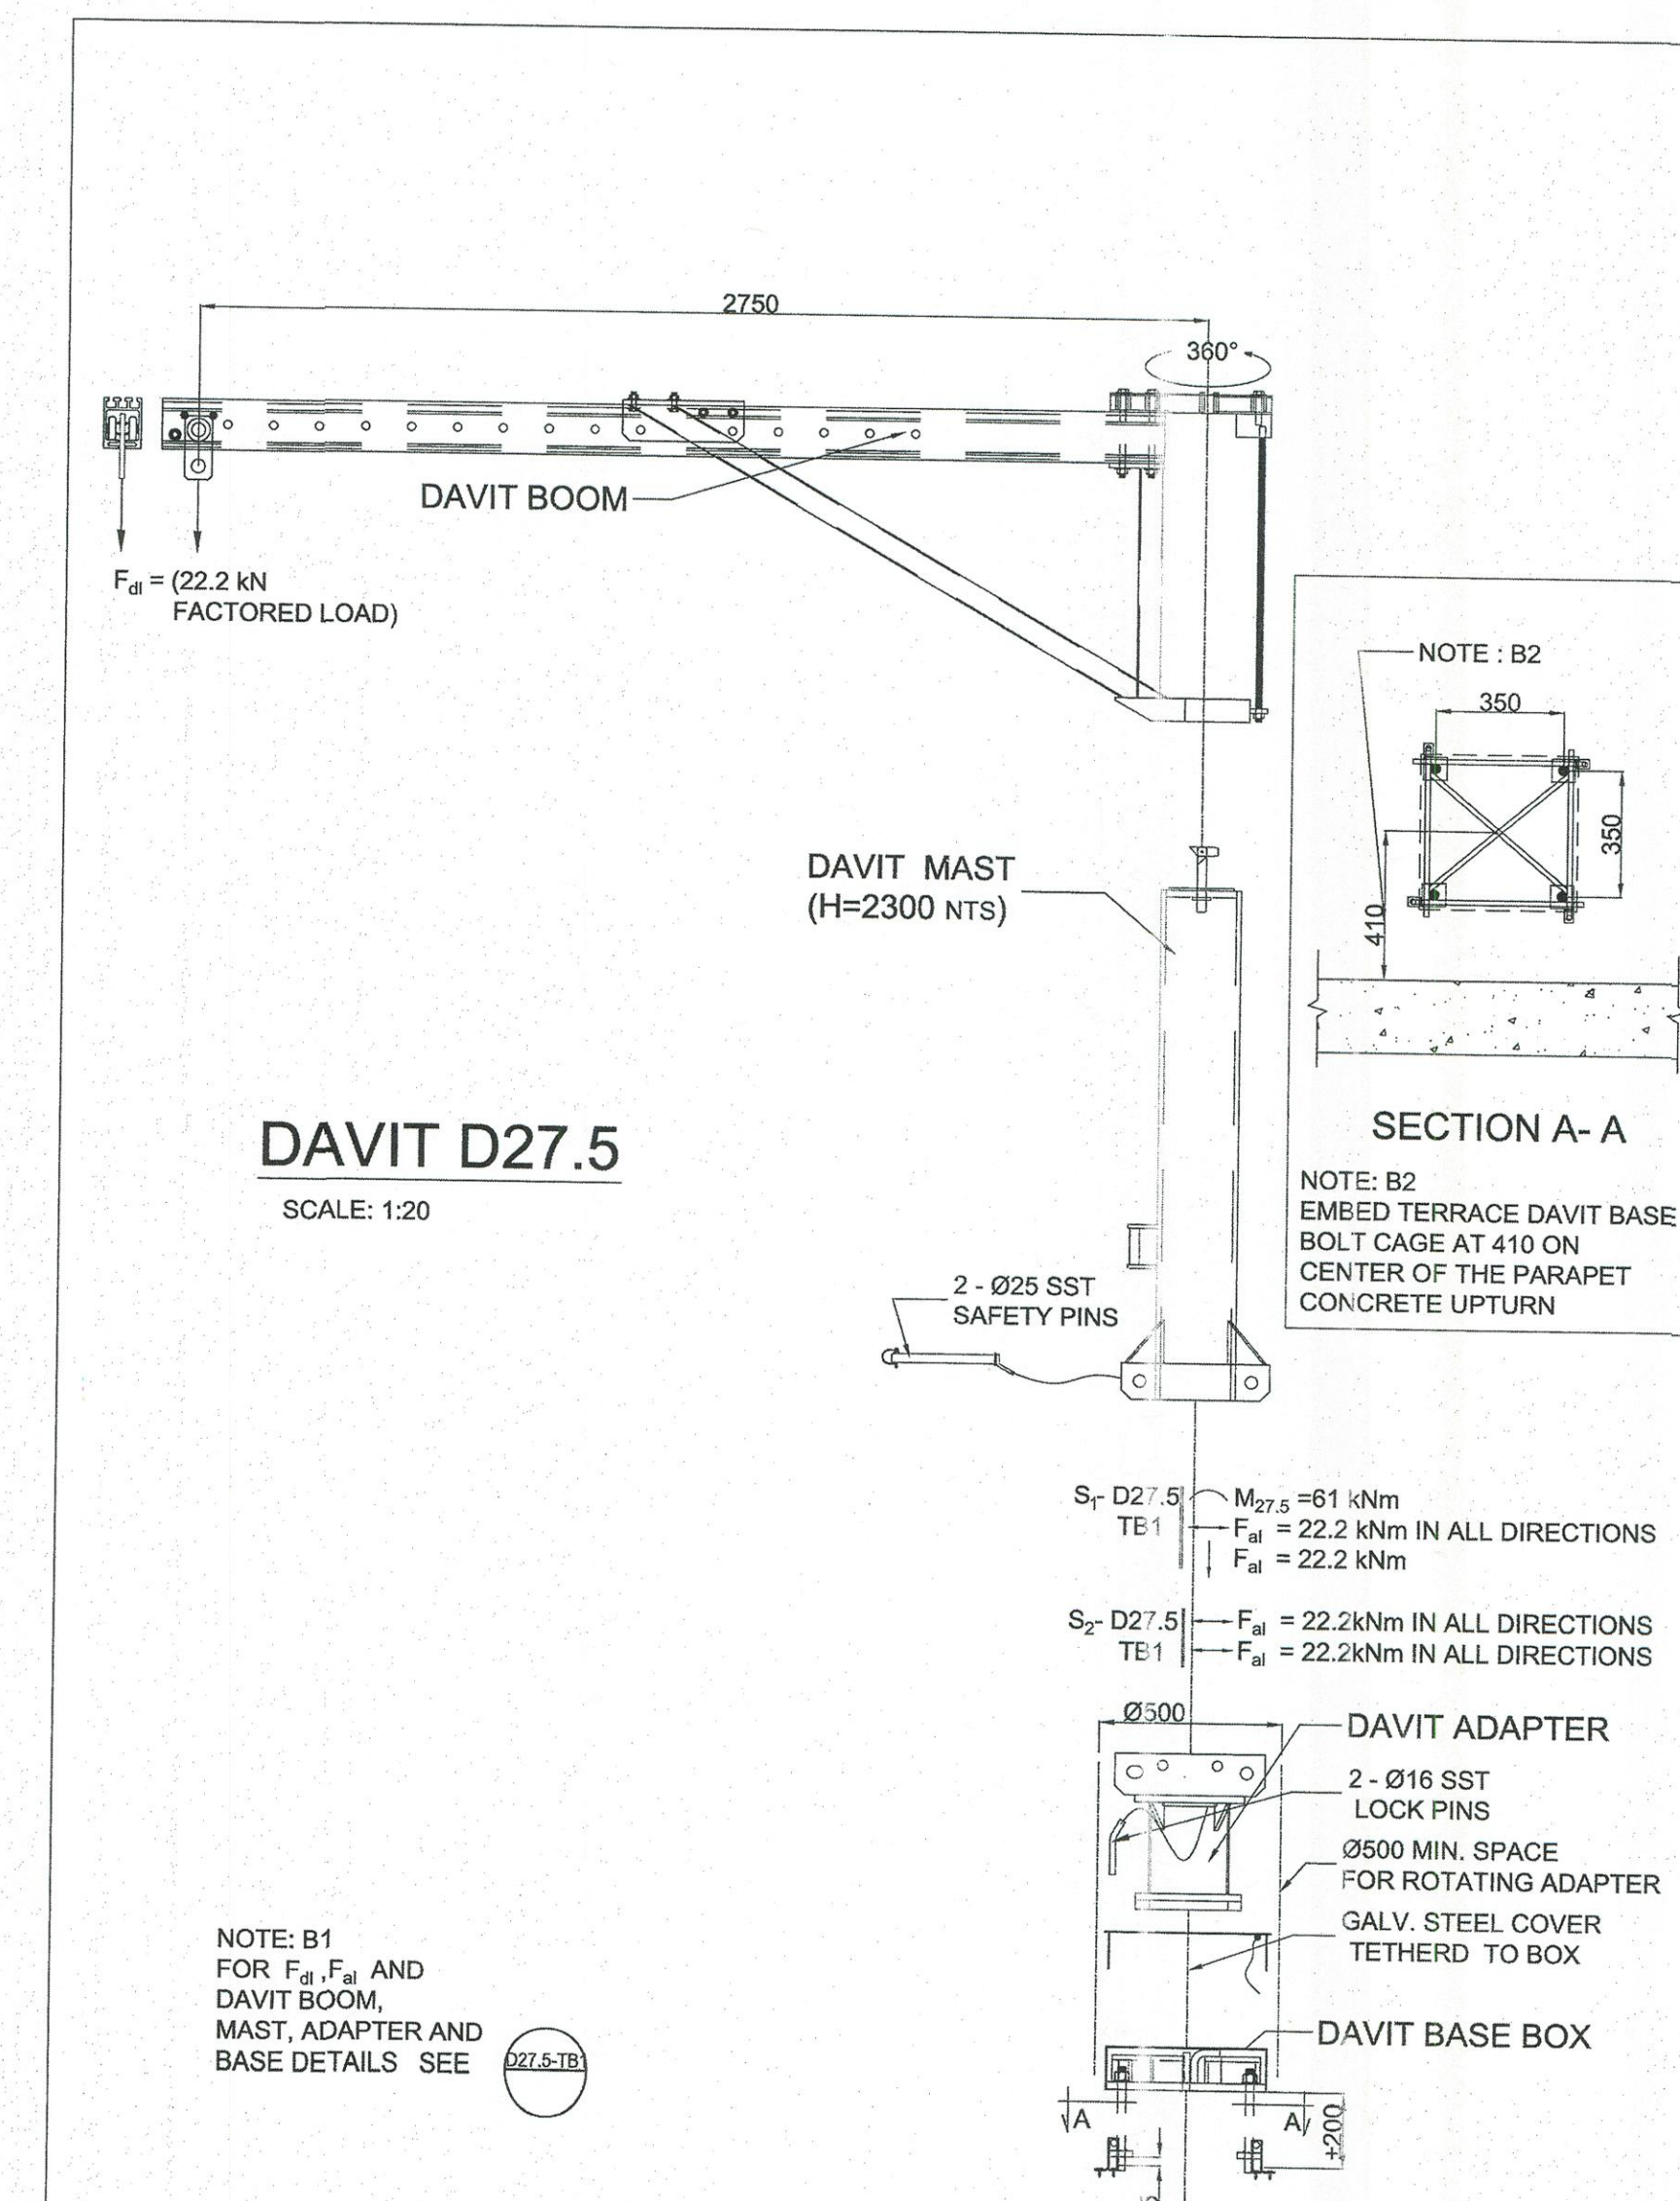

DAVIT D27.5
SCALE: 1:20

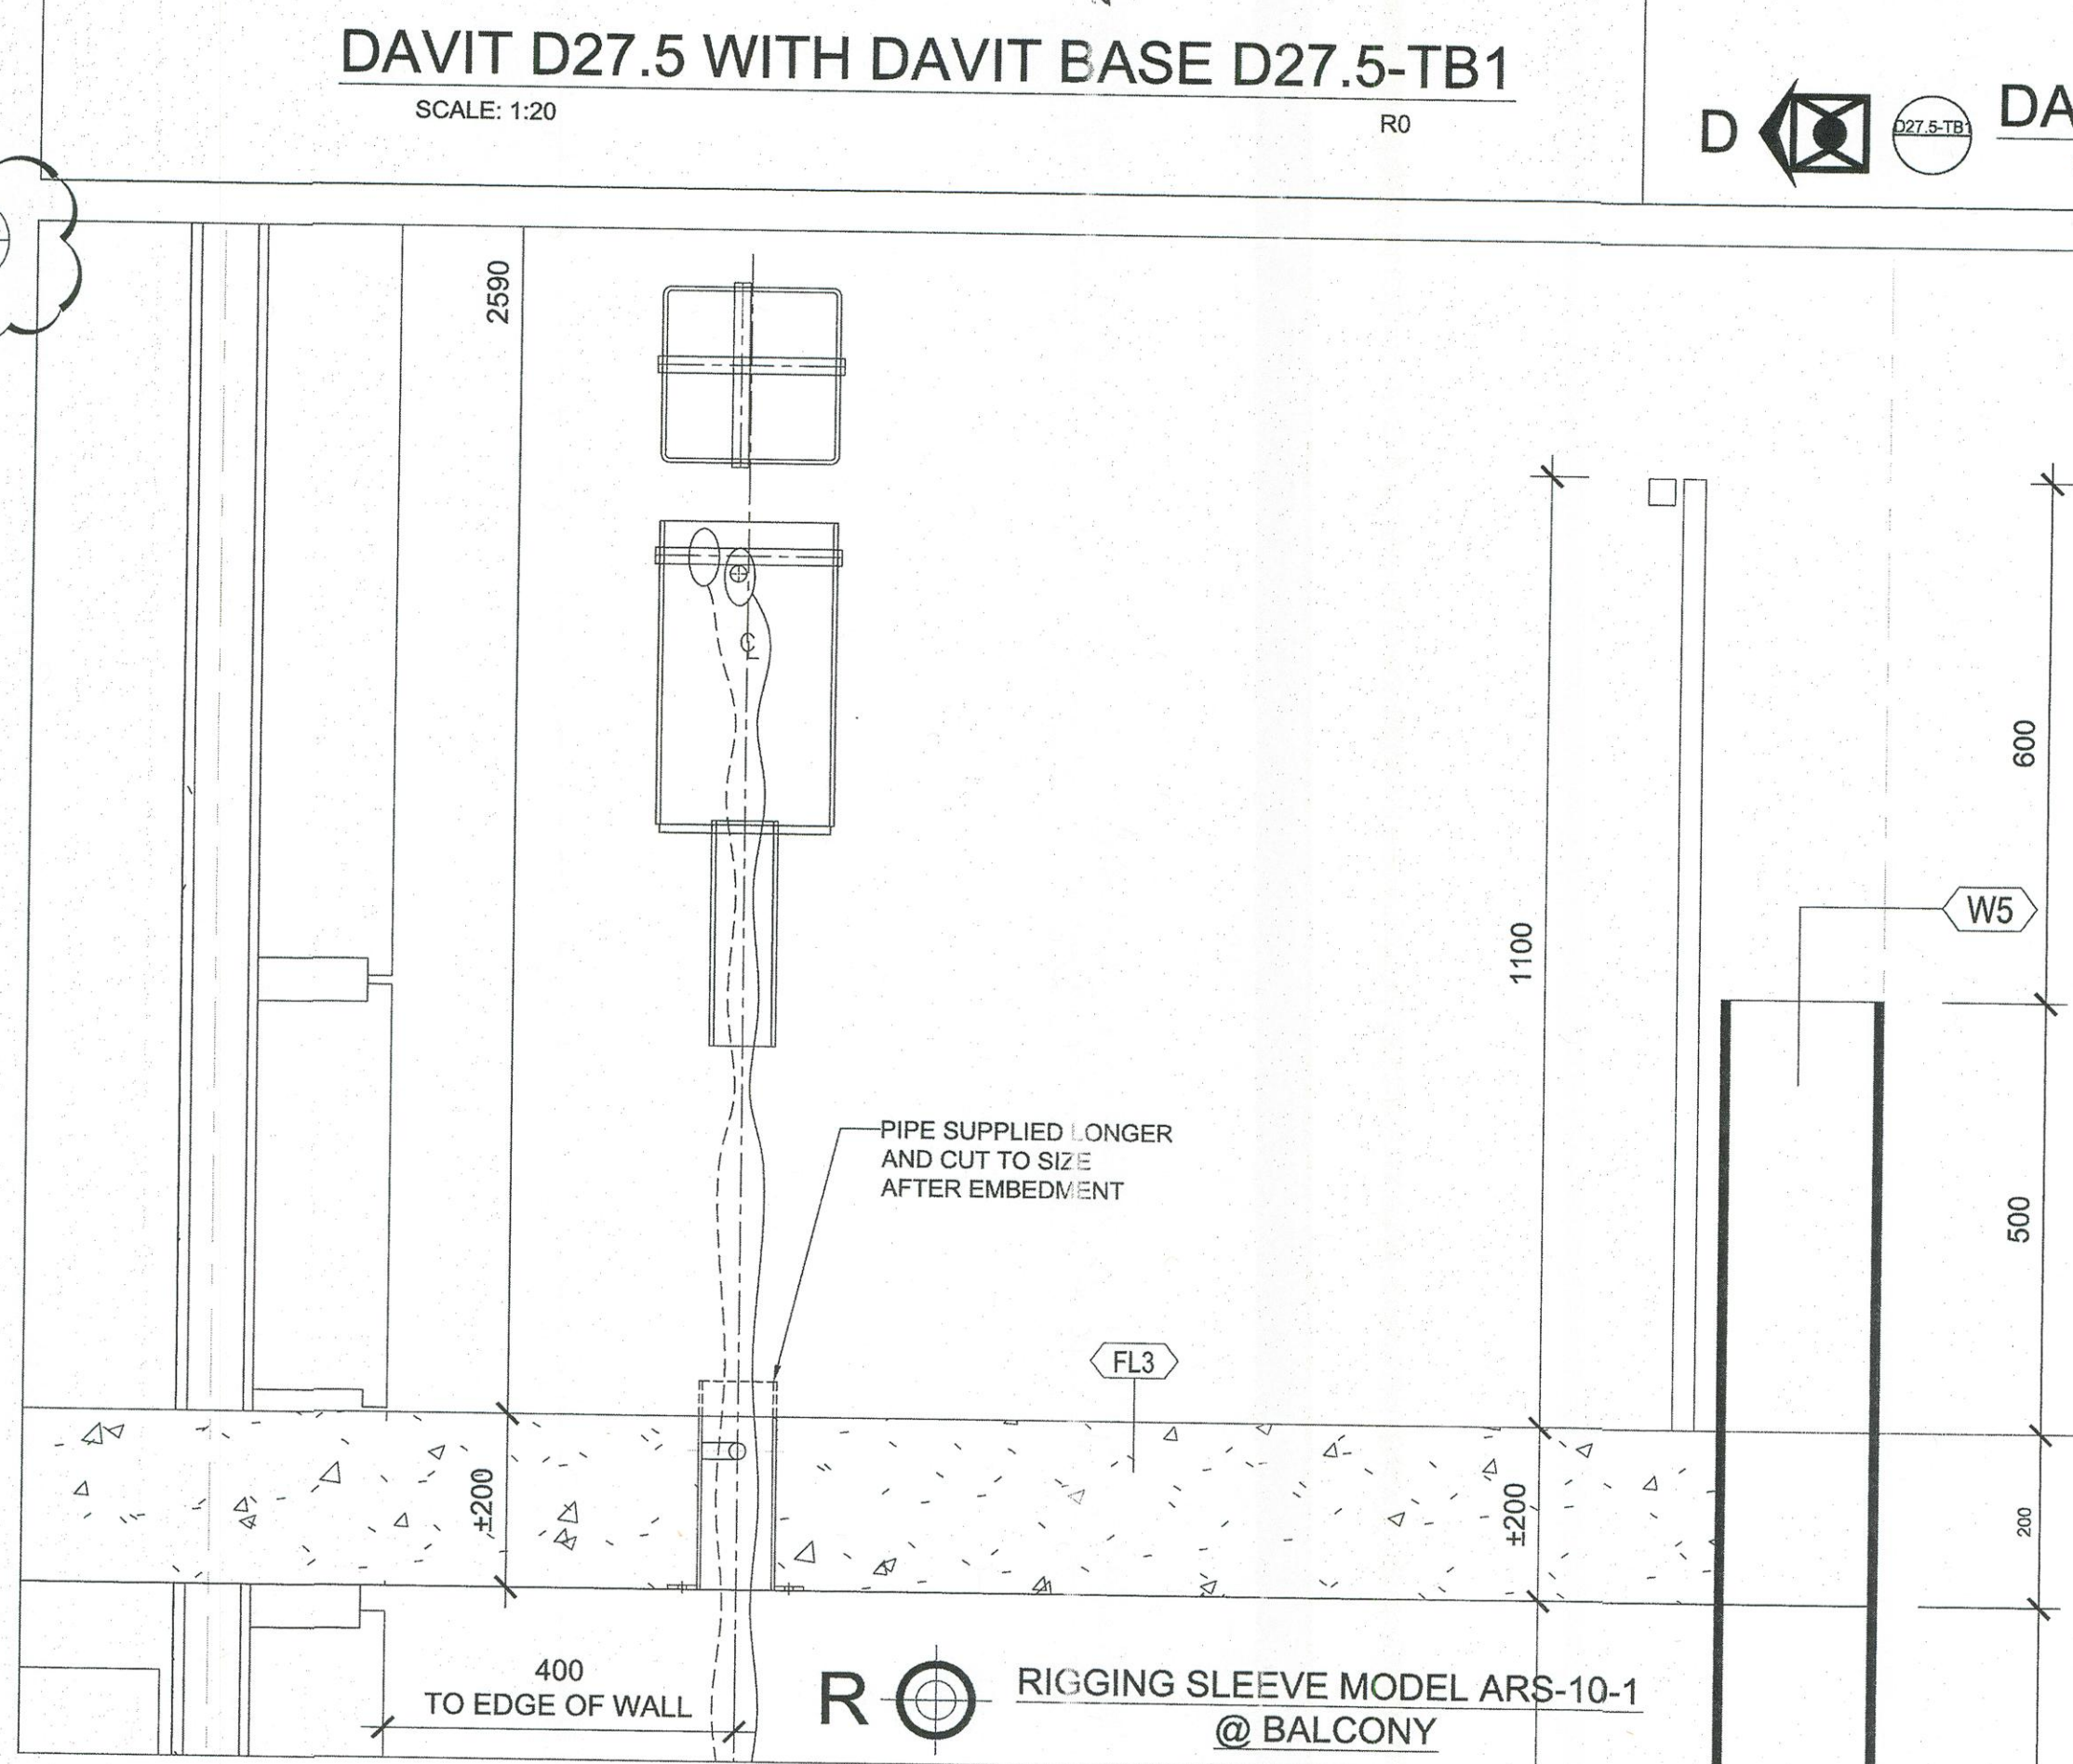

2
WC5.02
SECTION
Scale 1:8

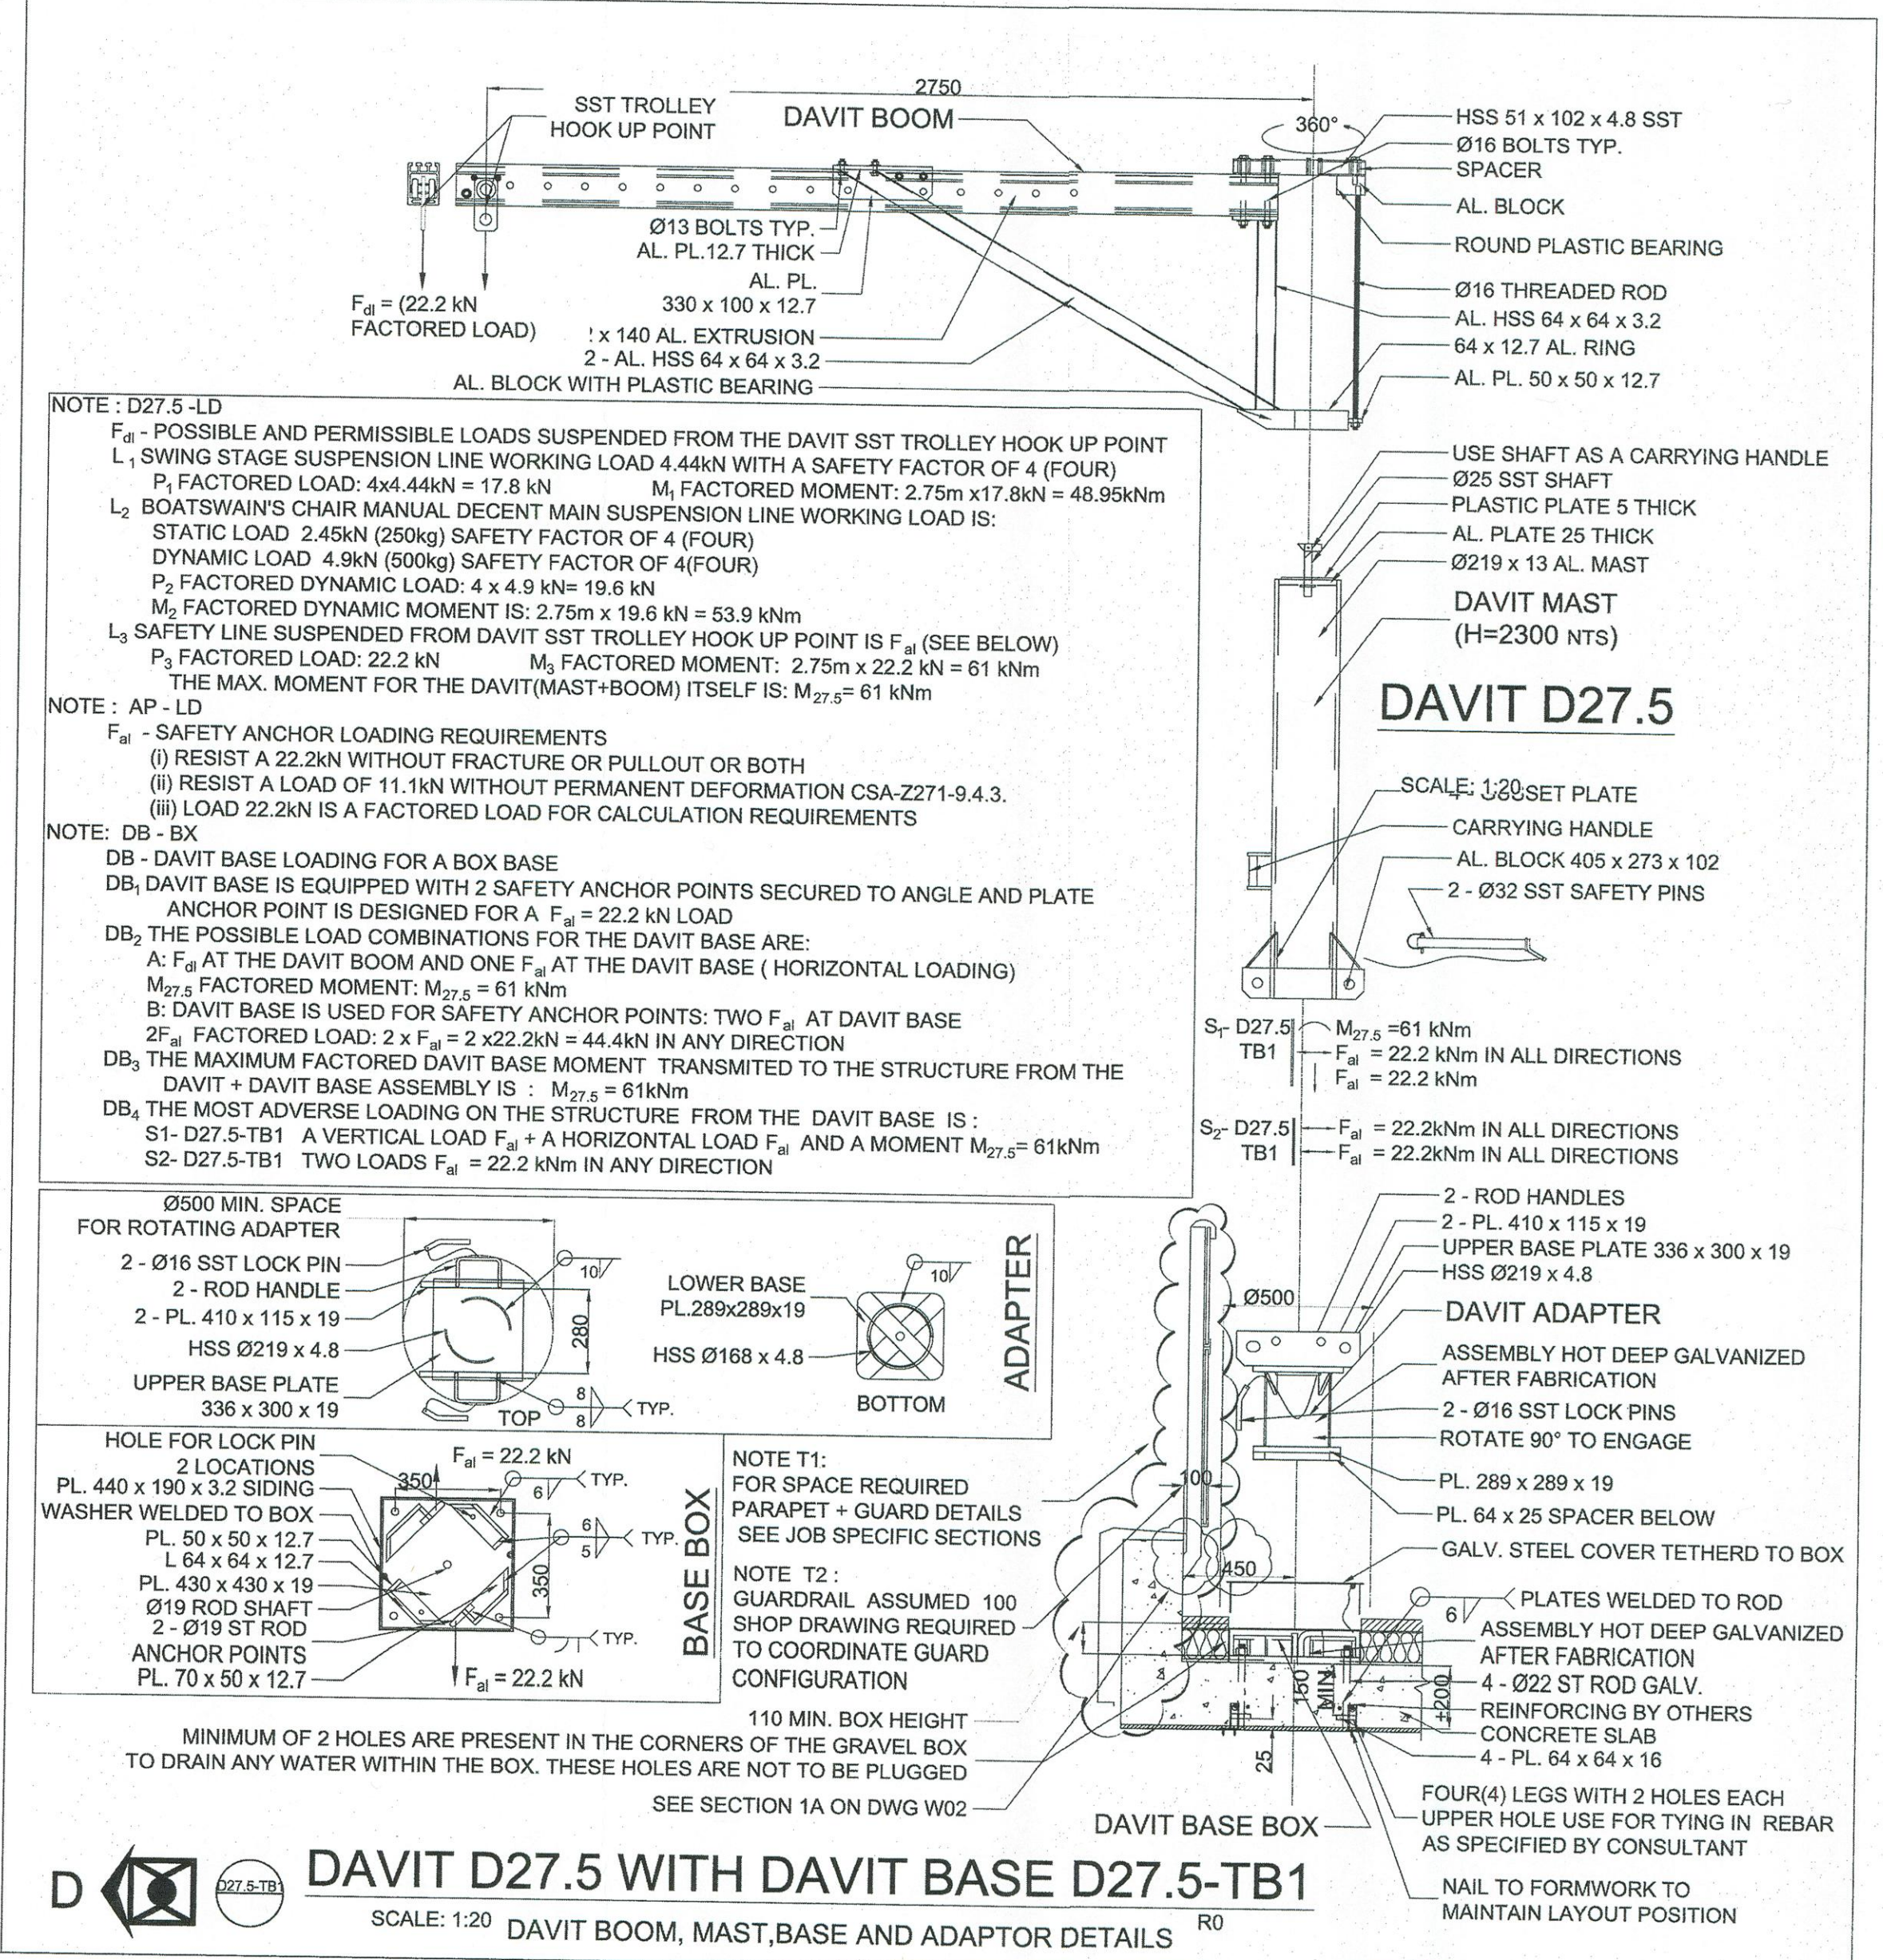

DAVIT D27.5 WITH DAVIT BASE D27.5-TB1
SCALE: 1:20 DAVIT BOOM, MAST, BASE AND ADAPTOR DETAILS

3
WC5.02
DETAIL
Scale 1:20

DRAWING REVIEW			
The review of this drawing does not in any way relieve the contractor of responsibility for its accuracy or for compliance with the contract documents.			
No Comment	1	Site Comments	1
Amount & Location	1	Revised Size	1
Submittal No.	1	Revised Date	1
Date	11/27/2015	Revised Date	11/27/2015
JANLOWSKY & PARTNERS Consulting Engineers 1120 Leslie St. Unit 1000 ON M5C 2K5			

1	DCT 202115	UPDATED AS PER REVIEW COMMENTS ON 2015-07-02	H.L.
0	JAN 12/2015	SHOP DRAWING ISSUED	H.L.
NO.	DATE	REVISIONS	BY
UNITS ARE IN MM UNLESS OTHERWISE NOTED			
ANKOR ENGINEERING SYSTEMS LTD. BUILDING FACADE & SAFETY SYSTEMS ENGINEERING, MANUFACTURING & INSTALLATION ADDRESS: 32 PENN DRIVE, TORONTO ON M6L 2H9 TELEPHONE: (416) 740-5761 FAX: (416) 740-5660 EMAIL: ANKOR@ANKOR.CA WEB: WWW.ANKOR.CA			
TITLE: SECTIONS AND DETAILS			
PROJECT: SQ ALEXANDRA PARK - BLOCK 11 38 CAMERON ST., TORONTO, ON.			
CLIENT: TRIDEL			
SCALE:	AS SHOWN	DATE:	JAN 12/2015
DRAWN:	H.L.	CHECKED:	J.B.
JOB No.:	J14096	DWG No.:	WC5.02