
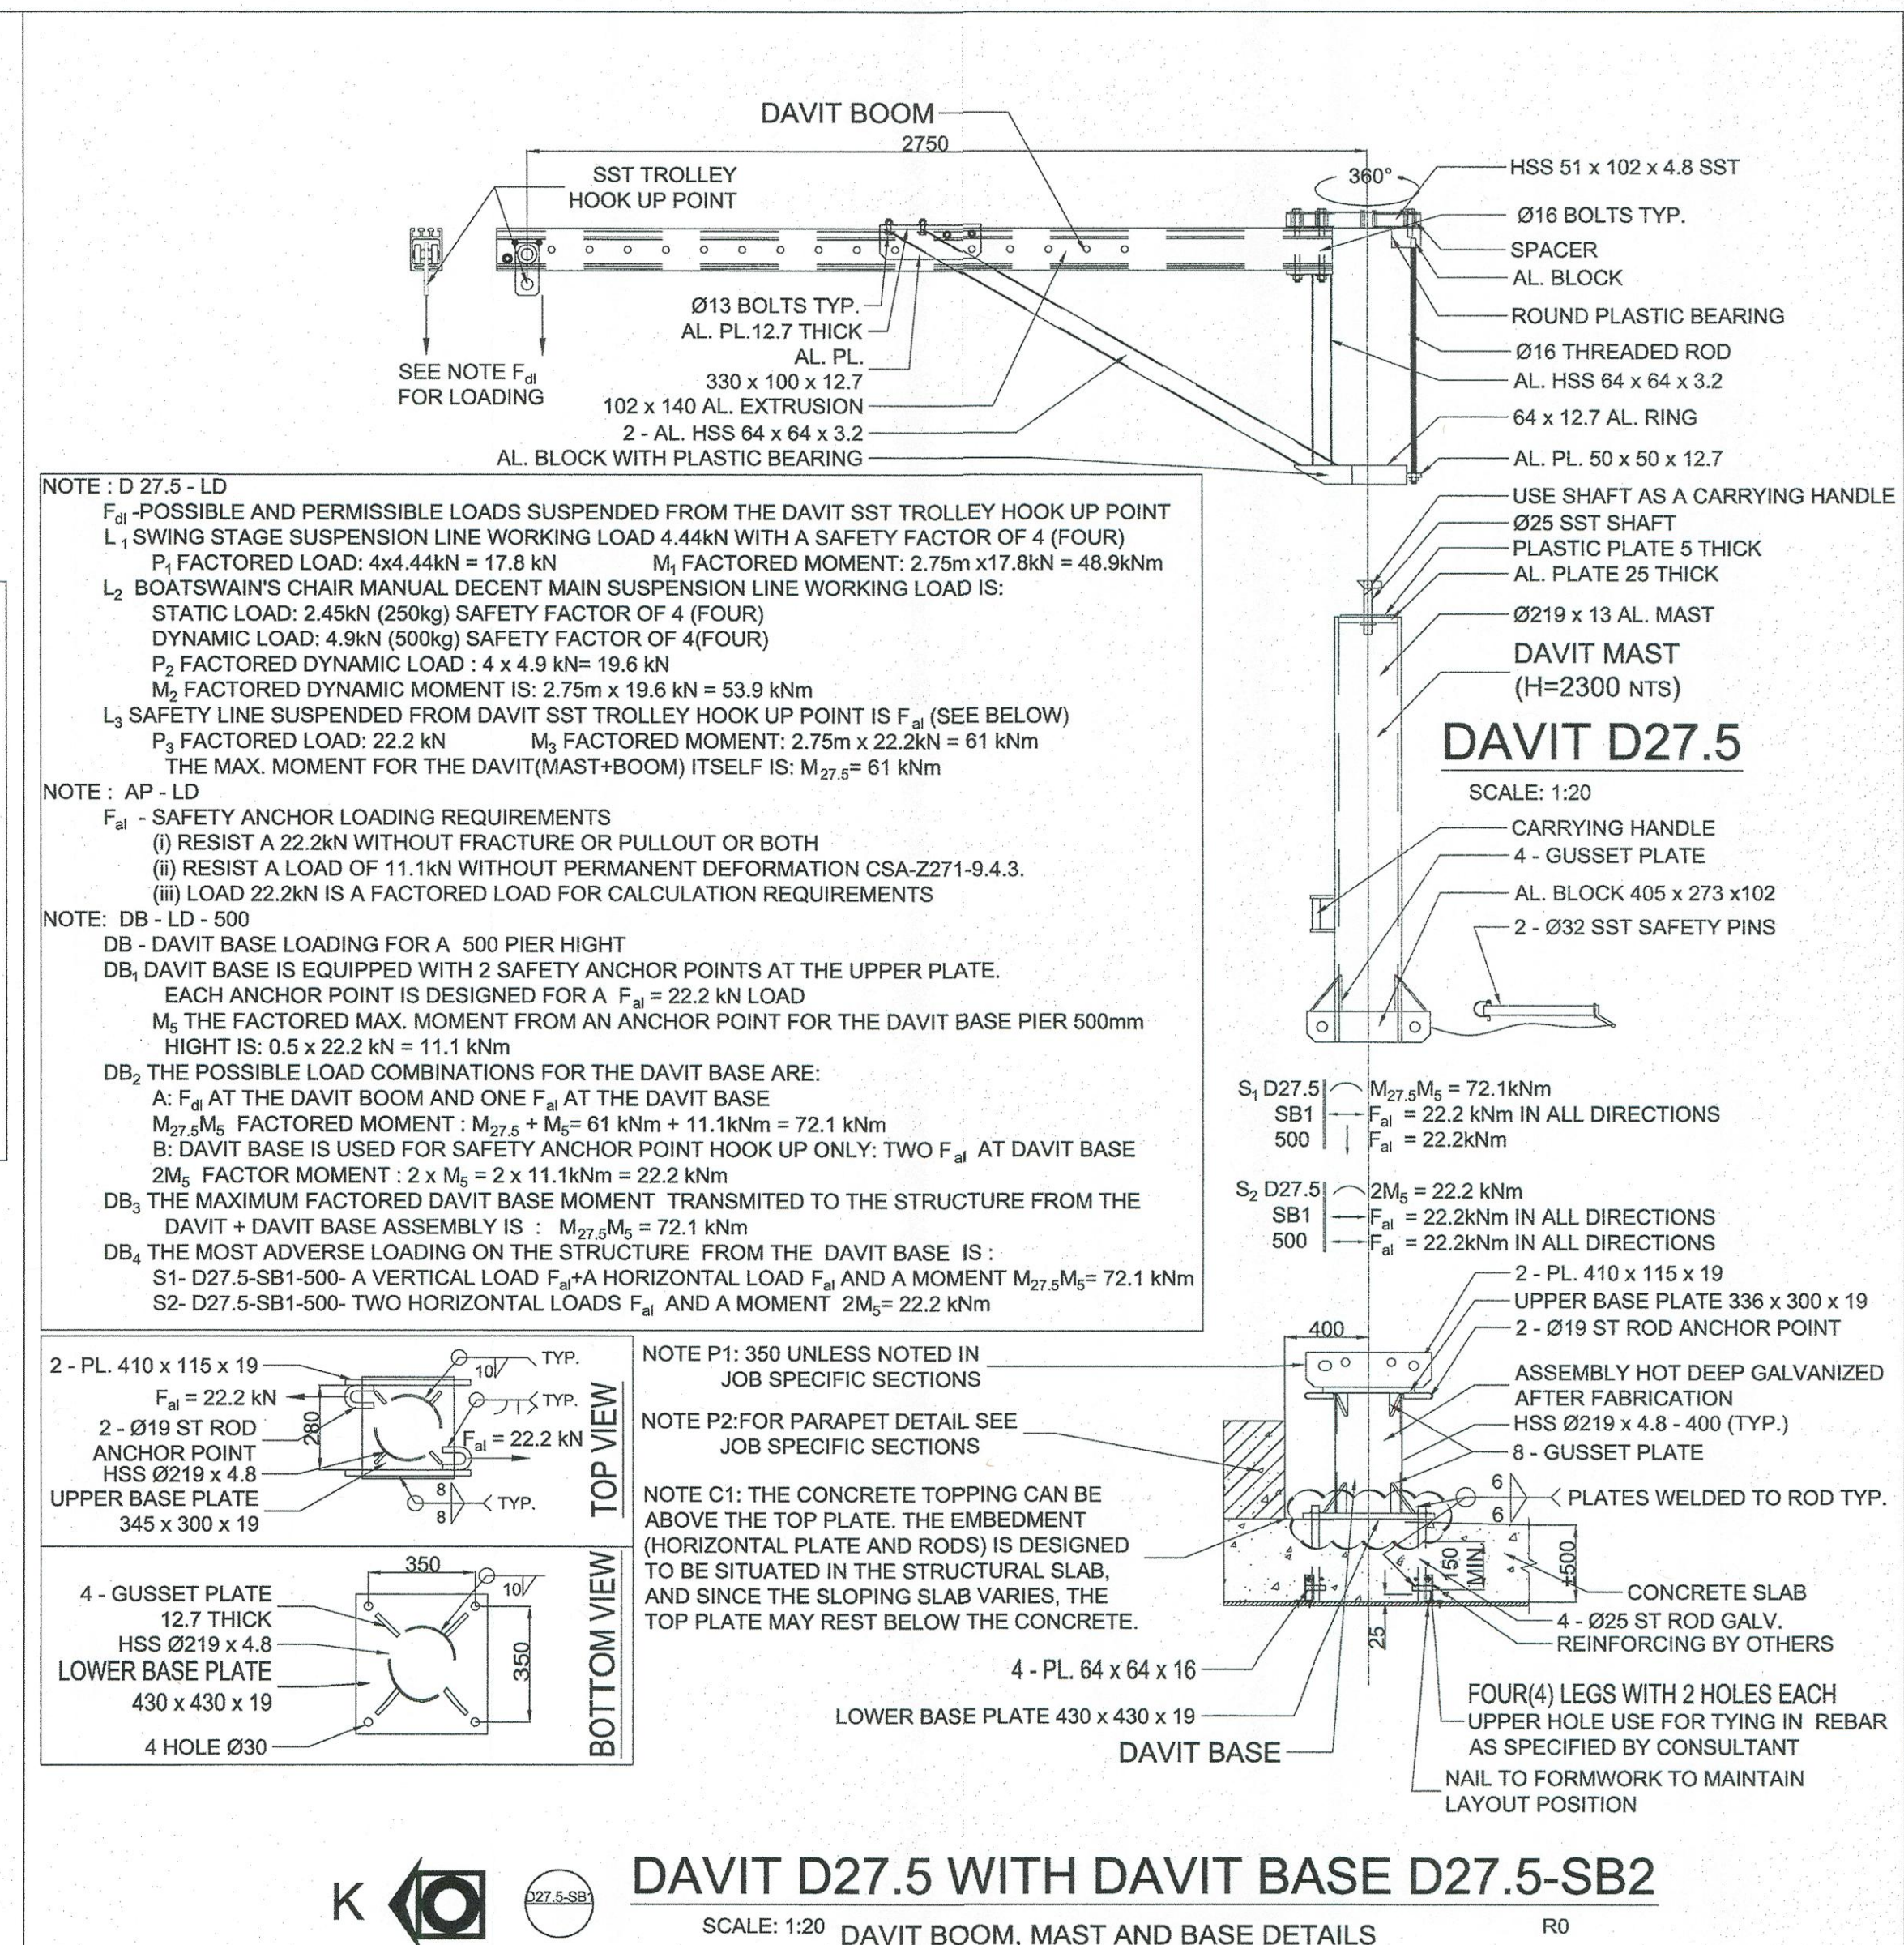
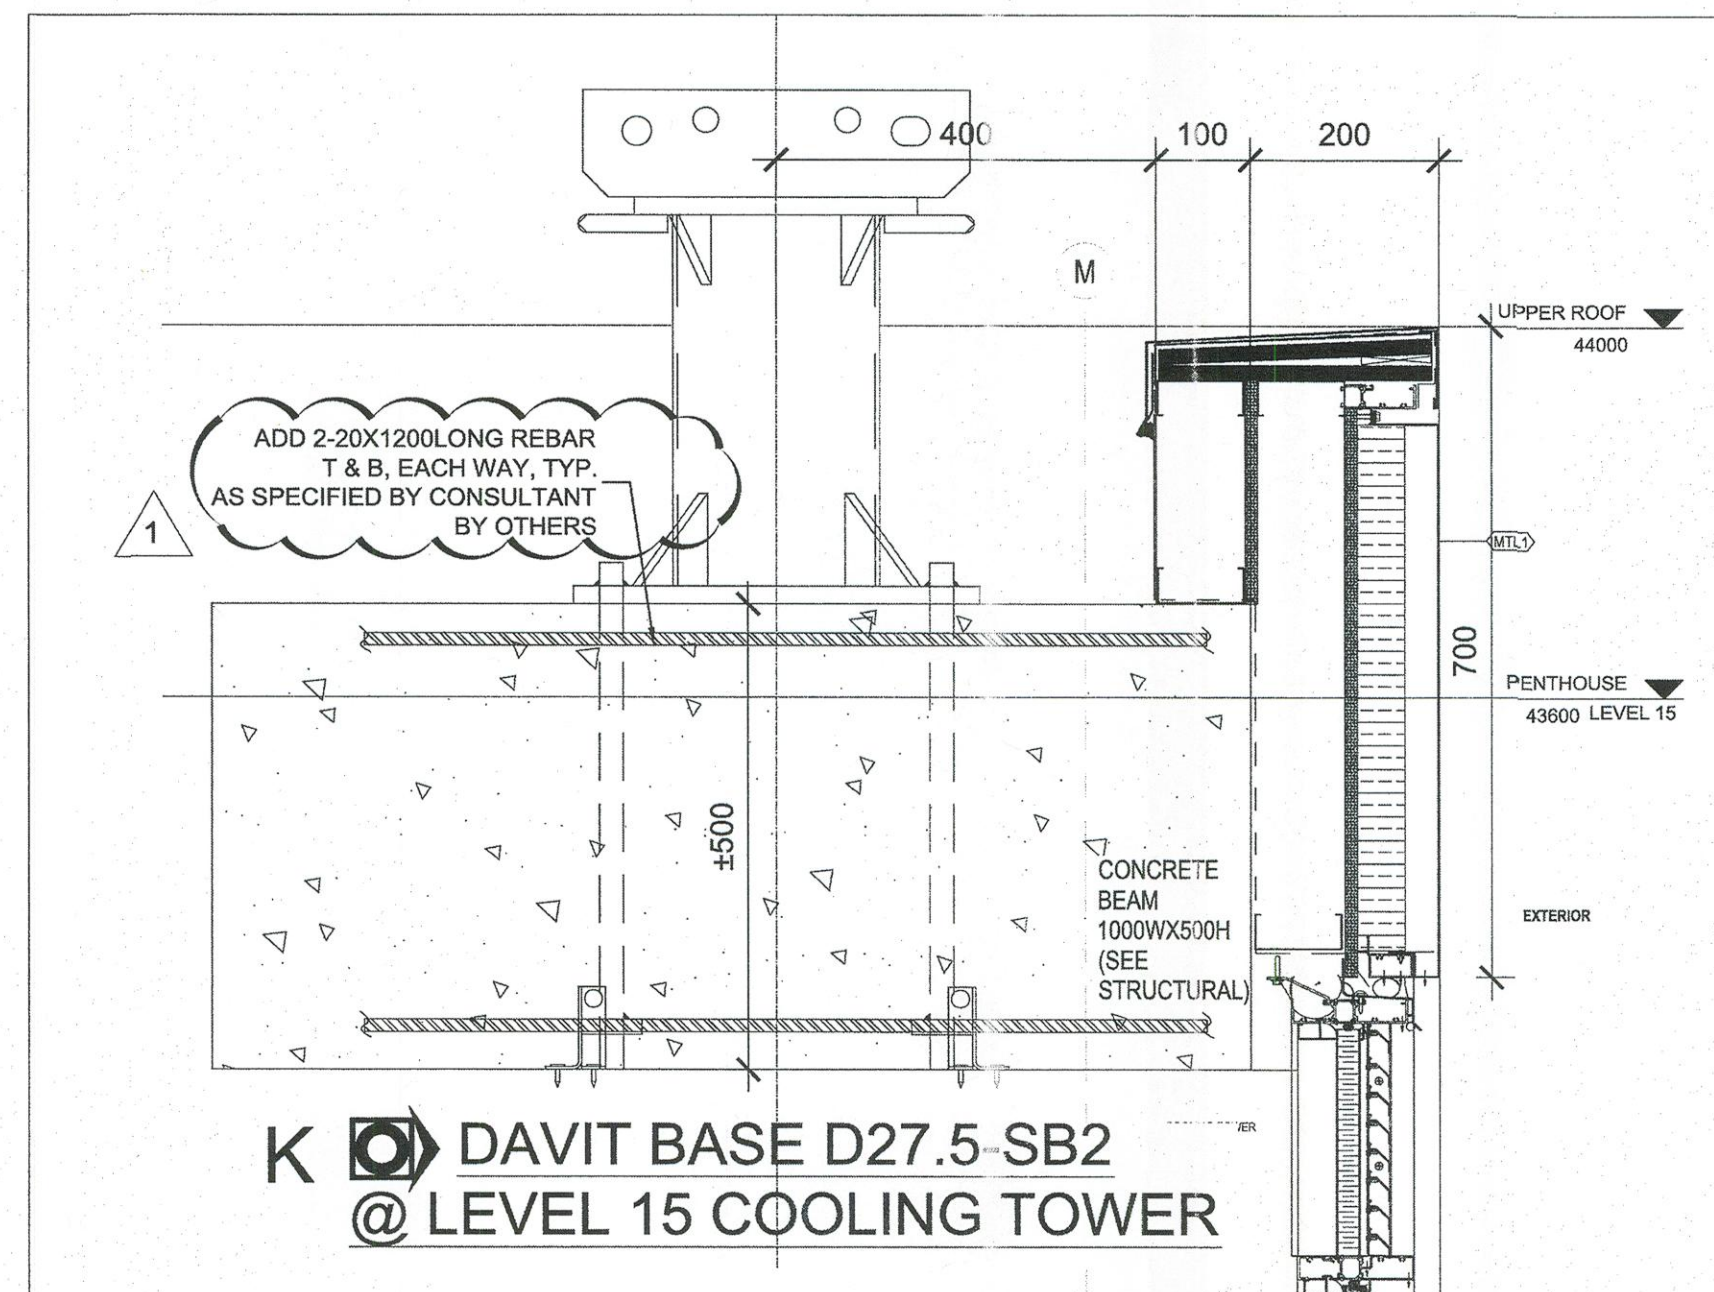
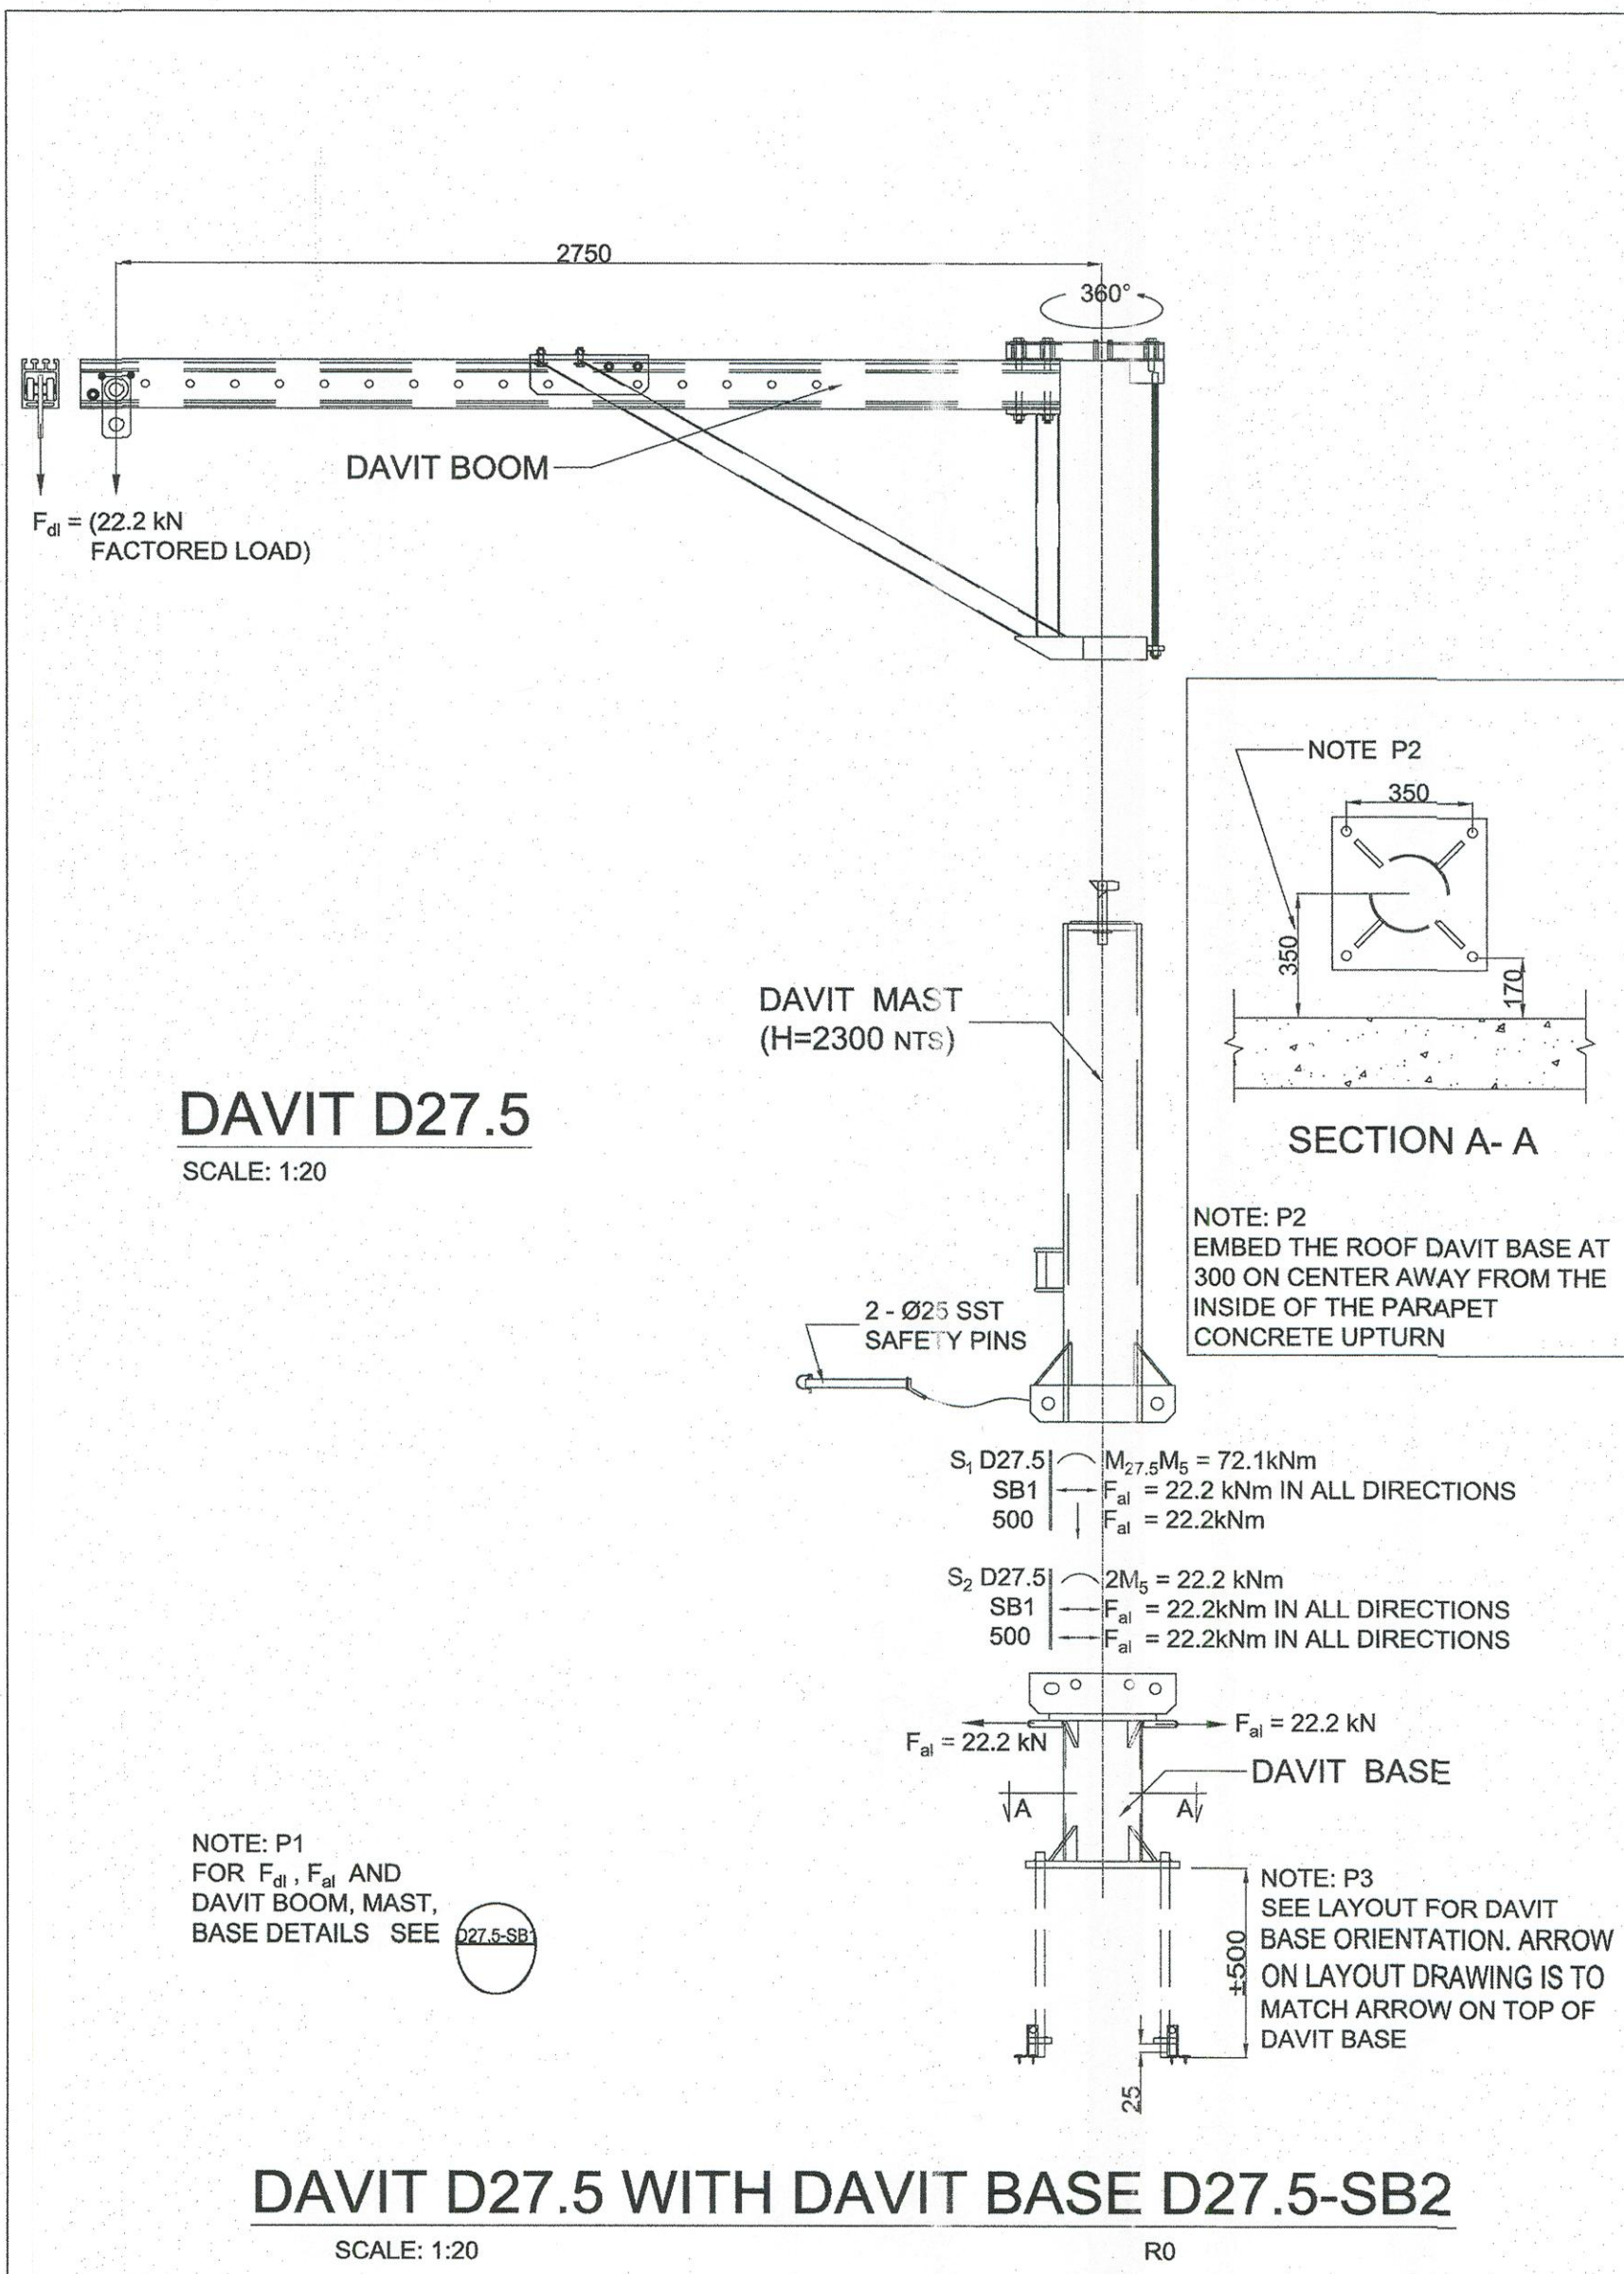
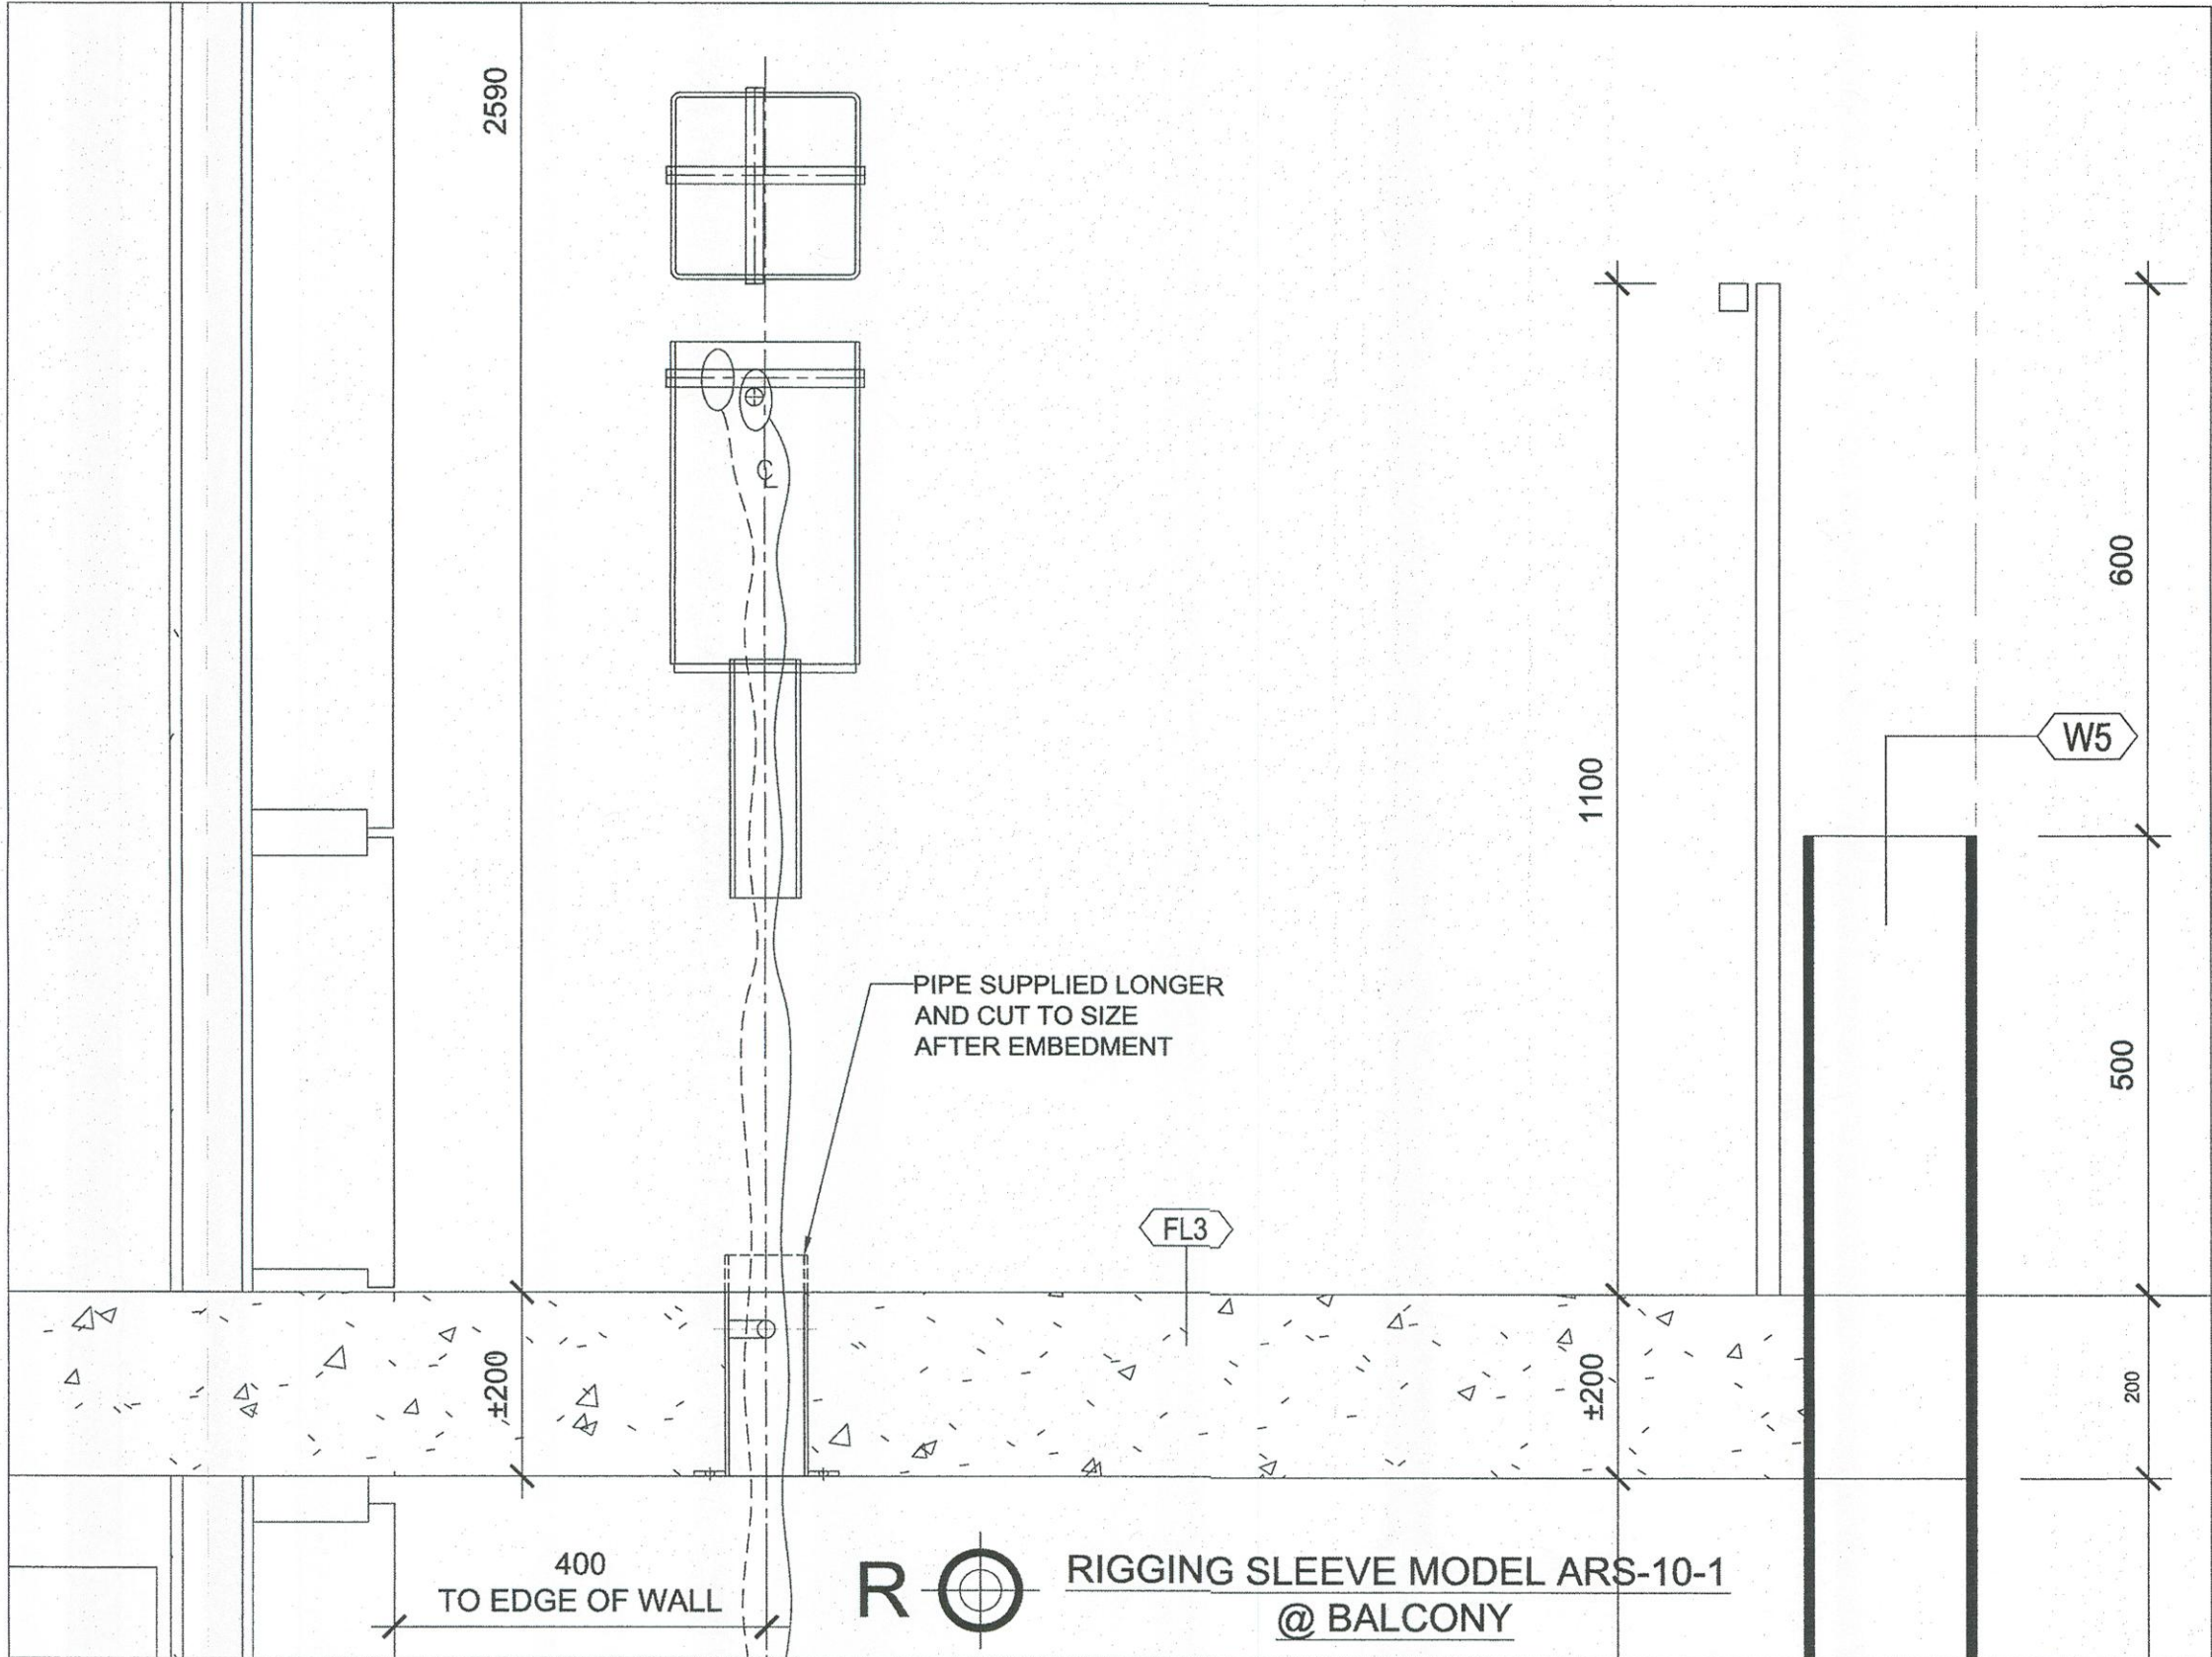


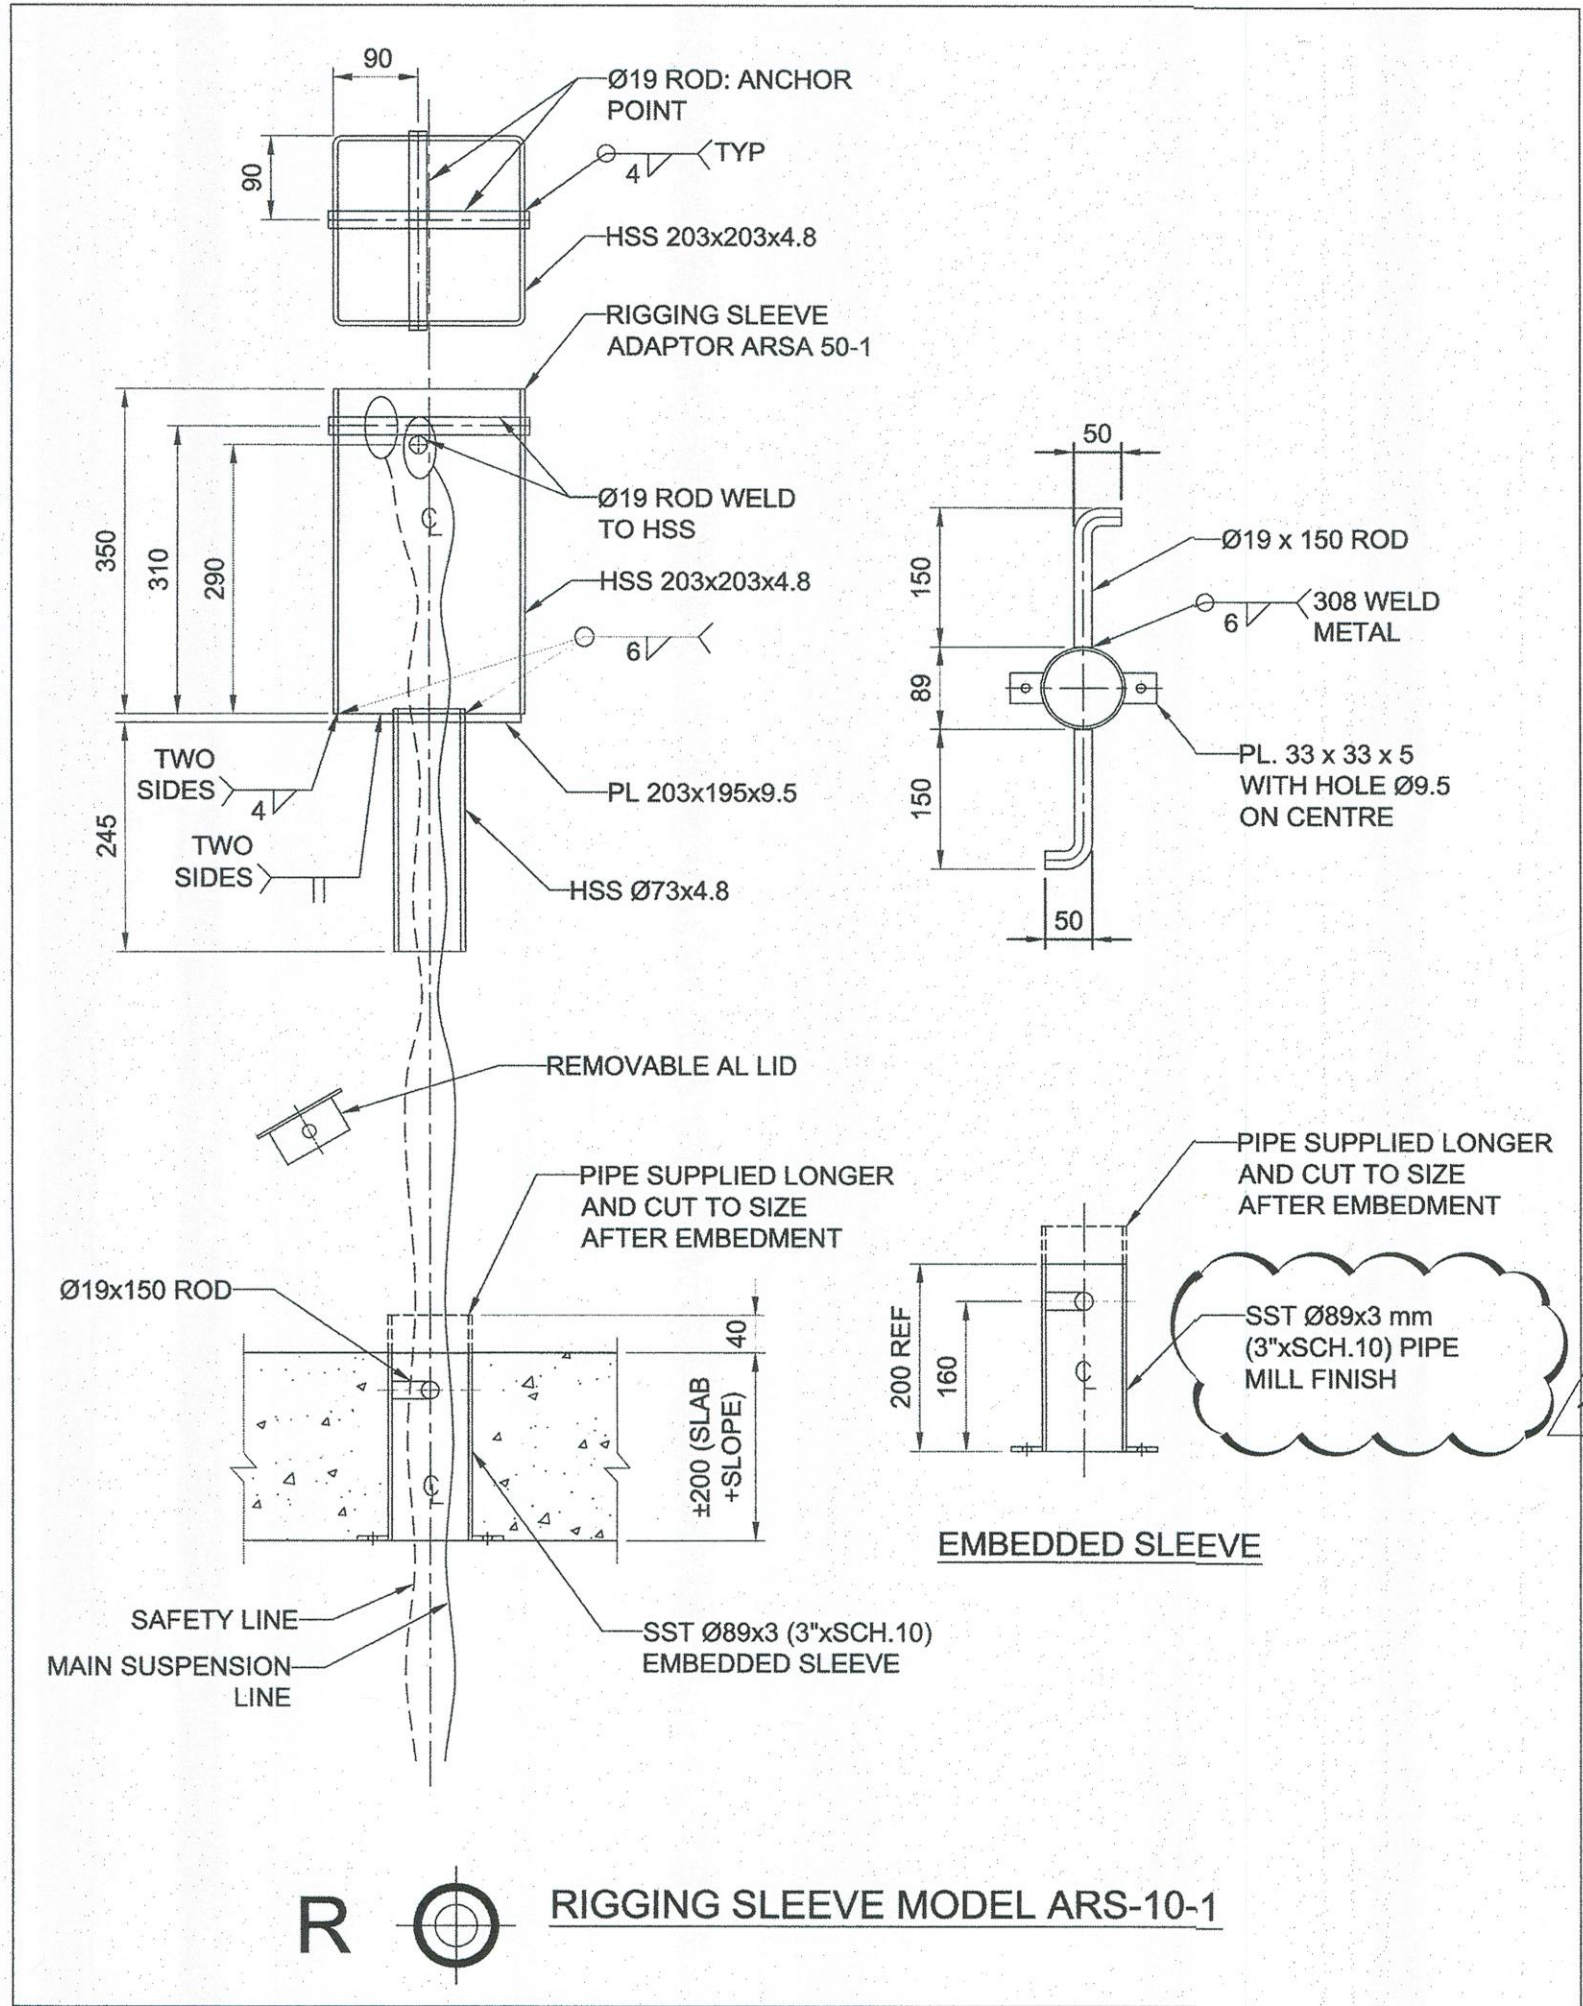

**SECTION 4**  
WC6.02  
Scale 1:8

**DETAIL 3**  
WC6.02  
Scale 1:20

| DRAWING REVIEW                                                                                                                                          |                     |
|---------------------------------------------------------------------------------------------------------------------------------------------------------|---------------------|
| The review of this drawing does not in any way relieve the contractor of responsibility for its accuracy or for compliance with the contract documents. |                     |
| ✓ No Comment                                                                                                                                            | See Comments        |
| Amend & Resubmit                                                                                                                                        | Reject & Start Over |
| Submission No. 13215                                                                                                                                    |                     |
| Project No. 13215                                                                                                                                       | By: J.P.            |
| Date: MAY 27, 2015                                                                                                                                      |                     |
| JABLONSKY AST & PARTNERS<br>Consulting Engineers<br>1129 Leslie St. Unit 1000 ON M5C 2K5                                                                |                     |

| NO. | DATE        | REVISIONS                                    | BY   |
|-----|-------------|----------------------------------------------|------|
| 1   | OCT 20/2015 | UPDATED AS PER REVIEW COMMENTS ON 2015-07-02 | H.L. |
| 0   | JAN 12/2015 | SHOP DRAWING ISSUED                          | H.L. |

UNITS ARE IN MM  
UNLESS OTHERWISE NOTED

**ANKOR ENGINEERING SYSTEMS LTD.**  
BUILDING FACADE & SAFETY SYSTEMS  
ENGINEERING, MANUFACTURING, & INSTALLATION

ADDRESS: 32 BEVIN DRIVE, TORONTO ON, M6L 2P9  
TELEPHONE: (416) 765-2171  
FAX: (416) 765-5855  
EMAIL: ANKOR@ANKORONCA.COM  
WEB: WWW.ANKORONCA.COM

**TITLE:** SECTIONS AND DETAILS

**PROJECT:** SQ ALEXANDRA PARK - BLOCK 11  
38 CAMERON ST., TORONTO, ON.

**CLIENT:** TRIDEL

**SCALE:** AS SHOWN  
**DATE:** JAN 12/2015

**DRAWN:** H.L.  
**CHECKED:** J.B.

**JOB NO.:** J14096  
**DWG NO.:** WC6.02