



DO NOT SCALE DRAWINGS.

CONTRACTOR MUST VERIFY ALL DRAWINGS, DIMENSIONS, DETAILS AND SPECIFICATIONS, AND REPORT ANY DISCREPANCIES TO UNION 31 INC. BEFORE PROCEEDING WITH WORK. MATERIALS MAY NOT BE SUBSTITUTED WITHOUT WRITTEN APPROVAL FROM UNION 31 INC. ALL DRAWINGS AND SPECIFICATIONS ARE INSTRUMENTS OF SERVICE AND THE PROPERTY OF UNION 31 INC. WHICH MUST BE RETURNED AT THE COMPLETION OF THE WORK.


PRINTED: 30-May-17

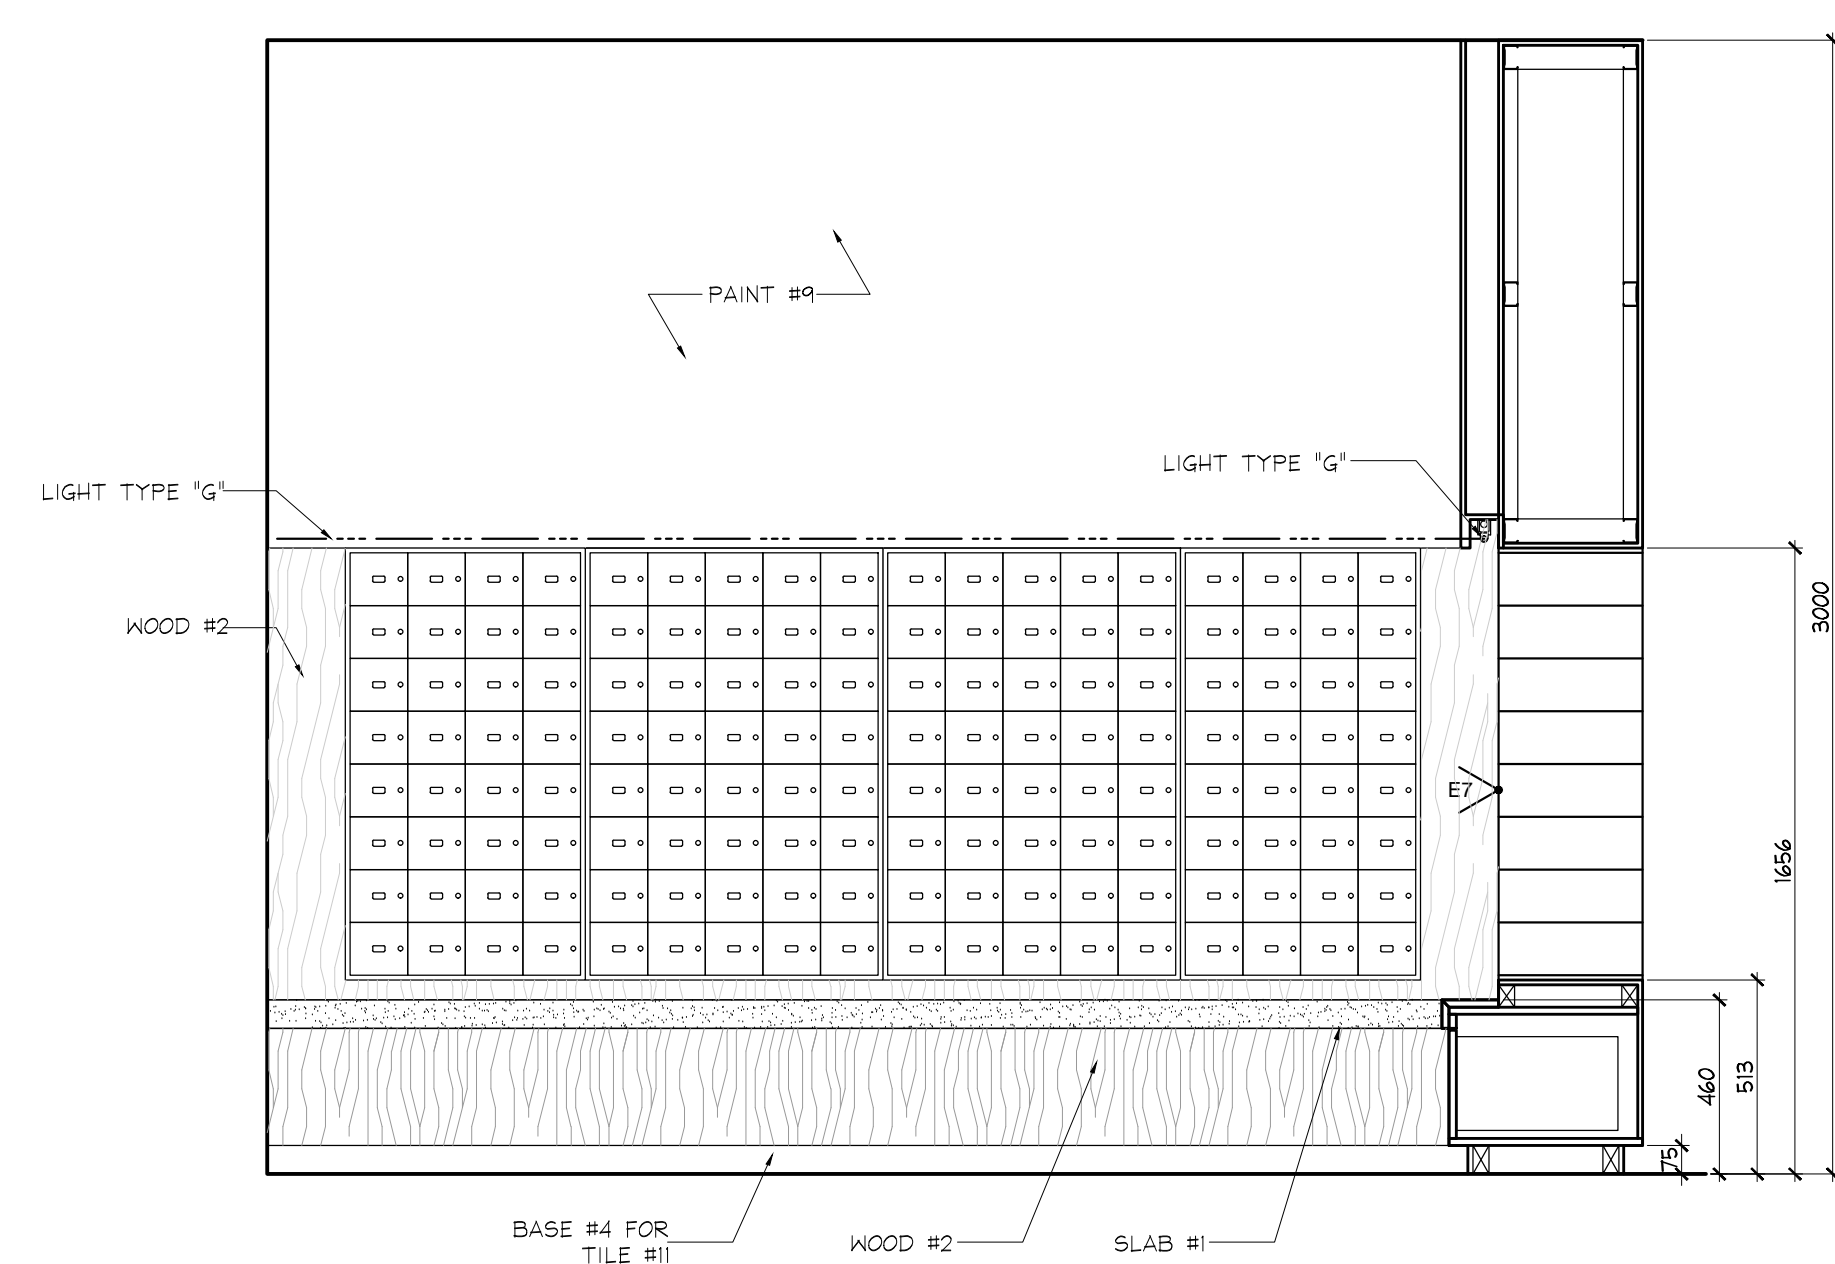


1 ELEVATION  
ID2.1.2 GROUND FLOOR MAILROOM SCALE 1:20

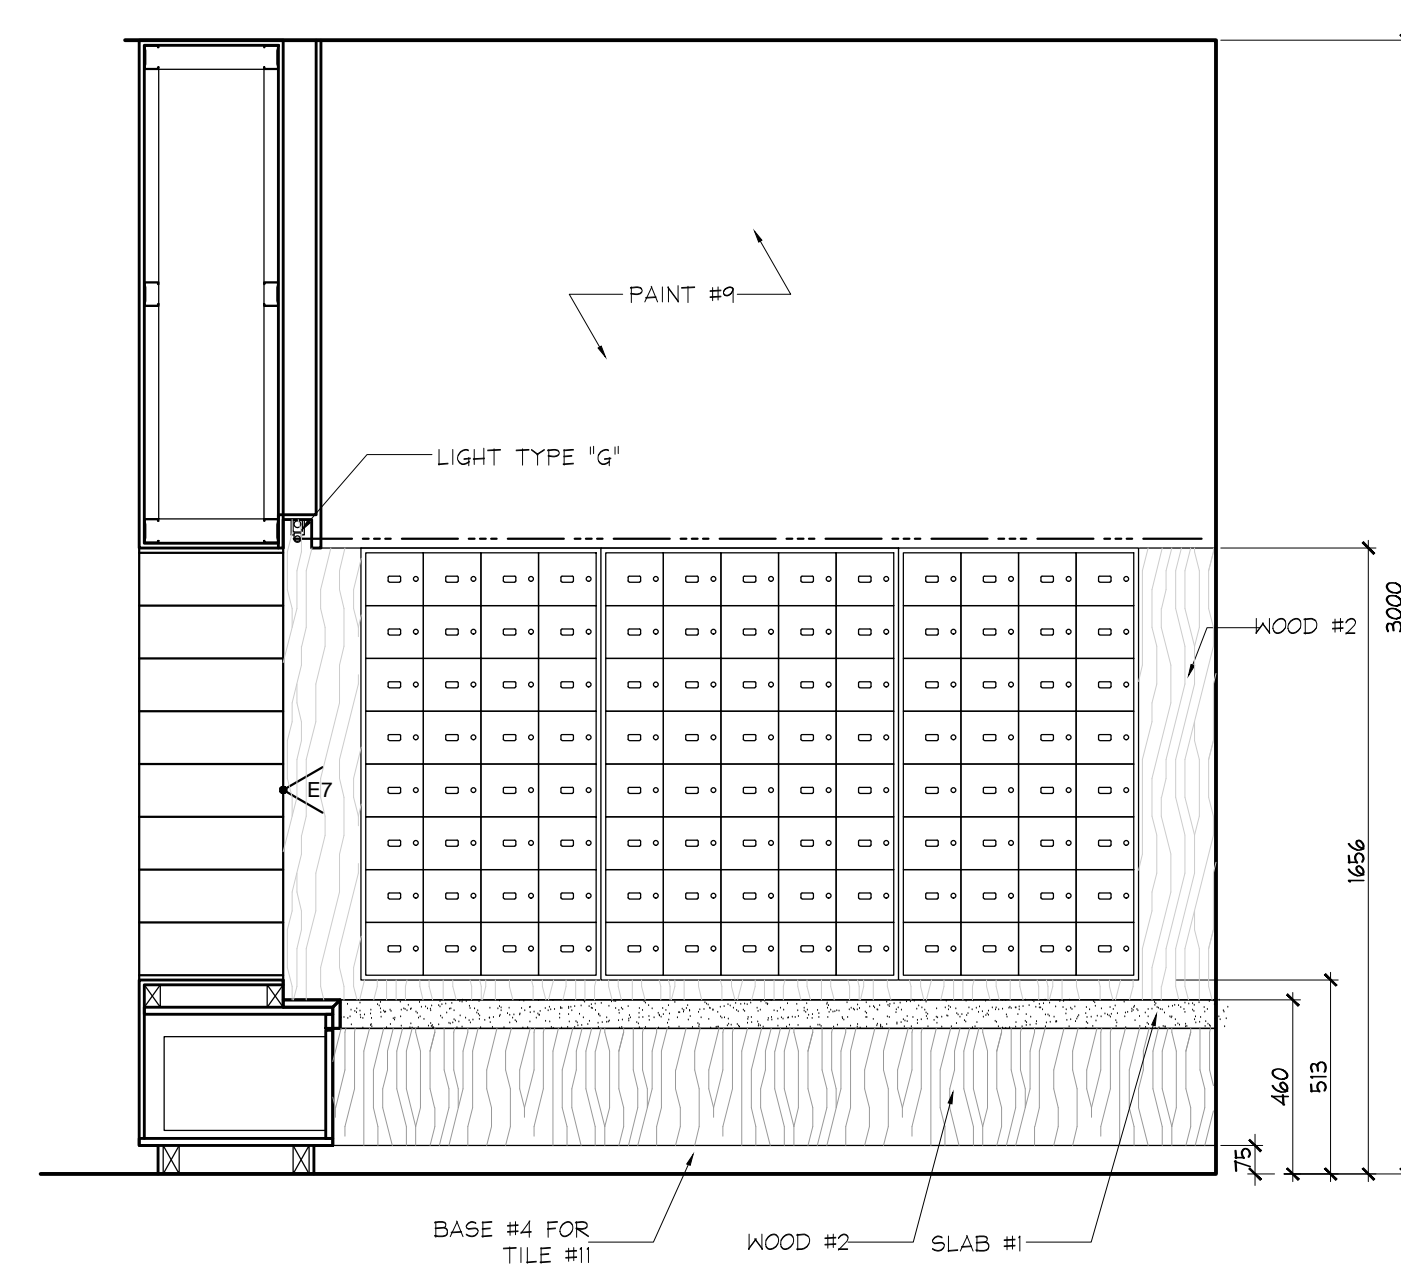


2 ELEVATION  
ID2.1.2 GROUND FLOOR MAILROOM SCALE 1:20

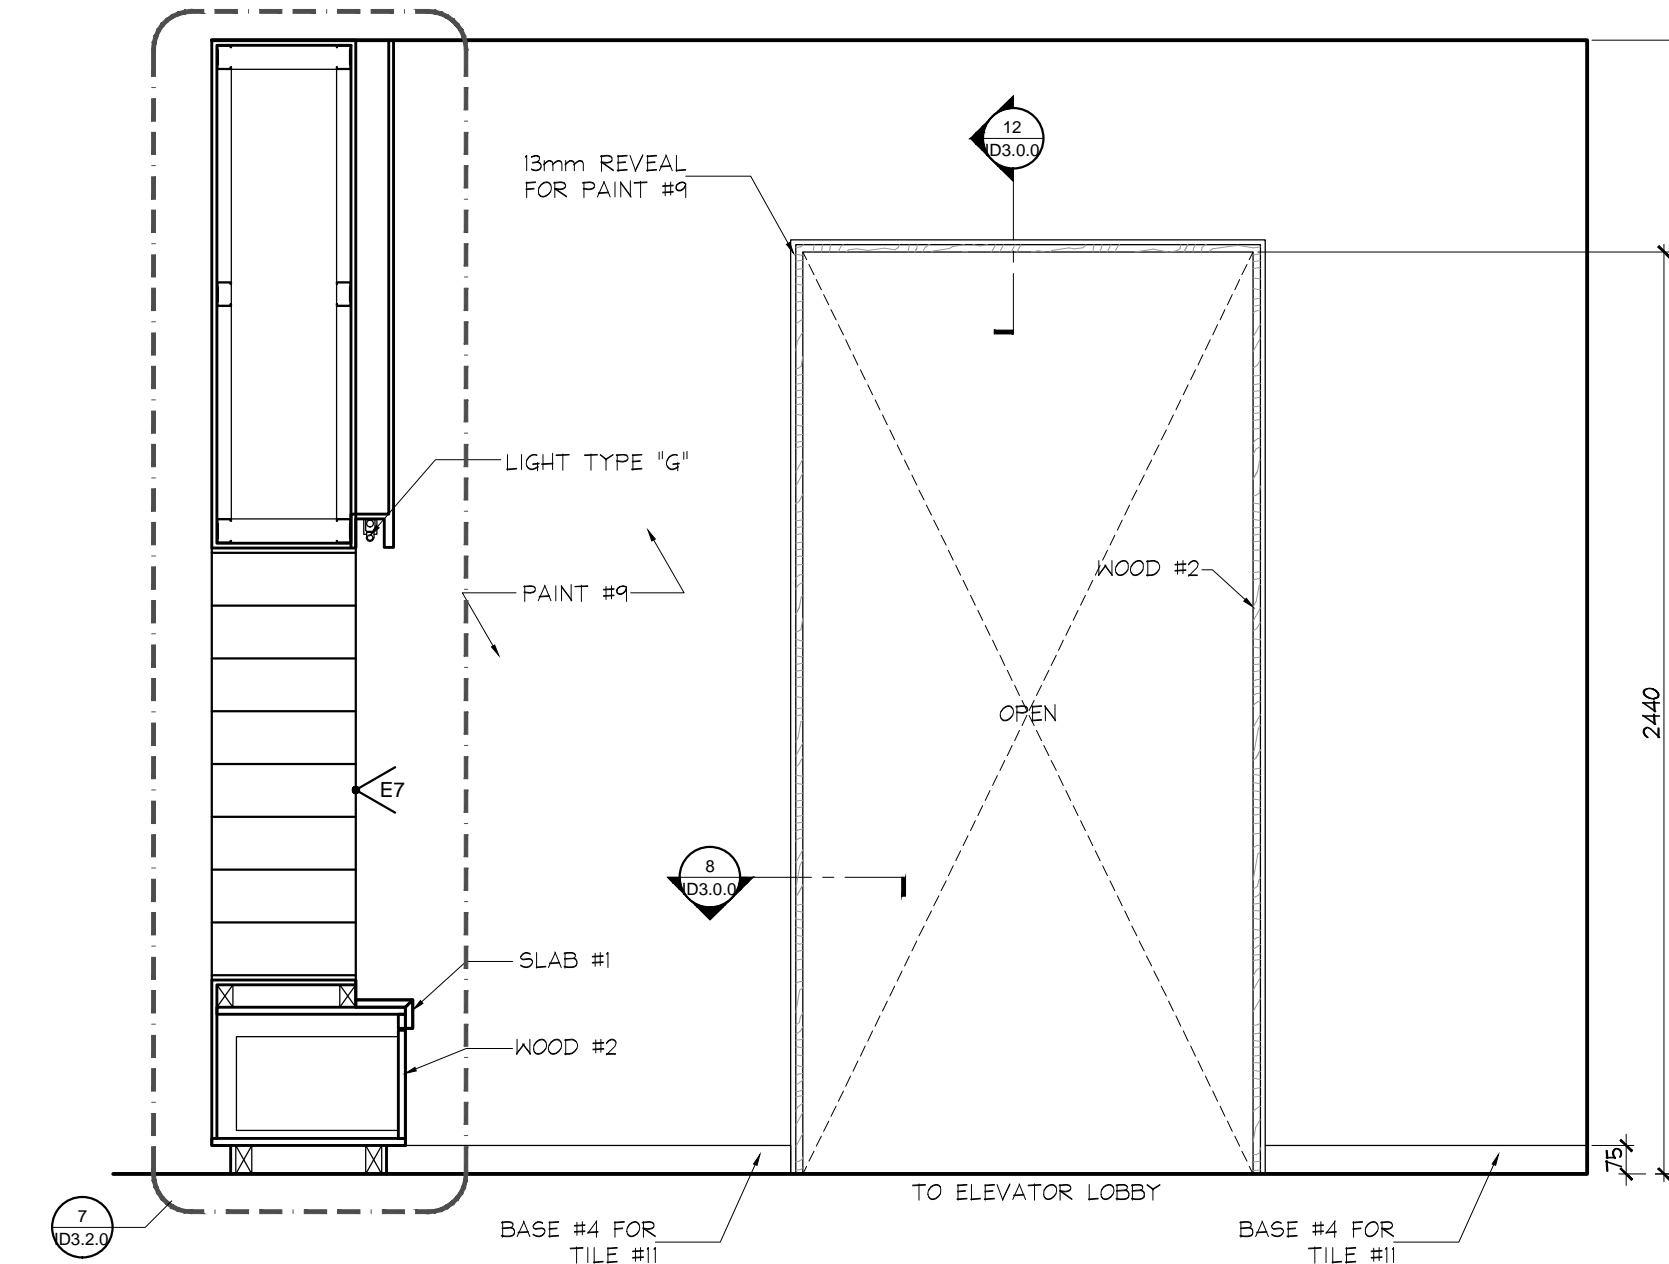

3 ELEVATION  
ID2.1.2 GROUND FLOOR MAILROOM SCALE 1:20

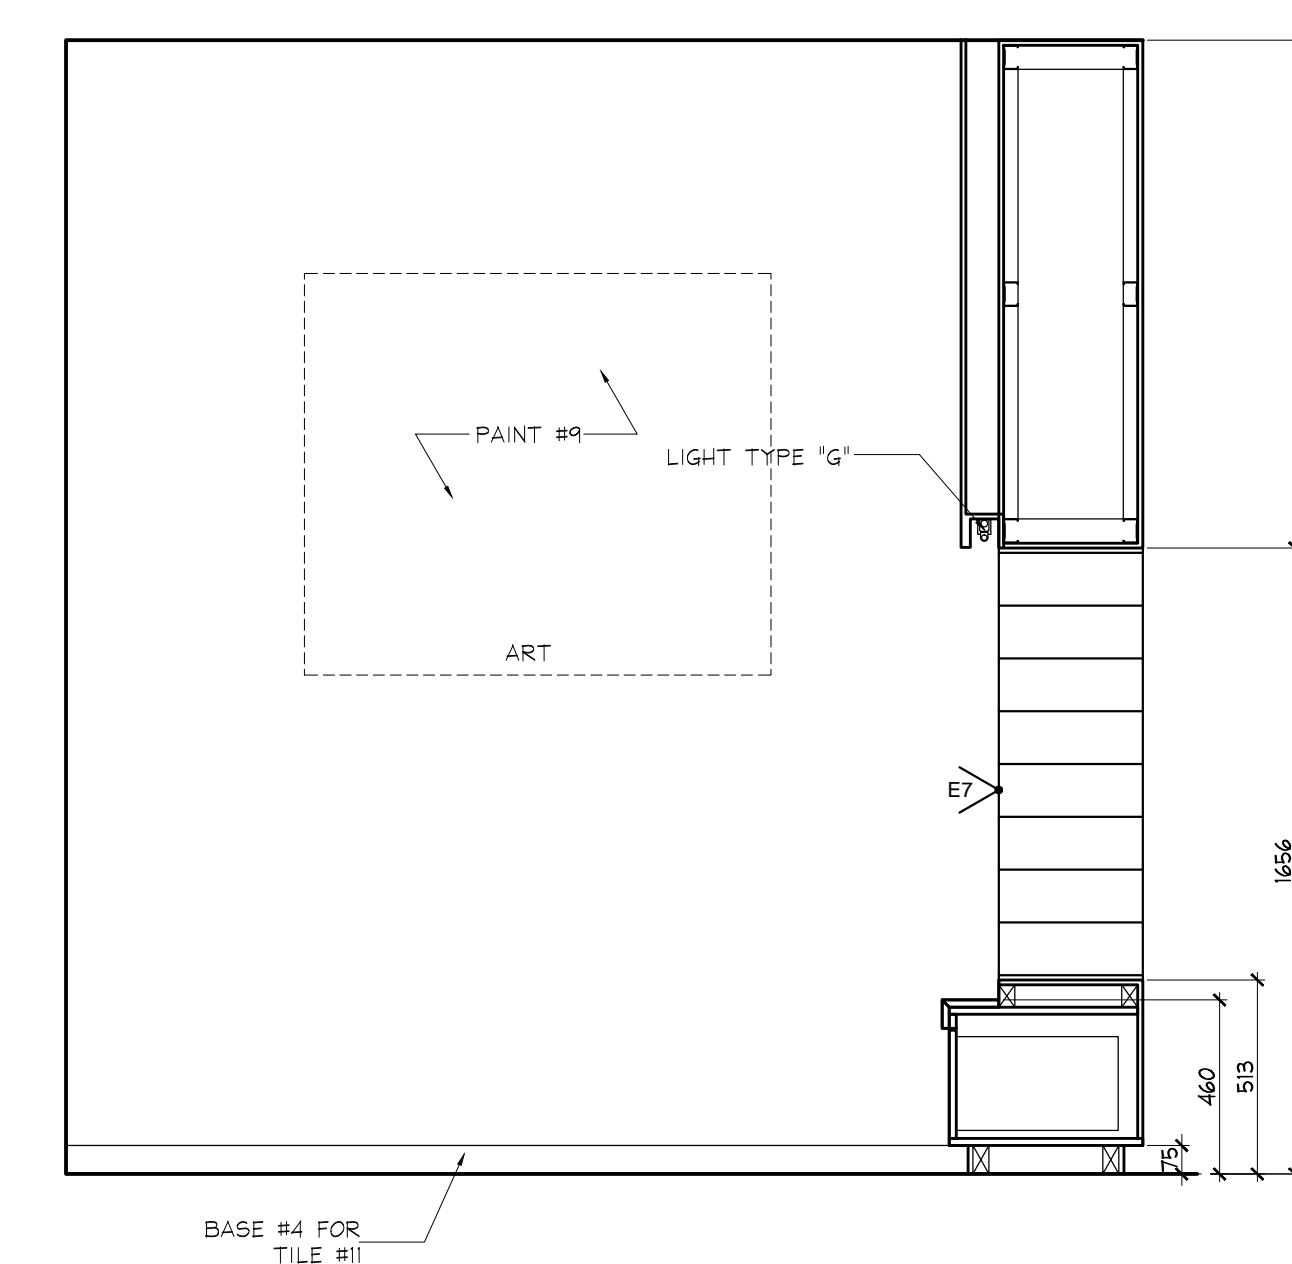

4 ELEVATION  
ID2.1.2 GROUND FLOOR MAILROOM SCALE 1:20

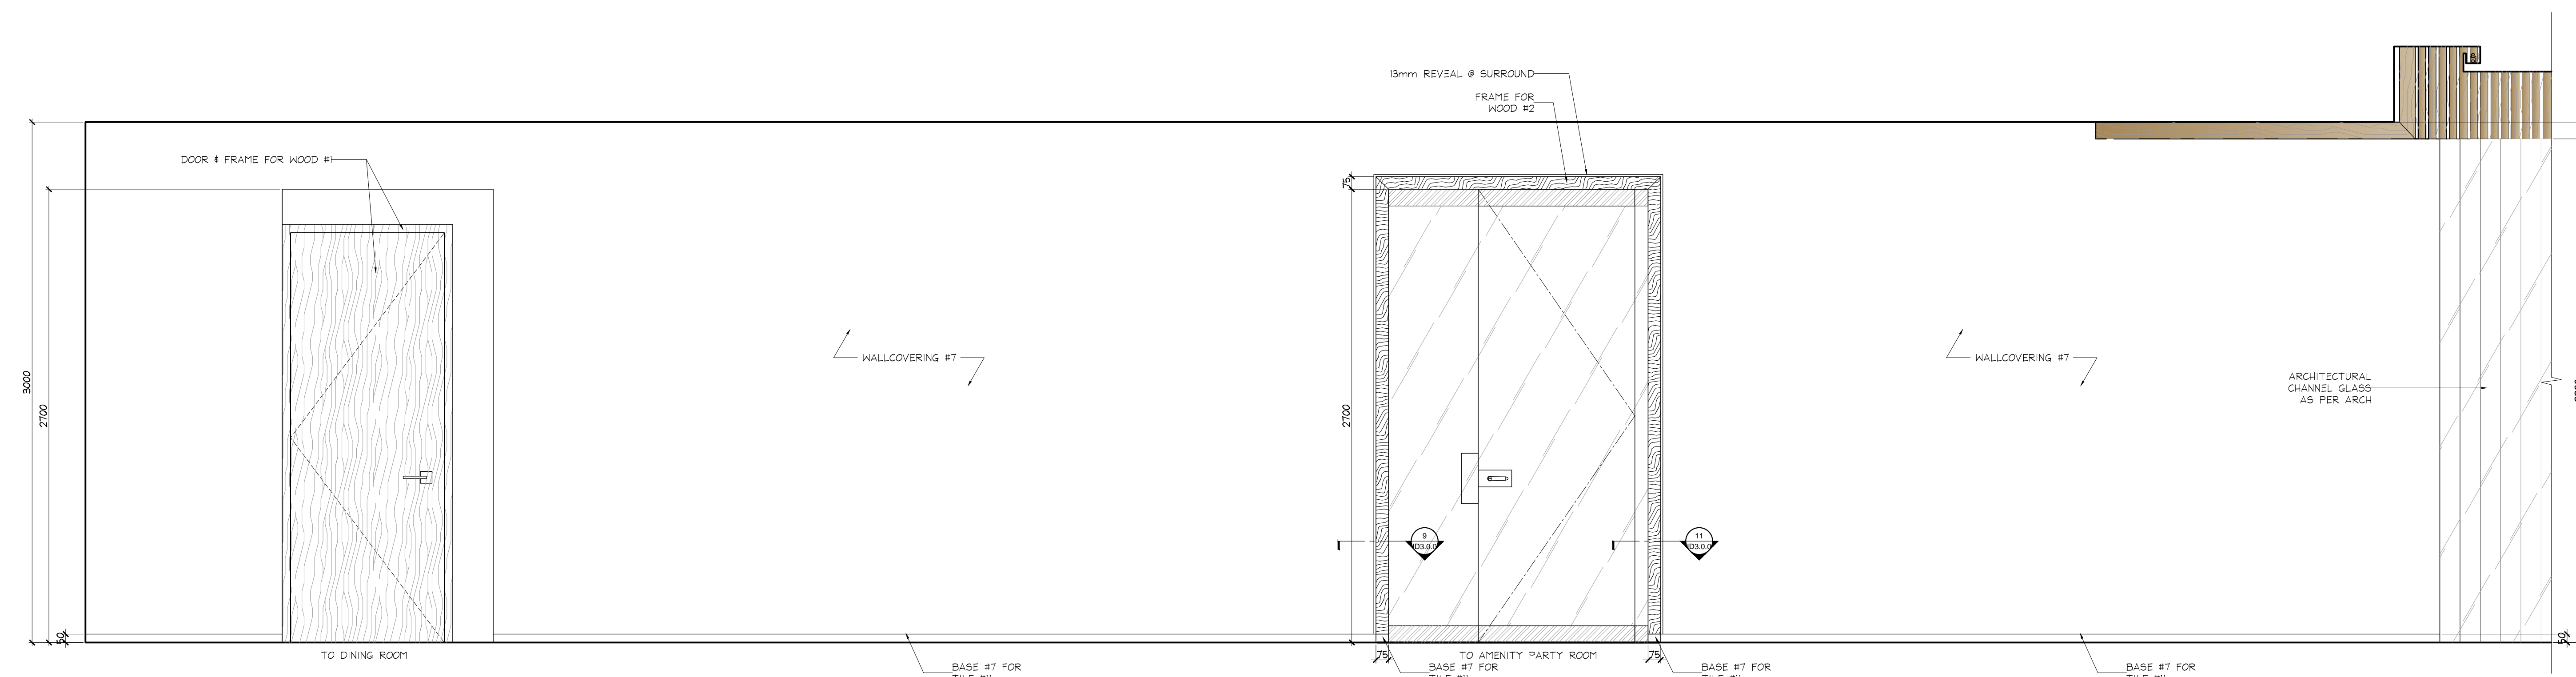

5 ELEVATION  
ID2.1.2 GROUND FLOOR CORRIDOR C SCALE 1:20



6 ELEVATION  
ID2.1.2 GROUND FLOOR CORRIDOR C SCALE 1:20

ISSUED FOR  
AS-BUILT

NO	DATE	COMMENTS	INI
01	31 MAY / 17	ISSUED FOR AS-BUILT	SV

UNION 31

UNION 31 INC.  
183 BATHURST STREET, STE. 201  
TORONTO, ON, M5T 2R7, CANADA  
TEL: 416-597-1576 FAX: 416-597-2339

PROJECT NAME:  
**ALEXANDRA PARK  
MAIN BUILDING**  
BLOCK 11  
ON, Canada

PROJECT NO.:  
13-949

DRAWINGS:  
**GROUND FLOOR  
ELEVATIONS**

DATE STARTED: 07 AUG / 13	DRAWING NO.:
SCALE: 1 : 20	<b>ID</b>
DRAWN BY: AP	<b>2.1.2</b>
APPROVED BY: KC	