


DO NOT SCALE DRAWINGS.


CONTRACTOR MUST VERIFY ALL DRAWINGS, DIMENSIONS, DETAILS AND SPECIFICATIONS, AND REPORT ANY DISCREPANCIES TO UNION31 INC. BEFORE PROCEEDING WITH WORK. MATERIALS MAY NOT BE SUBSTITUTED WITHOUT WRITTEN APPROVAL FROM UNION31 INC. ALL DRAWINGS AND SPECIFICATIONS ARE INSTRUMENTS OF SERVICE AND THE PROPERTY OF UNION31 INC. WHICH MUST BE RETURNED AT THE COMPLETION OF THE WORK.

PRINTED: 30-May-17

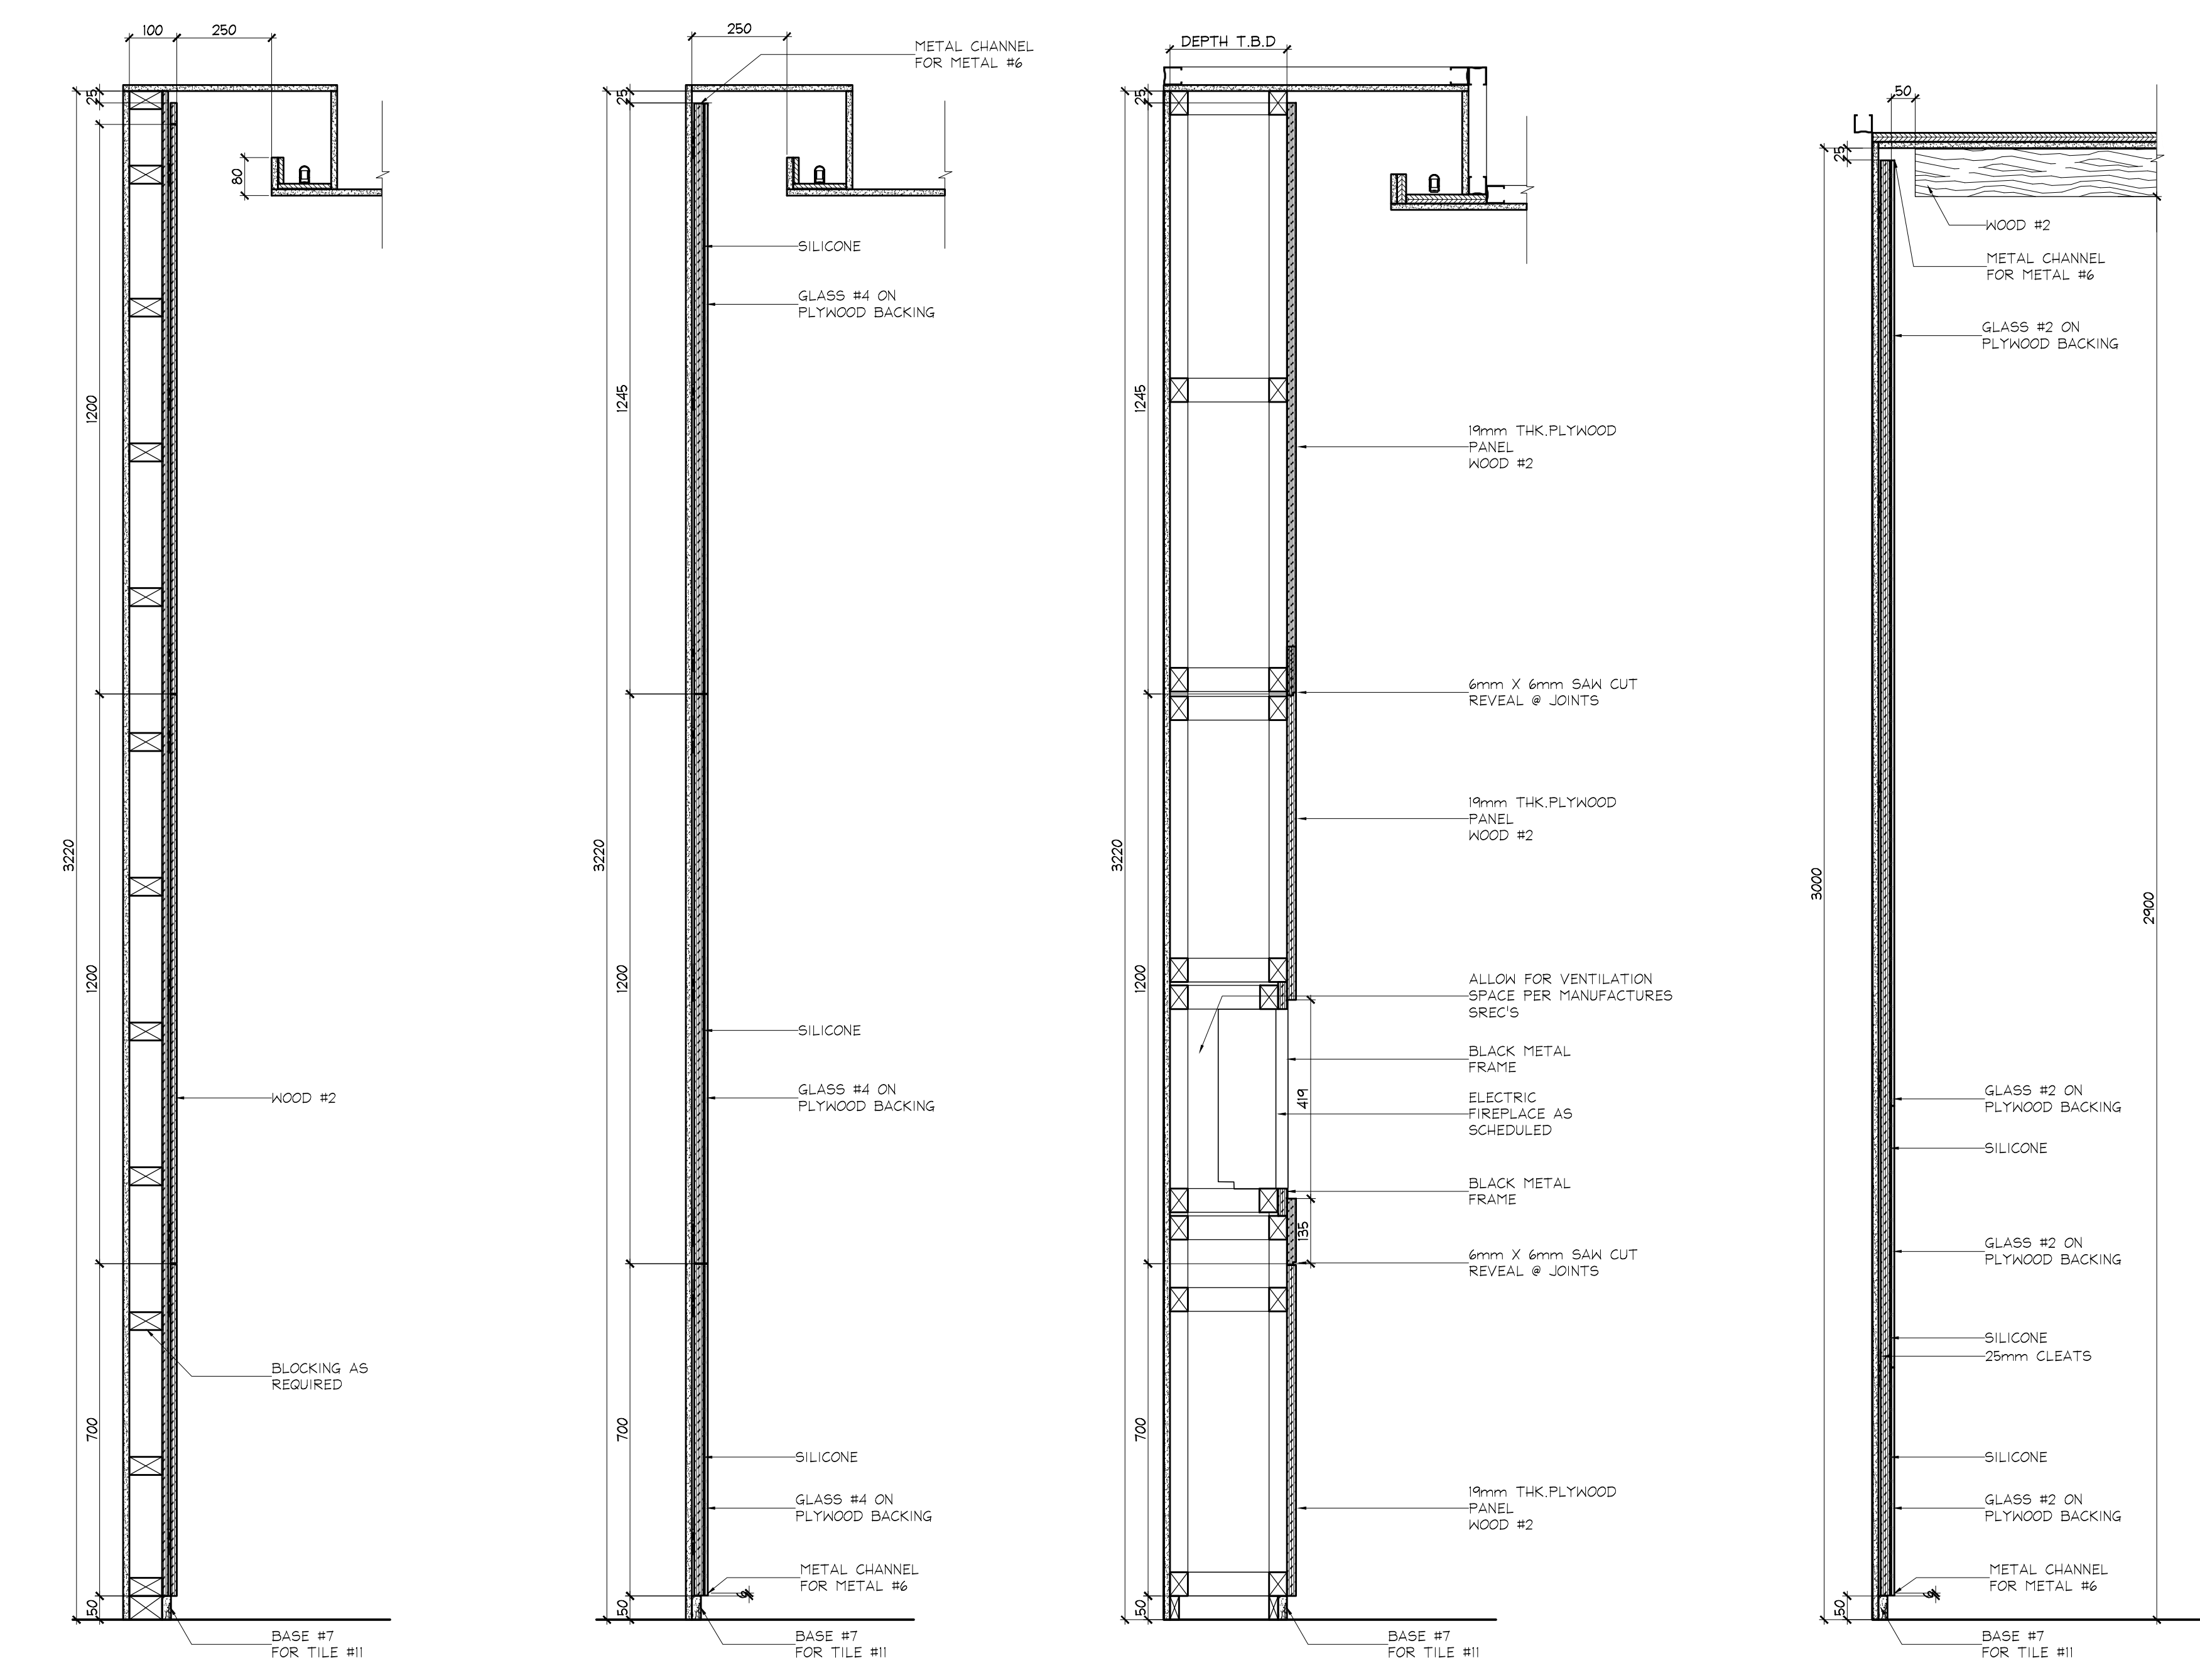


1 WALL SECTION 1ST FLOOR LOBBY SCALE 1:10
 2 WALL SECTION 1ST FLOOR LOBBY SCALE 1:10
 3 WALL SECTION @ LOBBY FIREPLACE 1ST FLOOR LOBBY SCALE 1:10
 4 WALL SECTION 1ST FLOOR LOBBY SCALE 1:10

5 WALL SECTION @ TV BEHIND CONCERGE 1ST FLOOR LOBBY SCALE 1:10
 6 WALL SECTION 1ST FLOOR MAILROOM SCALE 1:10

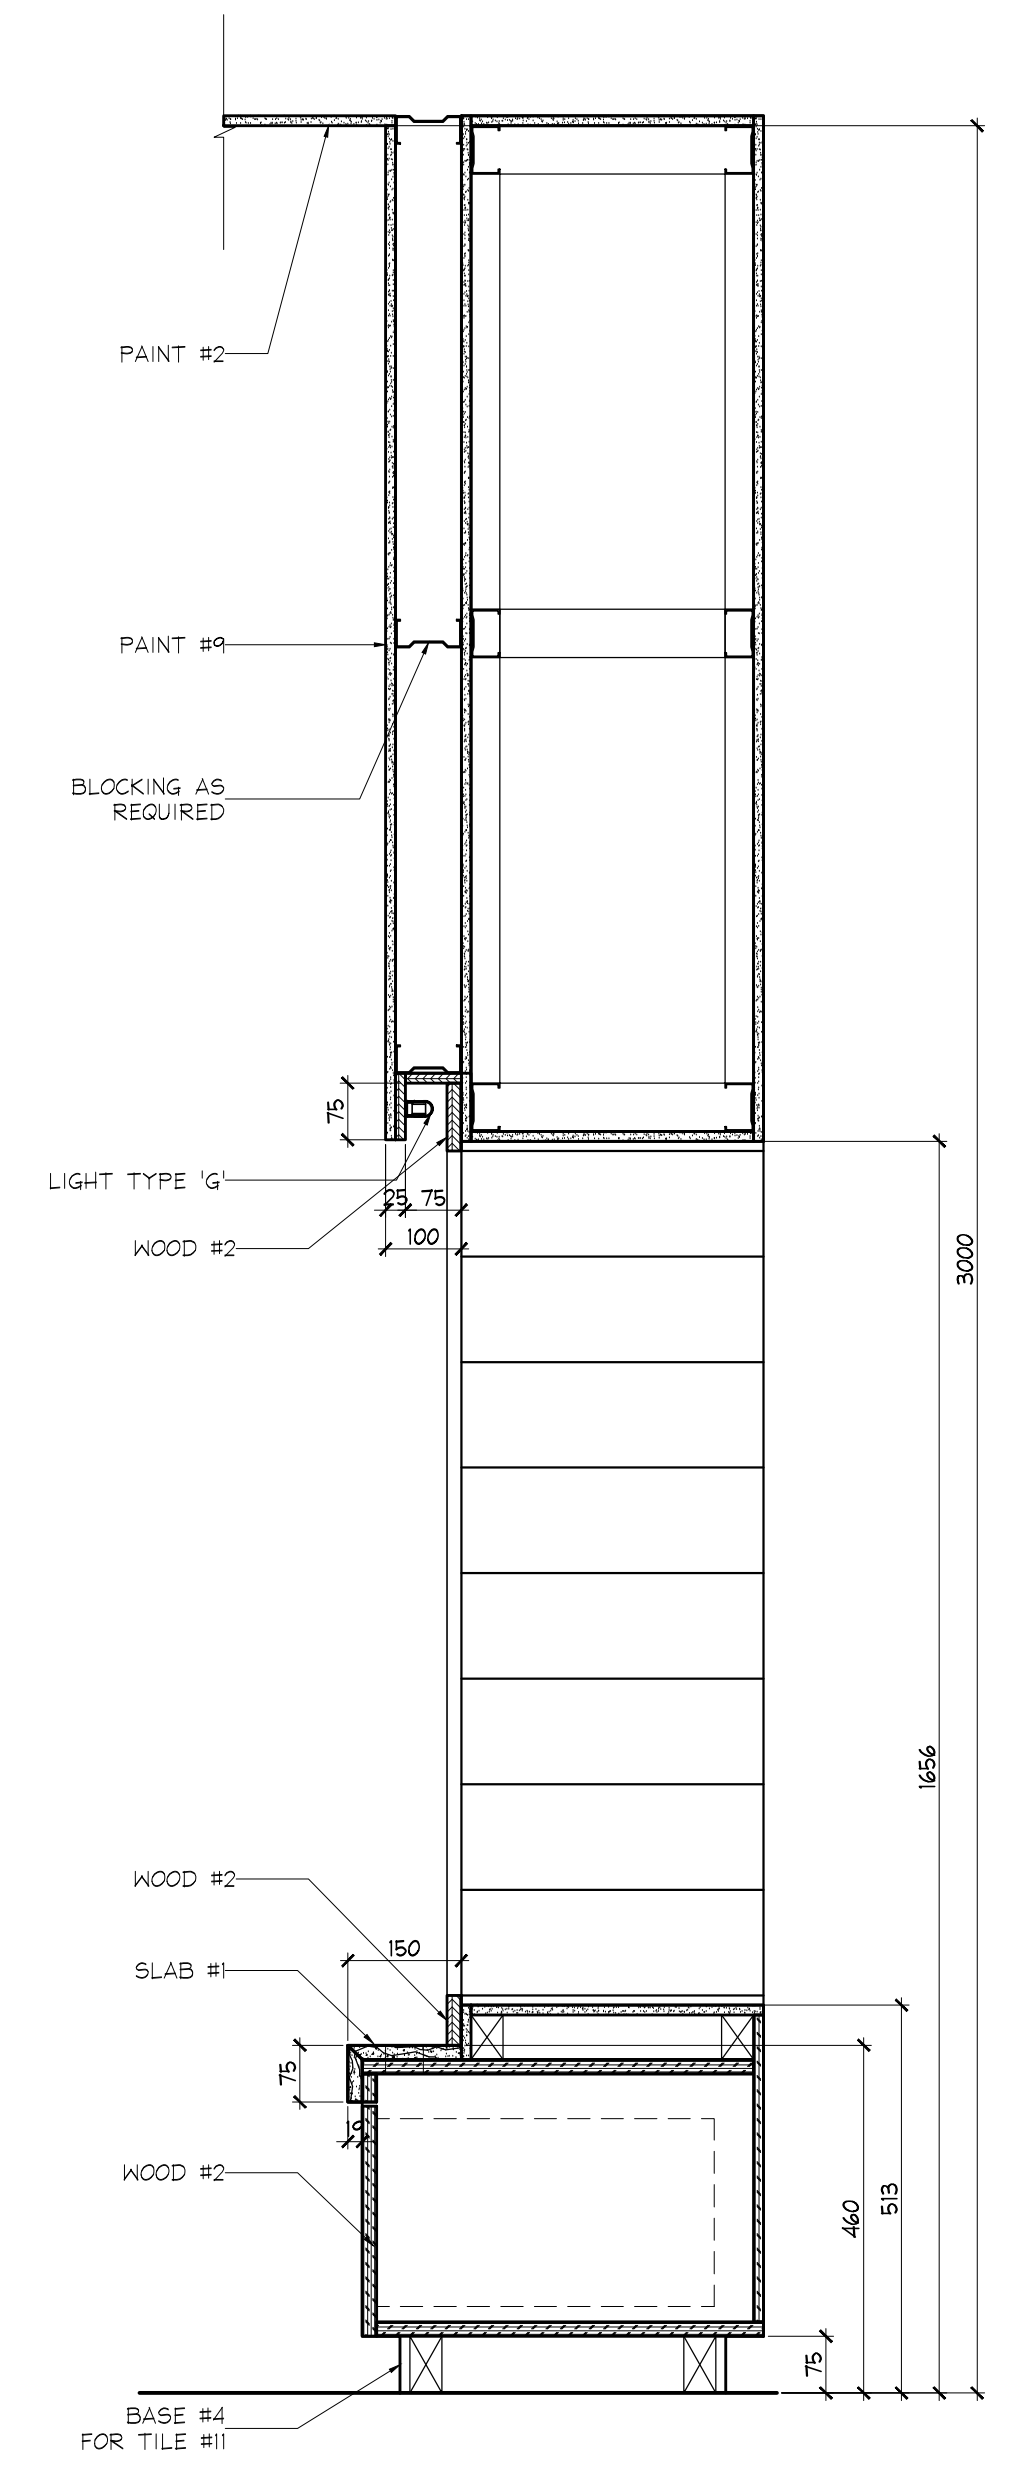


7 WALL SECTION 1ST FLOOR MAILROOM SCALE 1:10


ISSUED FOR AS-BUILT

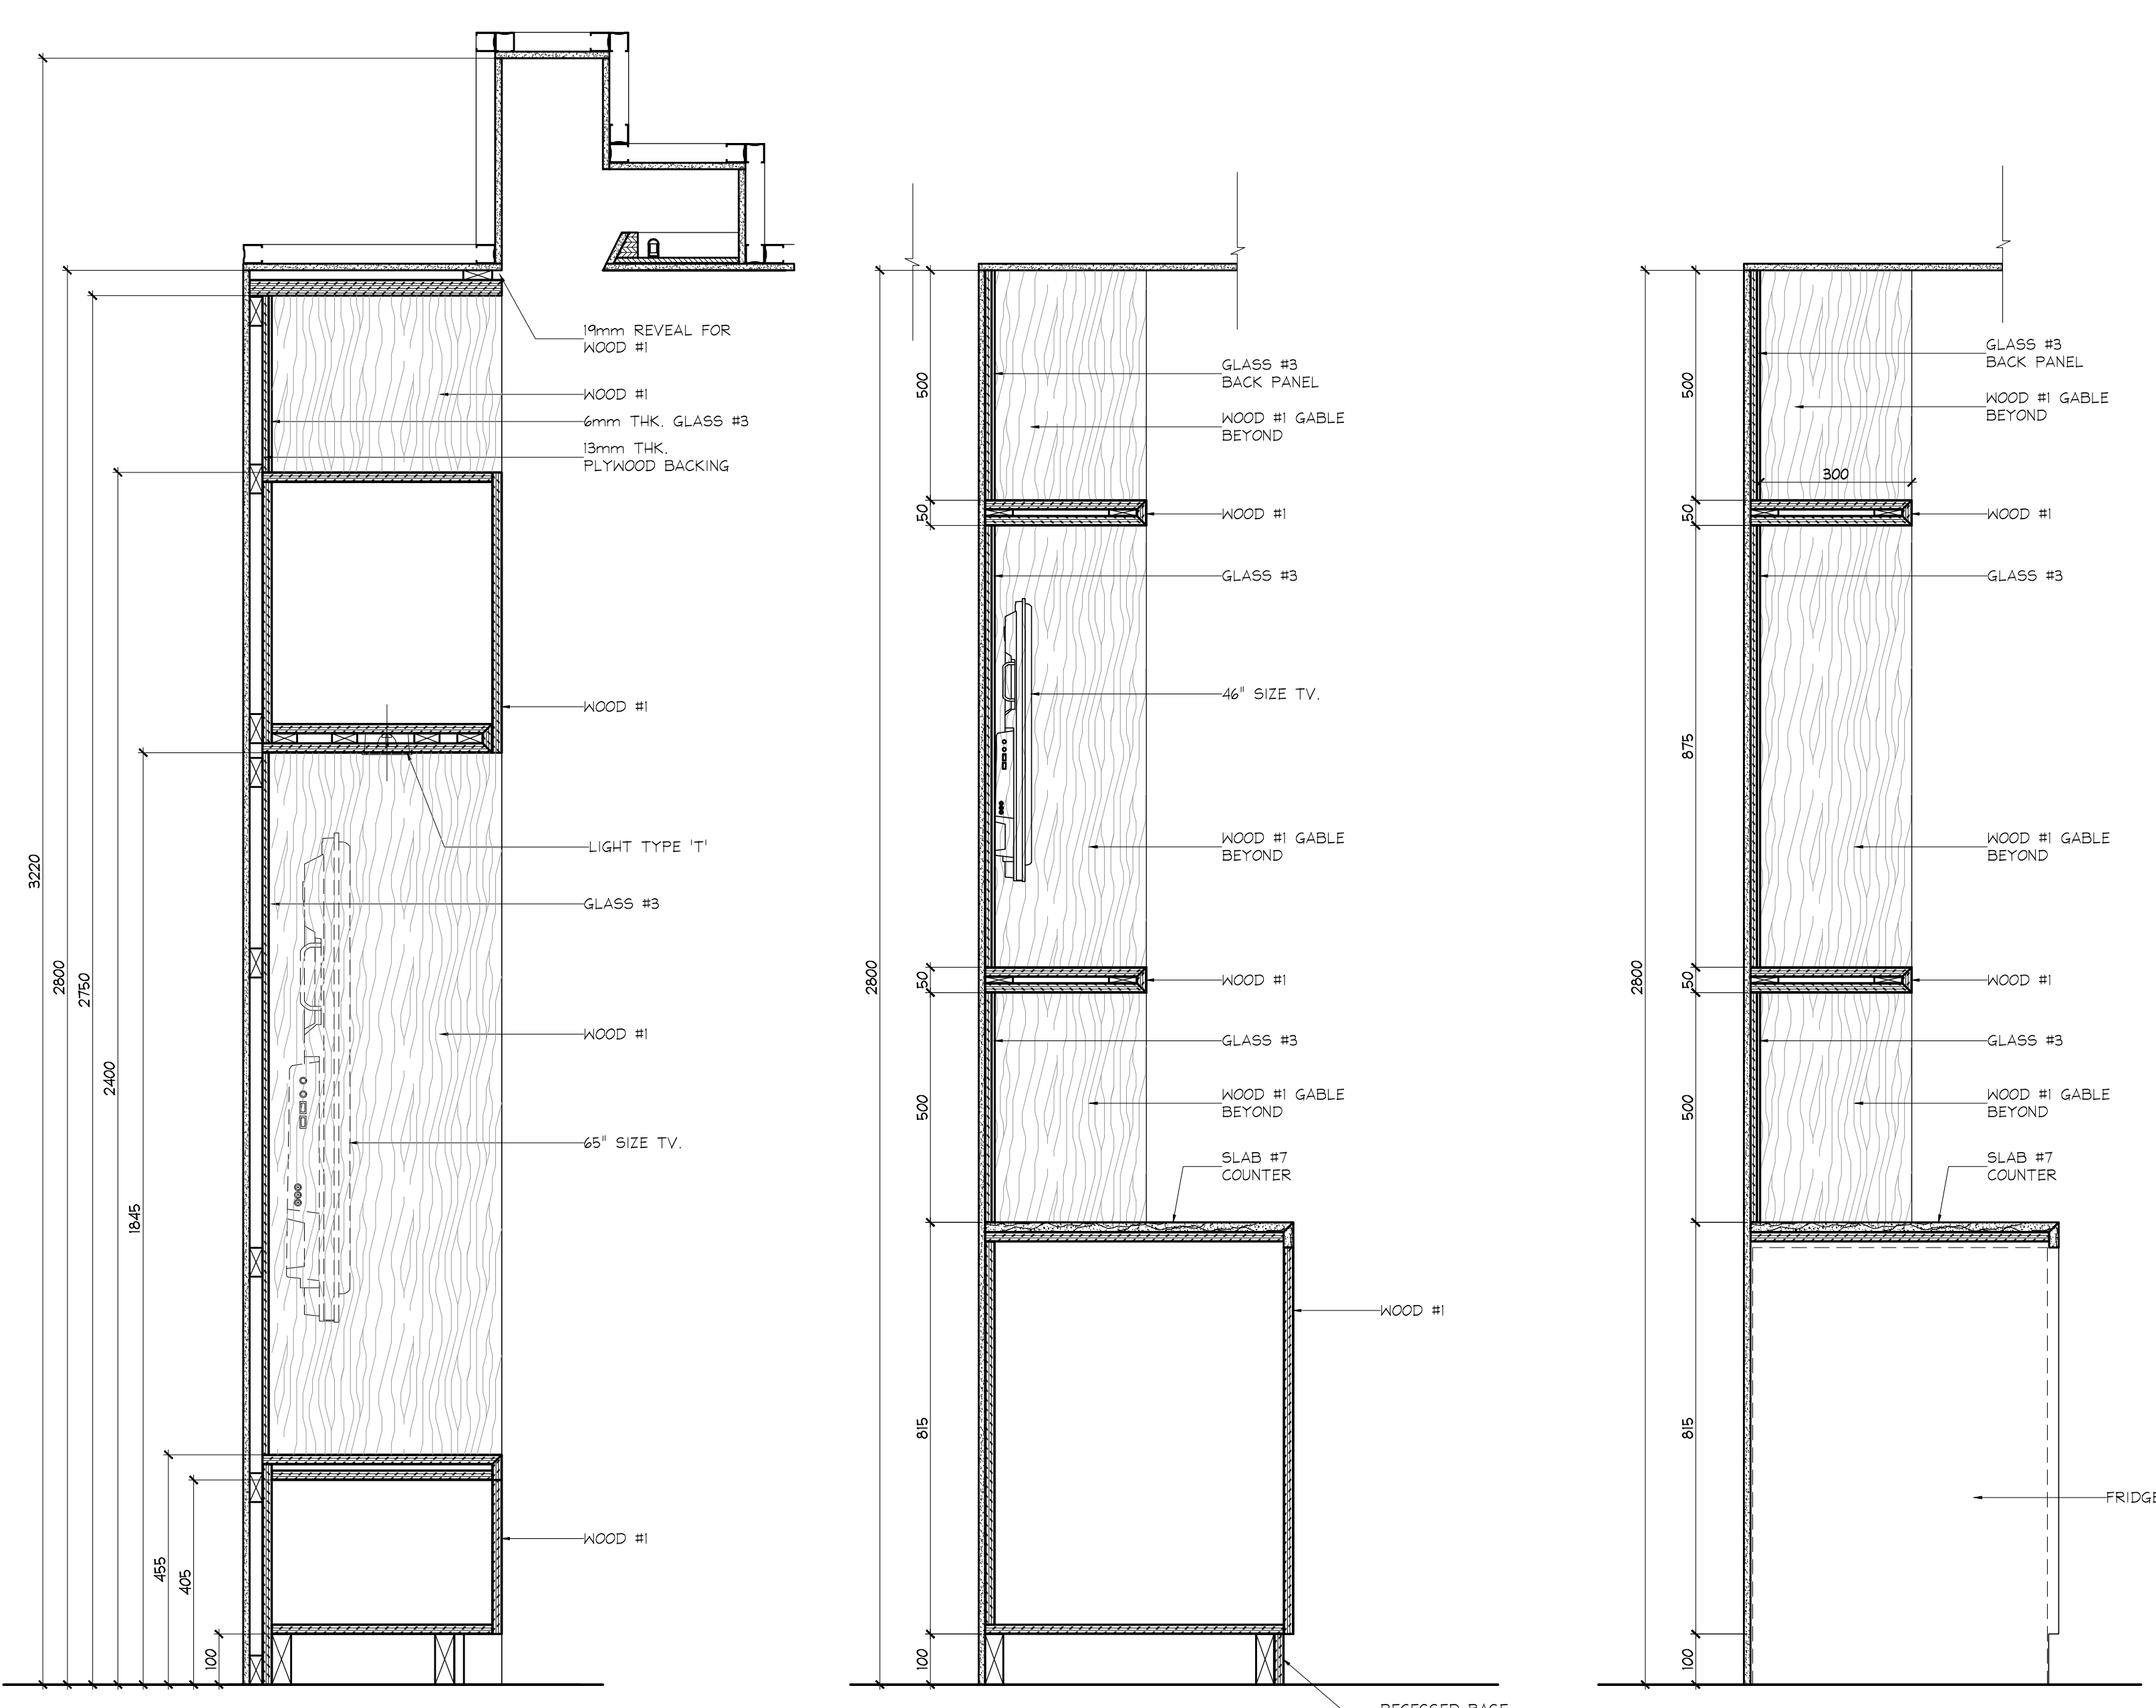


8 WALL SECTION 1ST FLOOR PARTY ROOM SCALE 1:10
 9 WALL SECTION @ TV 1ST FLOOR PARTY ROOM SCALE 1:10
 10 WALL SECTION 1ST FLOOR PARTY ROOM SCALE 1:10

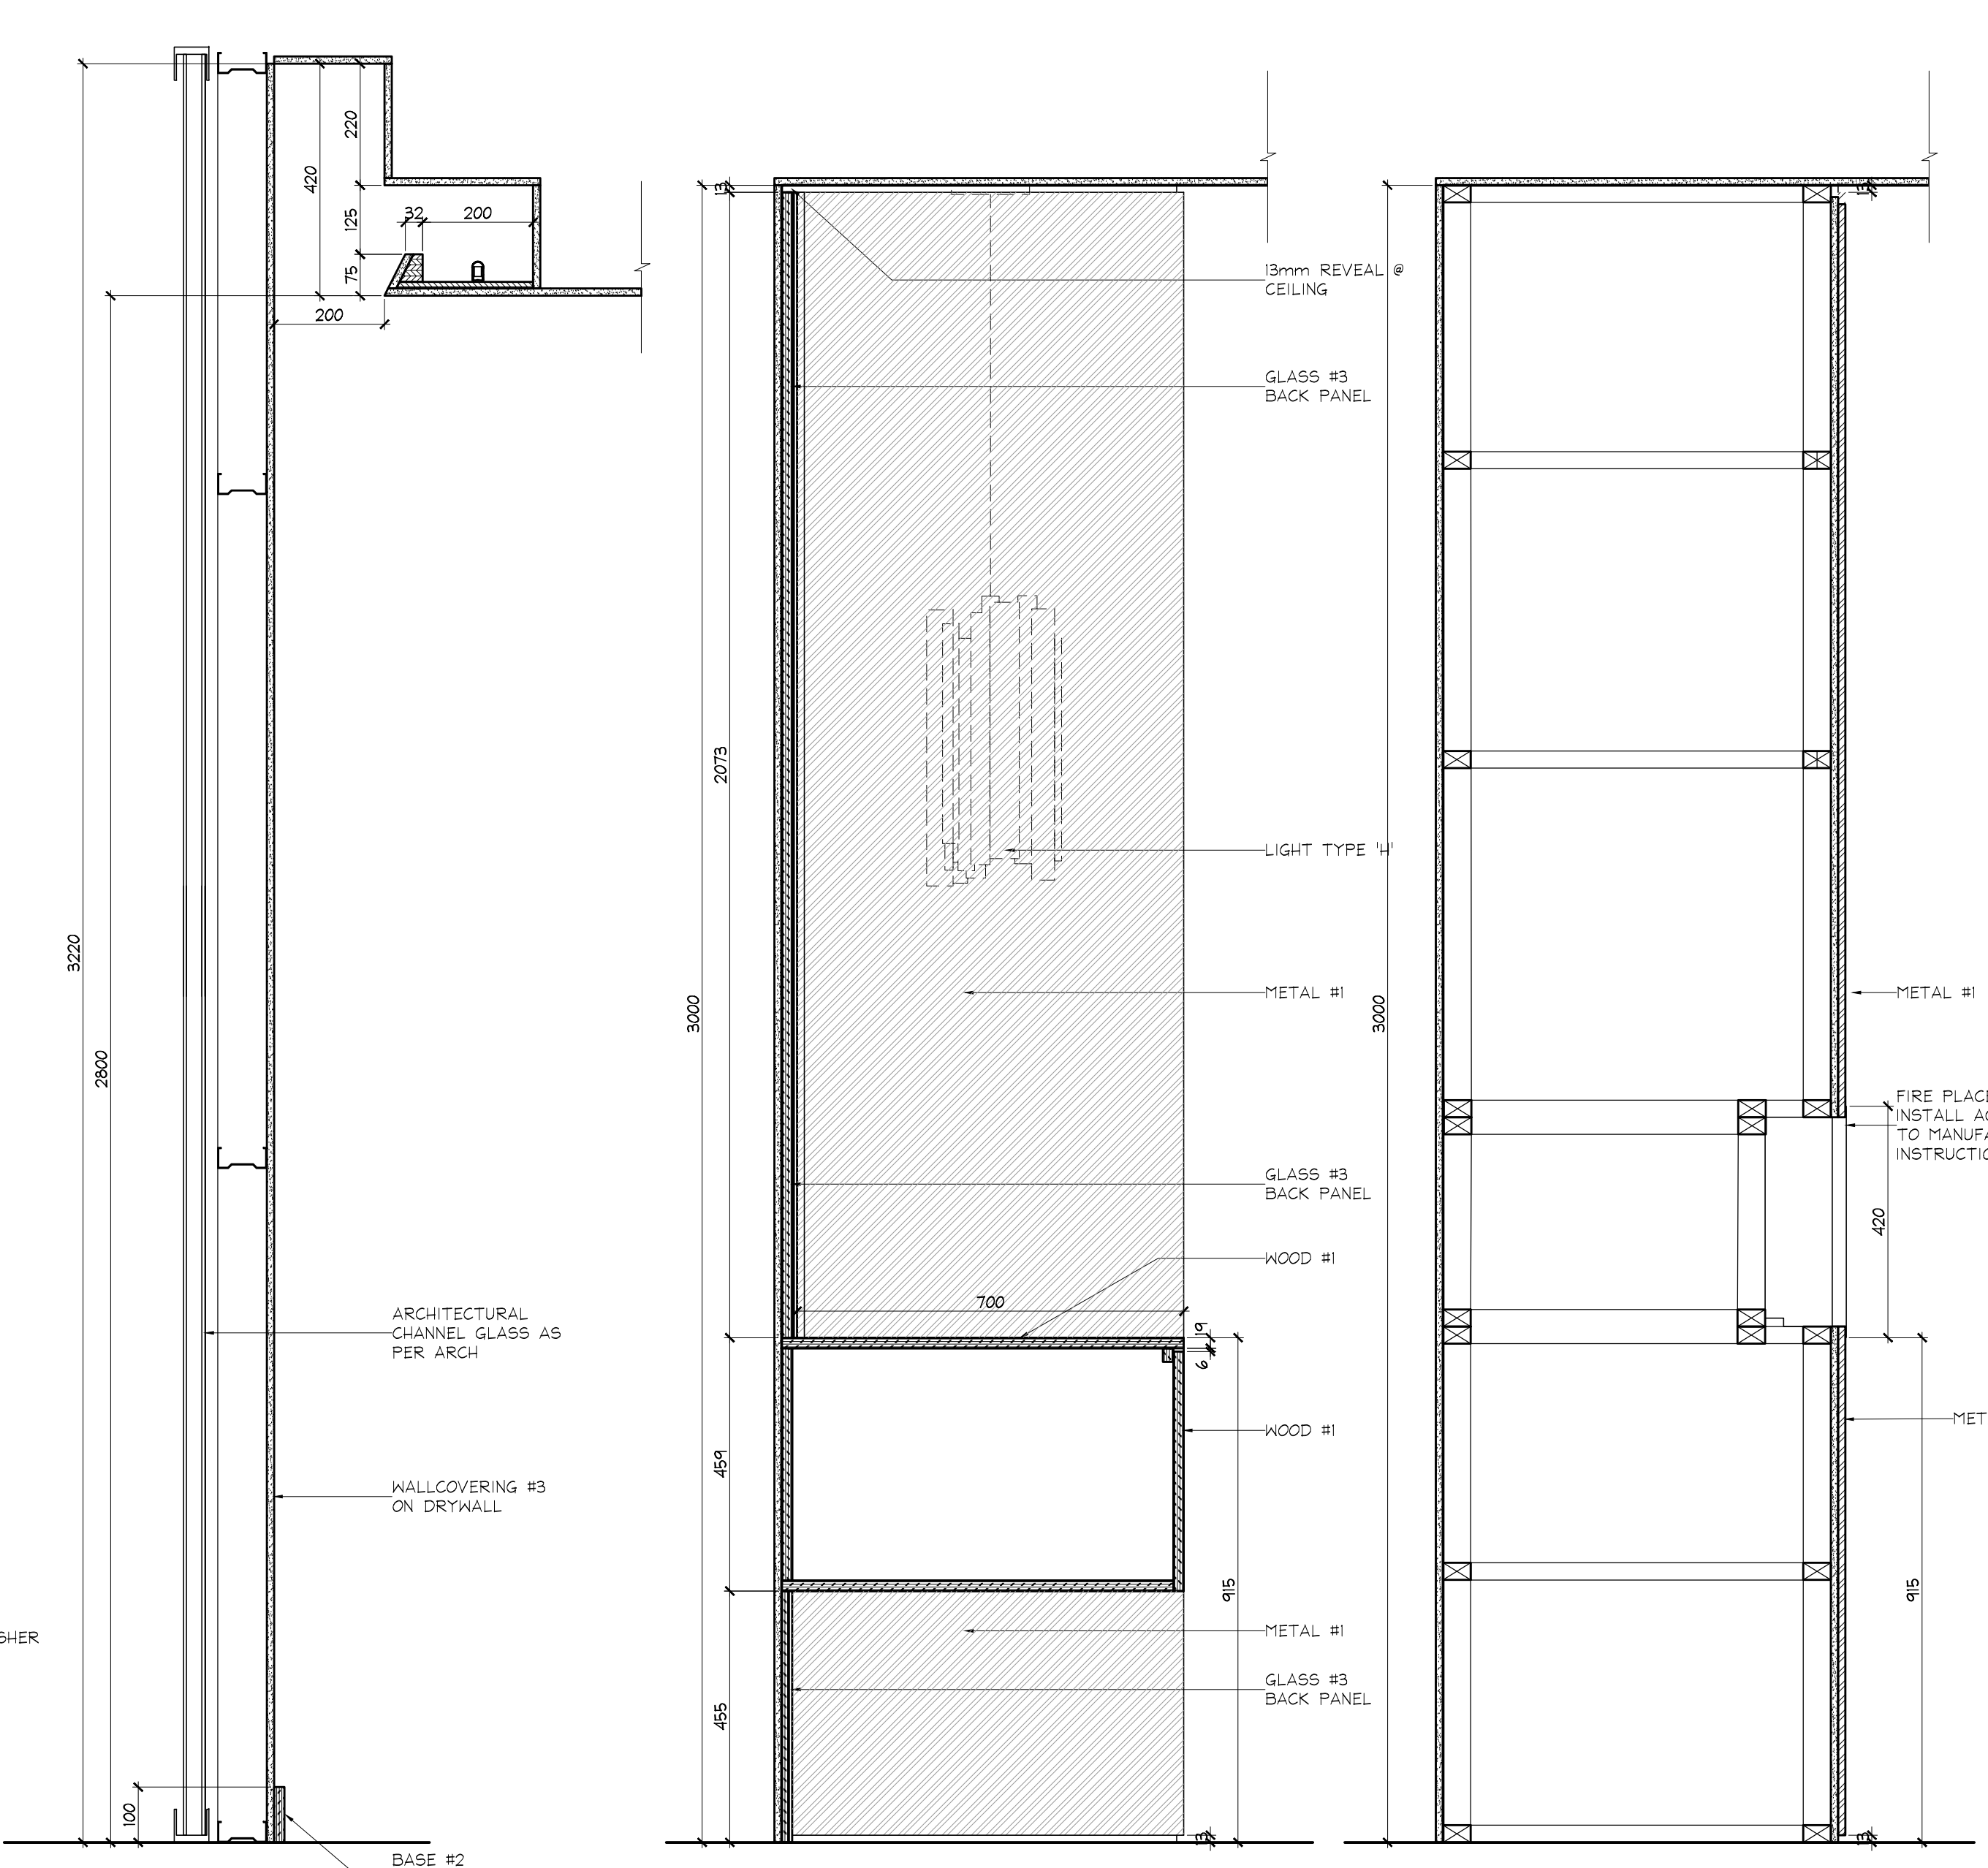

11 WALL SECTION 1ST FLOOR PARTY ROOM SCALE 1:10
 12 SECTION @ MIRROR 1ST FLOOR DINING ROOM SCALE 1:10

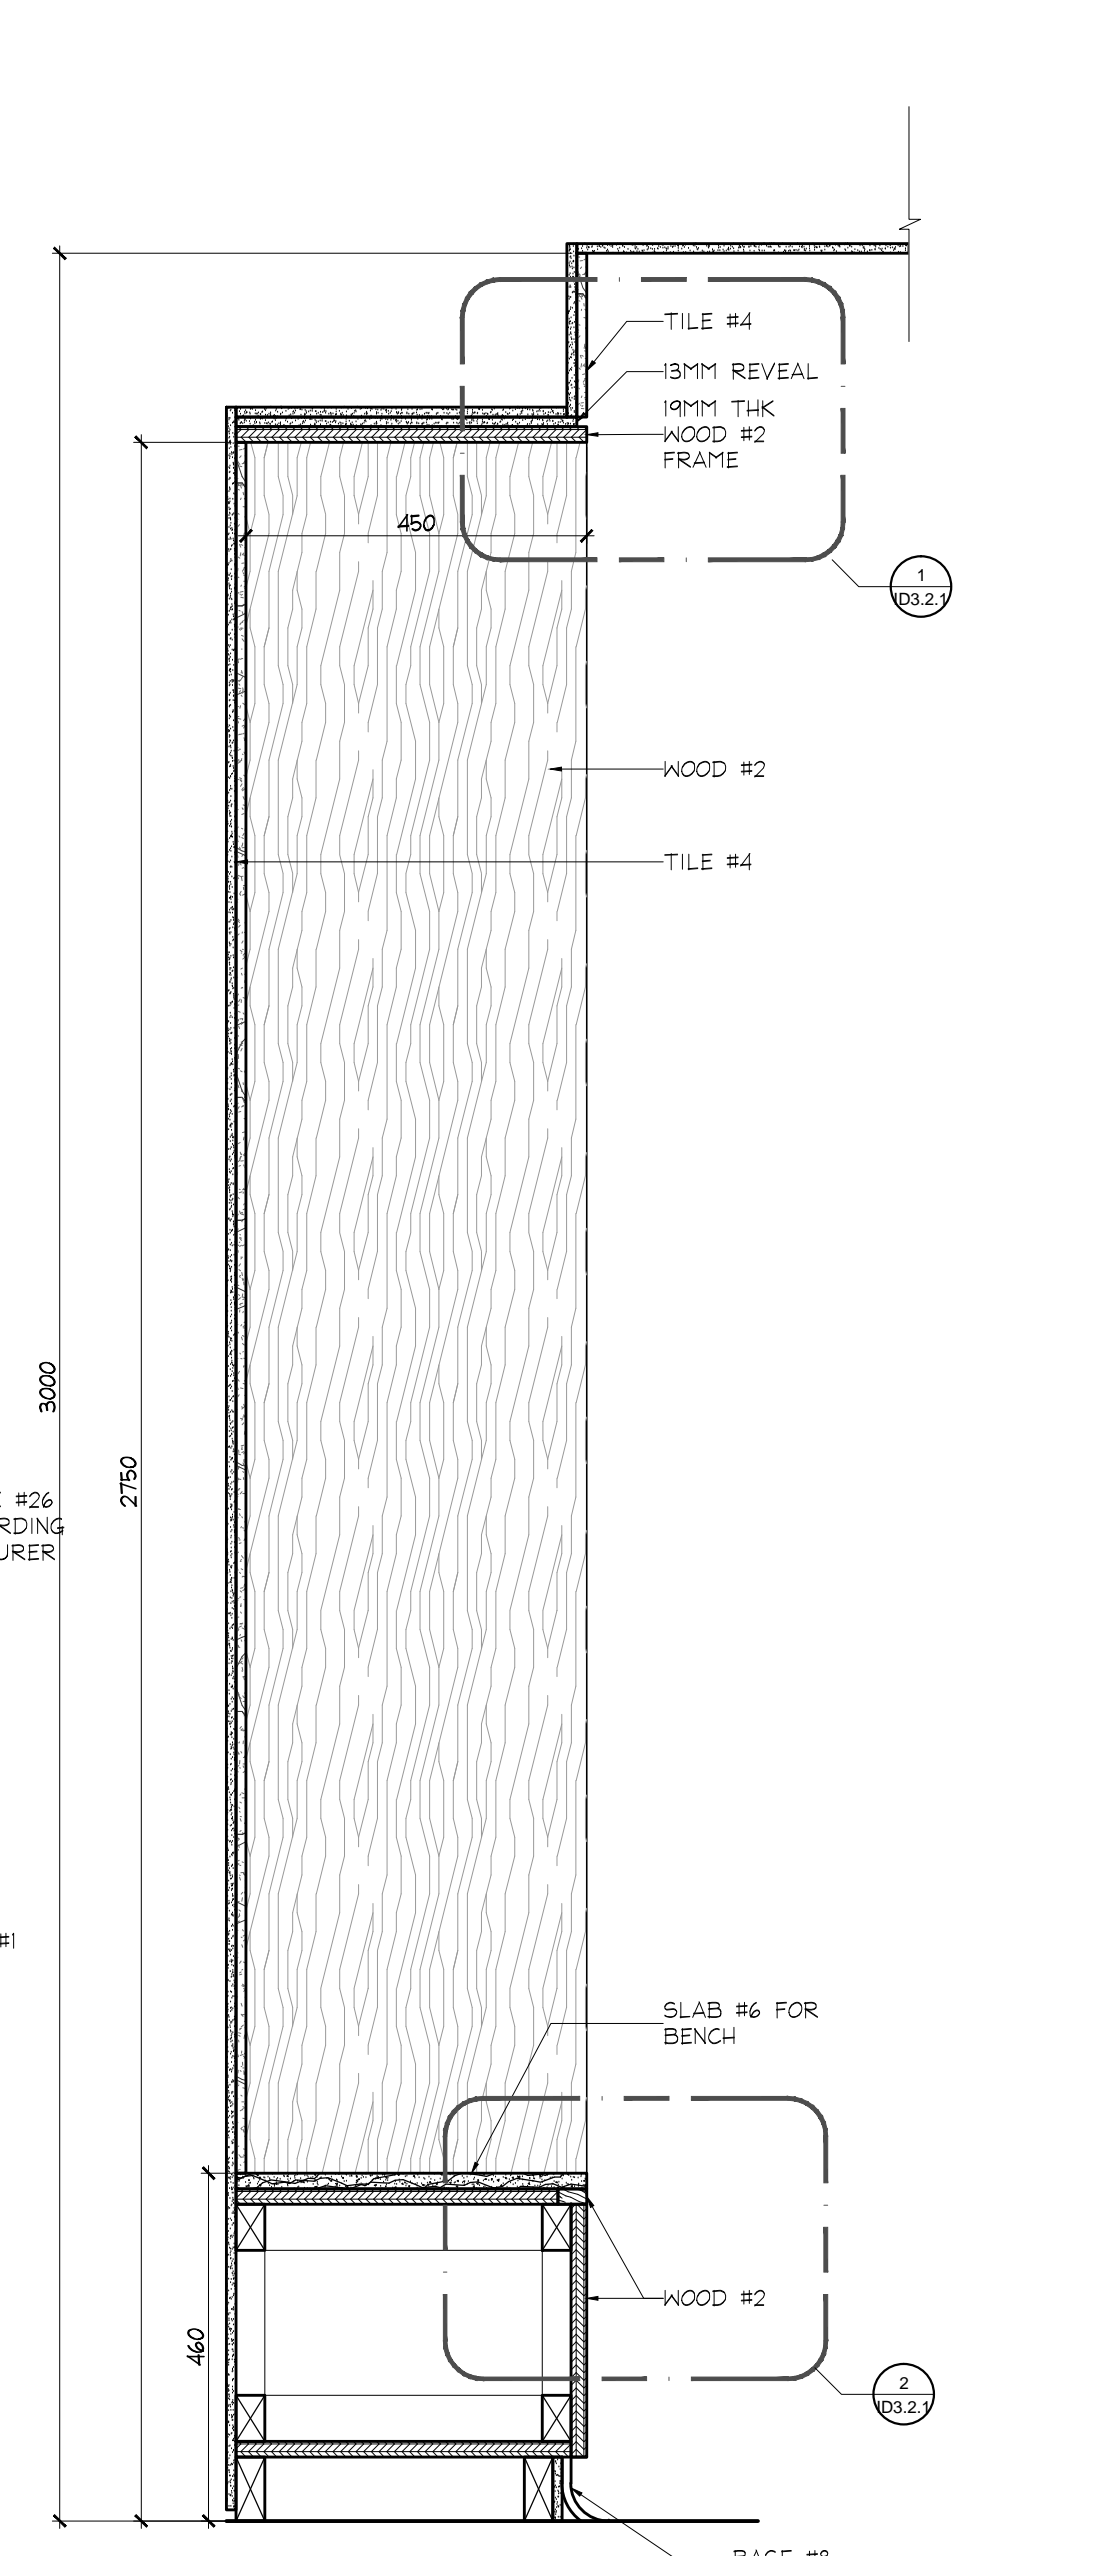

13 SECTION @ FIRE PLACE 1ST FLOOR DINING ROOM SCALE 1:10

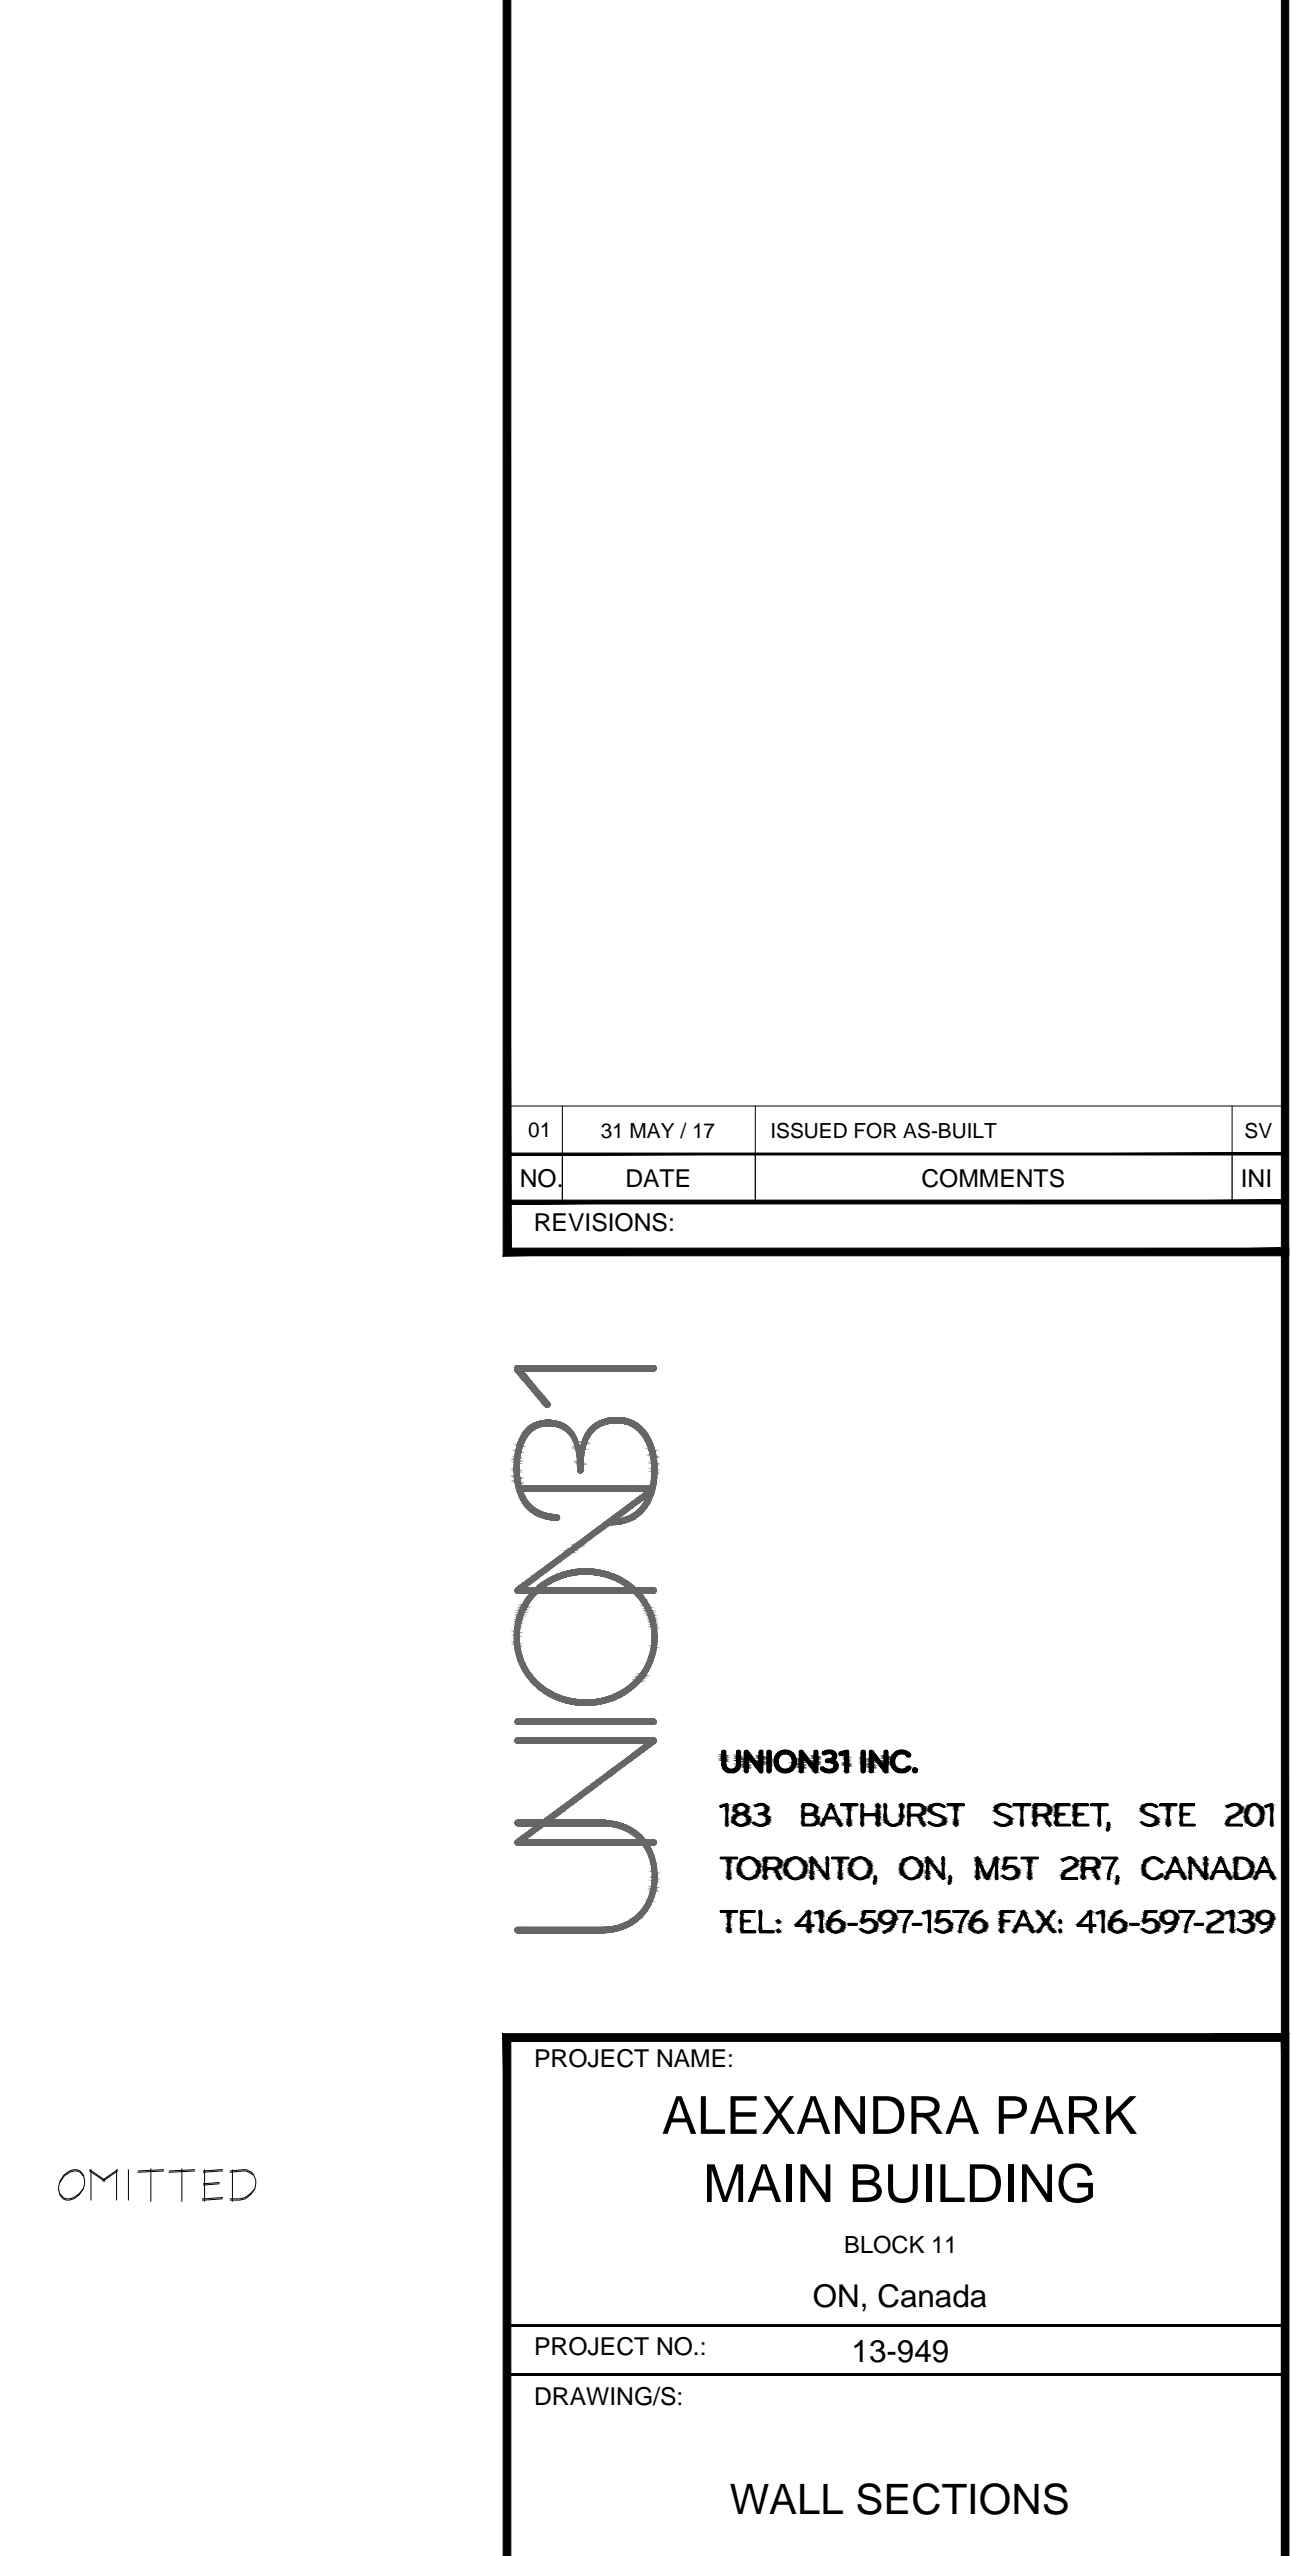

14 SECTION @ BENCH 1ST FLOOR CHANGE ROOMS SCALE 1:10
 15 SECTION @ BENCH 1ST FLOOR CHANGE ROOMS SCALE 1:10

01	31 MAY / 17	ISSUED FOR AS-BUILT	SV
NO.	DATE	COMMENTS	INI
REVISIONS:			

UNION31 INC.
 183 BATHURST STREET, STE. 201
 TORONTO, ON, M5T 2R7, CANADA
 TEL: 416-597-1576 FAX: 416-597-2139

PROJECT NAME:
ALEXANDRA PARK MAIN BUILDING
 BLOCK 11
 ON, Canada
 PROJECT NO.: 13-949
 DRAWINGS: WALL SECTIONS

DATE STARTED: 07 AUG / 13	DRAWING NO.: ID
SCALE: AS NOTED	3.2.0
DRAWN BY: SM	
APPROVED BY: KC	