


4TH FLOOR FRAMING PLAN

SCALE 1 : 100

- TOP OF SLAB IS AT ELEVATION AS SHOWN ON ARCH. DRAWINGS EXCEPT AS CROSSED AND NOTED ON PLAN.
- CONCRETE STRENGTH AT 28 DAYS SHALL BE:
FOR WALLS AND COLUMNS SEE SCHEDULE
FOR EXT. SLABS 35 MPa
FOR INTERIOR SLABS 25 MPa
FOR BEAMS 35 MPa
CONCRETE EXPOSED TO ELEMENTS SHALL BE 35 MPa WITH 6% TO 8% ENTRAINED AIR.
- FLOOR SLABS ARE DESIGNED FOR FOLLOWING LOADING CONDITIONS :
- MINIMUM YIELD STRESS FOR REINFORCING STEEL SHALL BE 400 MPa.
- TEMPERATURE REINFORCING FOR : 200 SLAB IS 100250, 210 SLAB IS 100230.
- NO OPENINGS LARGER THAN 300mm x 300mm ARE ALLOWED IN SLAB OTHER THAN THOSE SHOWN ON DRAWINGS.
- SEE TYPICAL DETAILS ON DRAWINGS S-001 TO S-005.
- SEE GENERAL NOTES ON DRAWING S-001.
- REFER TO ARCH. DRAWINGS FOR SLOPES OF SLAB.
- FOR COLUMN & WALL SCHEDULE SEE DRAWINGS S-301 TO S-306.
- COORDINATE BEAM DEPTH AT DOOR OPENINGS WITH ARCH. DRAWINGS.
- EXTEND TEMP. REINF. TO END OF BALCONIES/OVERHANGS.
- TOP BARS TERMINATING AT EDGE OF SLAB TO HAVE 180° HOOK.

	S.I.D.	L.L.
STAIRS & BALCONIES	0.50 KPa	4.80 KPa
LOCKERS & STORAGE *	1.30 KPa	4.80 KPa
RESIDENTIAL	1.30 KPa	1.9 KPa
TOILETS	1.30 KPa	2.40 KPa
TERRACES	5.0 KPa	4.80 KPa

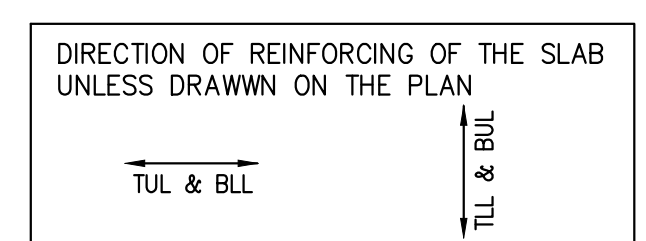

Jablonsky, Ast and Partners
CONSULTING ENGINEERS
1120 LESLIE STREET
DOR, ONTARIO, CANADA M3C 2K5
TEL: 416-441-7400
FAX: 416-441-2711
E-mail: j@jablonsky.com



FIRST FLOOR ELEV. 93.60m

NO.	ISSUED / REVISED	DATE
1	ISSUED FOR PERMIT	2014-09-03
2	RE ISSUED FOR PERMIT	2014-07-01
3	ISSUED FOR FORMING TENDER	2014-08-27
4	CONSTRUCTION REVIEW	2014-03-21
5	RE ISSUED FOR PERMIT	2014-01-07
6	ISSUED FOR CONSTRUCTION	2013-09-14
7	UPDATED - P.C.	2013-04-24
8	UPDATED - P.C.	2012-08-21
9	ISSUED FOR B.P.	2012-07-23
11	ISSUED FOR B.P.	2012-11-04

ALEXANDRA PARK - BLOCK 11
TORONTO, ONTARIO

project no: 13015
scale: 1:100
drawn by: H.W.
checked by: H.P.
date stamped: MARCH 2014