




SECTION 1  
SCALE 1:20  
S-304

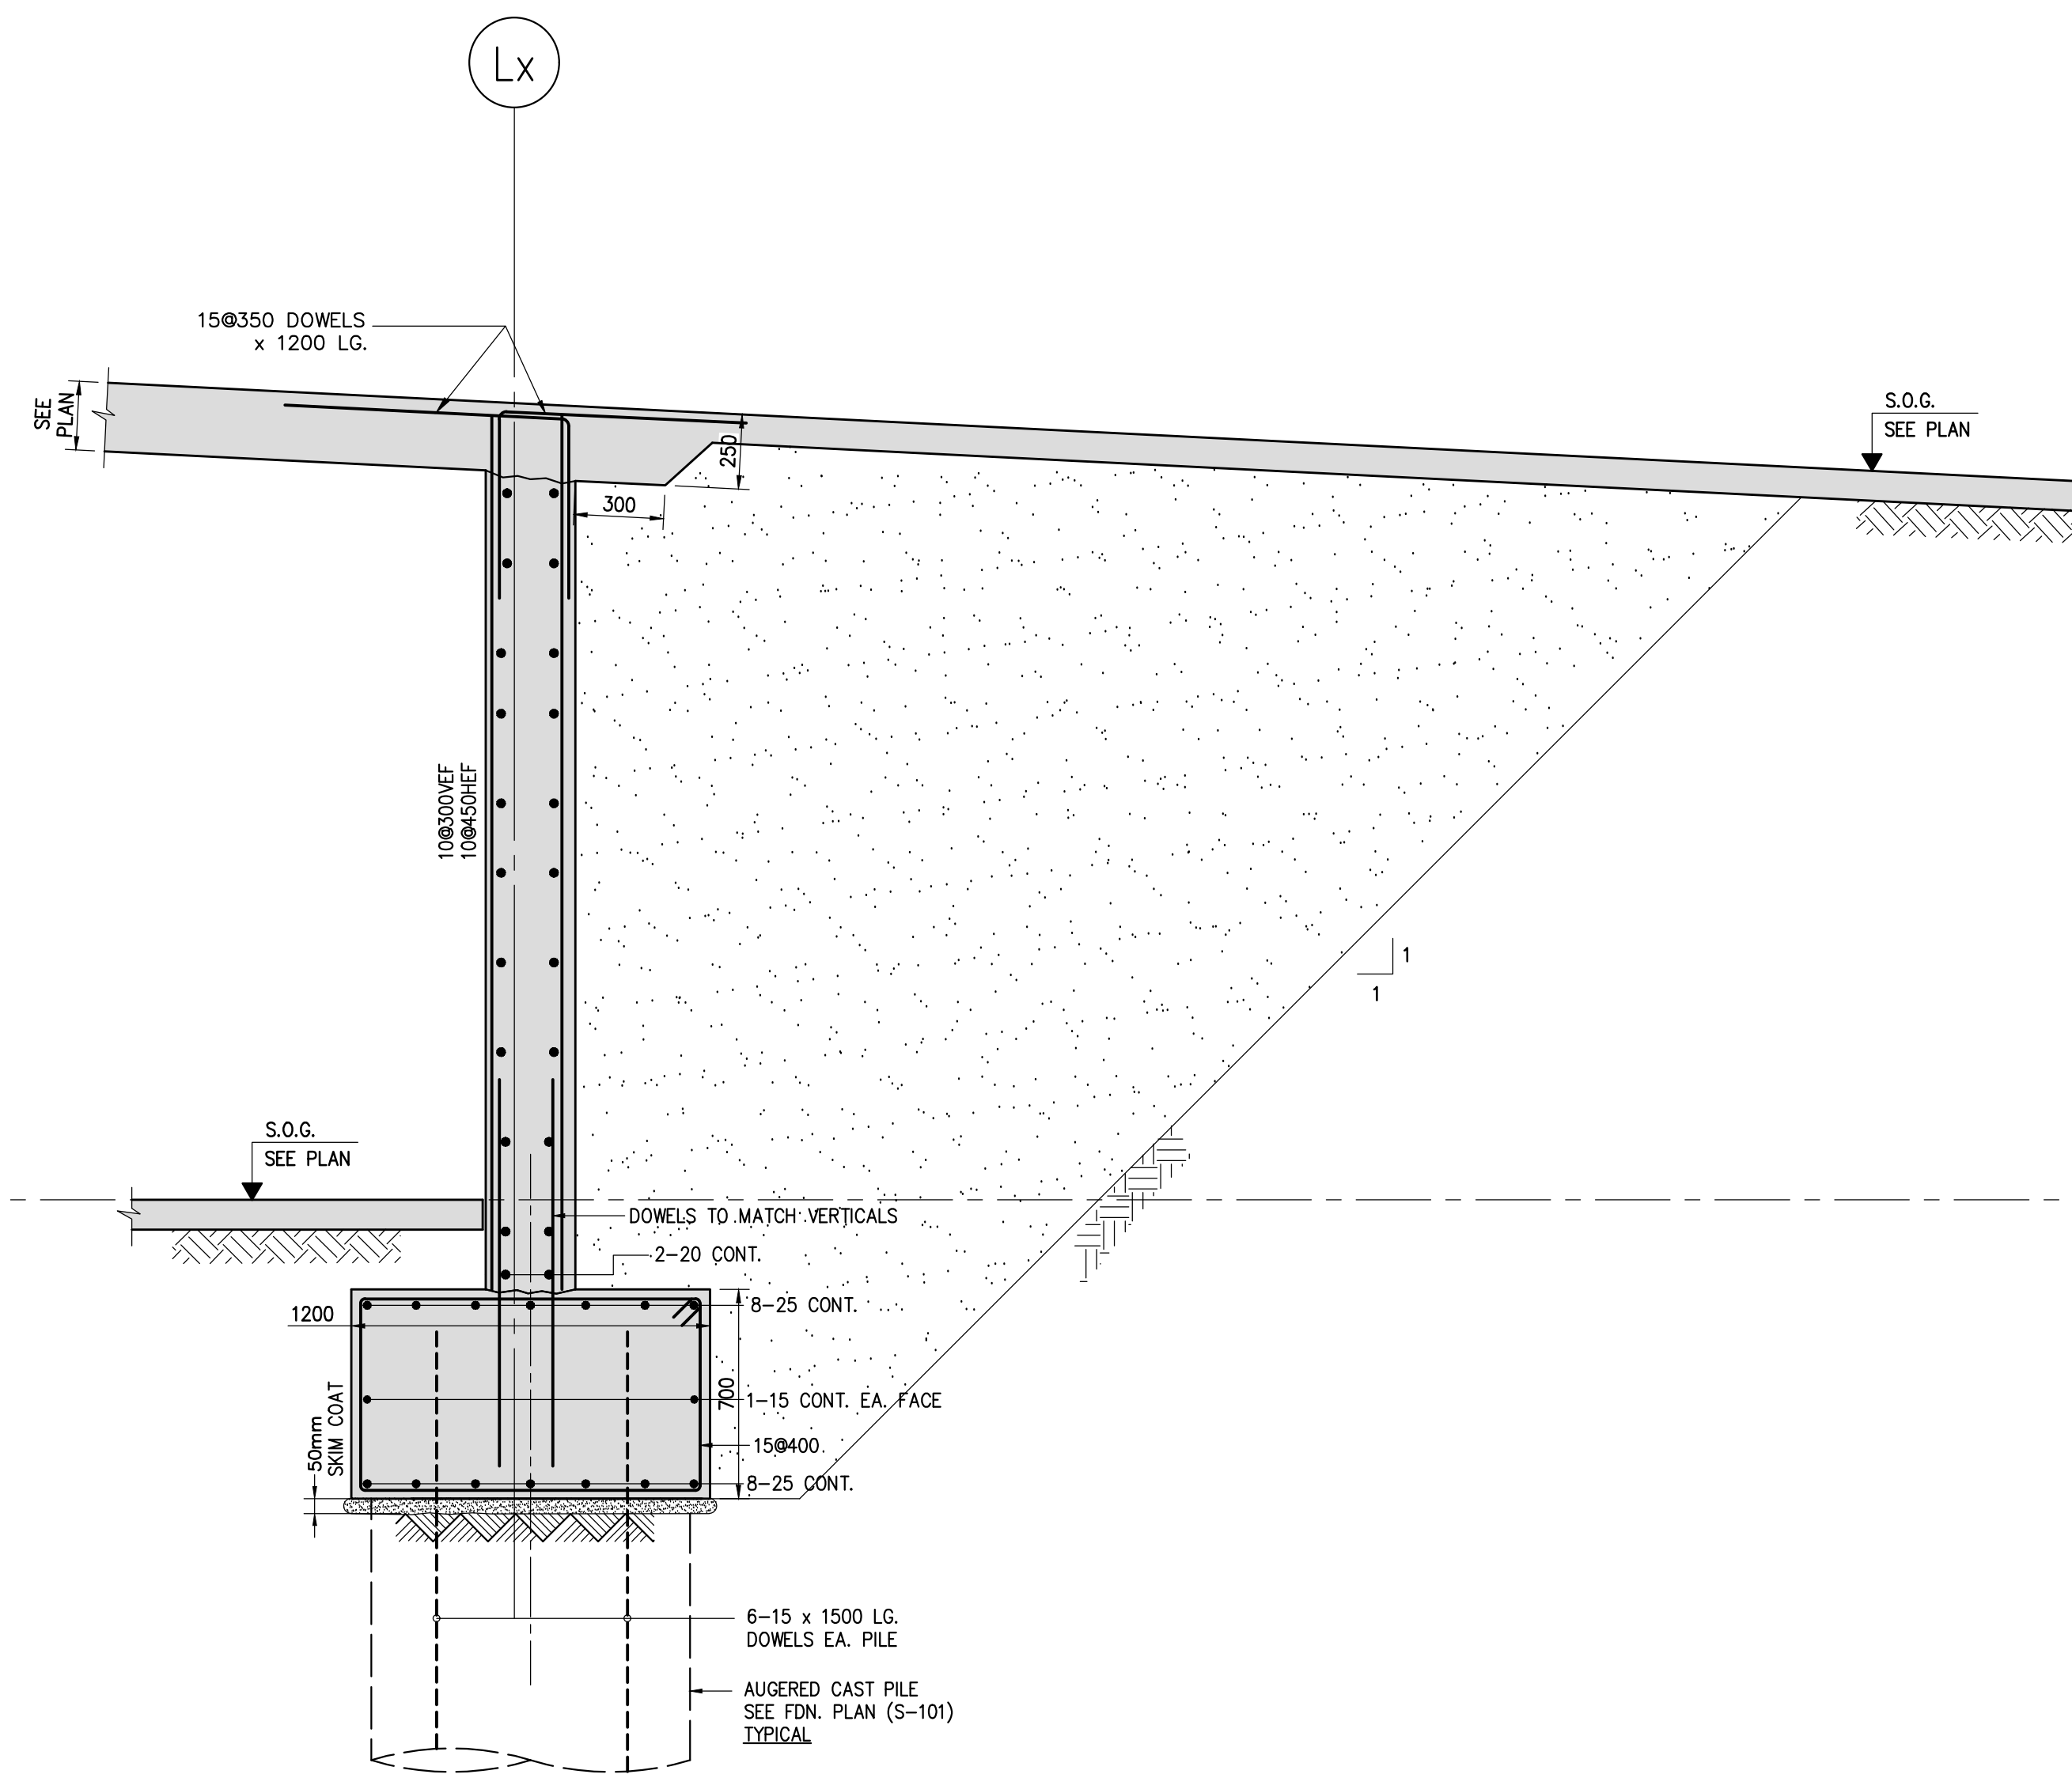


SECTION 2  
SCALE 1:20  
S-304

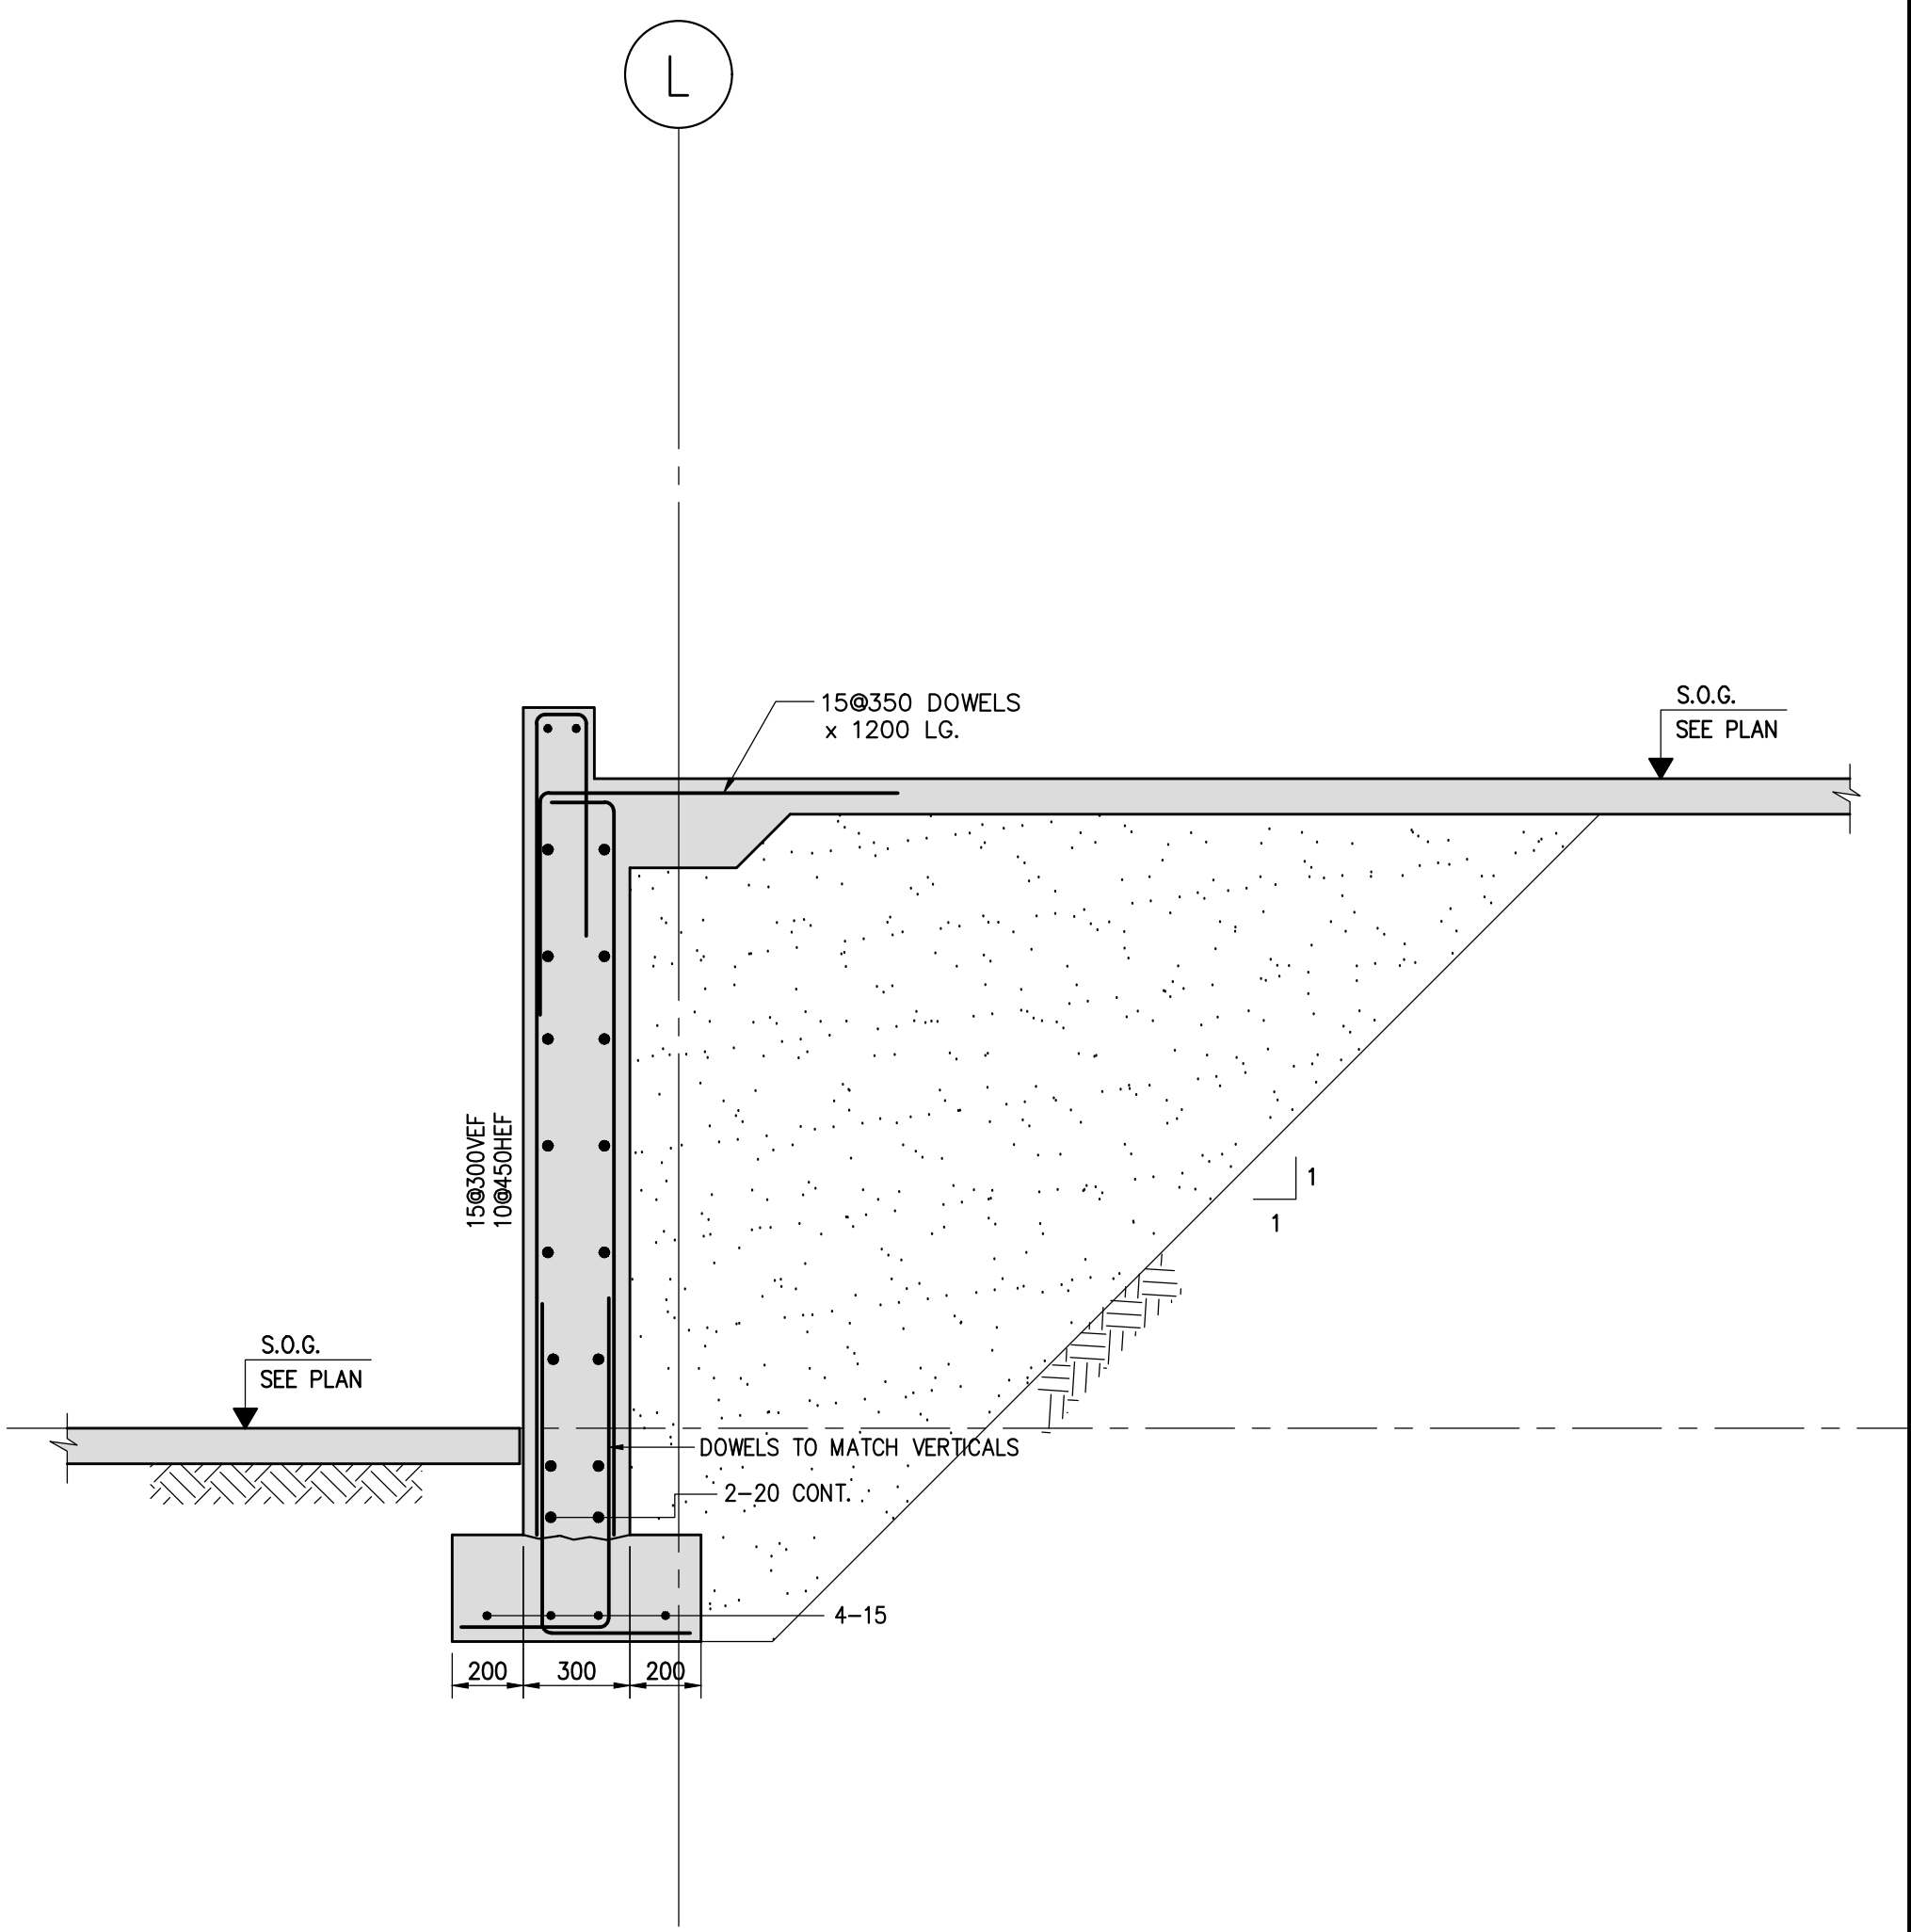


SECTION 3  
SCALE 1:20  
S-304

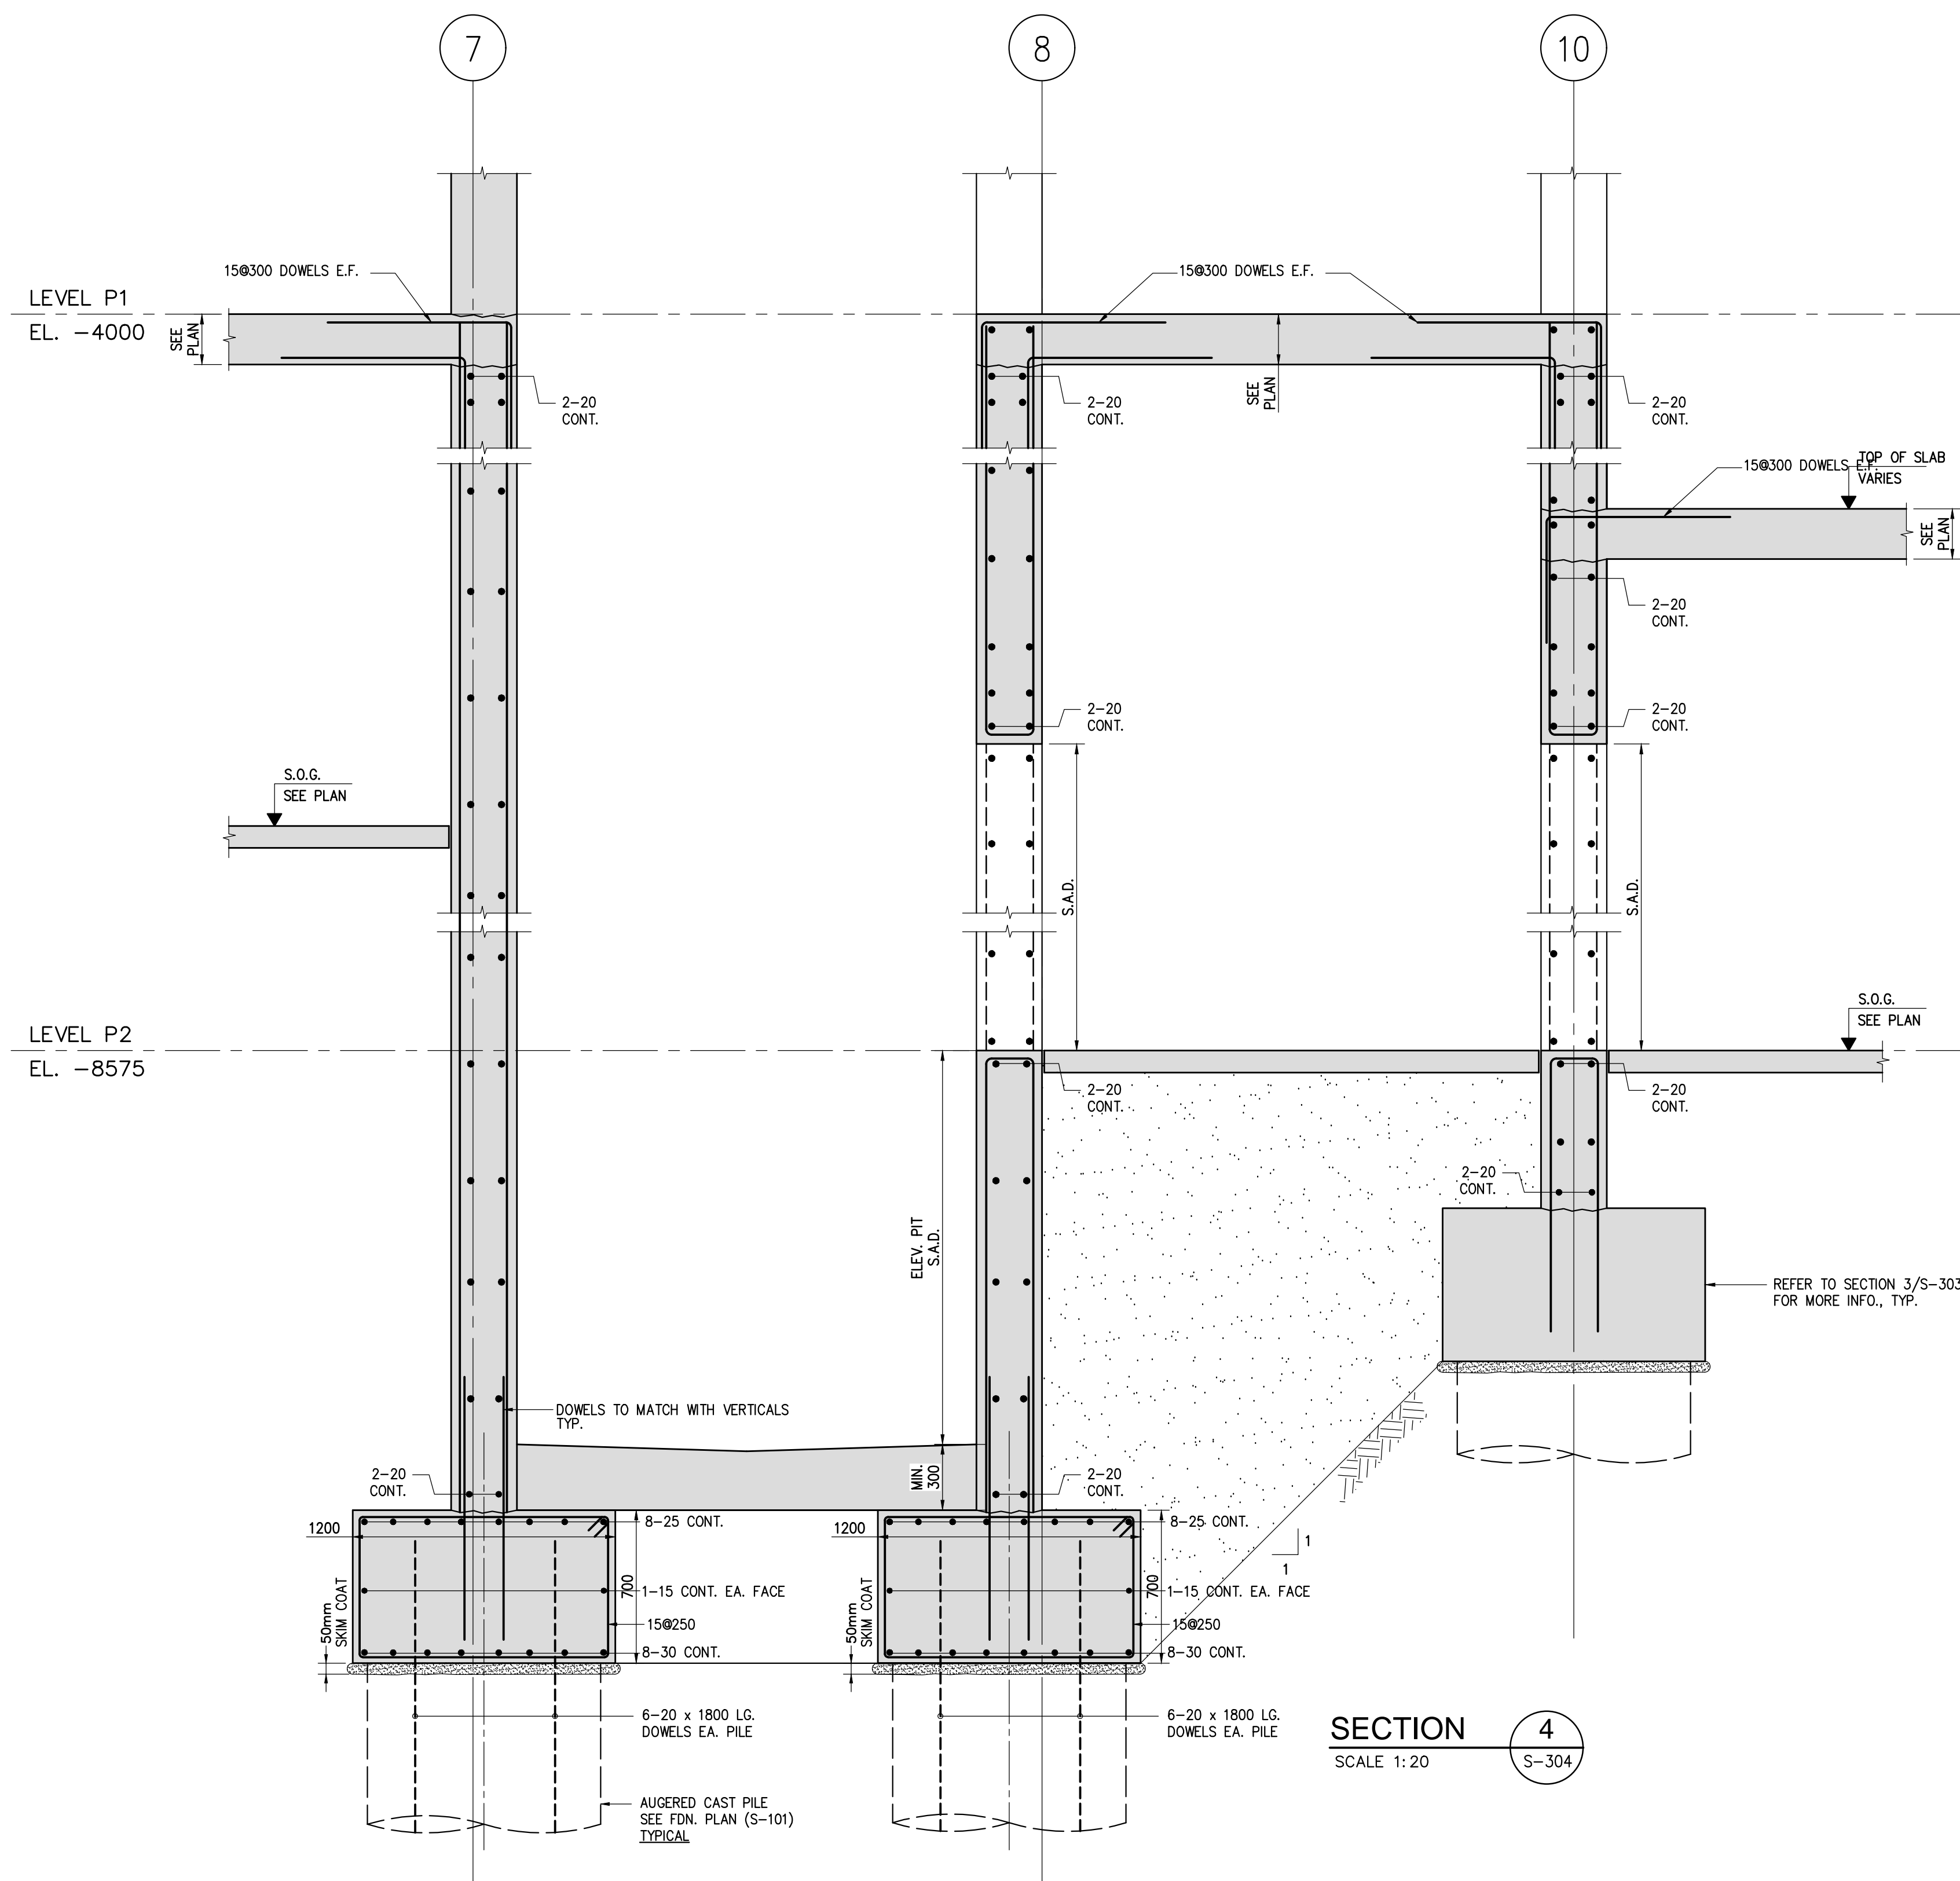

SECTION 4  
SCALE 1:20  
S-304

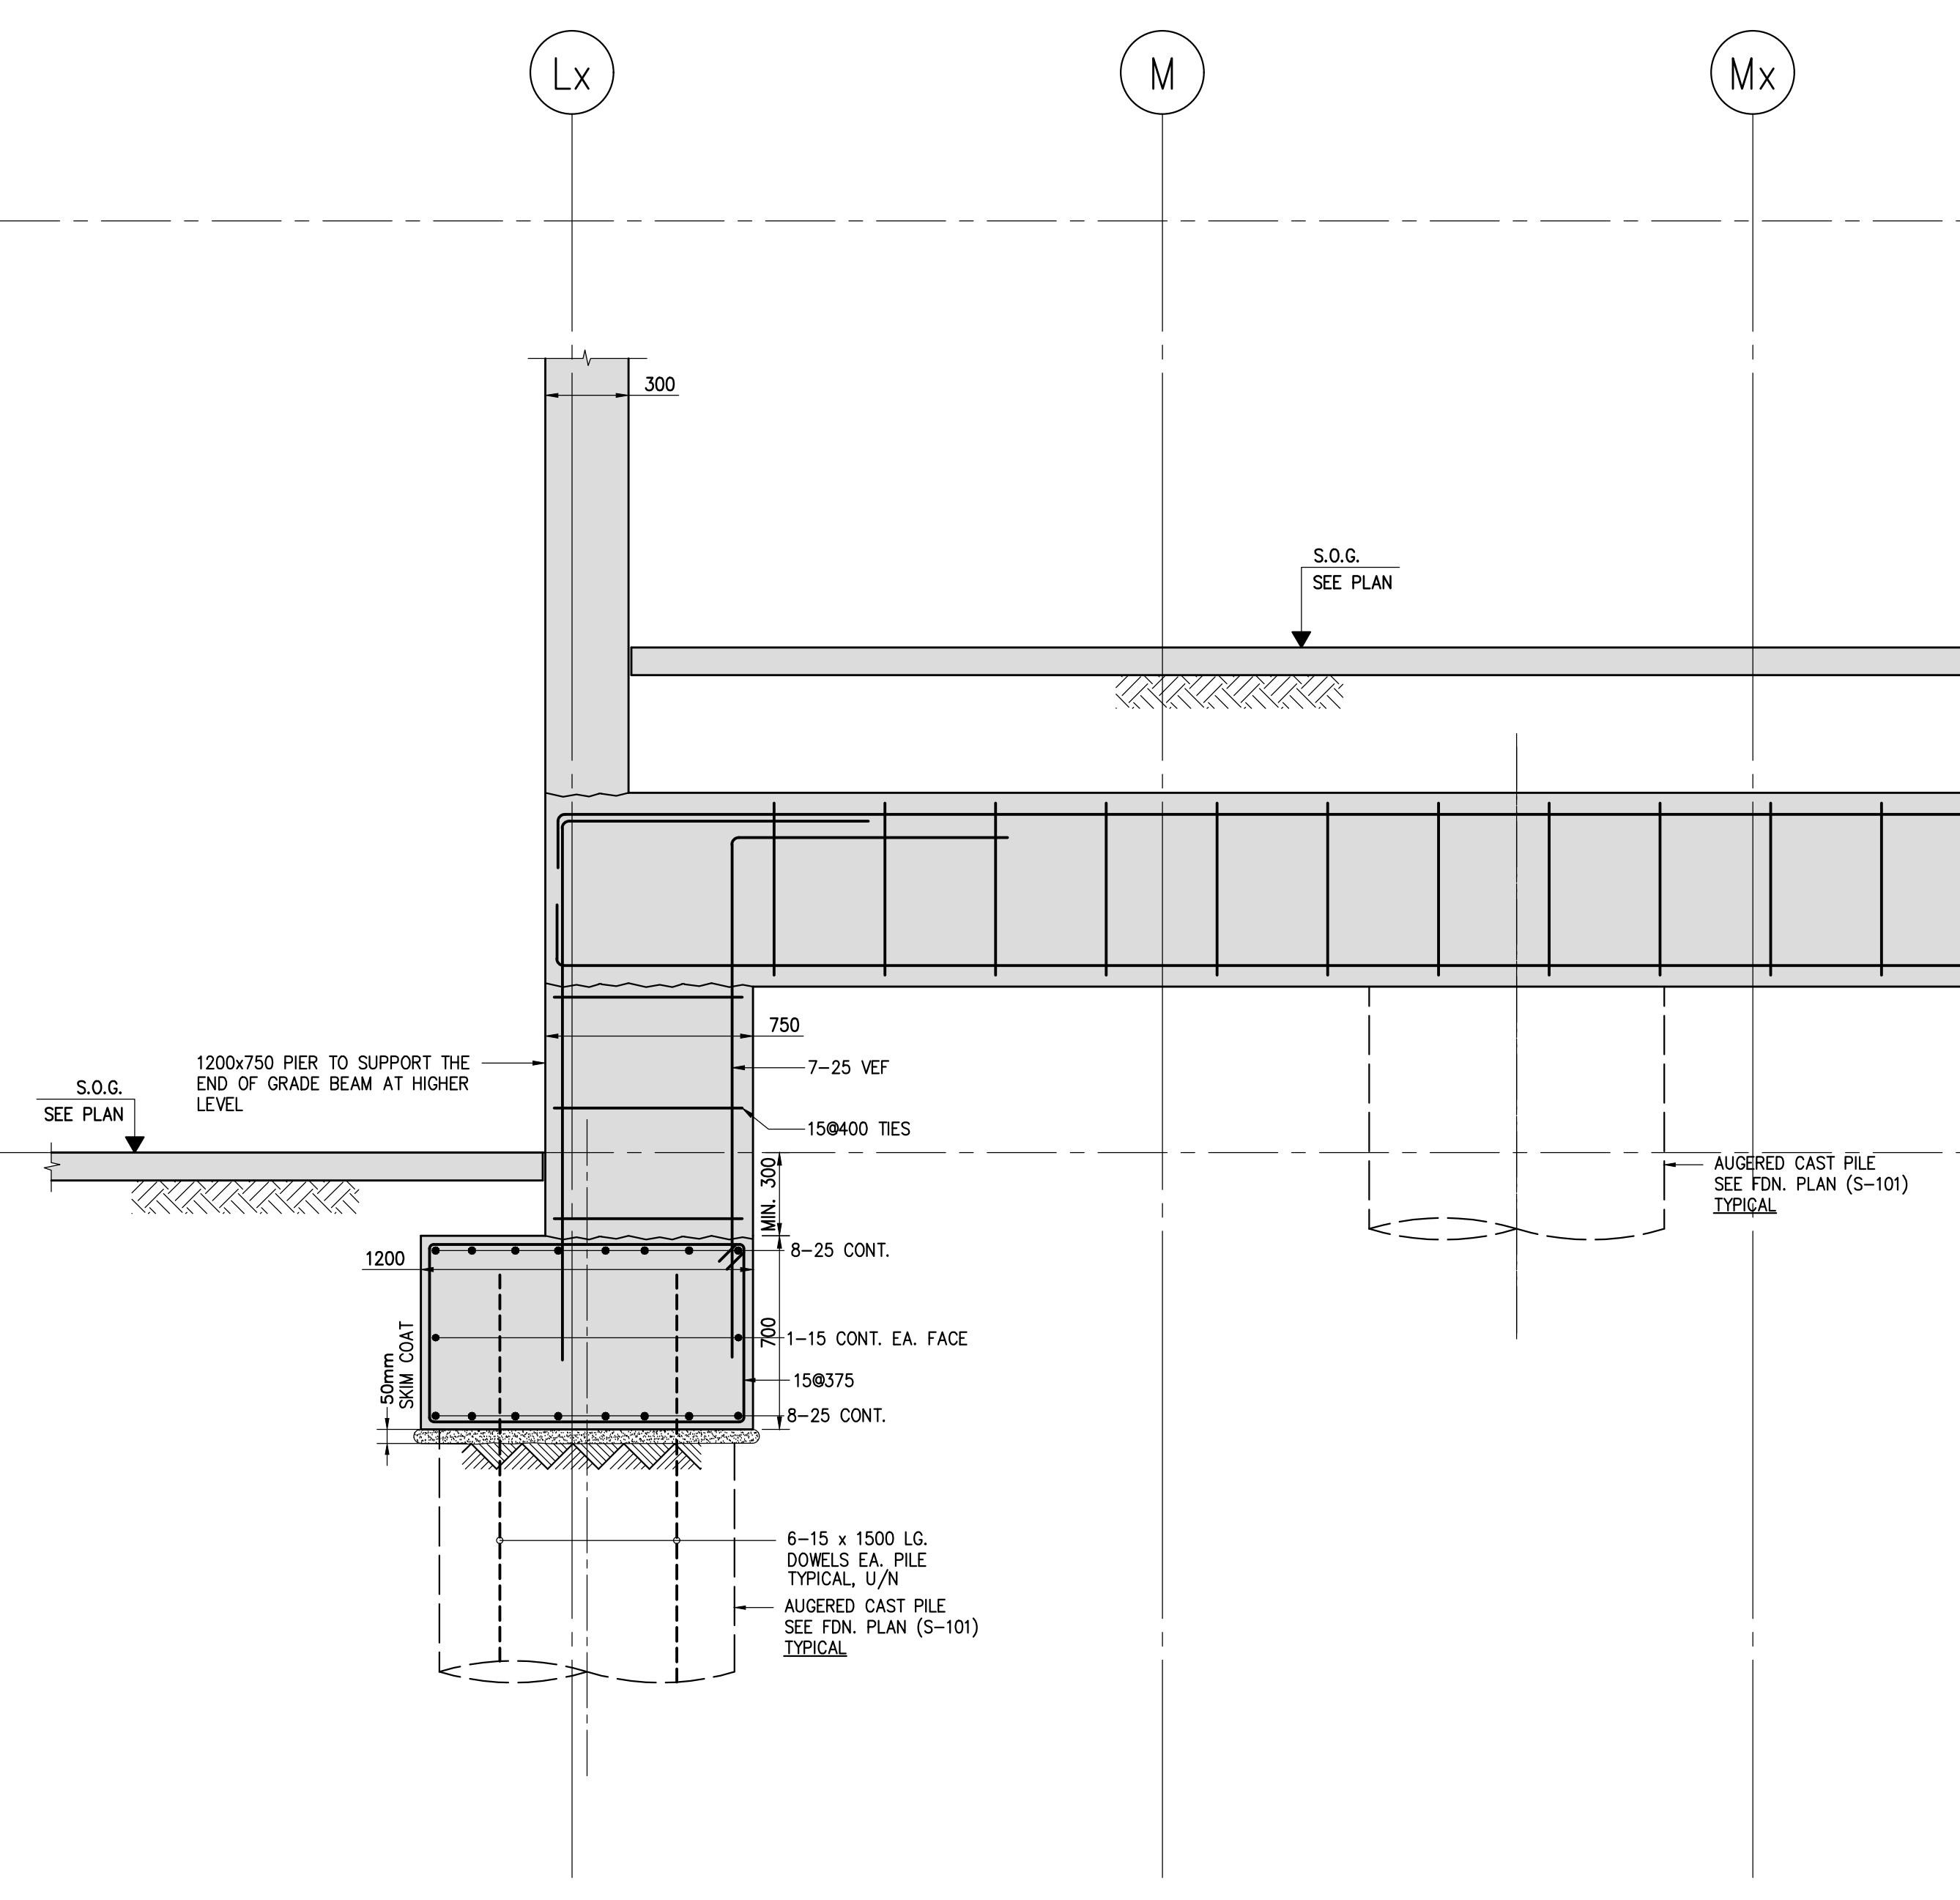

SECTION 5  
SCALE 1:20  
S-304

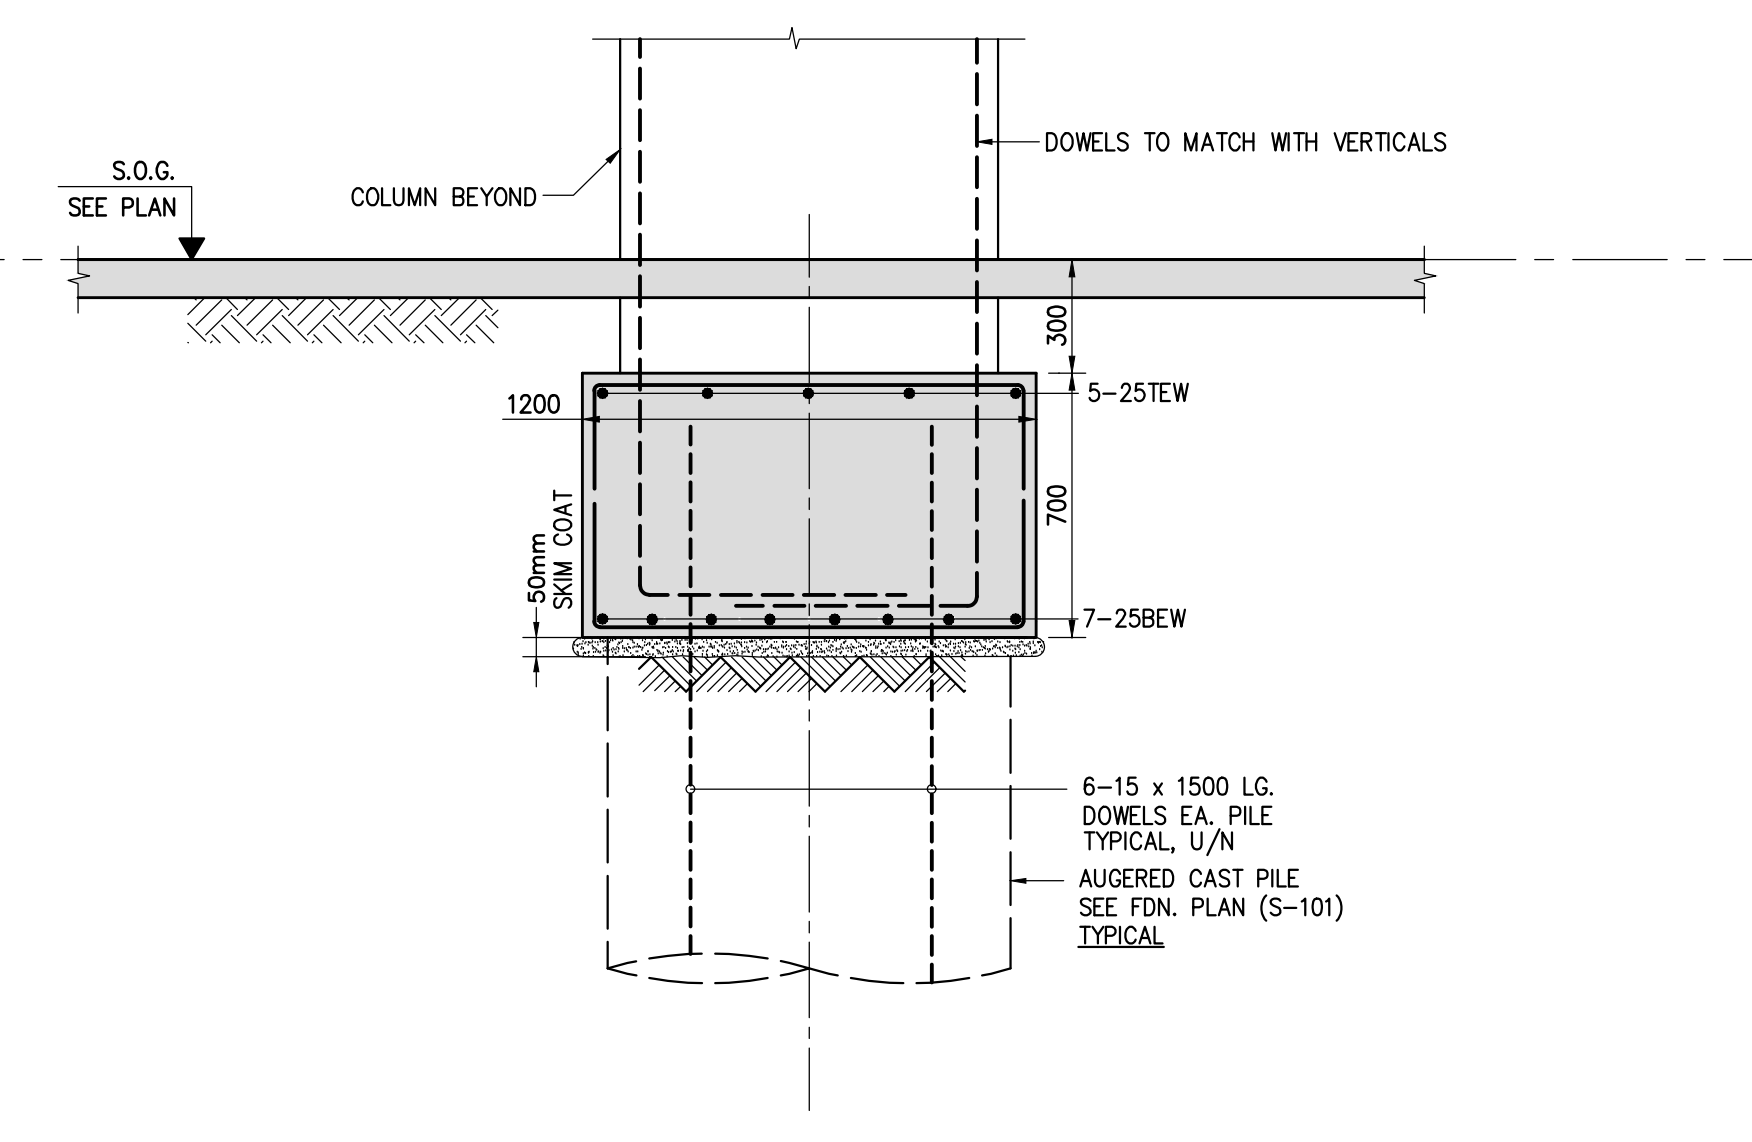

TYPICAL SECTION OF PILE CAP FOR COLUMNS  
SCALE 1:20

Jablonsky, Ast  
and Partners  
CONSULTING  
ENGINEERS  
1120 LESLIE STREET  
DOR MILLS, ON. M3C 2K5  
TEL. 416-447-7400  
FAX 416-447-2771  
E-mail: jsp@ast.on.ca



FIRST FLOOR ELEV. 93.60m

NO.	ISSUED / REVISED	DATE
1	ISSUED FOR PERMIT	2014-05-03
2	RE ISSUED FOR PERMIT	2014-07-01
3	ISSUED FOR FORMING TRENCH	2014-08-27
4	CONSTRUCTION REVIEW	2015-03-11
5	RE ISSUED FOR PERMIT	2015-01-07
6	ISSUED FOR CONSTRUCTION	2015-03-11
7	UPDATED - P.C.	2015-04-03
8	UPDATED - P.C.	2015-05-01
9	ISSUED FOR B.P.	2015-07-01
11	ISSUED FOR B.L.I	2015-11-04

ALEXANDRA PARK - BLOCK 11  
TORONTO, ONTARIO

Project no: 13015  
Scale: 1:25  
H.W.  
Reviewed by:  
Date stamped: MARCH 2014