


TYPE A

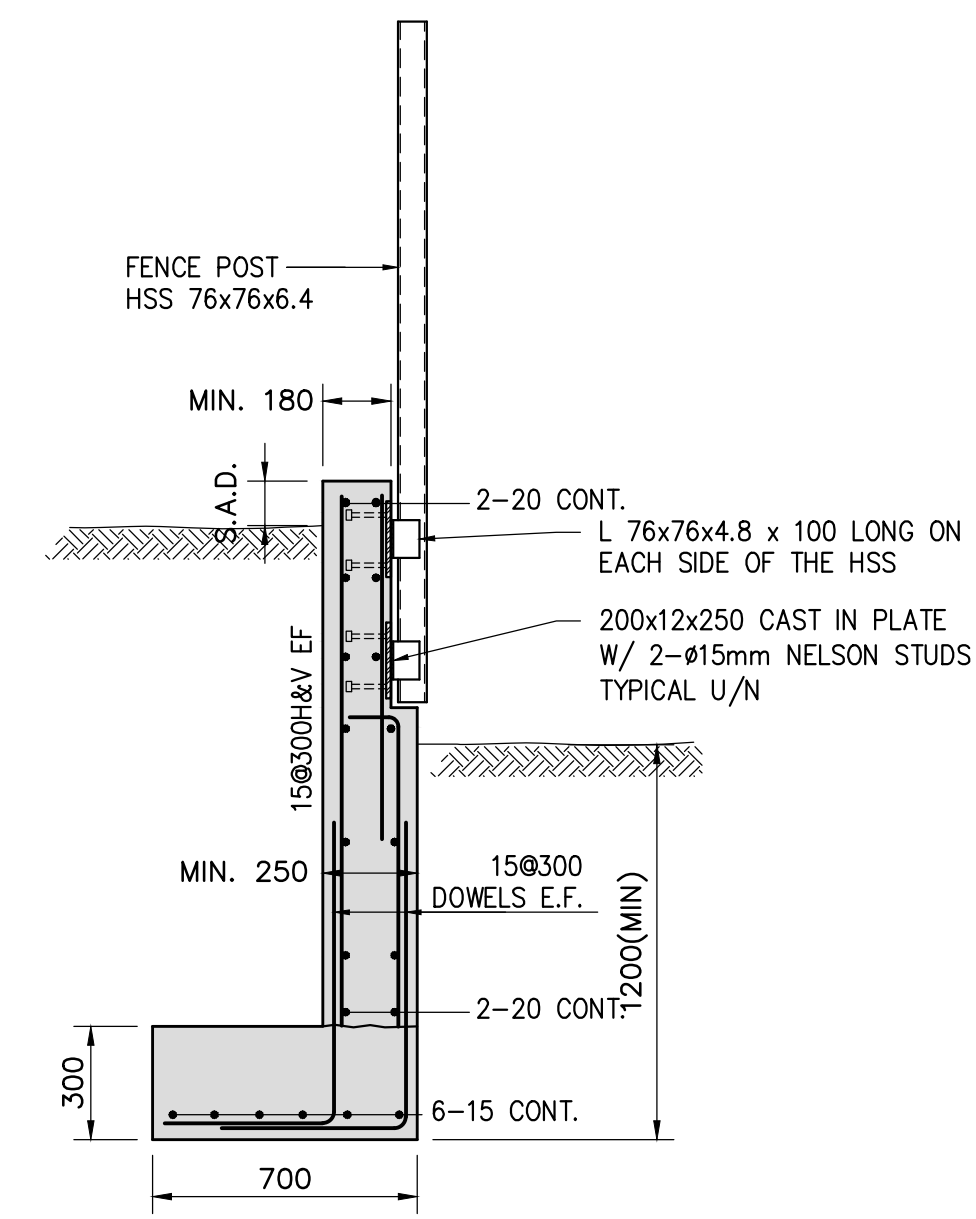


TYPE B

DETAIL OF RETAINING WALL

SCALE 1:20


- NOTE:
1. PROVIDE T.L.S. (TENSION LAP SLICE) FOR ALL HORIZONTAL BARS INTO ADJACENT WALLS.
 2. CONCRETE STRENGTH AT 28 DAYS SHALL BE 35 MPa, CLASS C-1, CONTAIN MIN. 7% TO BE ENTRAINED AIR.
 3. SEE ARCH. AND LANDSCAPE DRAWING FOR LOCATION OF RETAINING WALL.
 4. SEE LANDSCAPE DRAWINGS FOR LOCATIONS AND FENCE DETAILS.

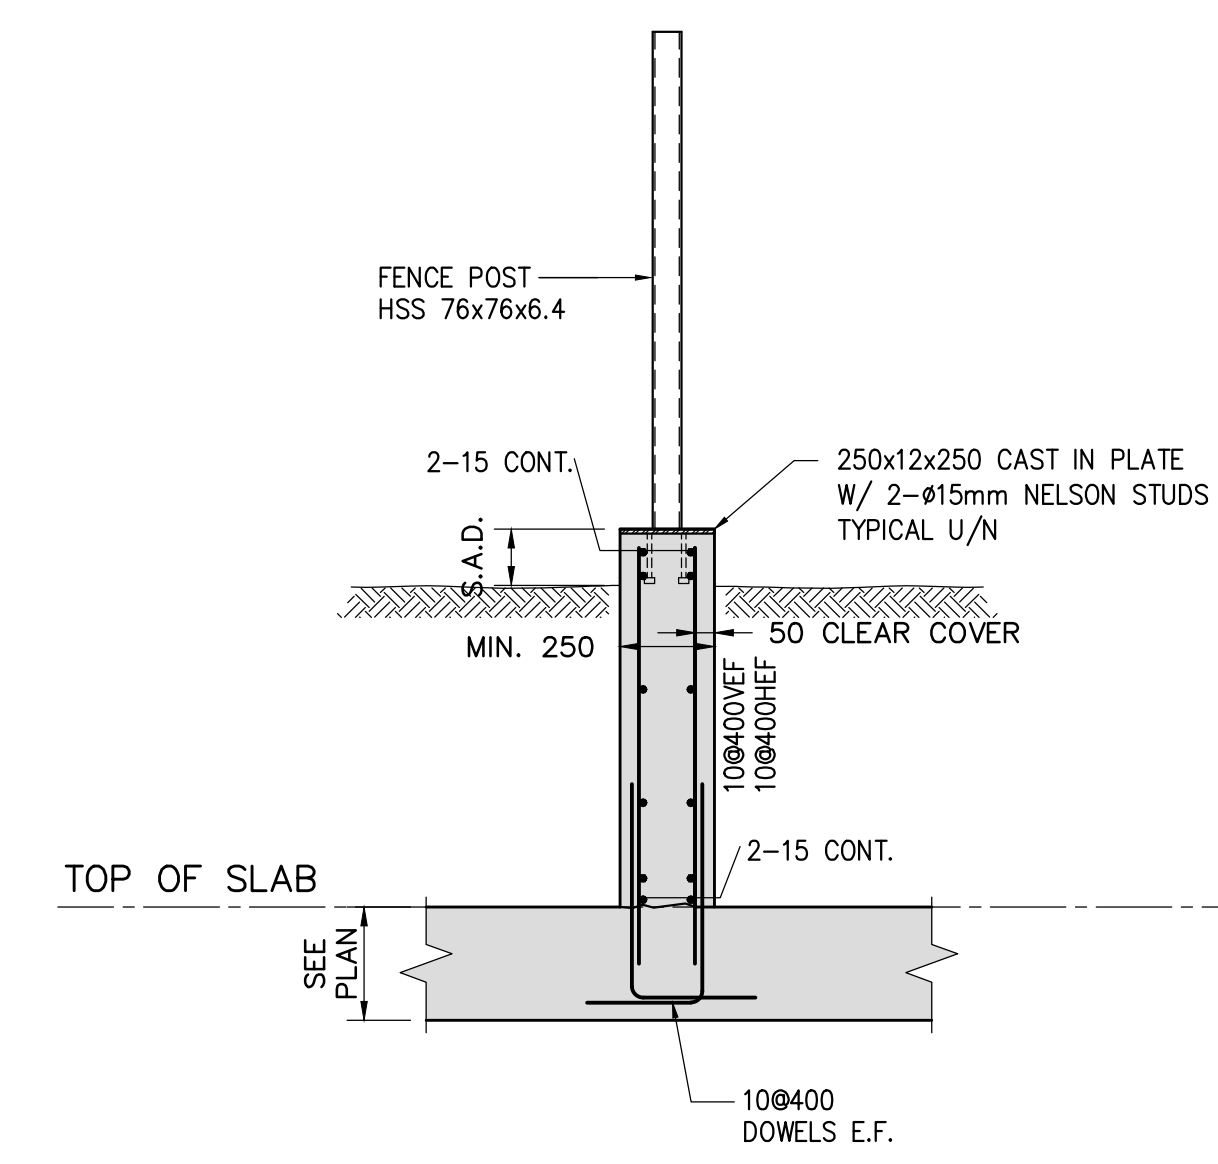

DETAIL OF PLANTER WALL



SCALE 1:20

- NOTE:
1. TO PROVIDE T.L.S. (TENSION LAP SLICE) FOR ALL HORIZONTAL BARS AND T.L.S. INTO ADJACENT WALLS.
 2. CONCRETE STRENGTH AT 28 DAYS SHALL BE 35 MPa, CLASS C-1, CONTAIN MIN. 7% TO BE ENTRAINED AIR.
 3. SEE ARCH. AND LANDSCAPE DRAWING FOR LOCATION OF PLANTER.

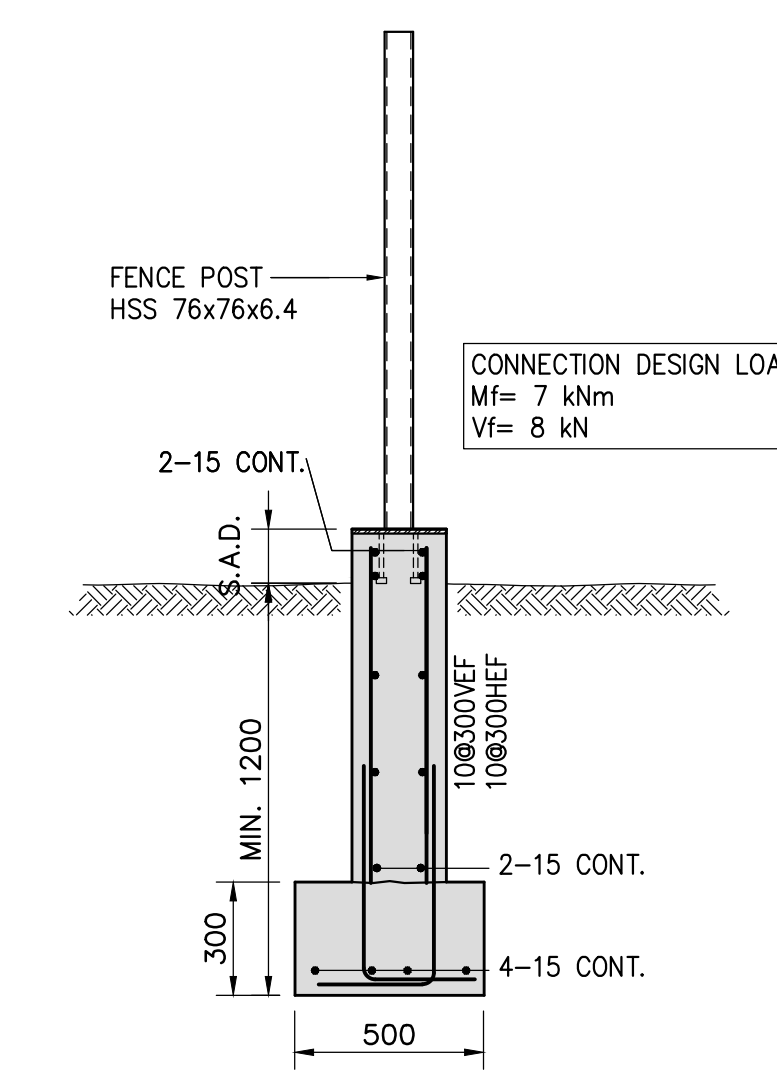


DETAIL OF LIGHTING POLE FOUNDATION

SCALE 1:20

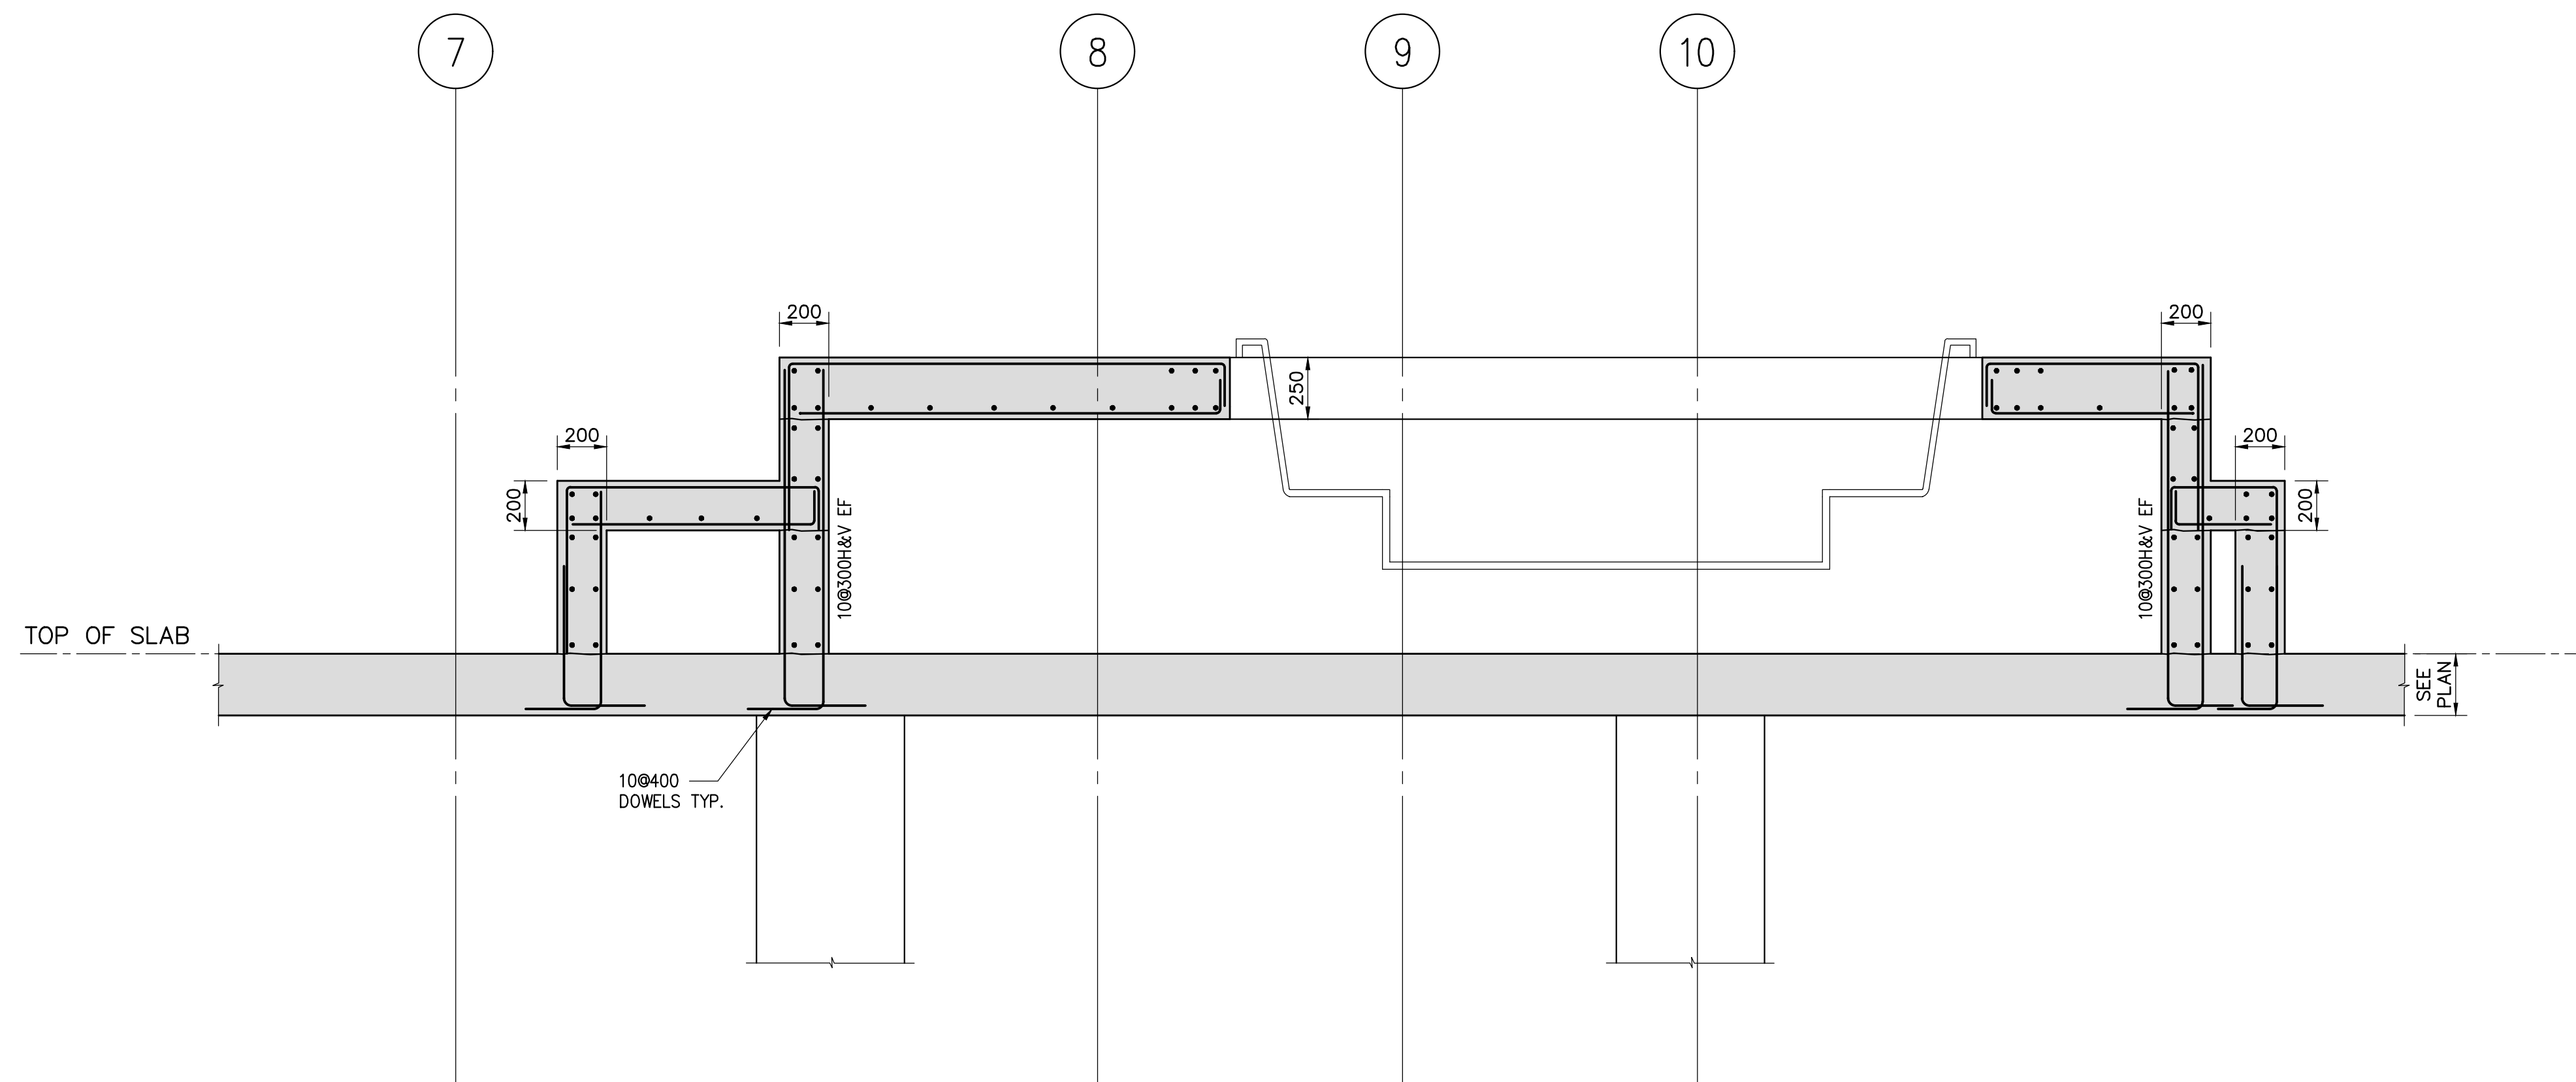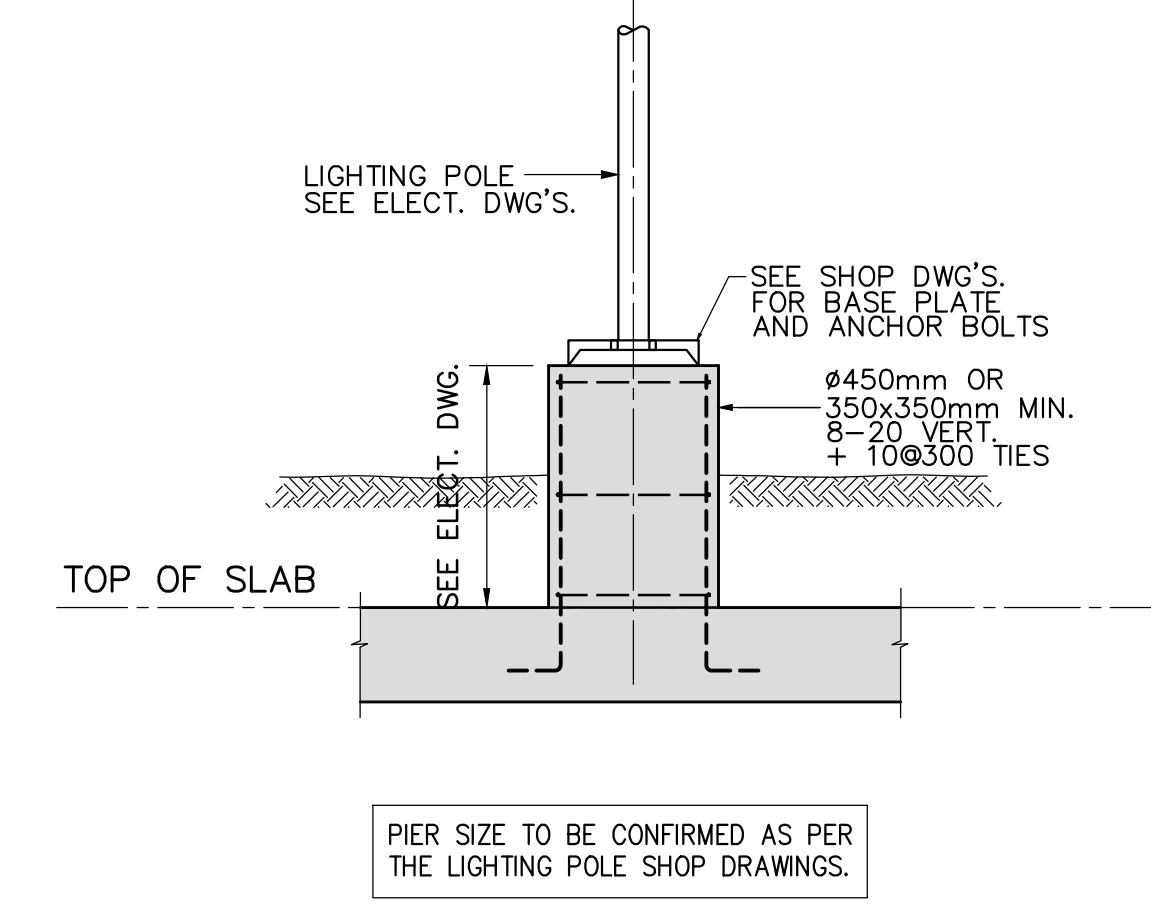

SECTION 1
SCALE 1:20

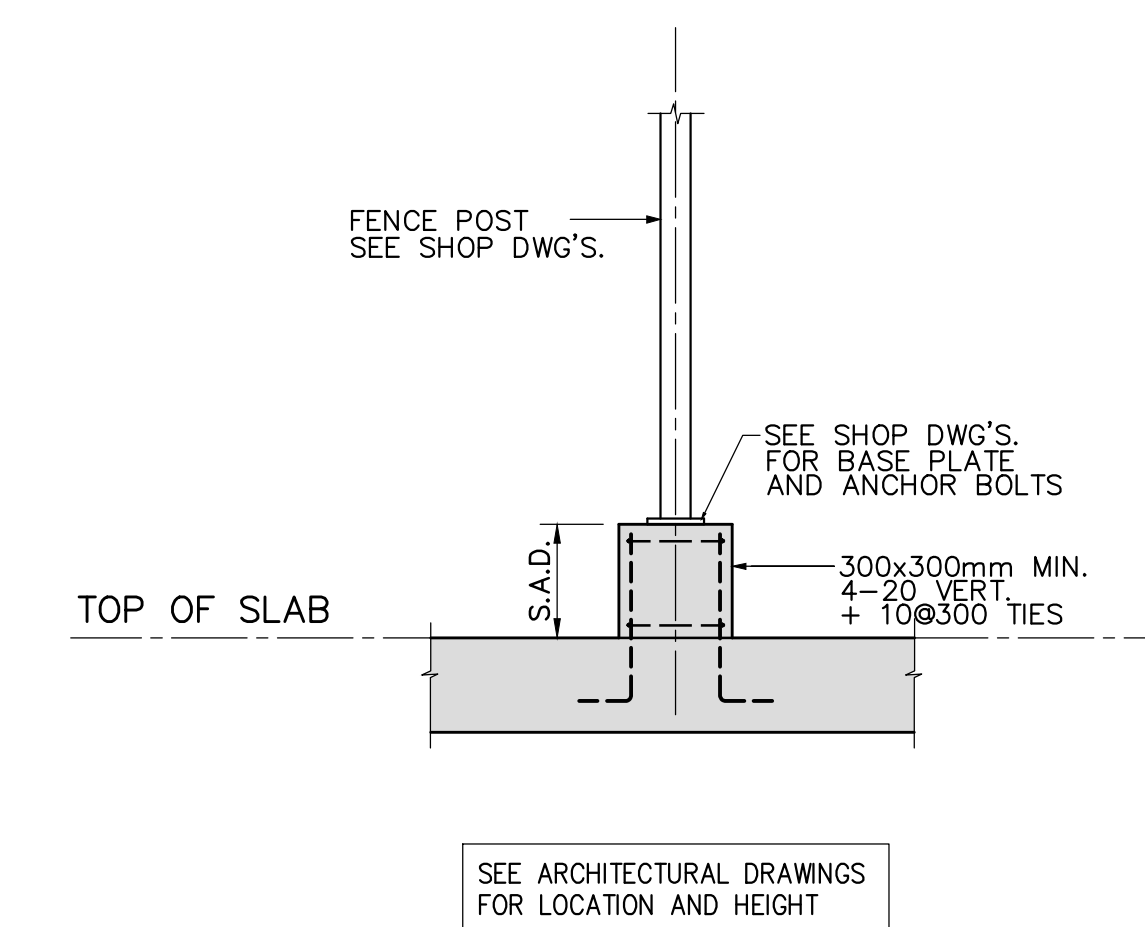

TYPICAL DETAIL FOR FENCE POST CONCRETE PIER
SCALE 1:20



FIRST FLOOR ELEV. 93.60m

NO.	ISSUED / REVISED	DATE
1	ISSUED FOR PERMIT	2014-05-03
2	RE ISSUED FOR PERMIT	2014-07-01
3	ISSUED FOR FORMING TRENCH	2014-08-27
4	CONSTRUCTION REVIEW	2015-03-03
5	RE ISSUED FOR PERMIT	2015-01-07
6	ISSUED FOR CONSTRUCTION	2015-03-11
7	UPDATED - RC	2015-04-03
8	UPDATED - RC	2015-05-01
9	ISSUED FOR B-I-P	2015-07-01
11	ISSUED FOR B-I-1	2015-11-04
12	ISSUED FOR B-I-2	2016-01-08