
Teeple Architects INC.

PACKAGE 2
P2, P1, G

Reviewed
Reviewed as noted
Revise and resubmit
Not Reviewed
Date: Aug 9/15
Reviewed by: VBarna


This review by Teeple Architects Inc. is for the sole purpose of ascertaining conformance with the general design concept. This review shall not mean that Teeple Architects Inc. approves the detailed design inherent in the shop drawings, responsibility for which shall remain with the Contractor submitting same, and such review shall not relieve the Contractor of the responsibility for errors or omissions in the shop drawings. The Contractor is responsibility for meeting all requirements of the Contract Documents. The Contractor is responsible for dimensions to be confirmed and correlated at the job site, for information that pertains solely to the fabrication processes or to techniques of construction and installation, and for the coordination of the work of all trades.

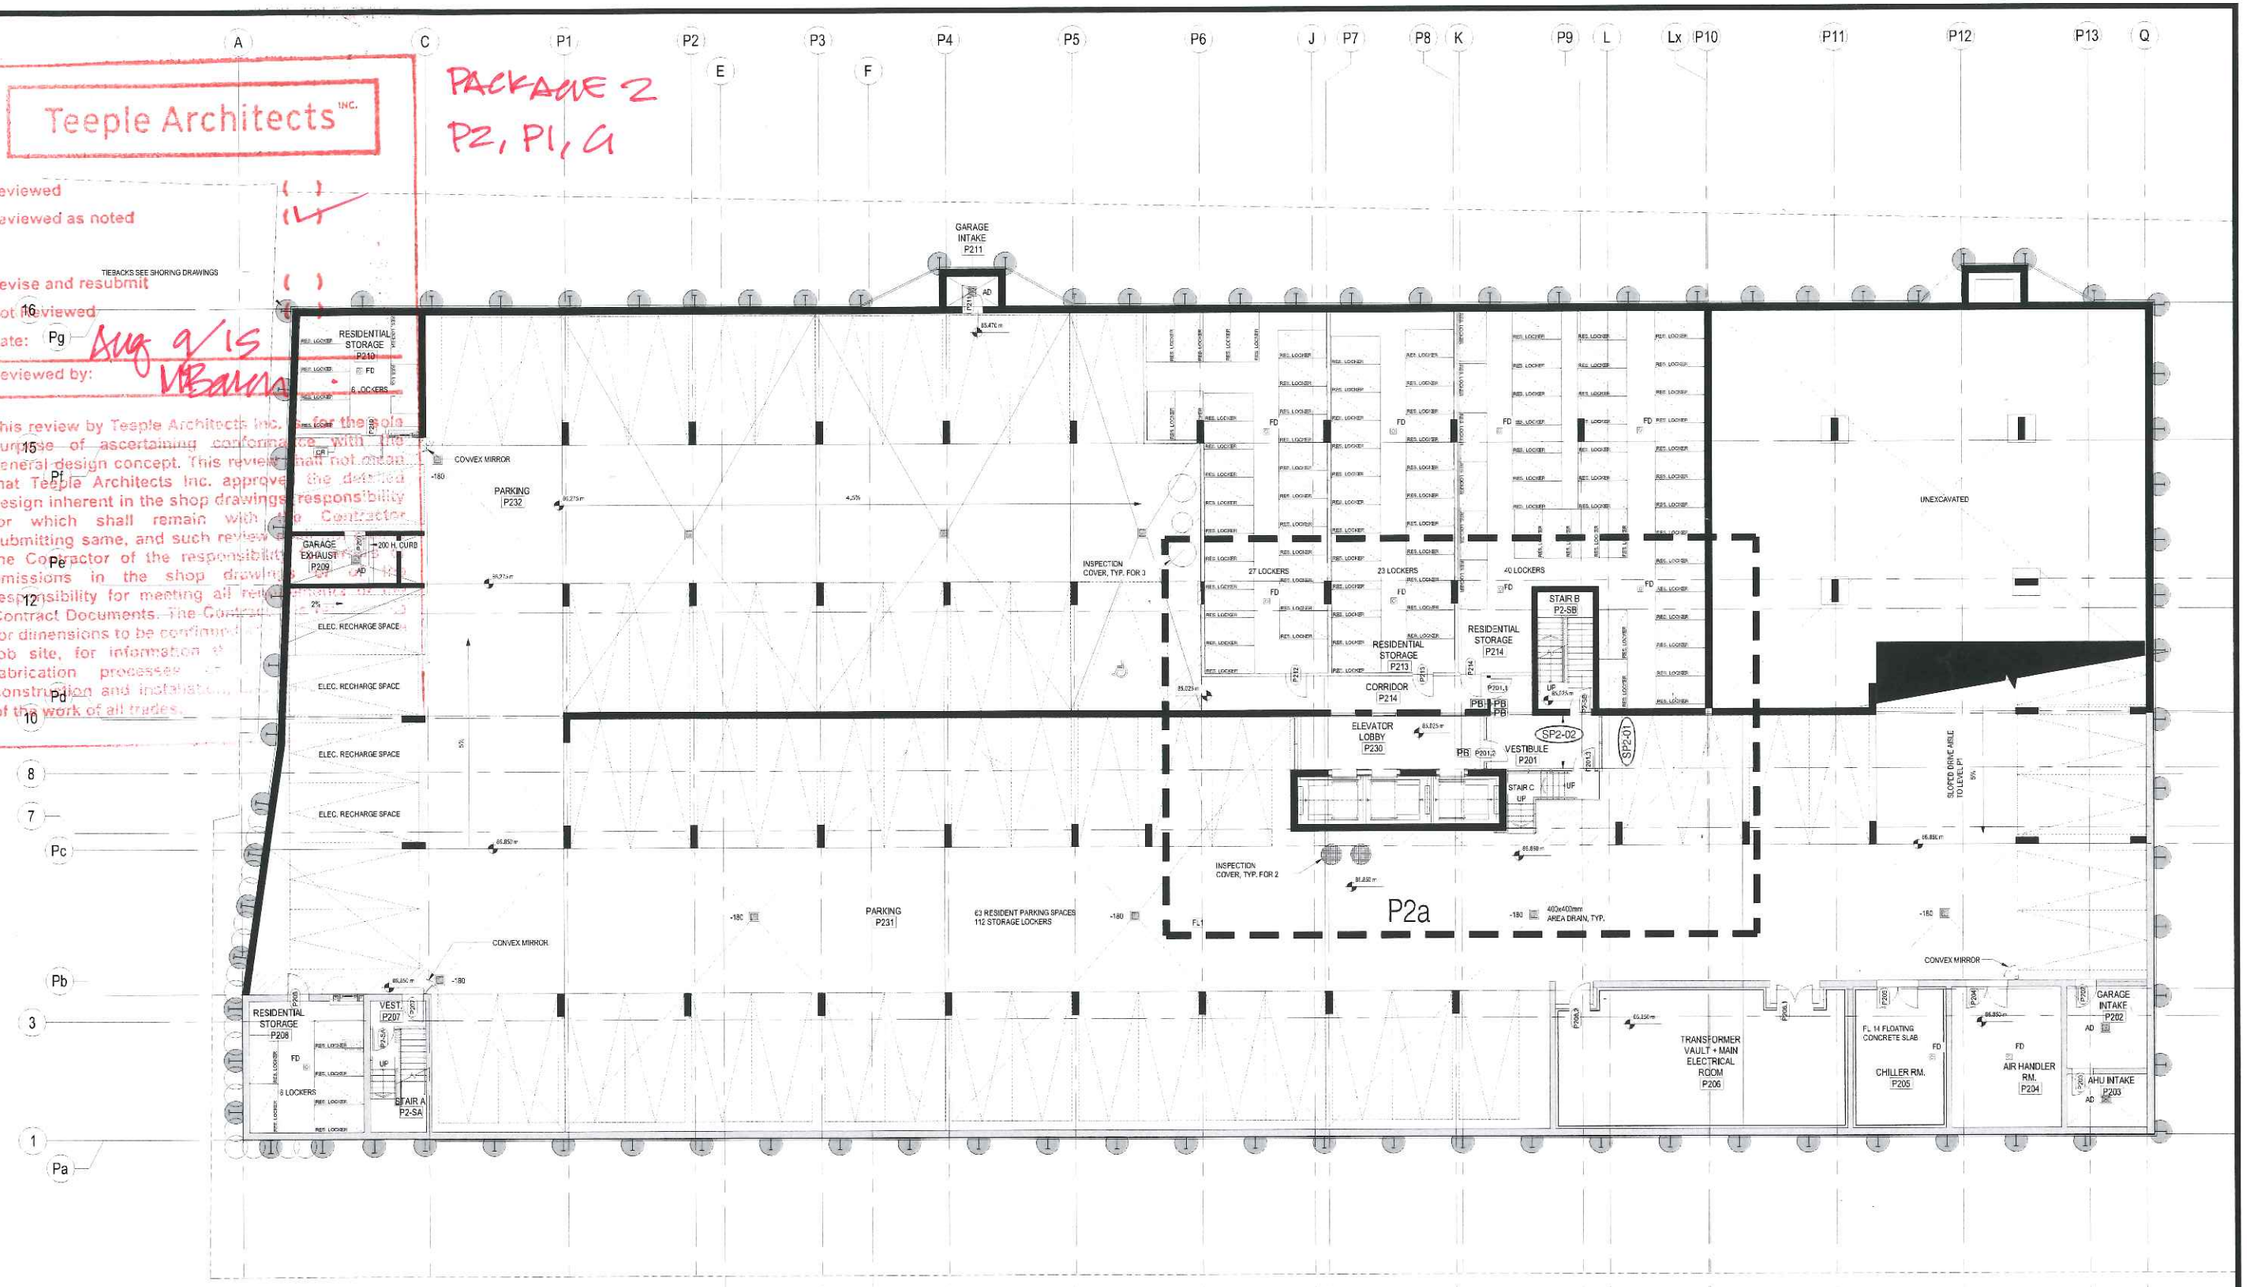

TORO ALUMINUM
COMMERCIAL INDUSTRIAL RESIDENTIAL
330 APPLEWOOD CRESCENT
CONCORD, ON, CANADA
L4K 4V2
TEL: (905) 738-5020
FAX: (905) 738-5481
WWW.TOROALUMINUM.COM

NO.	REVISION	BY	DATE


PROJECT NAME: SQ ALEXANDRA PARK - BLOCK11
DRAWING TITLE: PARKING LEVEL 2 FLOOR KEY PLAN
ARCHITECT: TEEPLE ARCHITECTS
CONTRACTOR: TRIDEL
SCALE: N/T/S
DRAWN BY: S.C
DATE: MARCH 4, 2015
DRAWING No: P2

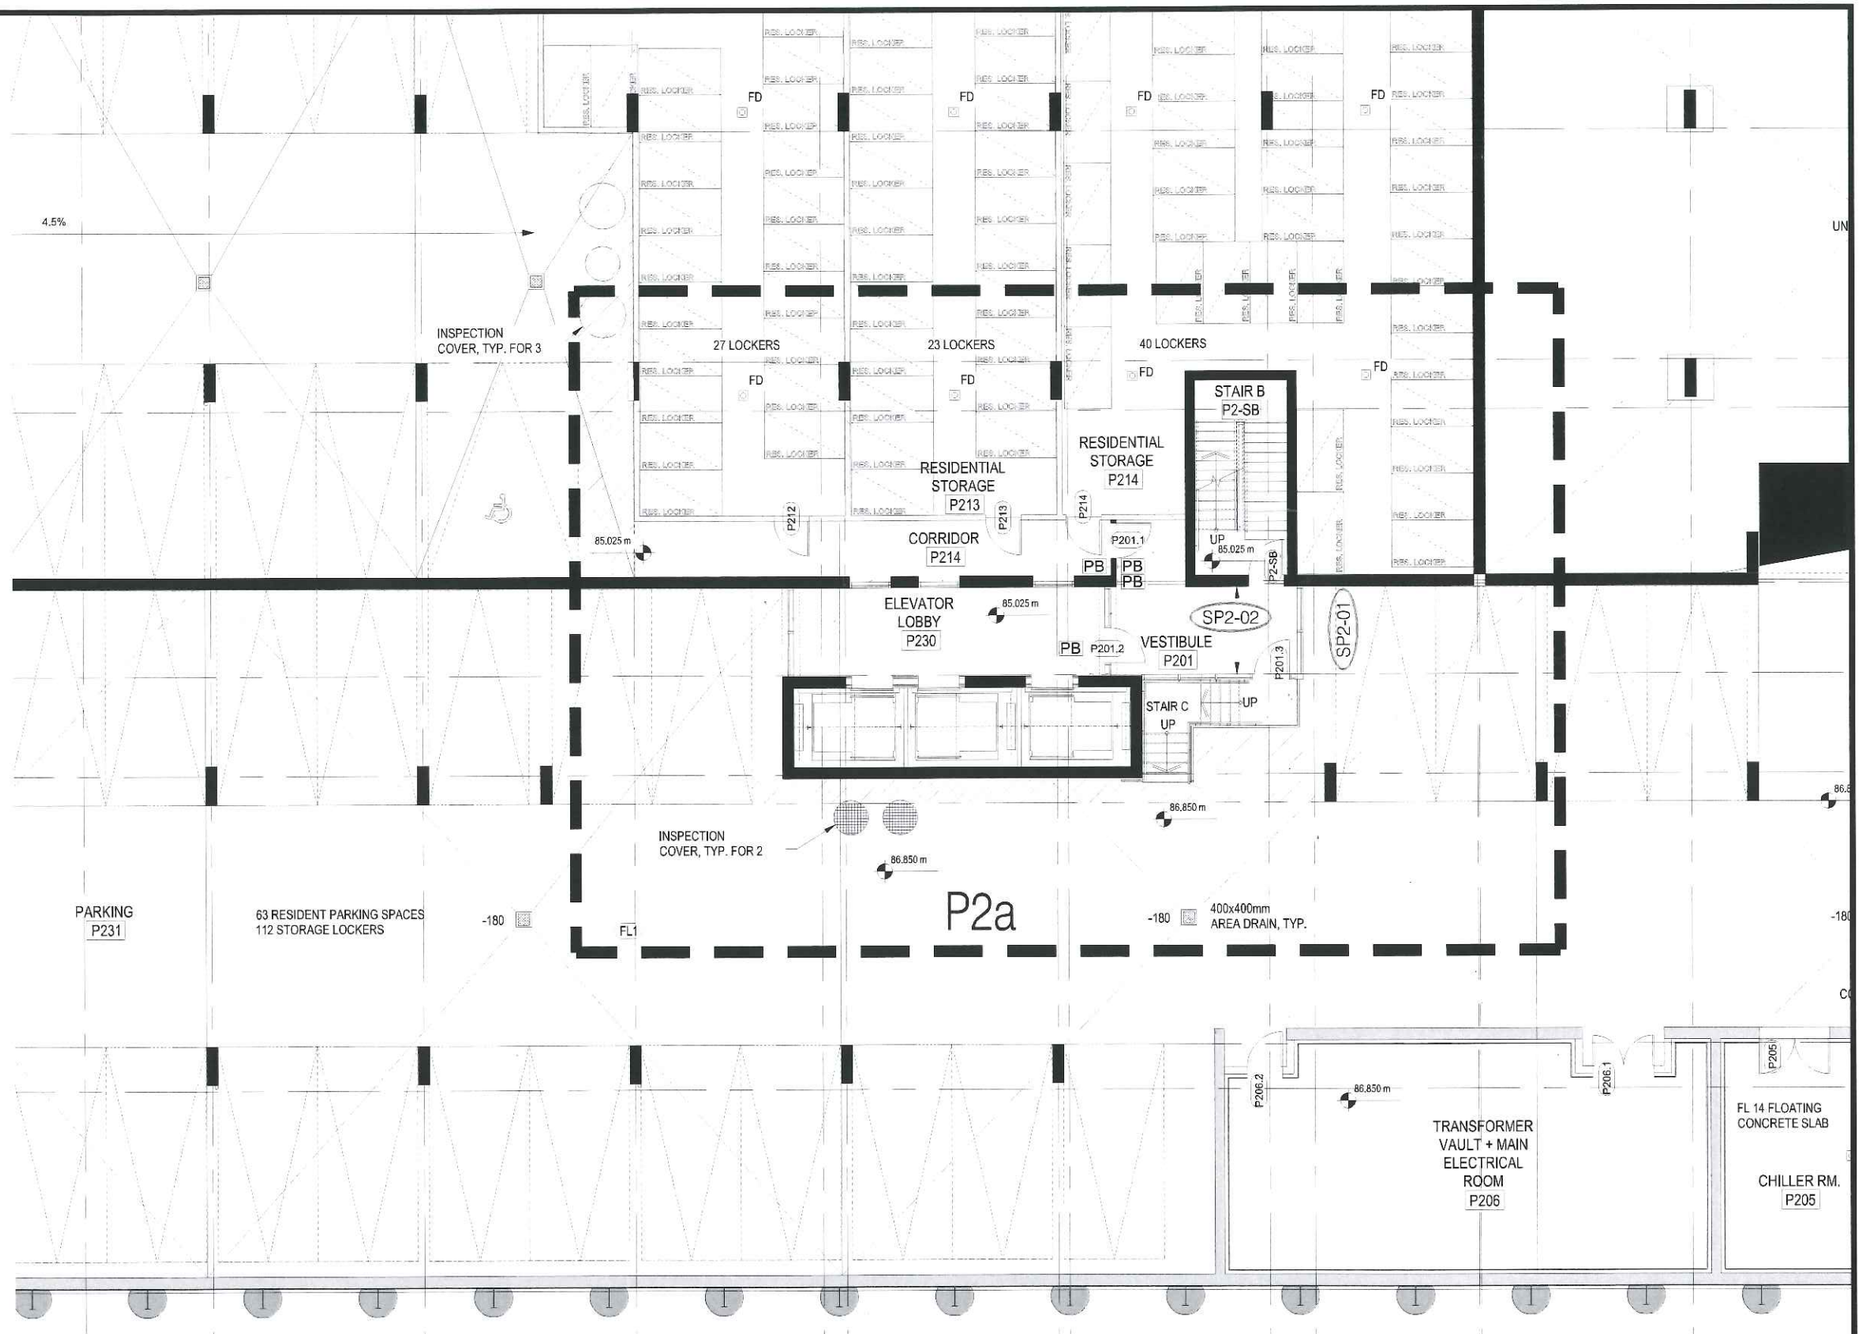


TORO ALUMINUM
COMMERCIAL INDUSTRIAL RESIDENTIAL
330 APPLEWOOD CRESCENT
CONCORD, ON, CANADA
L4K 4V2
TEL:(905)738-8220
FAX:(905)738-9481
WWW.TOROALUMINUM.COM

No.	REVISION	BY	DATE

PROJECT NAME: SQ ALEXANDRA PARK - BLOCK11
DRAWING TITLE: PARKING LEVEL 2 PARTIAL PLAN
ARCHITECT: TEEPLE ARCHITECTS
CONTRACTOR: TRIDEL
SCALE: N.T.S. DRAWN BY: S.C. DATE: MARCH 4, 2015
DRAWING No. P2a

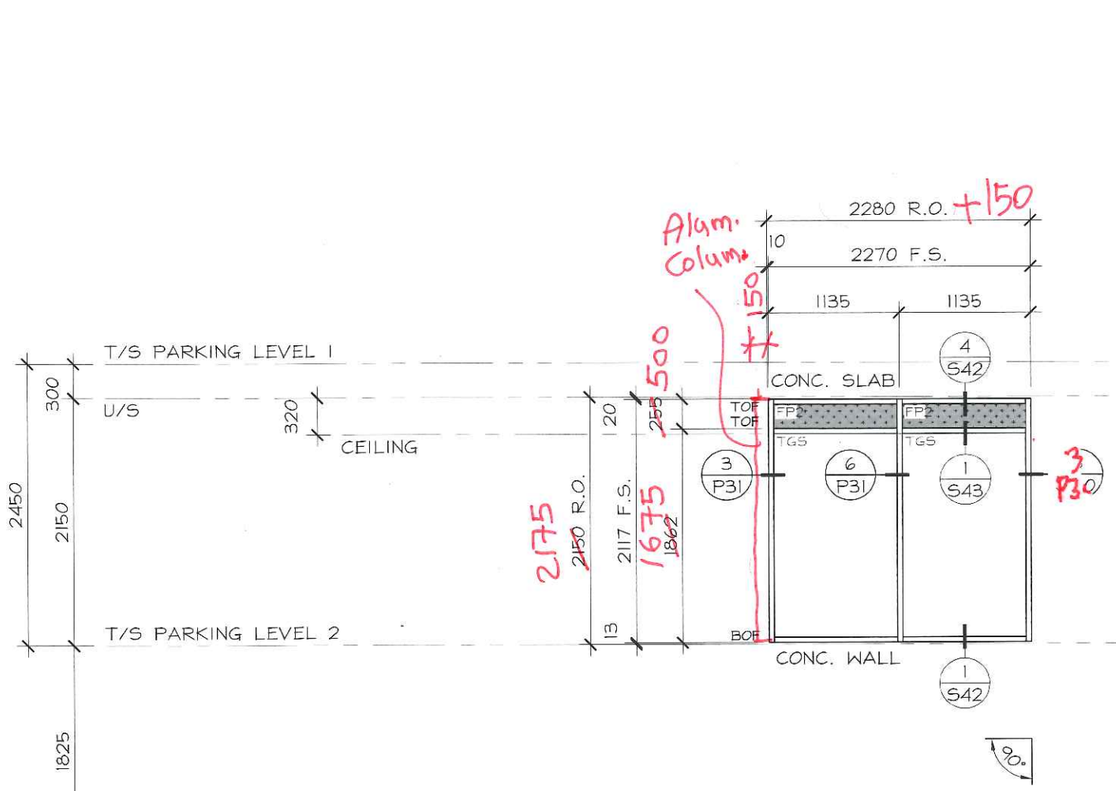

SP2-01 1 REQUIRED
1450 SERIES CW
CLEAR ANODIZED
VESTIBULE (P201)

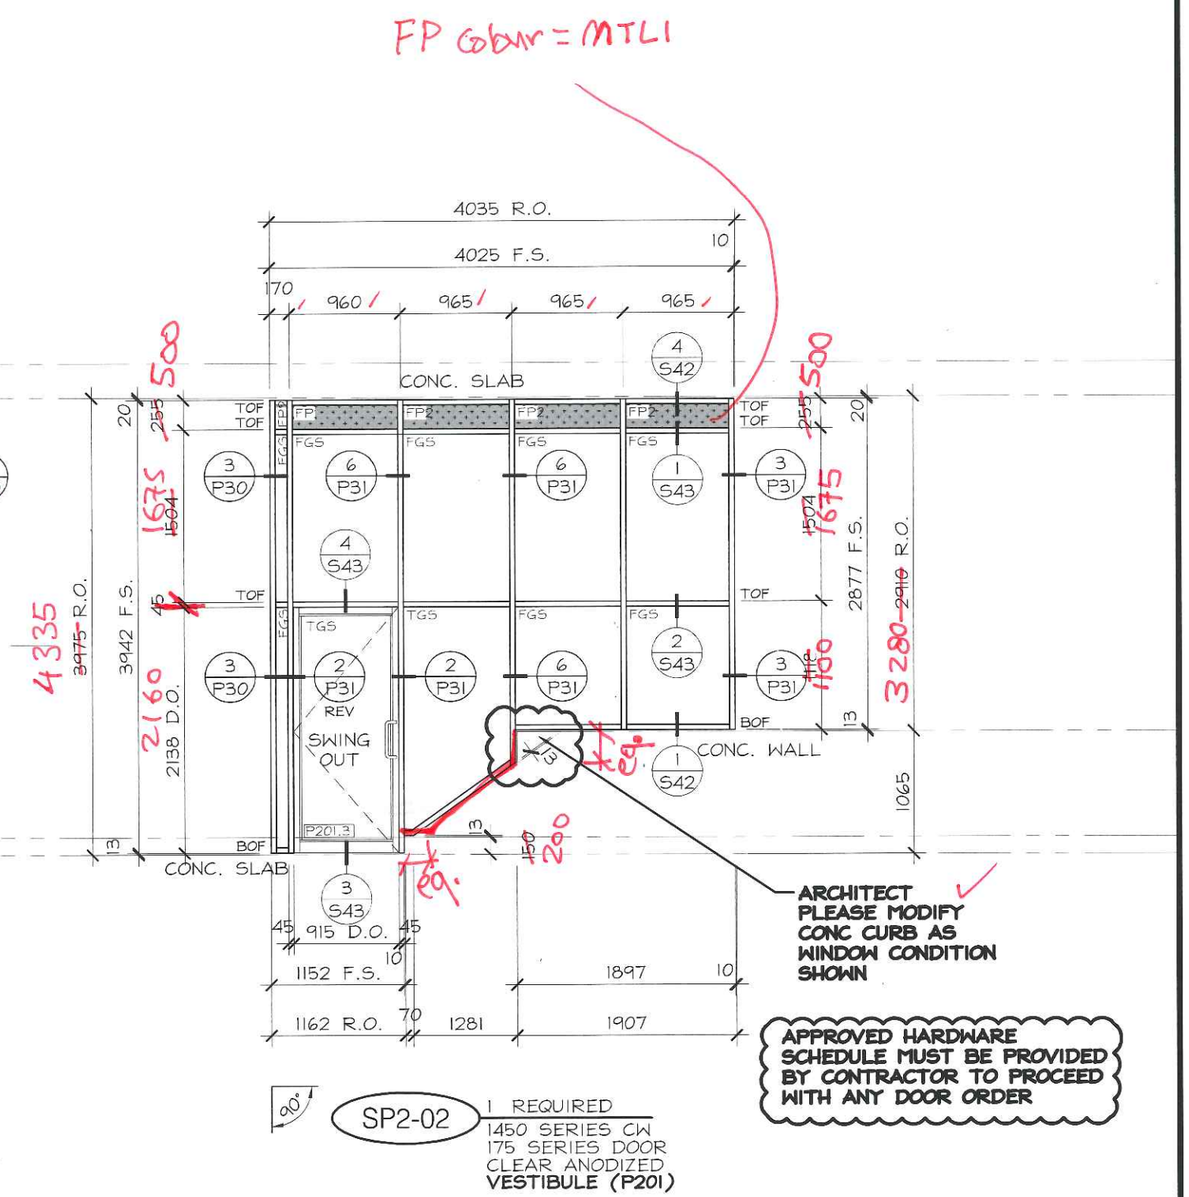


SP2-02 1 REQUIRED
1450 SERIES CW
175 SERIES DOOR
CLEAR ANODIZED
VESTIBULE (P201)

TORO ALUMINUM
COMMERCIAL INDUSTRIAL RESIDENTIAL
330 APPLEWOOD CRESCENT
CONCORD, ON, CANADA
L4K 4V2
TEL: (905)738-5220
FAX: (905)738-5481
WWW.TOROALUMINUM.COM

LICENSED PROFESSIONAL ENGINEER 06-27-15 D.T. PROHASKA 37549013 PROVINCE OF ONTARIO

No.	REVISION	BY	DATE

PROJECT NAME: SQ ALEXANDRA PARK - BLOCK11
DRAWING TITLE: PARKING LEVEL 2 ELEVATIONS
ARCHITECT: TEEPLE ARCHITECTS
CONTRACTOR: TRIDEL
SCALE: 1:50
DRAWN BY: S.C.
DATE: MARCH 4, 2015
DRAWING No.: P2-1

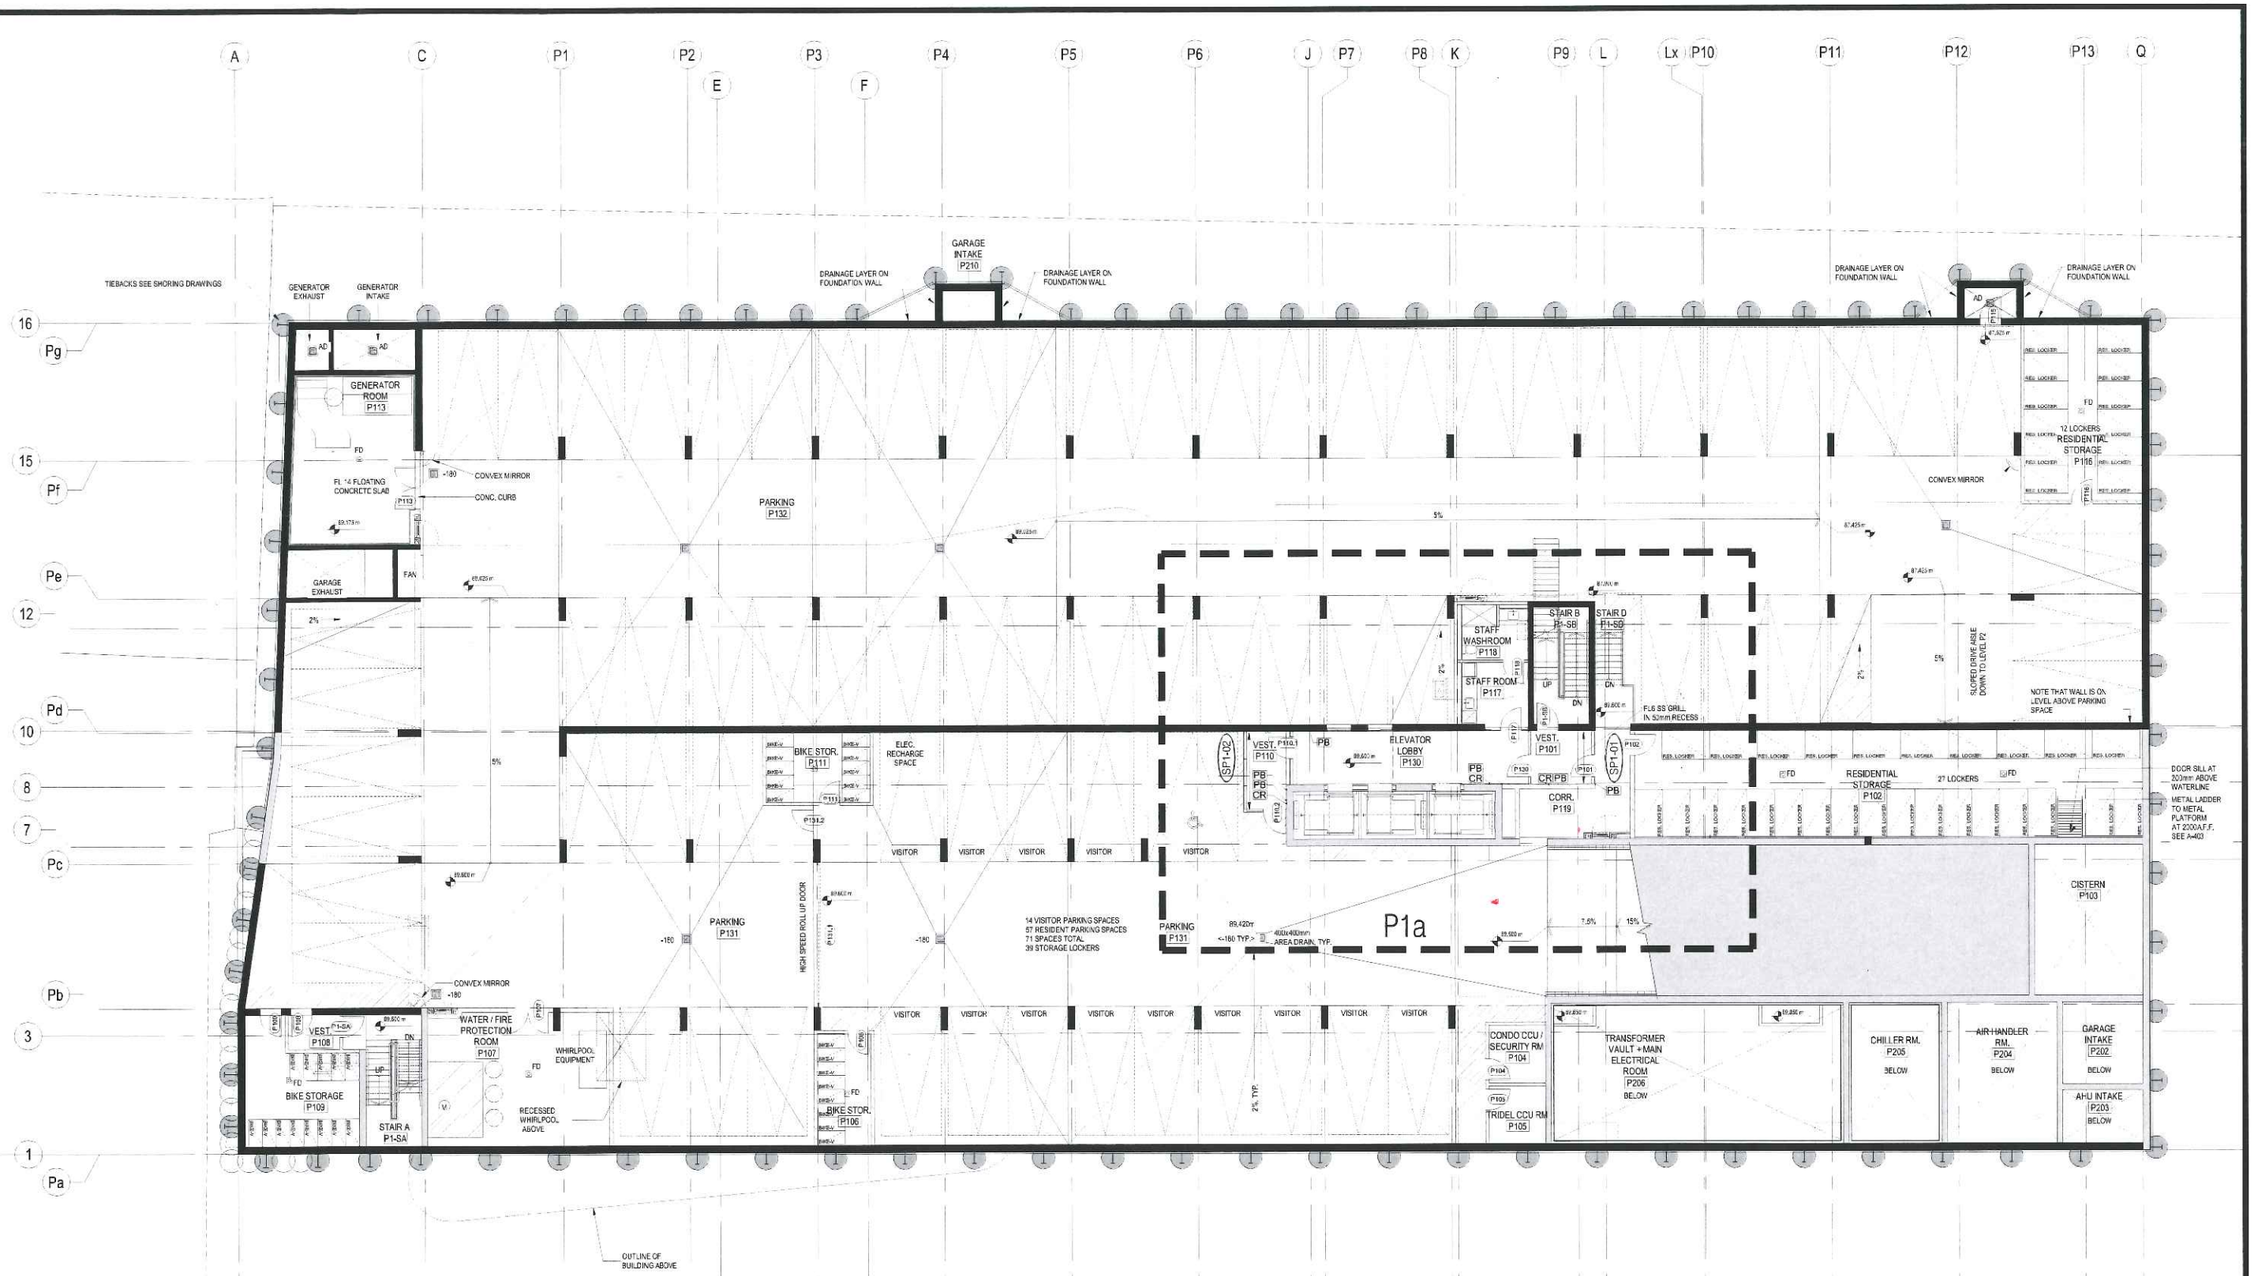

TORO ALUMINUM
COMMERCIAL INDUSTRIAL RESIDENTIAL
530 APPLEWOOD CRESCENT
CONCORD, ON, CANADA
L4K 4V2
TEL:(905)738-5220
FAX:(905)738-5451
WWW.TOROALUMINUM.COM

No.	REVISION	BY	DATE

PROJECT NAME: SQ ALEXANDRA PARK - BLOCK11


DRAWING TITLE: PARKING LEVEL 1 FLOOR KEY PLAN

ARCHITECT: TEEPLE ARCHITECTS

CONTRACTOR: TRIDEL

SCALE: N.T.S | DRAWN BY: S.C | DATE: MARCH 4, 2015


DRAWING No. P1

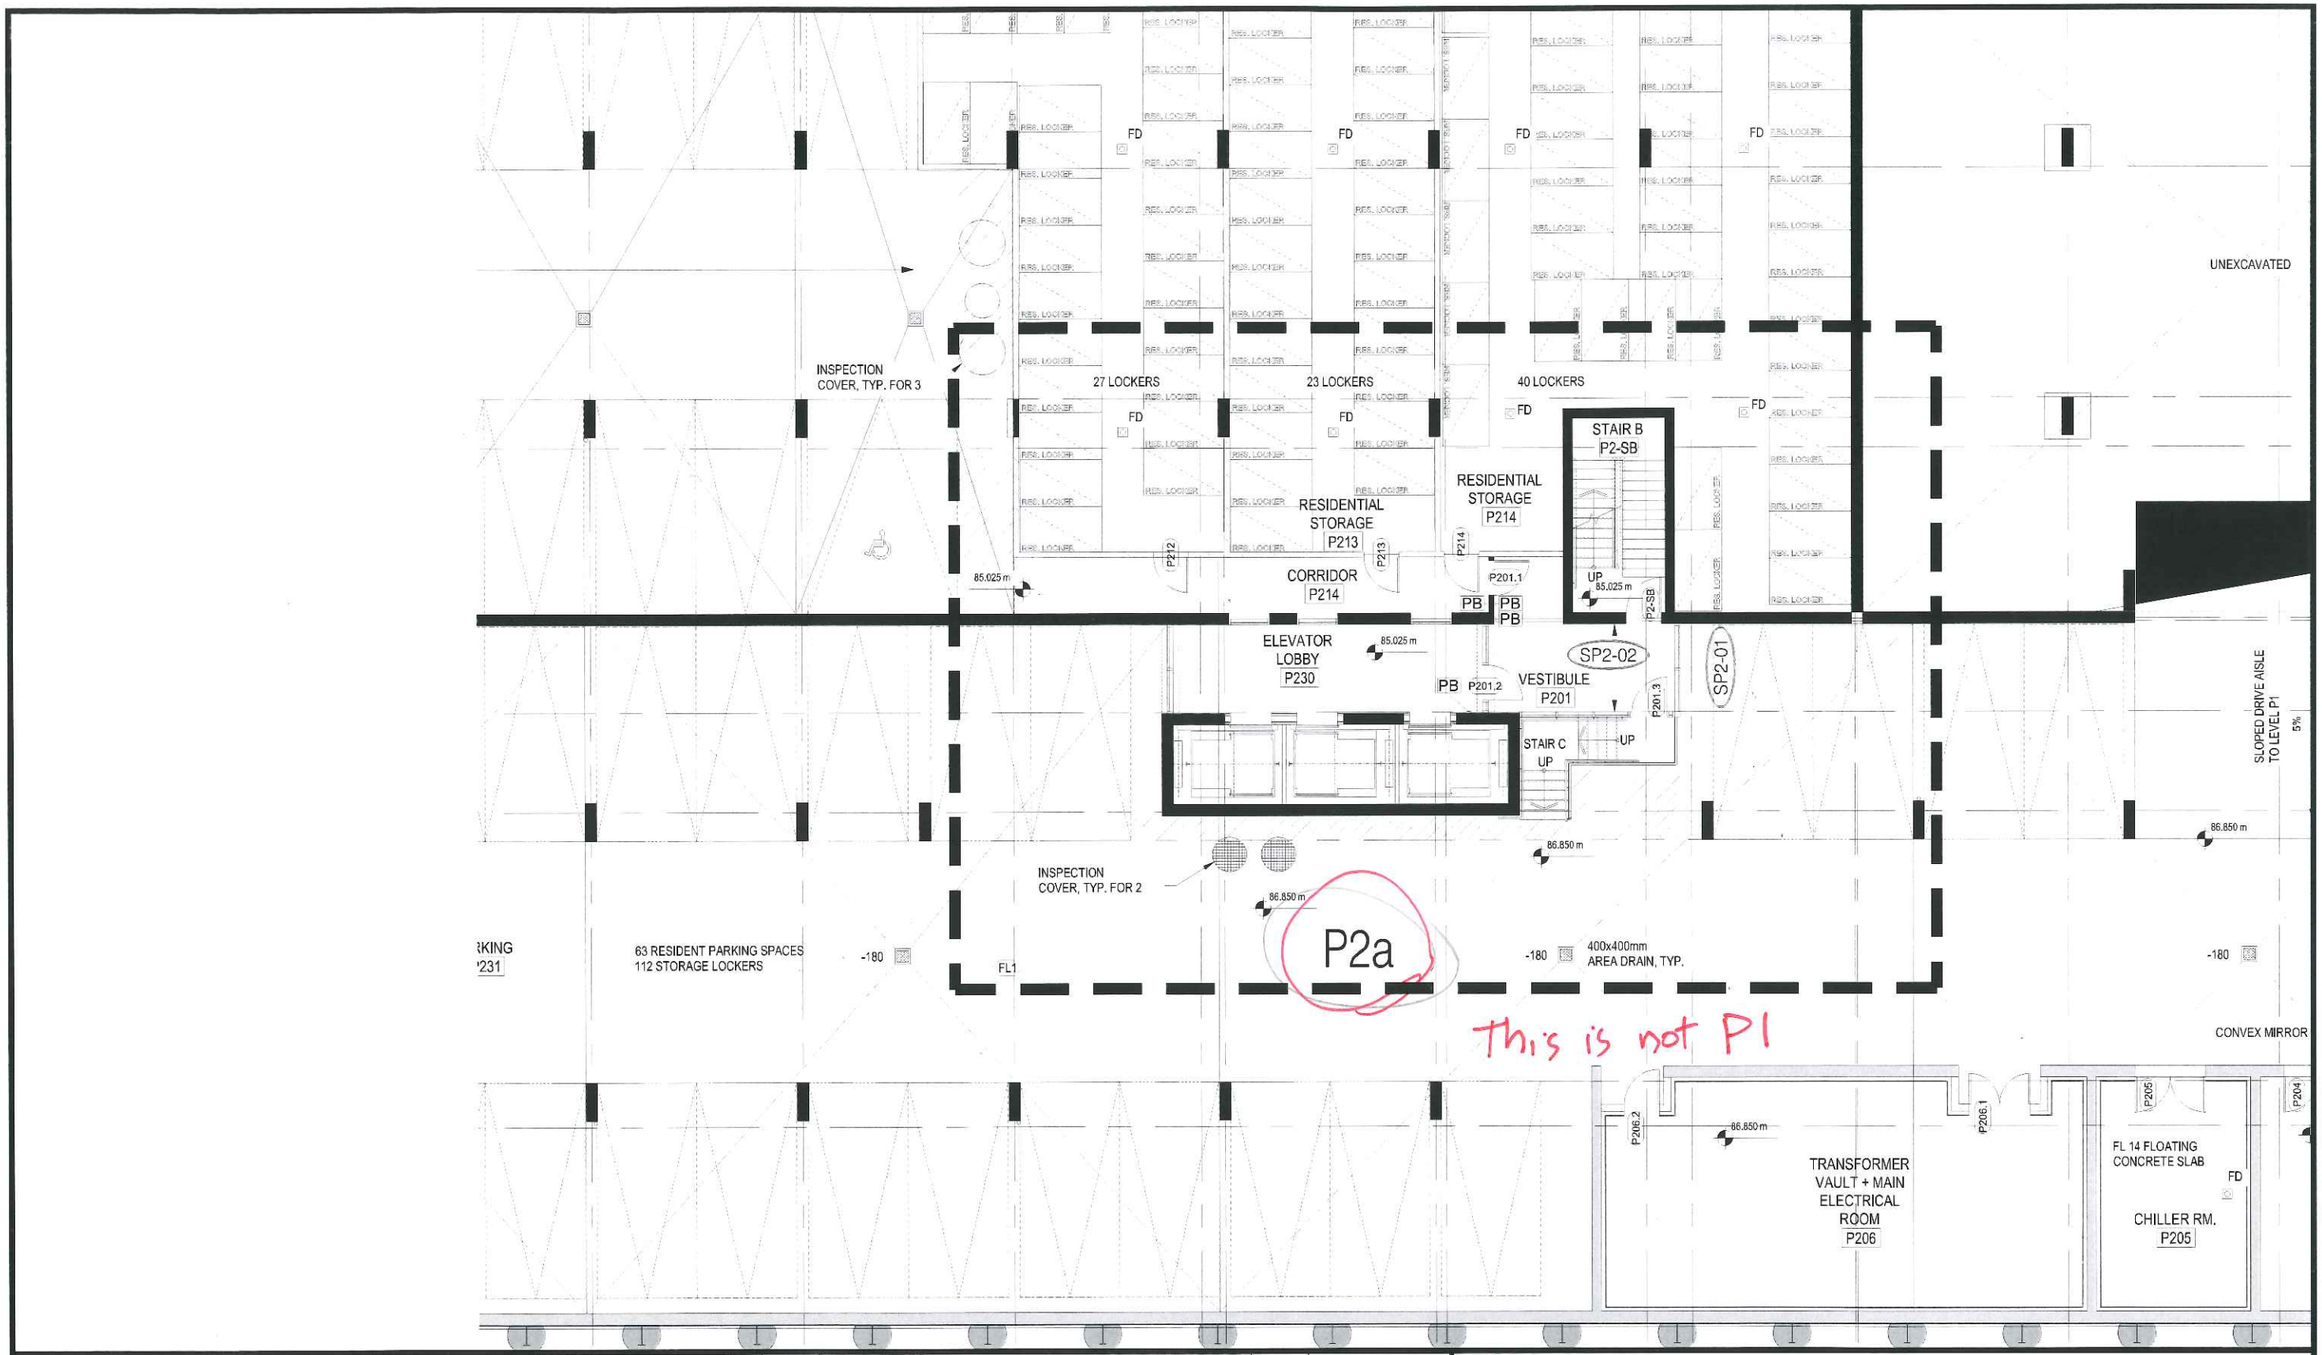

TORO ALUMINUM
COMMERCIAL INDUSTRIAL RESIDENTIAL
330 APPLEWOOD CRESCENT, CONCORD, ON, CANADA L4K 4V2
TEL:(905)738-5020 FAX:(905)738-5481 WWW.TOROALUMINUM.COM

No.	REVISION	BY	DATE

PROJECT NAME: SQ ALEXANDRA PARK - BLOCK11
DRAWING TITLE: PARKING LEVEL 1 PARTIAL PLAN
ARCHITECT: TEEPLE ARCHITECTS
CONTRACTOR: TRIDEL
SCALE: N.T.S. DRAWN BY: S.C. DATE: MARCH 4, 2015
DRAWING No. P1a

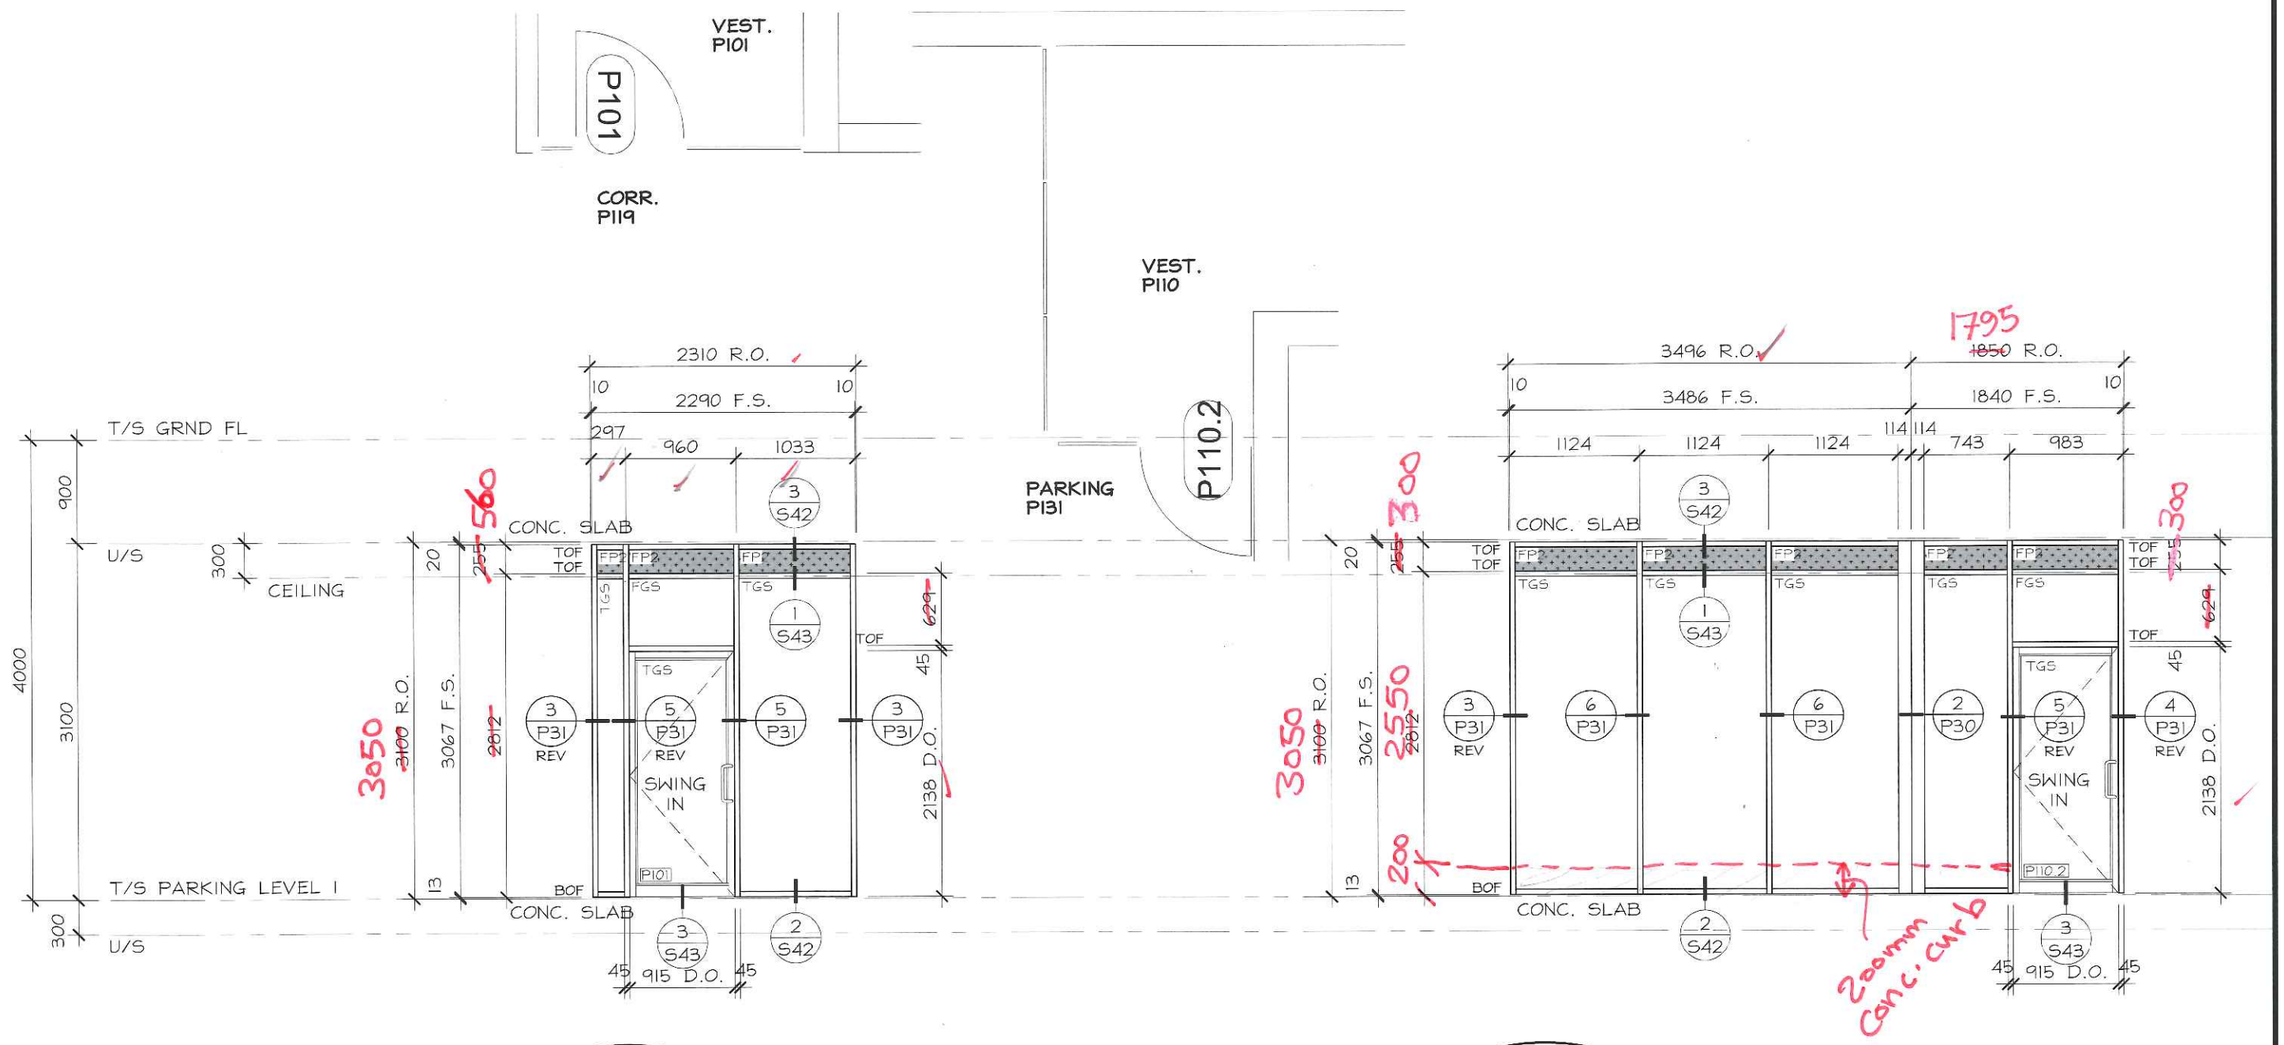

SP1-01 — 1 REQUIRED
1450 SERIES CW
175 SERIES DOOR
CLEAR ANODIZED
VESTIBULE (P101)

SP1-02 — 1 REQUIRED
1450 SERIES CW
175 SERIES DOOR
CLEAR ANODIZED
VESTIBULE (P110)

APPROVED HARDWARE SCHEDULE MUST BE PROVIDED BY CONTRACTOR TO PROCEED WITH ANY DOOR ORDER


Reference plan is required for P1

TORO ALUMINUM
COMMERCIAL INDUSTRIAL RESIDENTIAL
330 APPLEWOOD CRESCENT
CONCORD, ON, CANADA
L4K 4V2
TEL: (905)738-5220
FAX: (905)738-5481
WWW.TOROALUMINUM.COM

LICENSED PROFESSIONAL ENGINEER 06-27-15 D.T. PROHASKA 37549 PROVINCE OF ONTARIO

No.	REVISION	BY	DATE

PROJECT NAME:	SQ ALEXANDRA PARK - BLOCK11
DRAWING TITLE:	PARKING LEVEL 1 ELEVATIONS
ARCHITECT:	TEEPLE ARCHITECTS
CONTRACTOR:	TRIDEL
SCALE: 1:50	DRAWN BY: S.C.
DATE: MARCH 4, 2015	DRAWING No.: P1-1

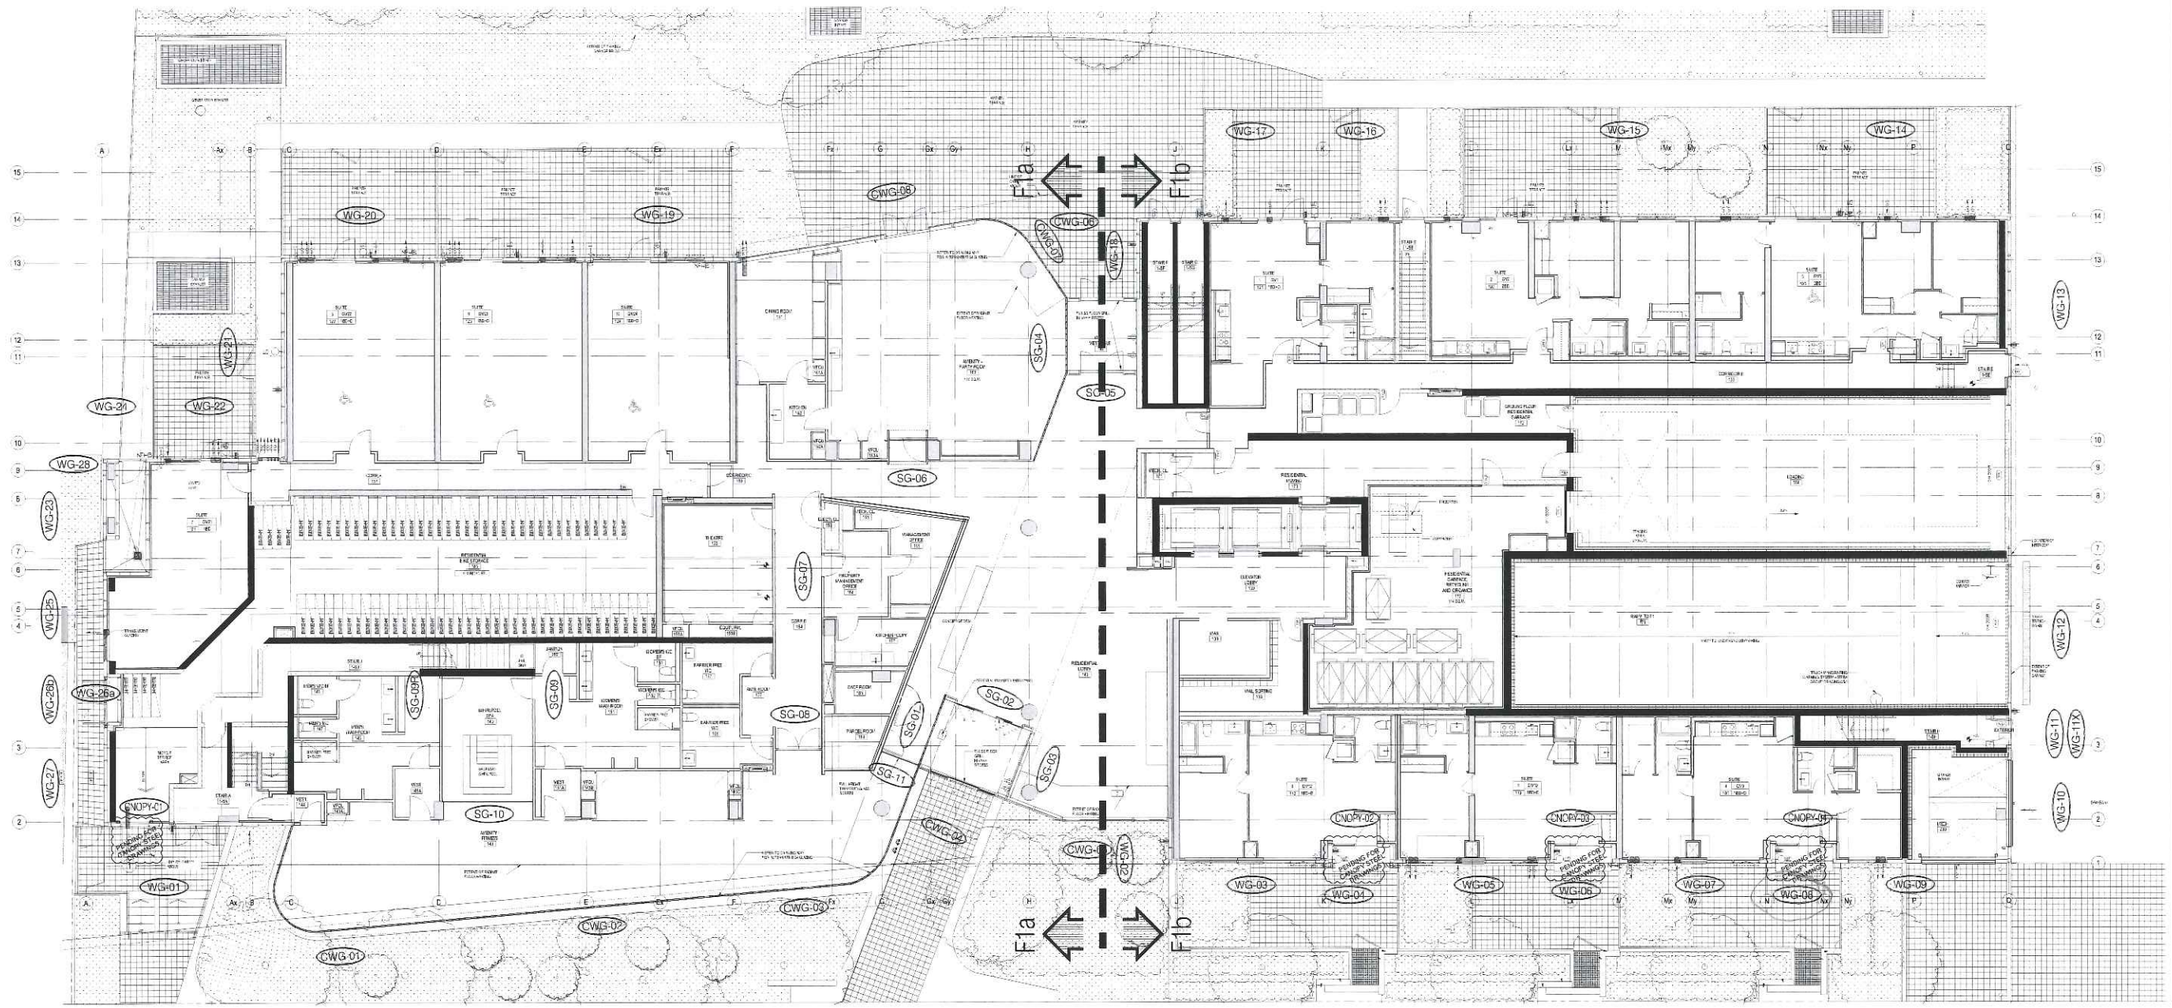


TORO ALUMINUM
COMMERCIAL INDUSTRIAL RESIDENTIAL
550 APPLEWOOD CRESCENT TEL: (905)738-5220
CONCORD, ON, CANADA FAX: (905)738-5457
L4K 4V2 WWW.TORDALUMINUM.COM

No.	REVISION	BY	DATE

PROJECT NAME: SQ ALEXANDRA PARK - BLOCK11
DRAWING TITLE: GROUND FLOOR KEY PLAN
ARCHITECT: TEEPLE ARCHITECTS
CONTRACTOR: TRIDEL
SCALE: N/T/S
DRAWN BY: S.C.
DATE: MARCH 4, 2015
DRAWING No: FG

A5104

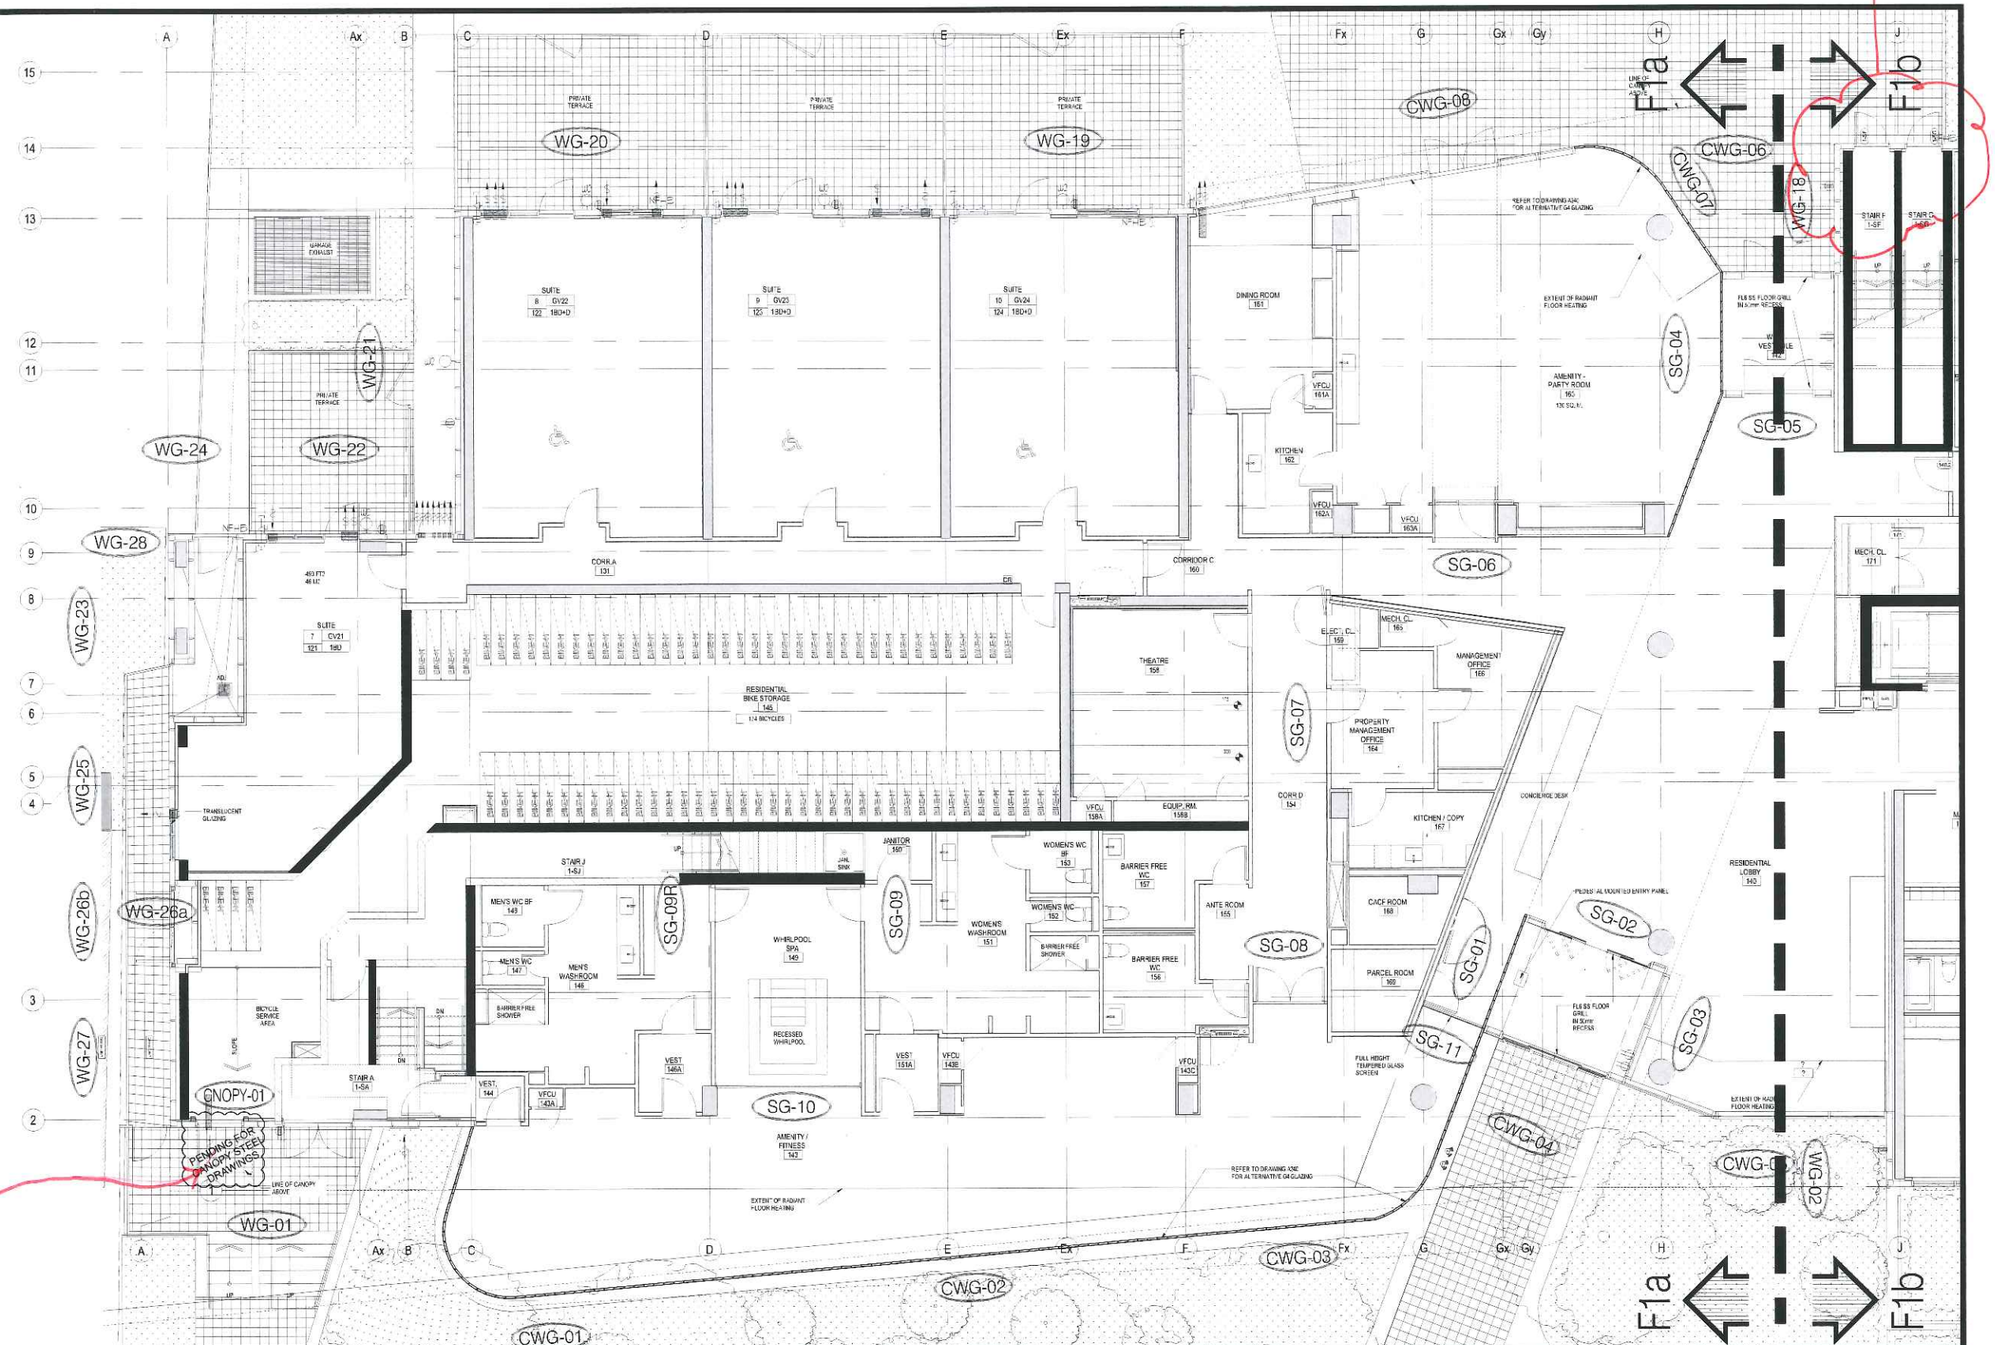

TORO ALUMINUM
COMMERCIAL INDUSTRIAL RESIDENTIAL
330 APPLEWOOD CRESCENT
CONCORD, ON, CANADA
L4K 4V2
TEL: (905) 738-6220
FAX: (905) 738-6481
WWW.TOROALUMINUM.COM

No.	REVISION	BY	DATE

PROJECT NAME: SQ ALEXANDRA PARK - BLOCK11


DRAWING TITLE: GROUND FLOOR PARTIAL PLAN

ARCHITECT: TEEPLE ARCHITECTS

CONTRACTOR: TRIDEL

SCALE: N/T/S | DRAWN BY: S.C | DATE: MARCH 4 2015

DRAWING No. FGa

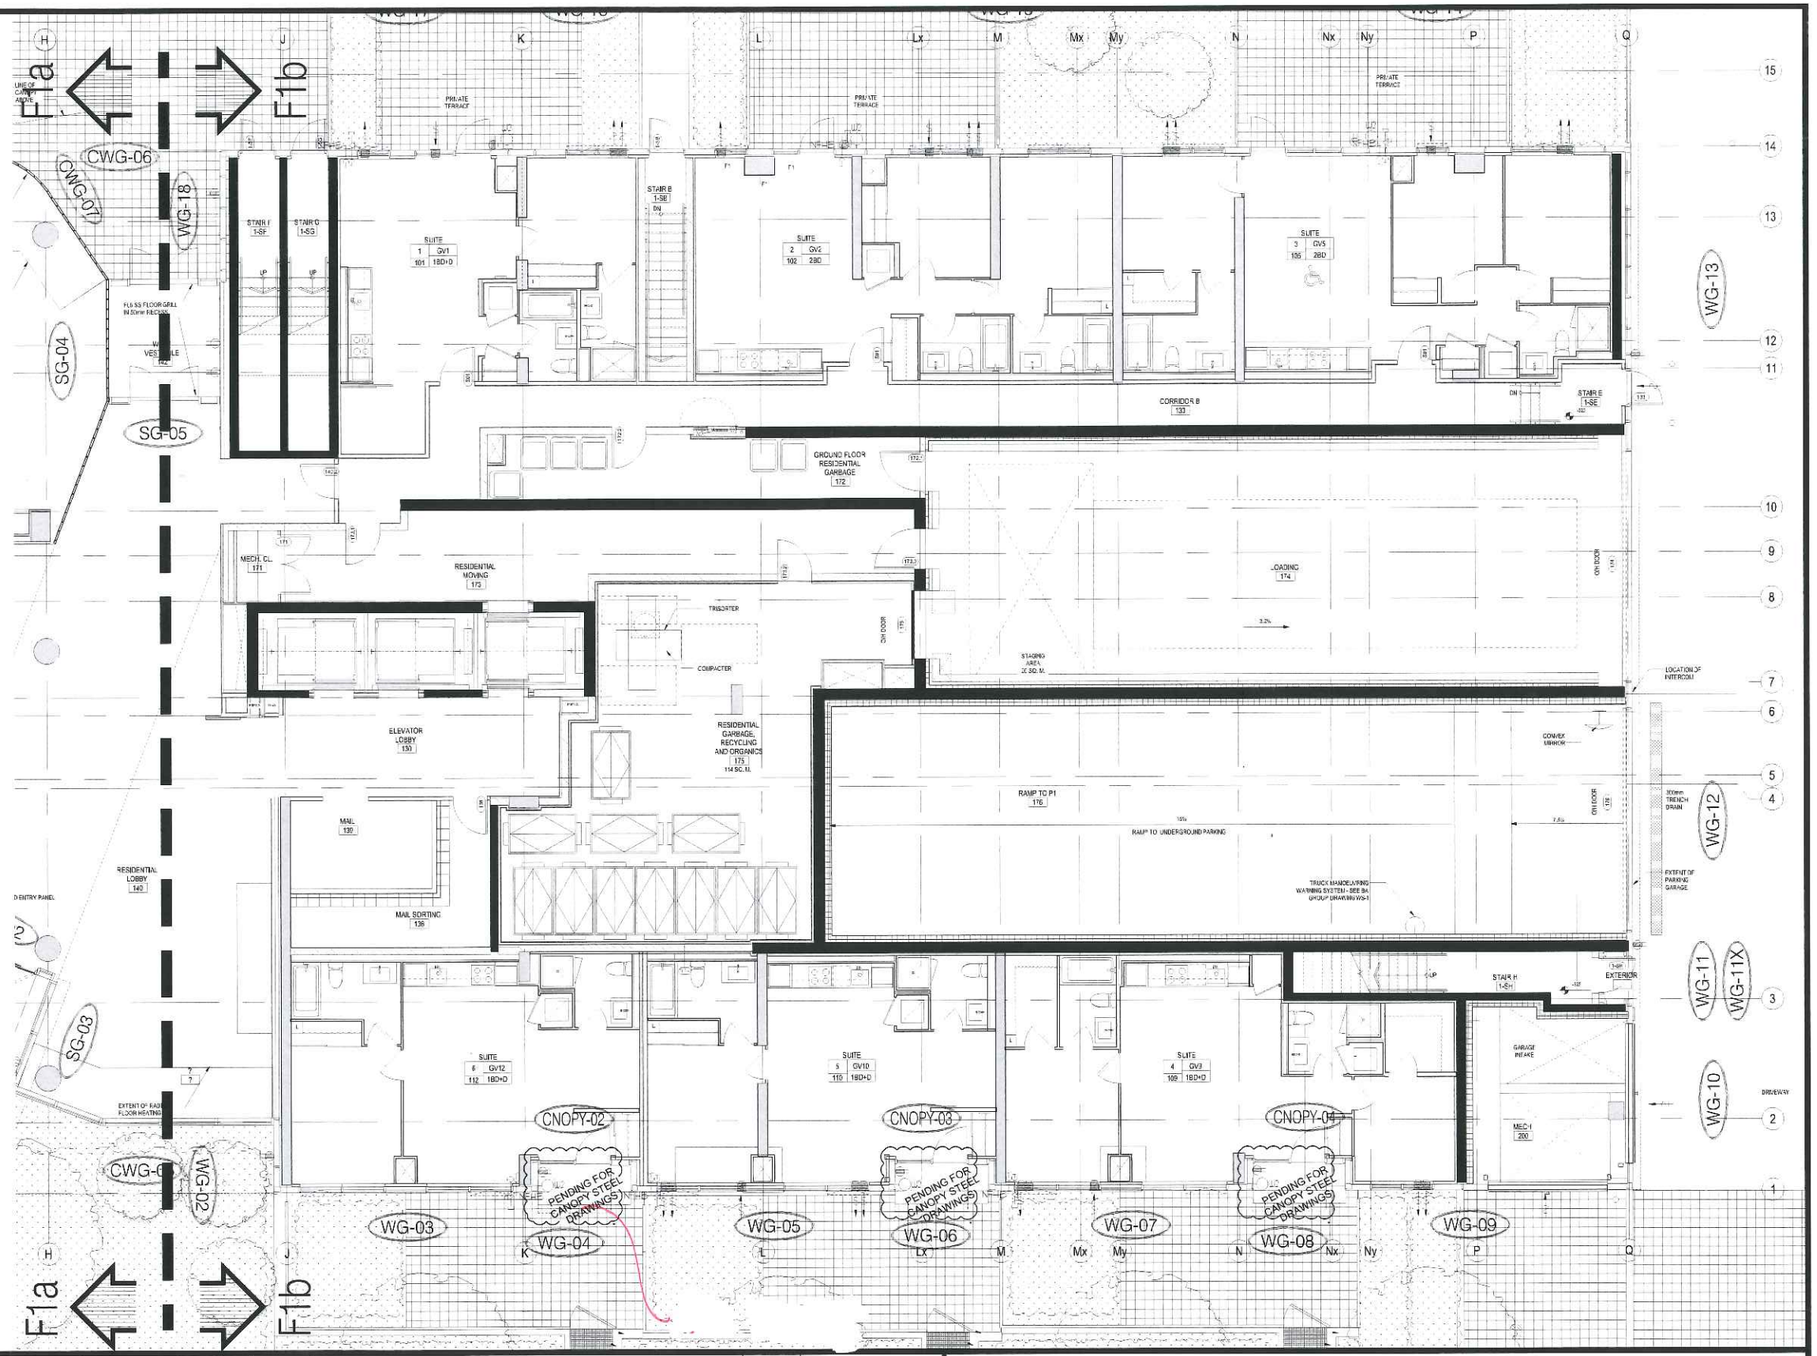

TORO ALUMINUM
COMMERCIAL INDUSTRIAL RESIDENTIAL
330 APPLEWOOD CRESCENT
CONCORD, ON, CANADA
L4K 4V2
TEL: (905)738-8220
FAX: (905)738-5481
WWW.TOROALUMINUM.COM

No.	REVISION	BY	DATE

PROJECT NAME: SQ ALEXANDRA PARK - BLOCK11
DRAWING TITLE: GROUND FLOOR PARTIAL PLAN
ARCHITECT: TEEPLE ARCHITECTS
CONTRACTOR: TRIDEL
SCALE: N.T.S
DRAWN BY: S.C
DATE: MARCH 4, 2015
DRAWING No.: FGb

no canopy (Deleted)

CENTRE LIGHT FIXTURES HORIZONTALLY ON PANELS.

TORO TO VERIFY FOR 915 mm ALUM. DOOR.

PENDING FOR CANOPY STEEL DRAWINGS

A Ax B C 1 2

7942 R.O.
7917 F.S.
25 106
124 501 1250 1346 368 659 1136 965 1105 935 974 1040 700 1040 225 10

T/S 2ND FL
U/S
200
25
4250
4050
4225 R.O.
4010 F.S.
1050
4185
1460
1230
615
1250
860
15
175
135
T/S GRND FL
T/S @ BICYCLE ENTRY 93.425 m.

TOF
96.525 TOF @ LOUVER
W/S LIGHT FIX. 95.850

BALCONY
BY-PASS
25
500
PP1
PPI
PG/HS
LOUVER
900
415
550
T.O.F. @ LOUVER 96.660
T.O.F. 95.760
TO ALIGN WITH DOOR FRAME

3 P4
S30
3 S29
5 P15
1 P27
4 S21
8 P15
1 S22
1 S31
2 S31
4 S29

ALUM. DOOR BY TORO
1-SA-1
ALUM. DOOR BY TORO
235 CLEAR OPENING
135
CONC. SLAB
4 S25
468 10
685 TOP
15

250 A 12.00 CLEAR OPENING PLUS HM FRAMES.
90°
90
915 1880 CLEAR OPENING 1 leaf door
900

CARD READER CENTRE @ 94.475m. CENTRE HORIZONTALLY ON PANEL.

NO VERT. JOINT HERE.

W/S BM 97.150

CANOPY DELETED.

1-A
CROSS SECTION
ARCH.REF. 4/A612

WG-01 1 REQUIRED
2587 SERIES
2487 SERIES


LIGHT FIXTURE HT. 2425 FROM ADJ. FLOOR L.(EXT.)

TORO ALUMINUM
COMMERCIAL INDUSTRIAL RESIDENTIAL
330 APPLEWOOD CRESCENT TEL: (905)738-5220
CONCORD, ON, CANADA FAX: (905)738-5481
L4K 4V2 WWW.TOROALUMINUM.COM

LICENSED PROFESSIONAL ENGINEER 06-27-15 D.T. PROHASKA 37549017 PROVINCE OF ONTARIO

No.	REVISION	BY	DATE

PROJECT NAME: SQ ALEXANDRA PARK - BLOCK11
DRAWING TITLE: GROUND FLOOR ELEVATIONS
ARCHITECT: TEEPLE ARCHITECTS
CONTRACTOR: TRIDEL
SCALE: 1:50 DRAWN BY: S.C. DATE: MARCH 4, 2015
DRAWING No.: EG-1

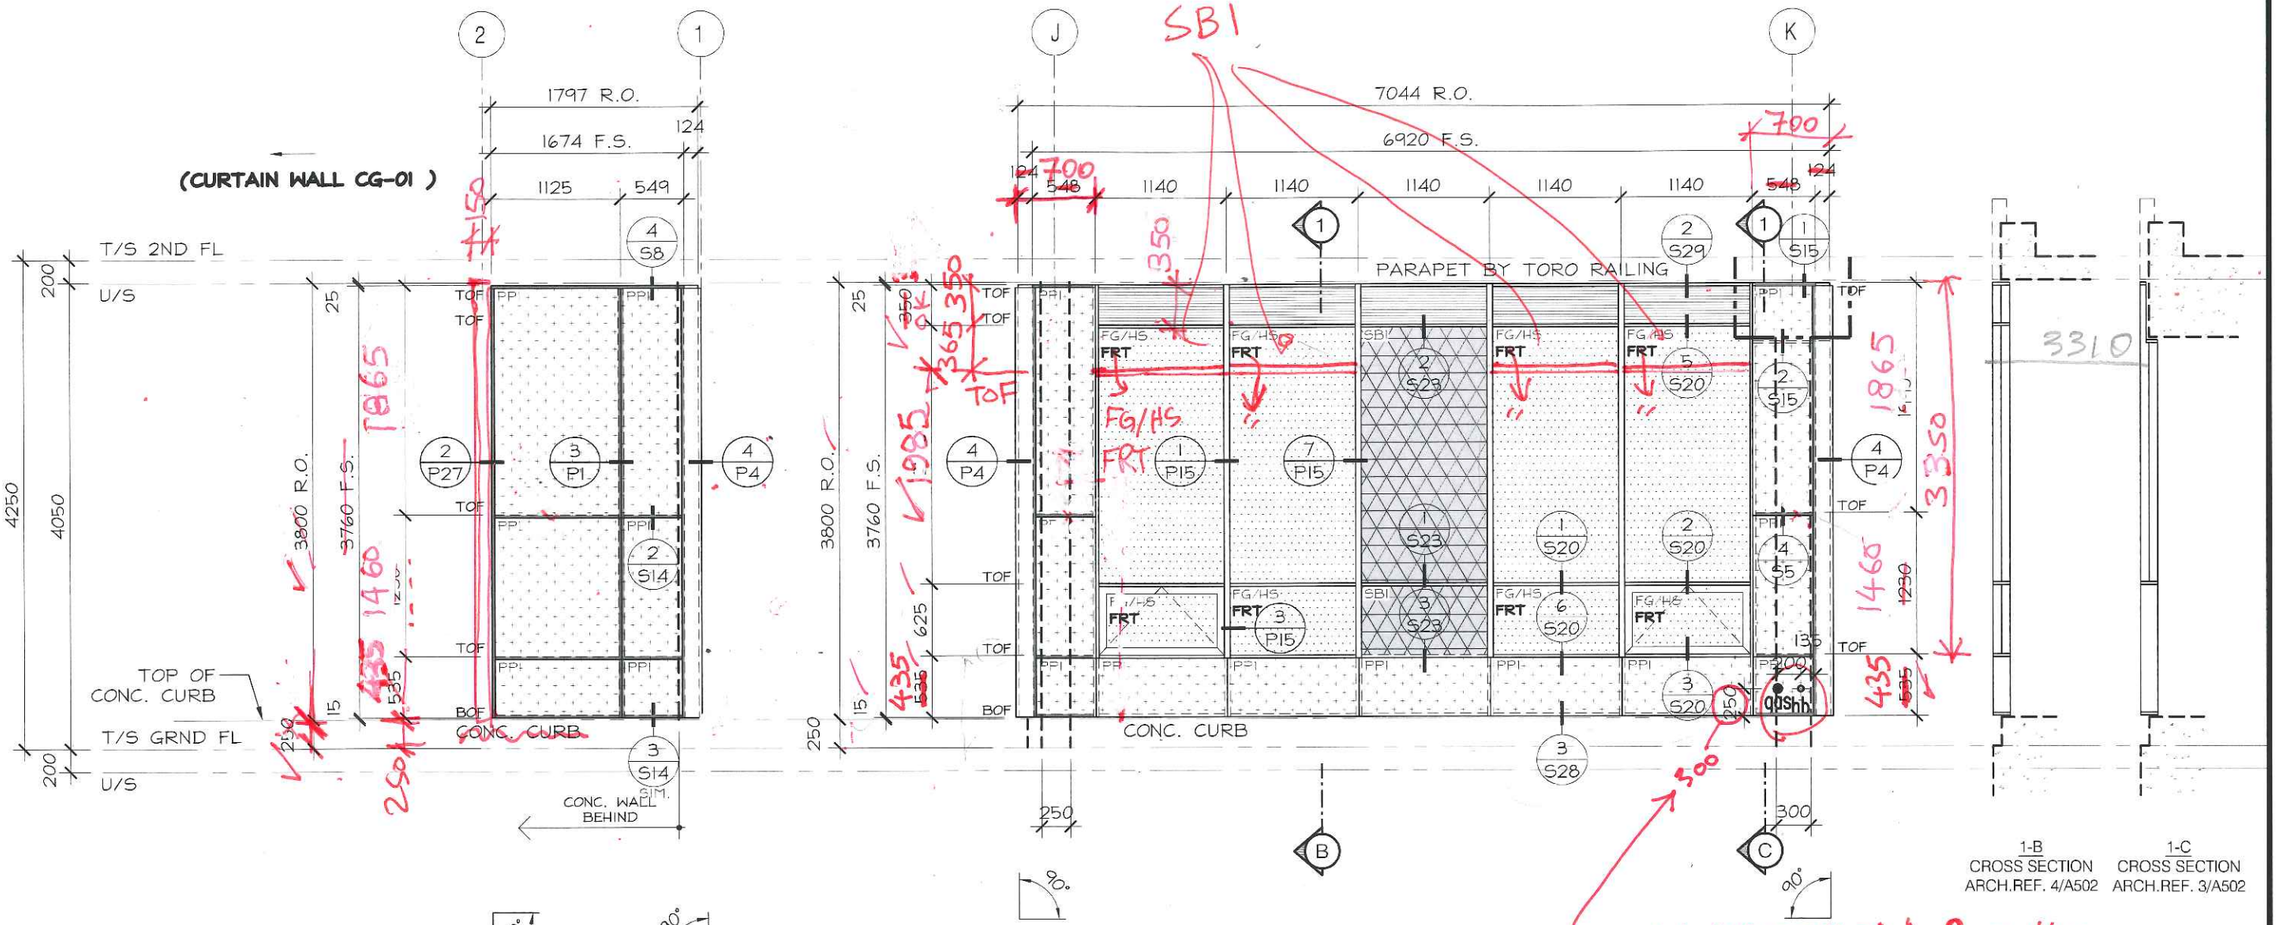

TORO ALUMINUM
COMMERCIAL INDUSTRIAL RESIDENTIAL
330 APPLEWOOD CRESCENT
CONCORD, ON, CANADA
L4K 4V2
TEL: (905)738-5220
FAX: (905)738-5481
WWW.TOROALUMINUM.COM

LICENSED PROFESSIONAL ENGINEER
06-27-15
D.T. PROHASKA
3754901
PROVINCE OF ONTARIO

No.	REVISION	BY	DATE

PROJECT NAME:	SQ ALEXANDRA PARK - BLOCK11
DRAWING TITLE:	GROUND FLOOR ELEVATIONS
ARCHITECT:	TEEPLE ARCHITECTS
CONTRACTOR:	TRIDEL
SCALE: 1:50	DRAWN BY: S.C.
DATE: MARCH 4, 2015	DRAWING No.: EG-2

ONLY WHERE THE RAILING IS OVER EXTERIOR SPACE — ONLY CANTILEVERED BALCONIES — CAN THE FASCIA PANELS BE BY TORO RAILING. WHEN THE SPACE BELOW IS INTERIOR, FASCIA PANELS MUST BE WINDOW WALL BECAUSE IT IS PART OF THE BUILDING ENVELOPE SYSTEM.

PENDING FOR CANOPY STEEL DRAWINGS

CANOPY HSS PENETRATION

PARAPET BY TORO RAILING

all panels PP1

T/S 2ND FL

U/S

T/S GRND FL

U/S

TOP OF CONC. CURB

CONC. SLAB

CONC. COLUMN BEHIND

DEMISING WALL BEHIND

1-D
CROSS SECTION
ARCH.REF.
2/A502;3/A612

* B.O. LF = +2250


WG-04 | 1 REQUIRED
2587 SERIES
2487 SERIES

TORO ALUMINUM
COMMERCIAL INDUSTRIAL RESIDENTIAL
330 APPLEWOOD CRESCENT
CONCORD, ON, CANADA
L4K 4V2
TEL: (905)738-5220
FAX: (905)738-5481
WWW.TOROALUMINUM.COM

LICENSED PROFESSIONAL ENGINEER
06-27-15
D.T. PROHASKA
3754901
PROVINCE OF ONTARIO

No.	REVISION	BY	DATE

PROJECT NAME: SQ ALEXANDRA PARK - BLOCK11
DRAWING TITLE: GROUND FLOOR ELEVATIONS
ARCHITECT: TEEPLE ARCHITECTS
CONTRACTOR: TRIDEL
SCALE: 1:50
DRAWN BY: S.C.
DATE: MARCH 4, 2015
DRAWING No.: EG-3

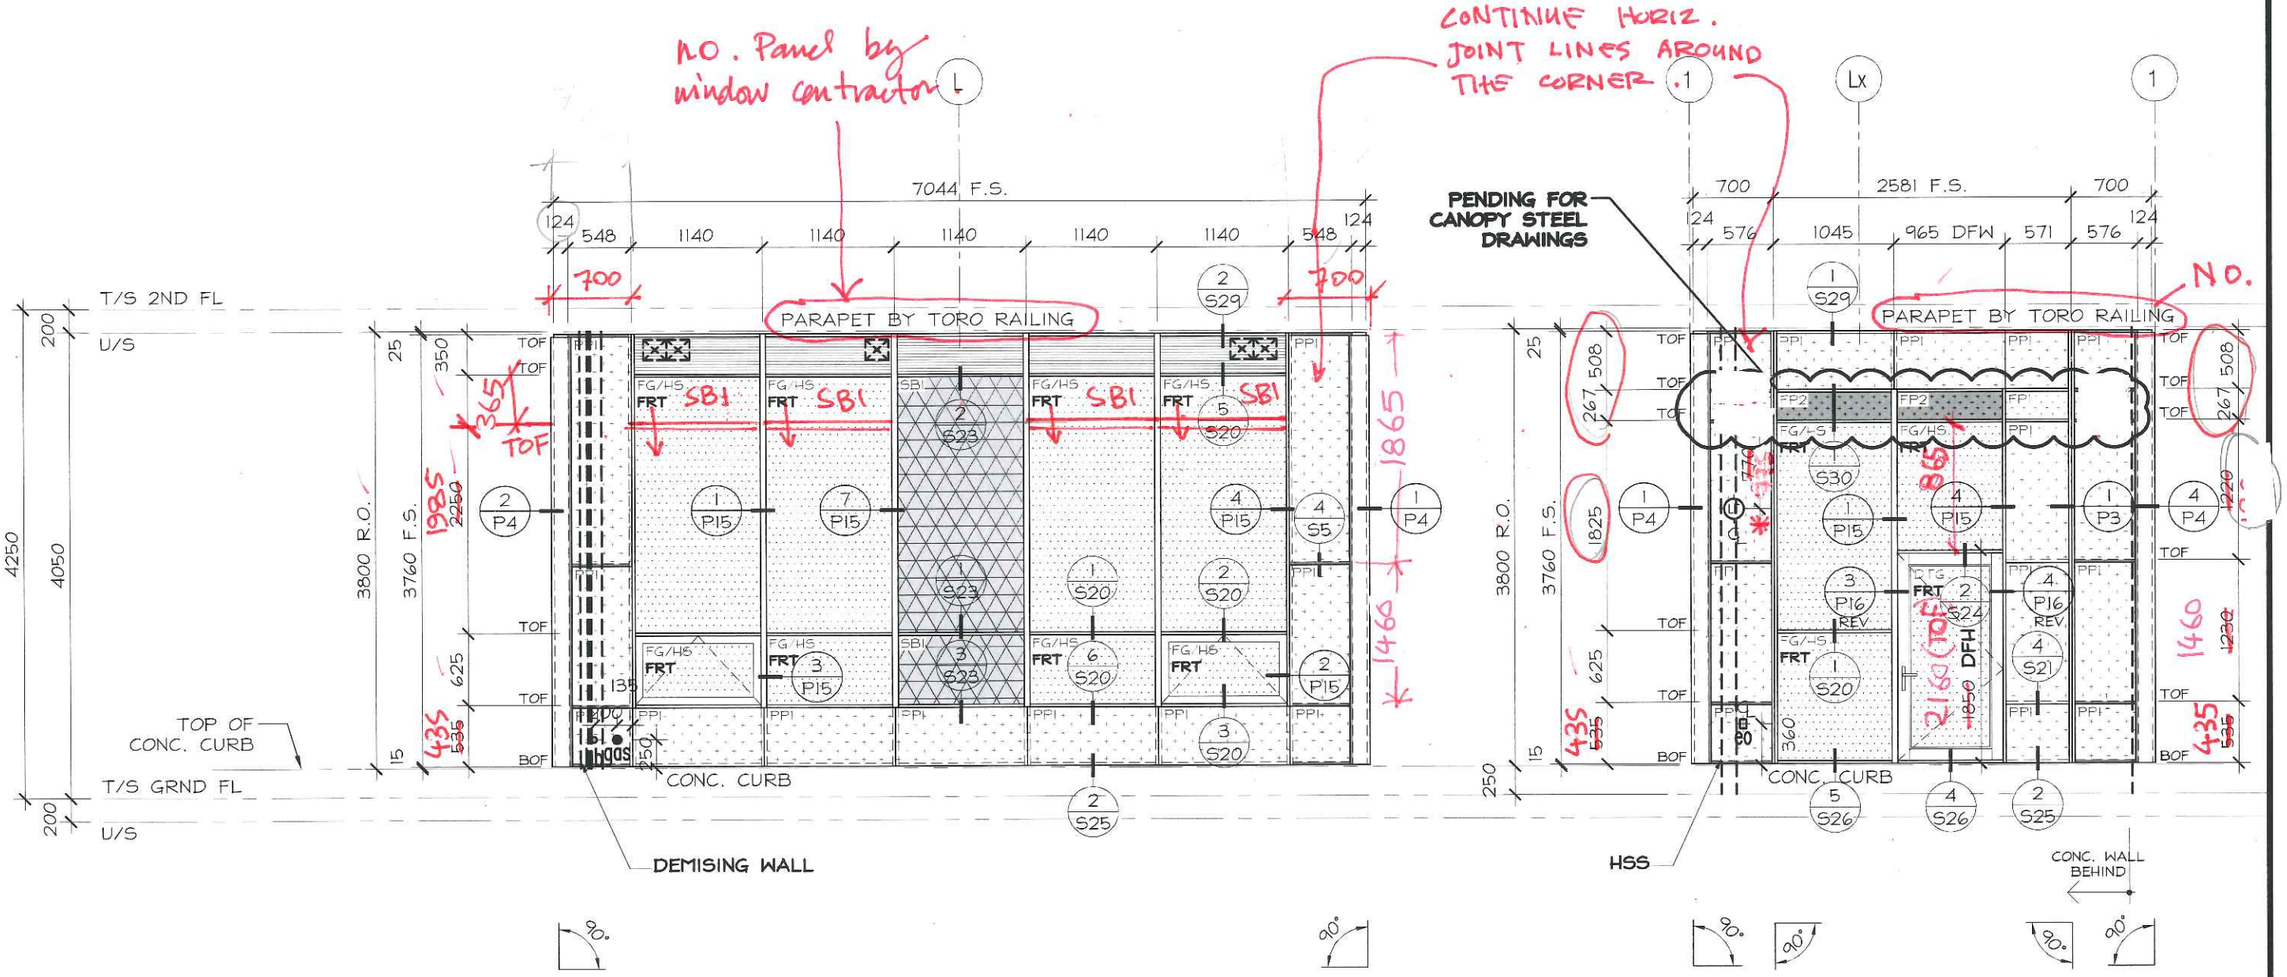

WG-05 1 REQUIRED
2587 SERIES
2487 SERIES

*B.O.L.F


WG-06 1 REQUIRED
2587 SERIES
2487 SERIES
(See comments on WG-04)

TORO ALUMINUM
COMMERCIAL INDUSTRIAL RESIDENTIAL
330 APPLEWOOD CRESCENT TEL: (905)738-5220
CONCORD, ON, CANADA FAX: (905)738-5481
L4K 4V2 WWW.TOROALUMINUM.COM

LICENSED PROFESSIONAL ENGINEER
06-27-15
D.T. PROHASKA
3754901
PROVINCE OF ONTARIO

No.	REVISION	BY	DATE

PROJECT NAME: SQ ALEXANDRA PARK - BLOCK11
DRAWING TITLE: GROUND FLOOR ELEVATIONS
ARCHITECT: TEEPLE ARCHITECTS
CONTRACTOR: TRIDEL
SCALE: 1:50 DRAWN BY: S.C. DATE: MARCH 4, 2015
DRAWING No.: EG-4

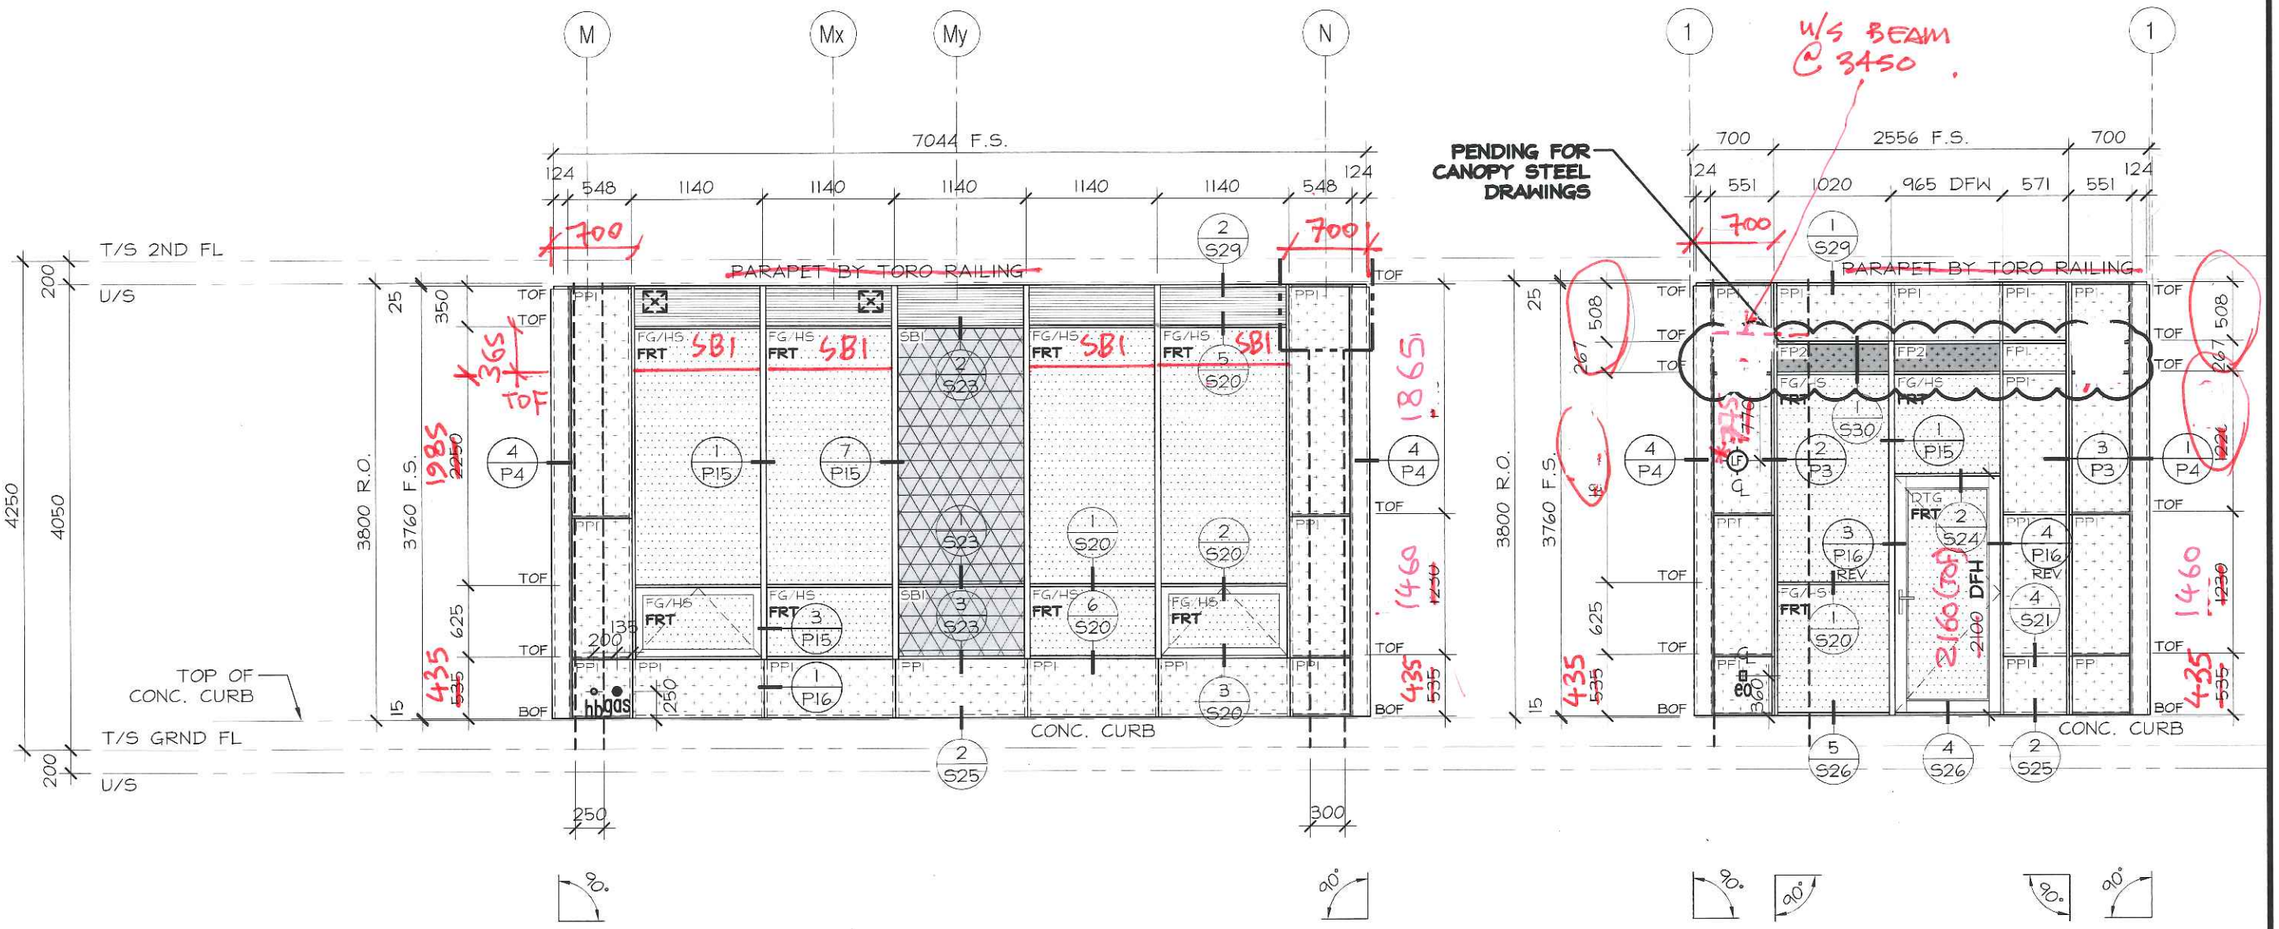


TORO ALUMINUM
COMMERCIAL INDUSTRIAL RESIDENTIAL
330 APPLEWOOD CRESCENT CONCORD, ON, CANADA L4K 4V2
TEL: (905)738-5220 FAX: (905)738-5481 WWW.TOROALUMINUM.COM

LICENSED PROFESSIONAL ENGINEER 06-27-15 D.T. PROHASKA 37549014 PROVINCE OF ONTARIO

No.	REVISION	BY	DATE

PROJECT NAME: SQ ALEXANDRA PARK - BLOCK11
DRAWING TITLE: GROUND FLOOR ELEVATIONS
ARCHITECT: TEEPLE ARCHITECTS
CONTRACTOR: TRIDEL
SCALE: 1:50 DRAWN BY: S.C. DATE: MARCH 4, 2015
DRAWING No.: EG-5

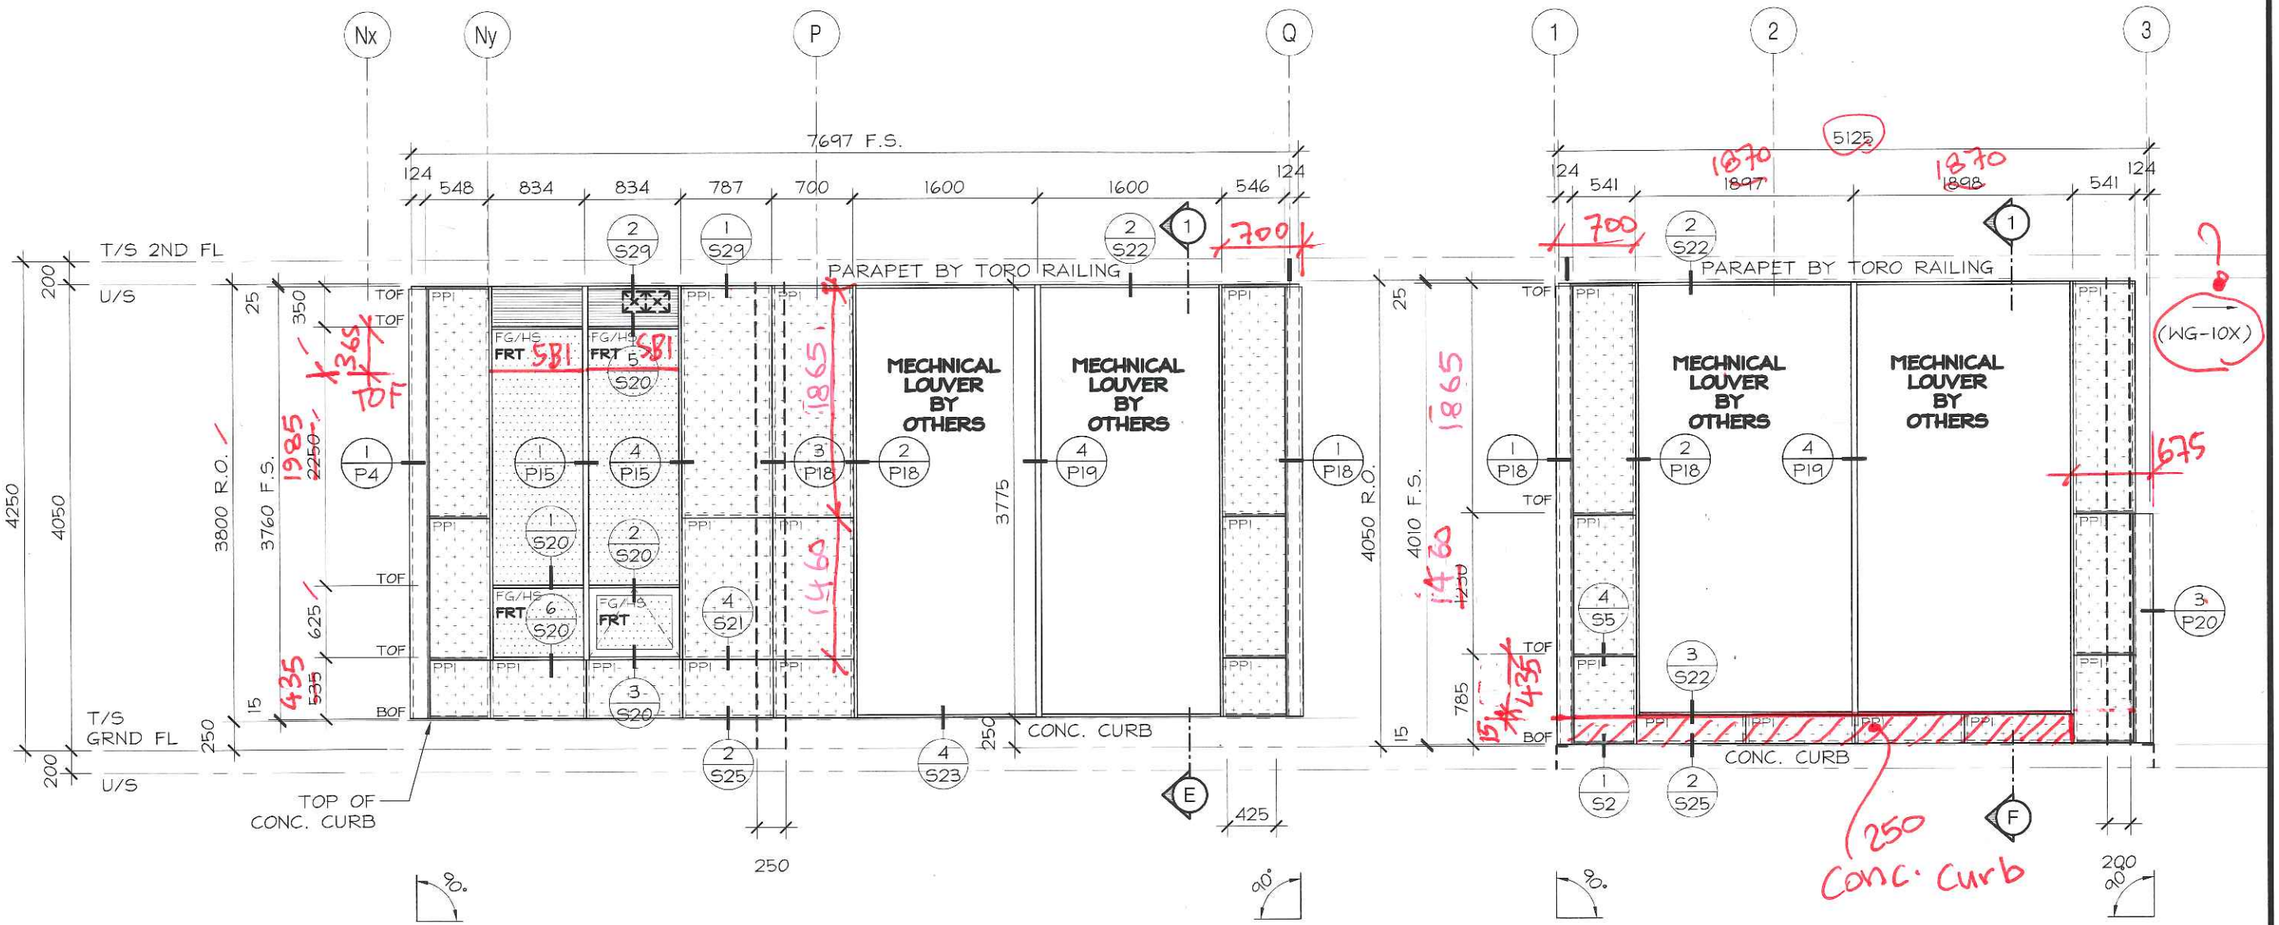

WG-09 | 1 REQUIRED
2587 SERIES
2487 SERIES


WG-10 | 1 REQUIRED
2587 SERIES
2487 SERIES

TORO ALUMINUM
COMMERCIAL INDUSTRIAL RESIDENTIAL
330 APPLEWOOD CRESCENT
CONCORD, ON, CANADA
L4K 4V2
TEL: (905)738-5220
FAX: (905)738-5481
WWW.TOROALUMINUM.COM

LICENSED PROFESSIONAL ENGINEER
06-27-15
D.T. PROHASKA
3754901
PROVINCE OF ONTARIO

No.	REVISION	BY	DATE

PROJECT NAME: SQ ALEXANDRA PARK - BLOCK11
DRAWING TITLE: GROUND FLOOR ELEVATIONS
ARCHITECT: TEEPLE ARCHITECTS
CONTRACTOR: TRIDEL
SCALE: 1:50
DRAWN BY: S.C.
DATE: MARCH 4, 2015
DRAWING No.: EG-6

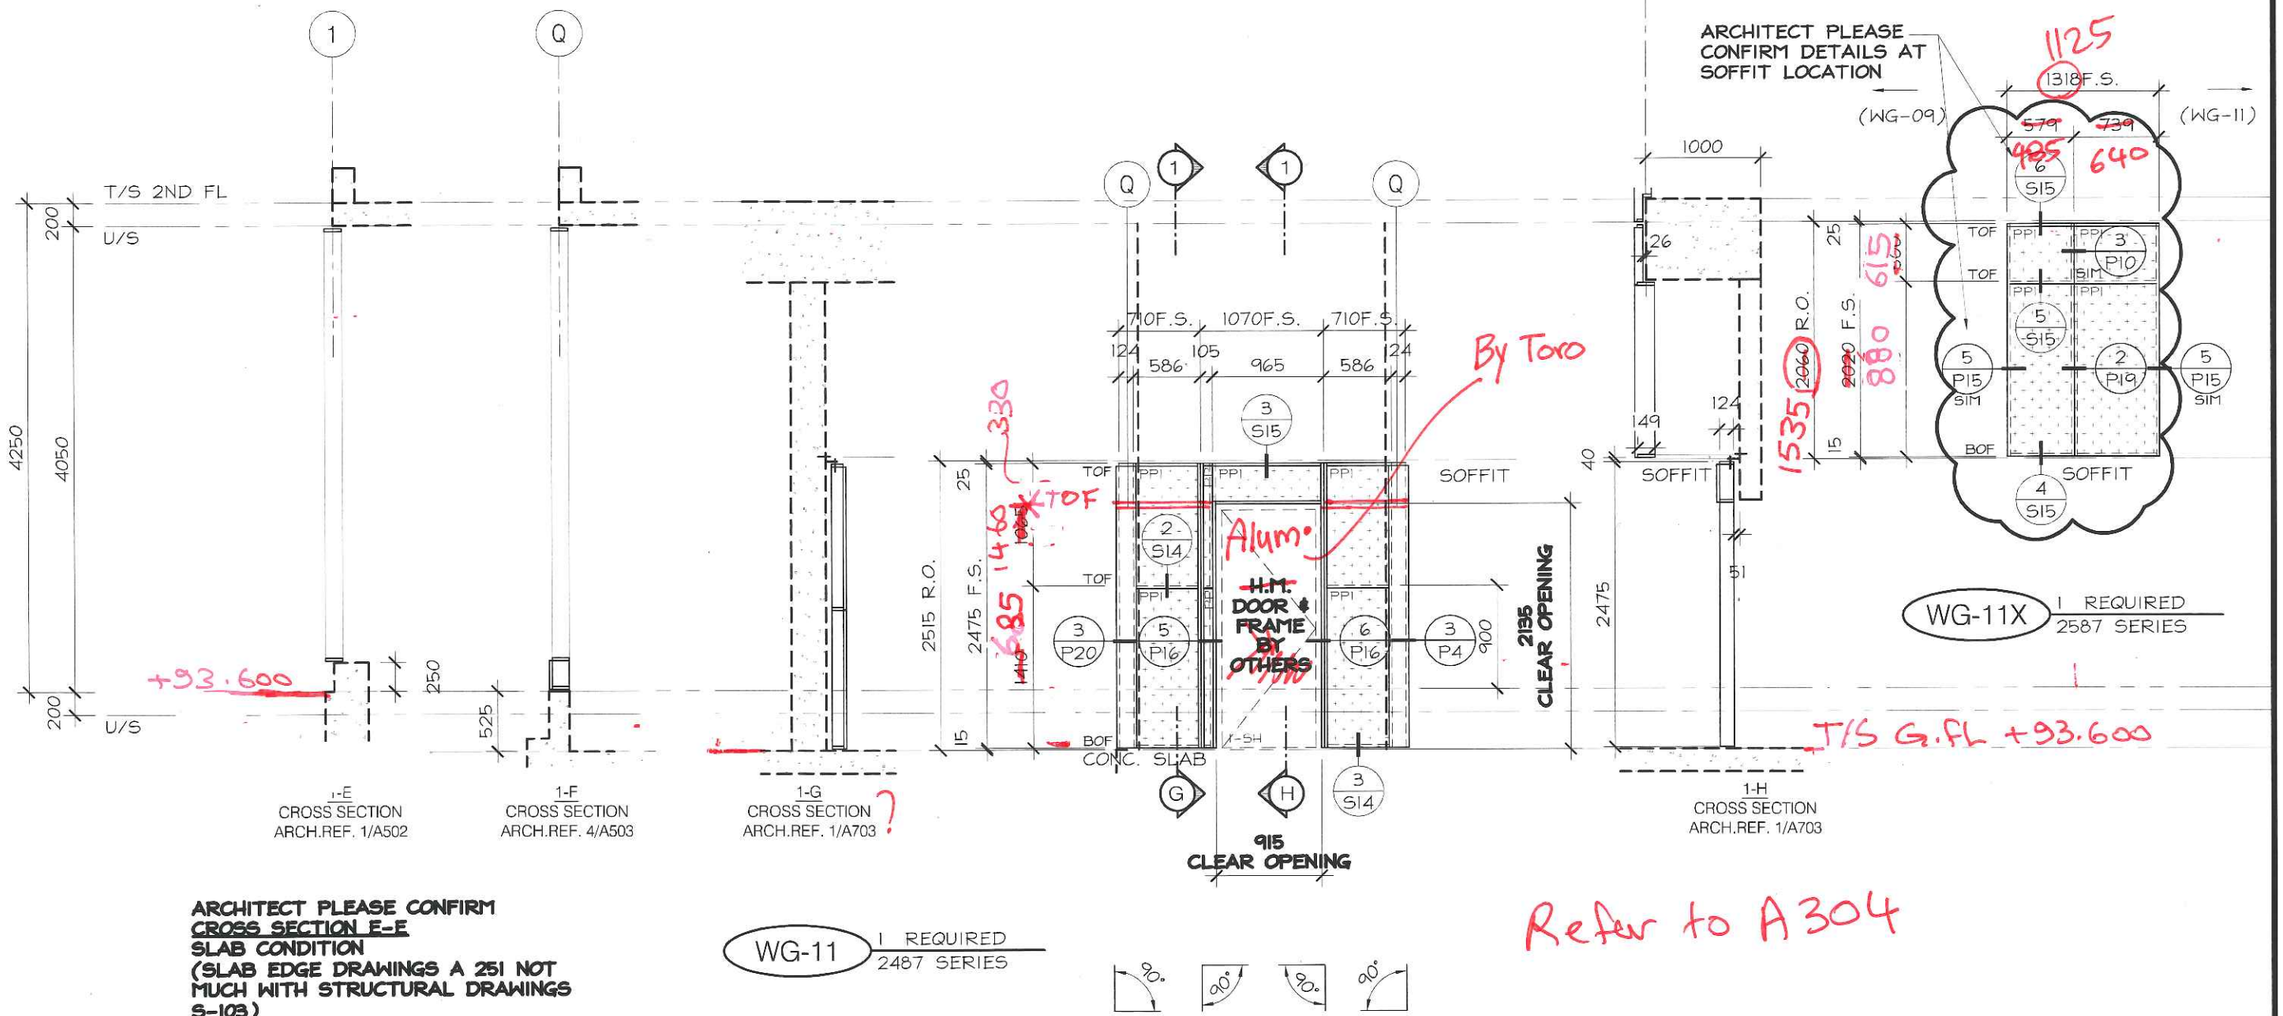

ARCHITECT PLEASE CONFIRM
CROSS SECTION E-E
SLAB CONDITION
(SLAB EDGE DRAWINGS A 251 NOT MUCH WITH STRUCTURAL DRAWINGS S-103)


Refer to A304

TORO ALUMINUM
COMMERCIAL INDUSTRIAL RESIDENTIAL
330 APPLEWOOD CRESCENT
CONCORD, ON, CANADA
L4K 4V2
TEL: (905)738-5220
FAX: (905)738-5481
WWW.TOROALUMINUM.COM

LICENSED PROFESSIONAL ENGINEER
06-27-15
D.T. PROHASKA
37549014
PROVINCE OF ONTARIO

No.	REVISION	BY	DATE

PROJECT NAME:	SQ ALEXANDRA PARK - BLOCK11
DRAWING TITLE:	GROUND FLOOR ELEVATIONS
ARCHITECT:	TEEPLE ARCHITECTS
CONTRACTOR:	TRIDEL
SCALE: 1:50	DRAWN BY: S.C.
DATE: MARCH 4, 2015	
DRAWING No.:	EG-7

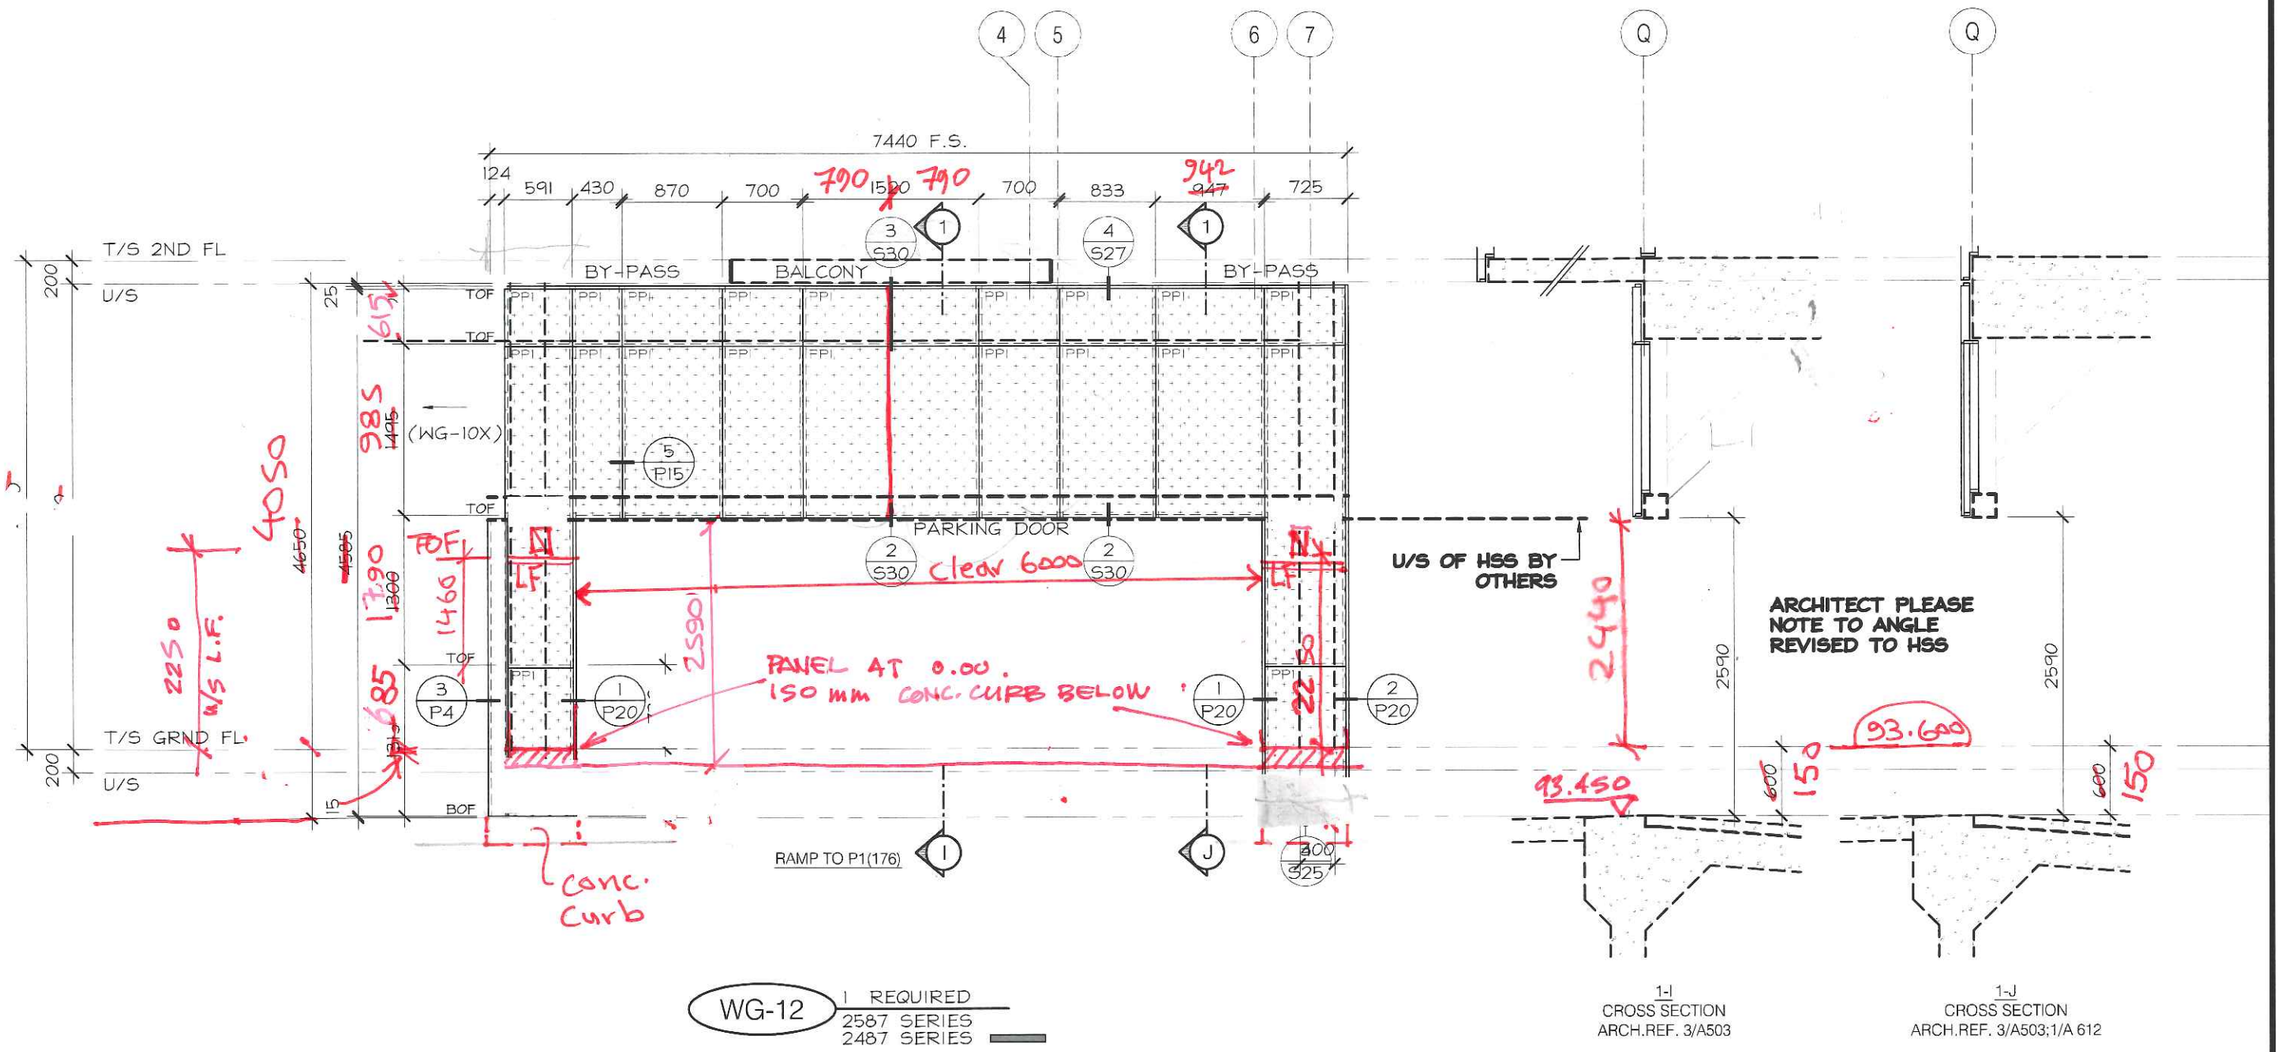

WG-12 — 1 REQUIRED
2587 SERIES
2487 SERIES

1-I
CROSS SECTION
ARCH.REF. 3/A503


1-J
CROSS SECTION
ARCH.REF. 3/A503;1/A 612

TORO ALUMINUM
COMMERCIAL INDUSTRIAL RESIDENTIAL
330 APPLEWOOD CRESCENT
CONCORD, ON, CANADA
L4K 4V2
TEL: (905)738-5220
FAX: (905)738-5481
WWW.TOROALUMINUM.COM

LICENSED PROFESSIONAL ENGINEER
06-27-15
D.T. PROHASKA
3754901
PROVINCE OF ONTARIO

No.	REVISION	BY	DATE

PROJECT NAME: SQ ALEXANDRA PARK - BLOCK11
DRAWING TITLE: GROUND FLOOR ELEVATIONS
ARCHITECT: TEEPLE ARCHITECTS
CONTRACTOR: TRIDEL
SCALE: 1:50
DRAWN BY: S.C.
DATE: MARCH 4, 2015
DRAWING No.: EG-8

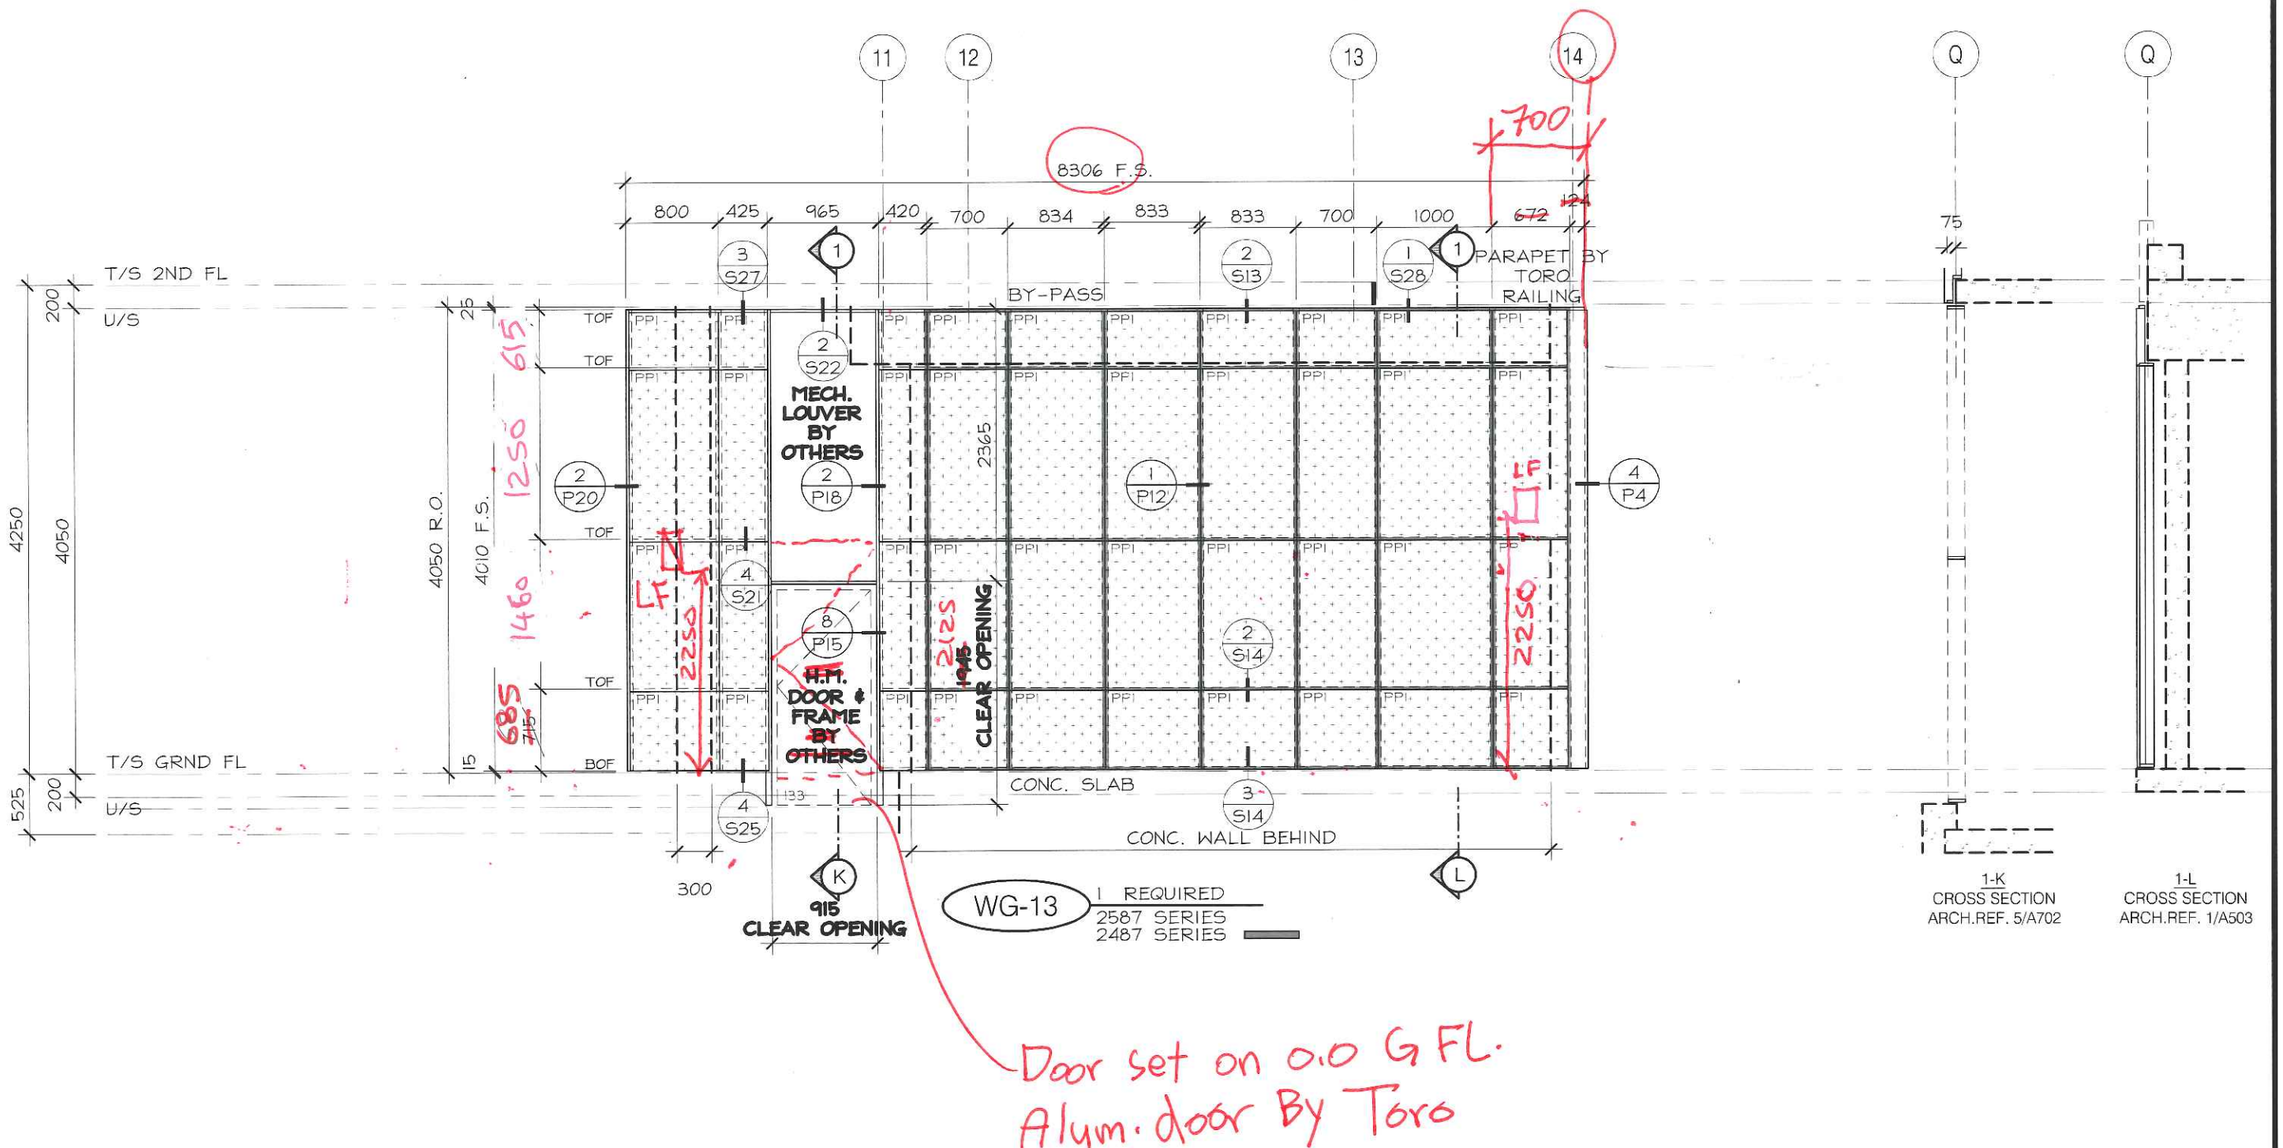


Door set on 0.0 G FL.
Alum. door By Toro

TORO ALUMINUM
COMMERCIAL INDUSTRIAL RESIDENTIAL
330 APPLEWOOD CRESCENT
CONCORD, ON, CANADA
L4K 4V2
TEL: (905)738-5220
FAX: (905)738-5481
WWW.TOROALUMINUM.COM

LICENSED PROFESSIONAL ENGINEER
06-27-15
D.T. PROHASKA
37549014
PROVINCE OF ONTARIO

No.	REVISION	BY	DATE

PROJECT NAME:	SQ ALEXANDRA PARK - BLOCK11
DRAWING TITLE:	GROUND FLOOR ELEVATIONS
ARCHITECT:	TEEPLE ARCHITECTS
CONTRACTOR:	TRIDEL
SCALE:	1:50
DRAWN BY:	S.C.
DATE:	MARCH 4, 2015
DRAWING No.:	EG-9

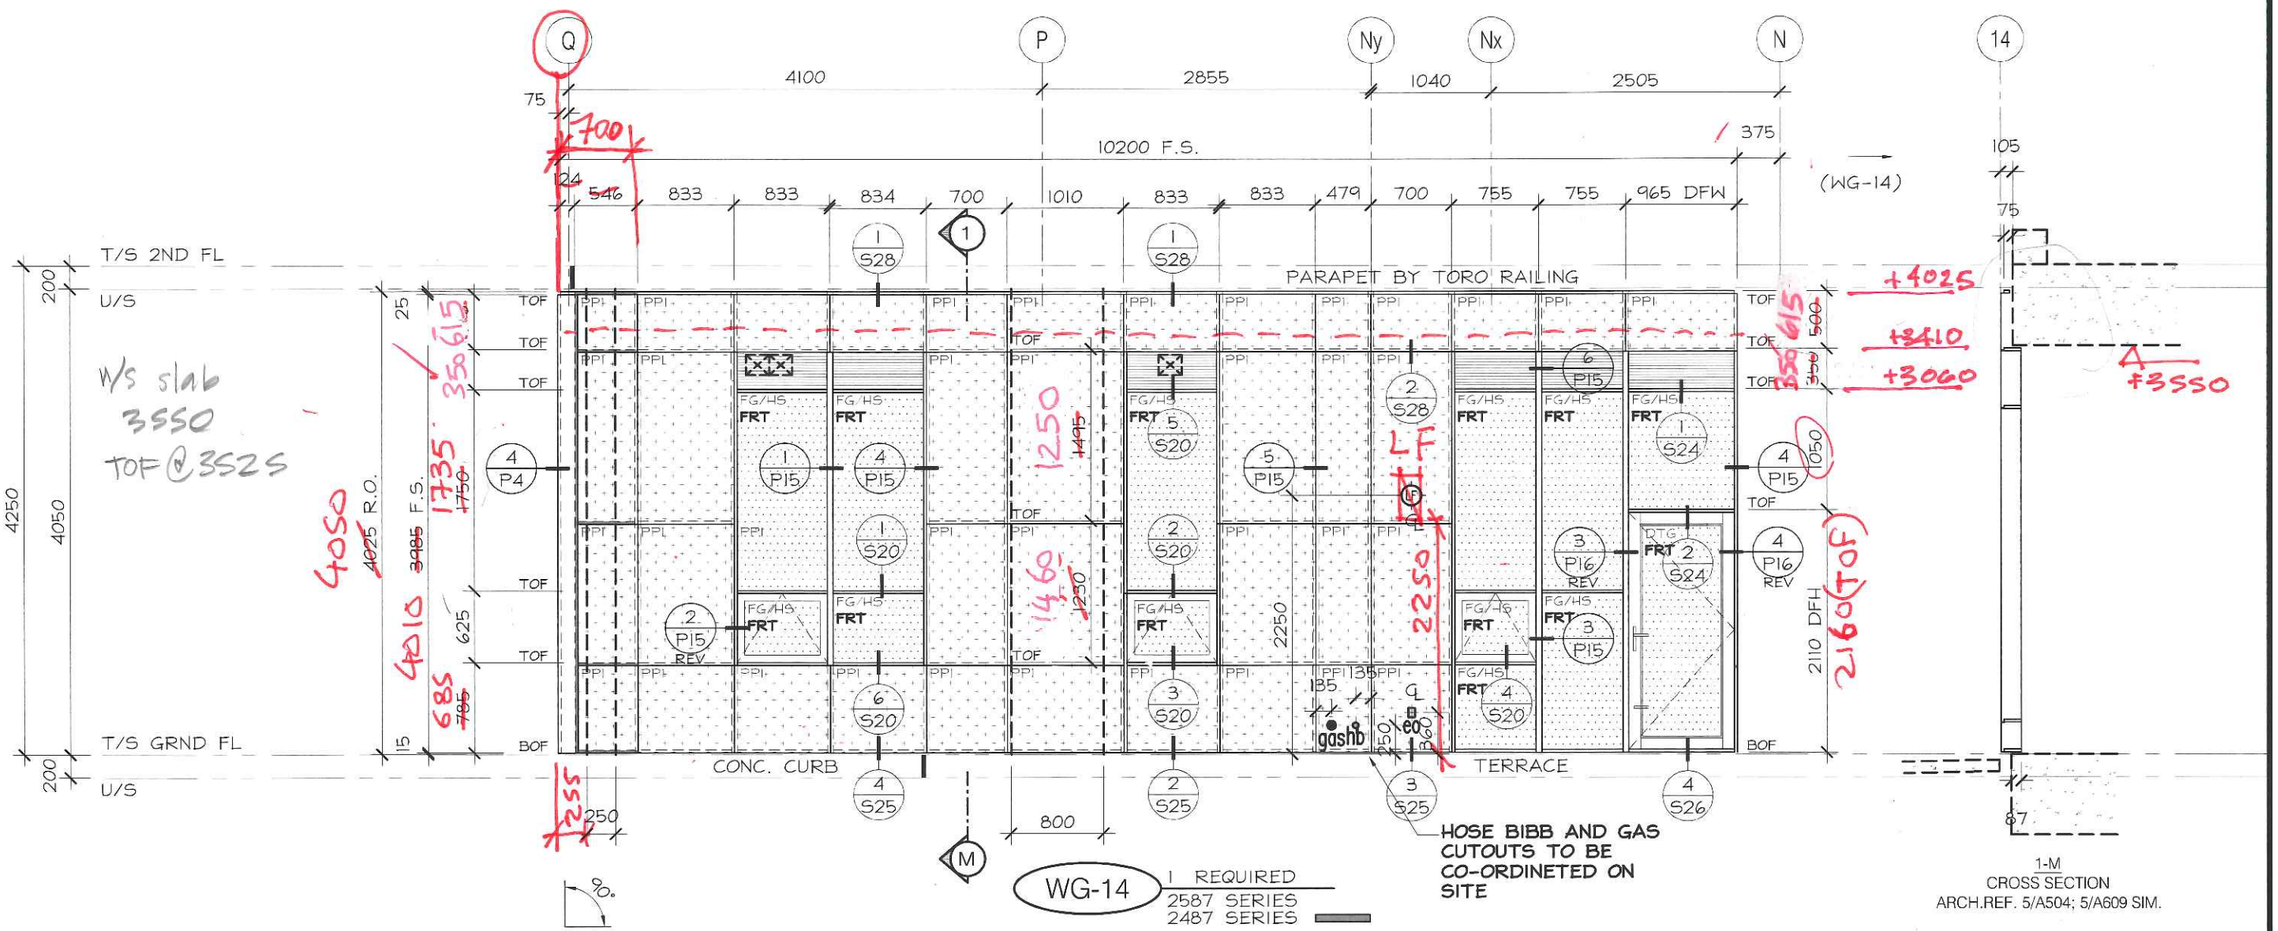


TORO ALUMINUM
COMMERCIAL INDUSTRIAL RESIDENTIAL
330 APPLEWOOD CRESCENT
CONCORD, ON, CANADA
L4K 4V2
TEL: (905)738-5220
FAX: (905)738-5481
WWW.TOROALUMINUM.COM

LICENSED PROFESSIONAL ENGINEER
06-27-15
D.T. PROHASKA
PROVINCE OF ONTARIO

No.	REVISION	BY	DATE

PROJECT NAME:	SQ ALEXANDRA PARK - BLOCK11
DRAWING TITLE:	GROUND FLOOR ELEVATIONS
ARCHITECT:	TEEPLE ARCHITECTS
CONTRACTOR:	TRIDEL
SCALE: 1:50	DRAWN BY: S.C.
DATE: MARCH 4, 2015	DRAWING No.: EG-10

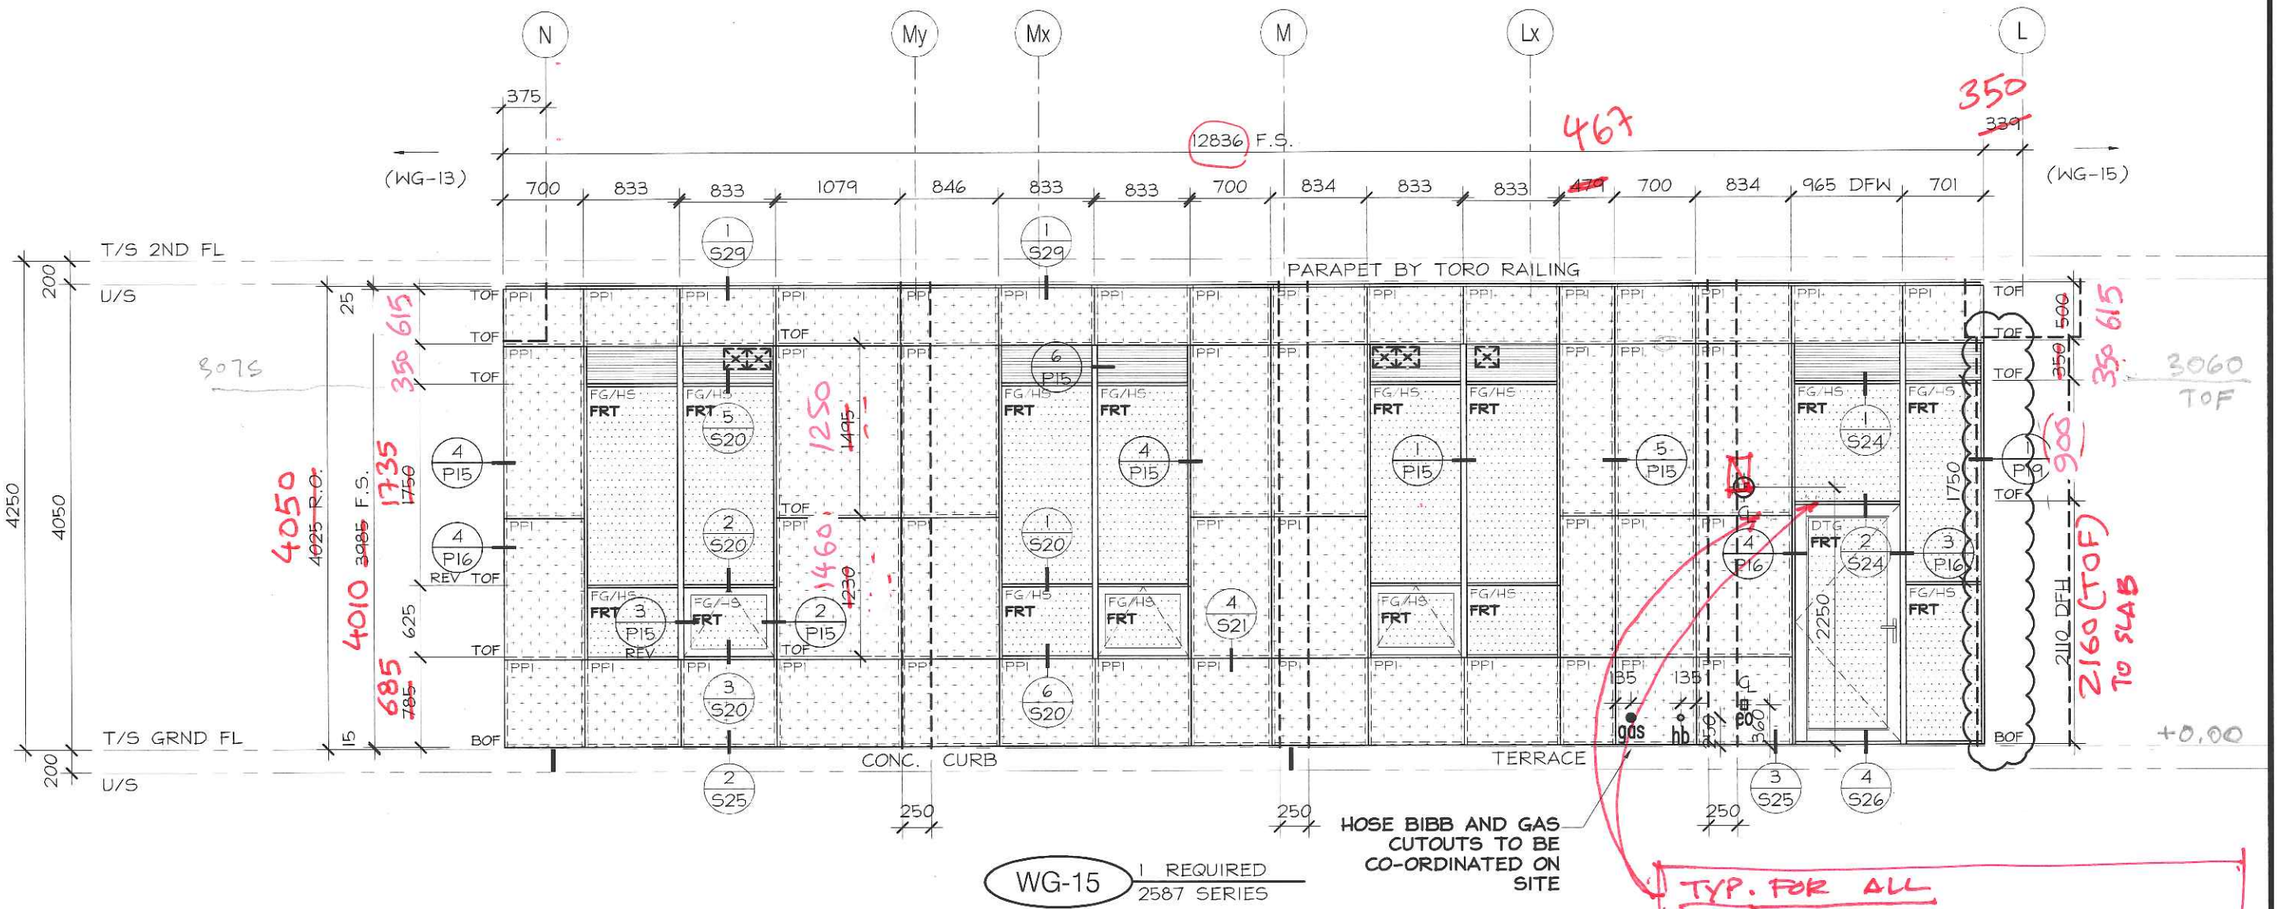

TYP. FOR ALL


THE DESIGN INTENTION IS THAT BALCONY & PATIO DOORS ARE NOMINALLY 2135 (7'-0") TALL U.N.O., AND THAT ADJACENT FRAMES & PANELS ALIGN W/ DOOR HEAD. T.O.F. NOTED AS 2160 mm TO SLAB TYP. U.N.O.

TORO ALUMINUM
COMMERCIAL INDUSTRIAL RESIDENTIAL
330 APPLEWOOD CRESCENT
CONCORD, ON, CANADA
L4K 4V2
TEL: (905)738-5220
FAX: (905)738-5481
WWW.TOROALUMINUM.COM

LICENSED PROFESSIONAL ENGINEER 06-27-15 D.T. PROHASKA 3754901 PROVINCE OF ONTARIO

No.	REVISION	BY	DATE

PROJECT NAME:	SQ ALE
DRAWING TITLE:	GROUN
ARCHITECT:	TEEPLE ARCHITECTS
CONTRACTOR:	TRIDEL
SCALE: 1:50	DRAWN BY: S.C.
DATE: MARCH 4, 2015	DRAWING No.: EG-11

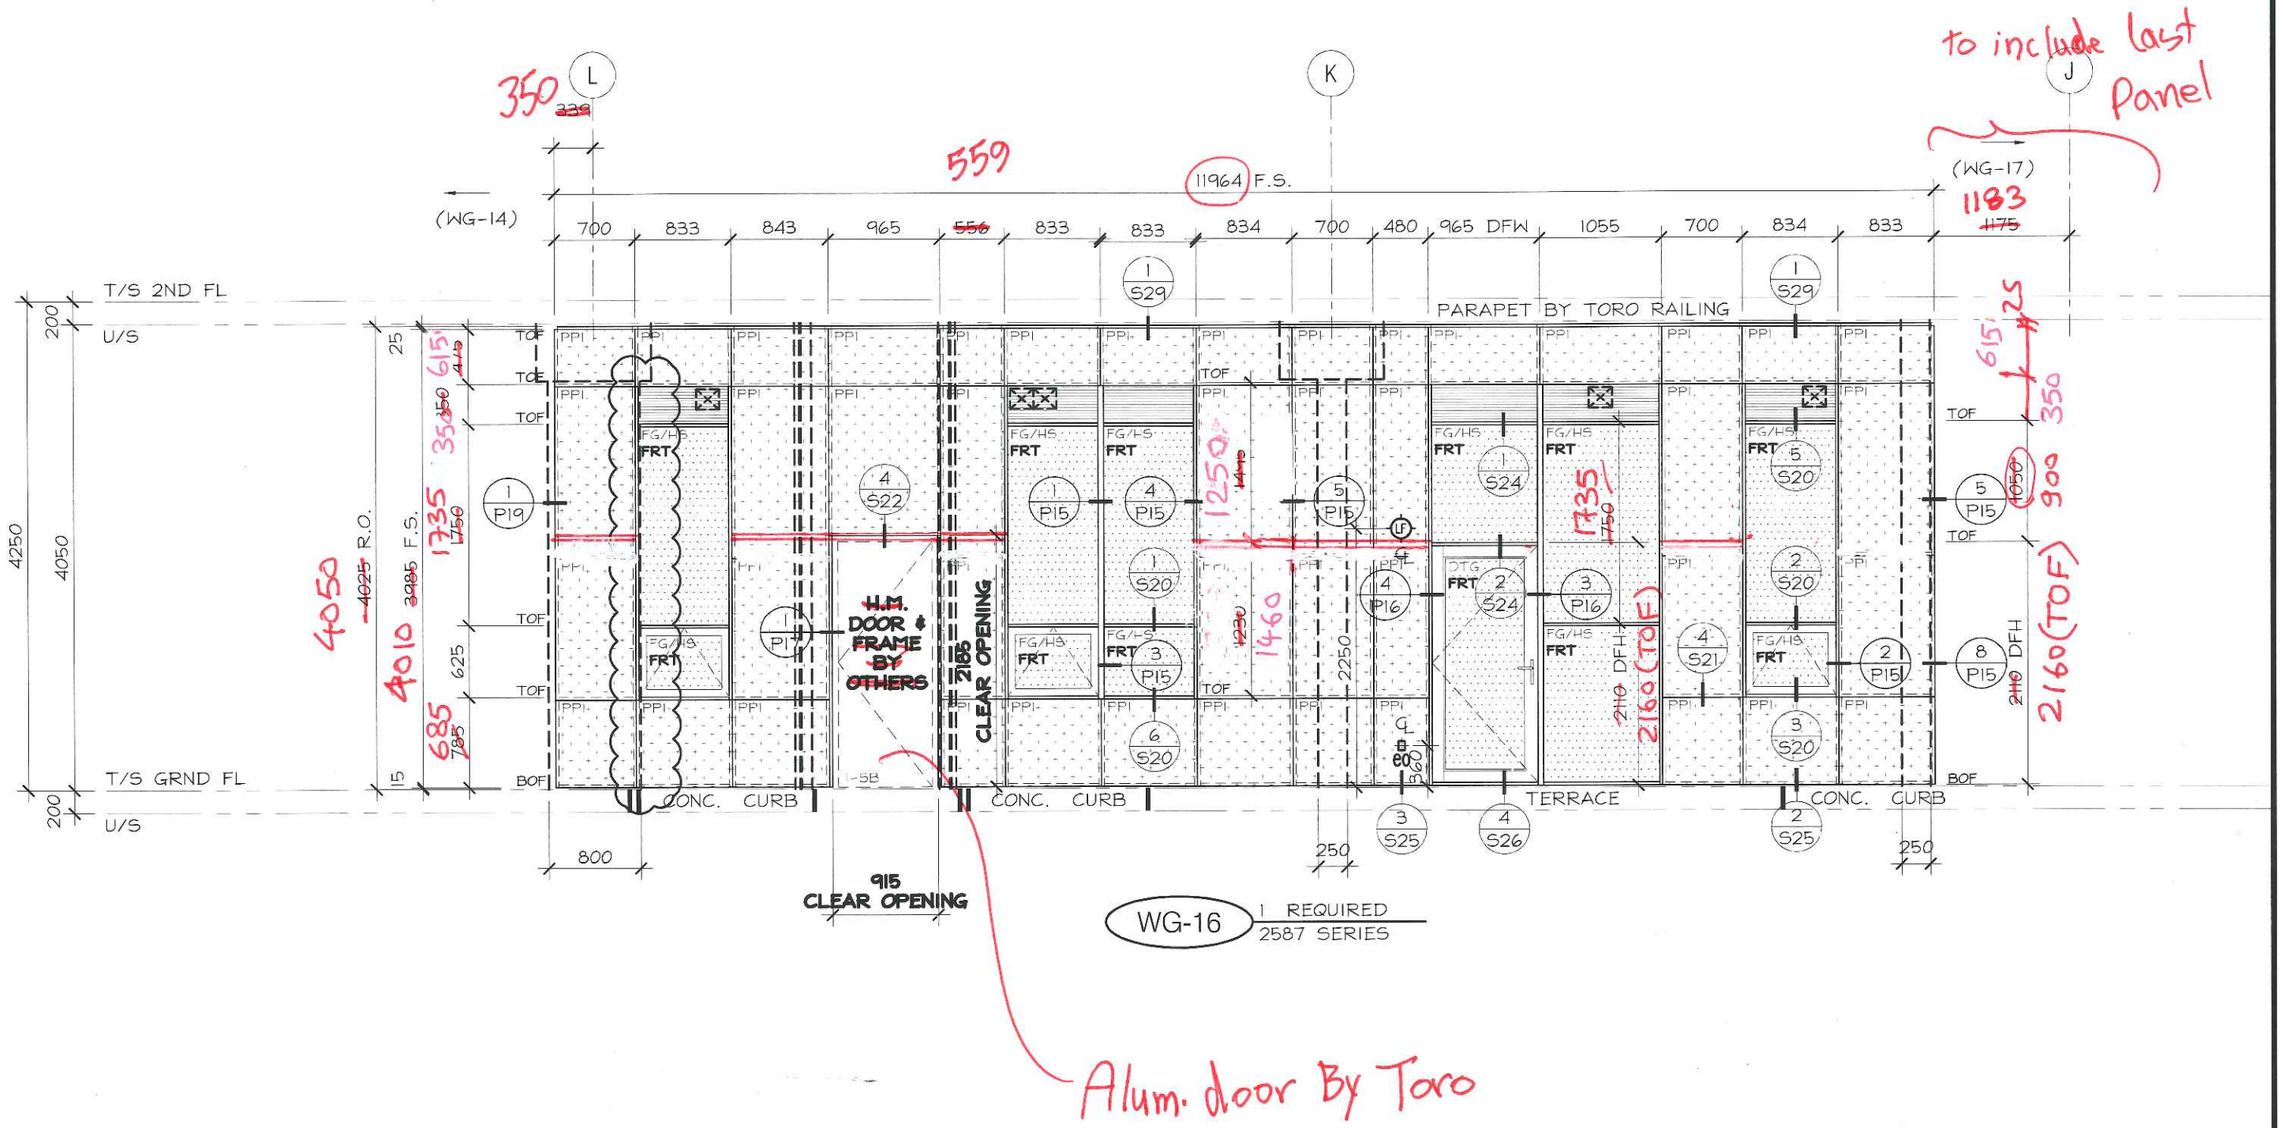


PROJECT NAME:	SQ ALEXANDRA PARK - BLOCK11
DRAWING TITLE:	GROUND FLOOR ELEVATIONS
ARCHITECT:	TEEPLE ARCHITECTS
CONTRACTOR:	TRIDEL
SCALE:	1:50
DRAWN BY:	S.C.
DATE:	MARCH 4, 2015
DRAWING No.:	EG-12

TORO ALUMINUM
COMMERCIAL INDUSTRIAL RESIDENTIAL
330 APPLEWOOD CRESCENT
CONCORD, ON, CANADA
L4K 4V2
TEL: (905)738-5220
FAX: (905)738-5481
WWW.TOROALUMINUM.COM

LICENSED PROFESSIONAL ENGINEER 06-27-15 D.T. PROHASKA 3754901 PROVINCE OF ONTARIO

No.	REVISION	BY	DATE

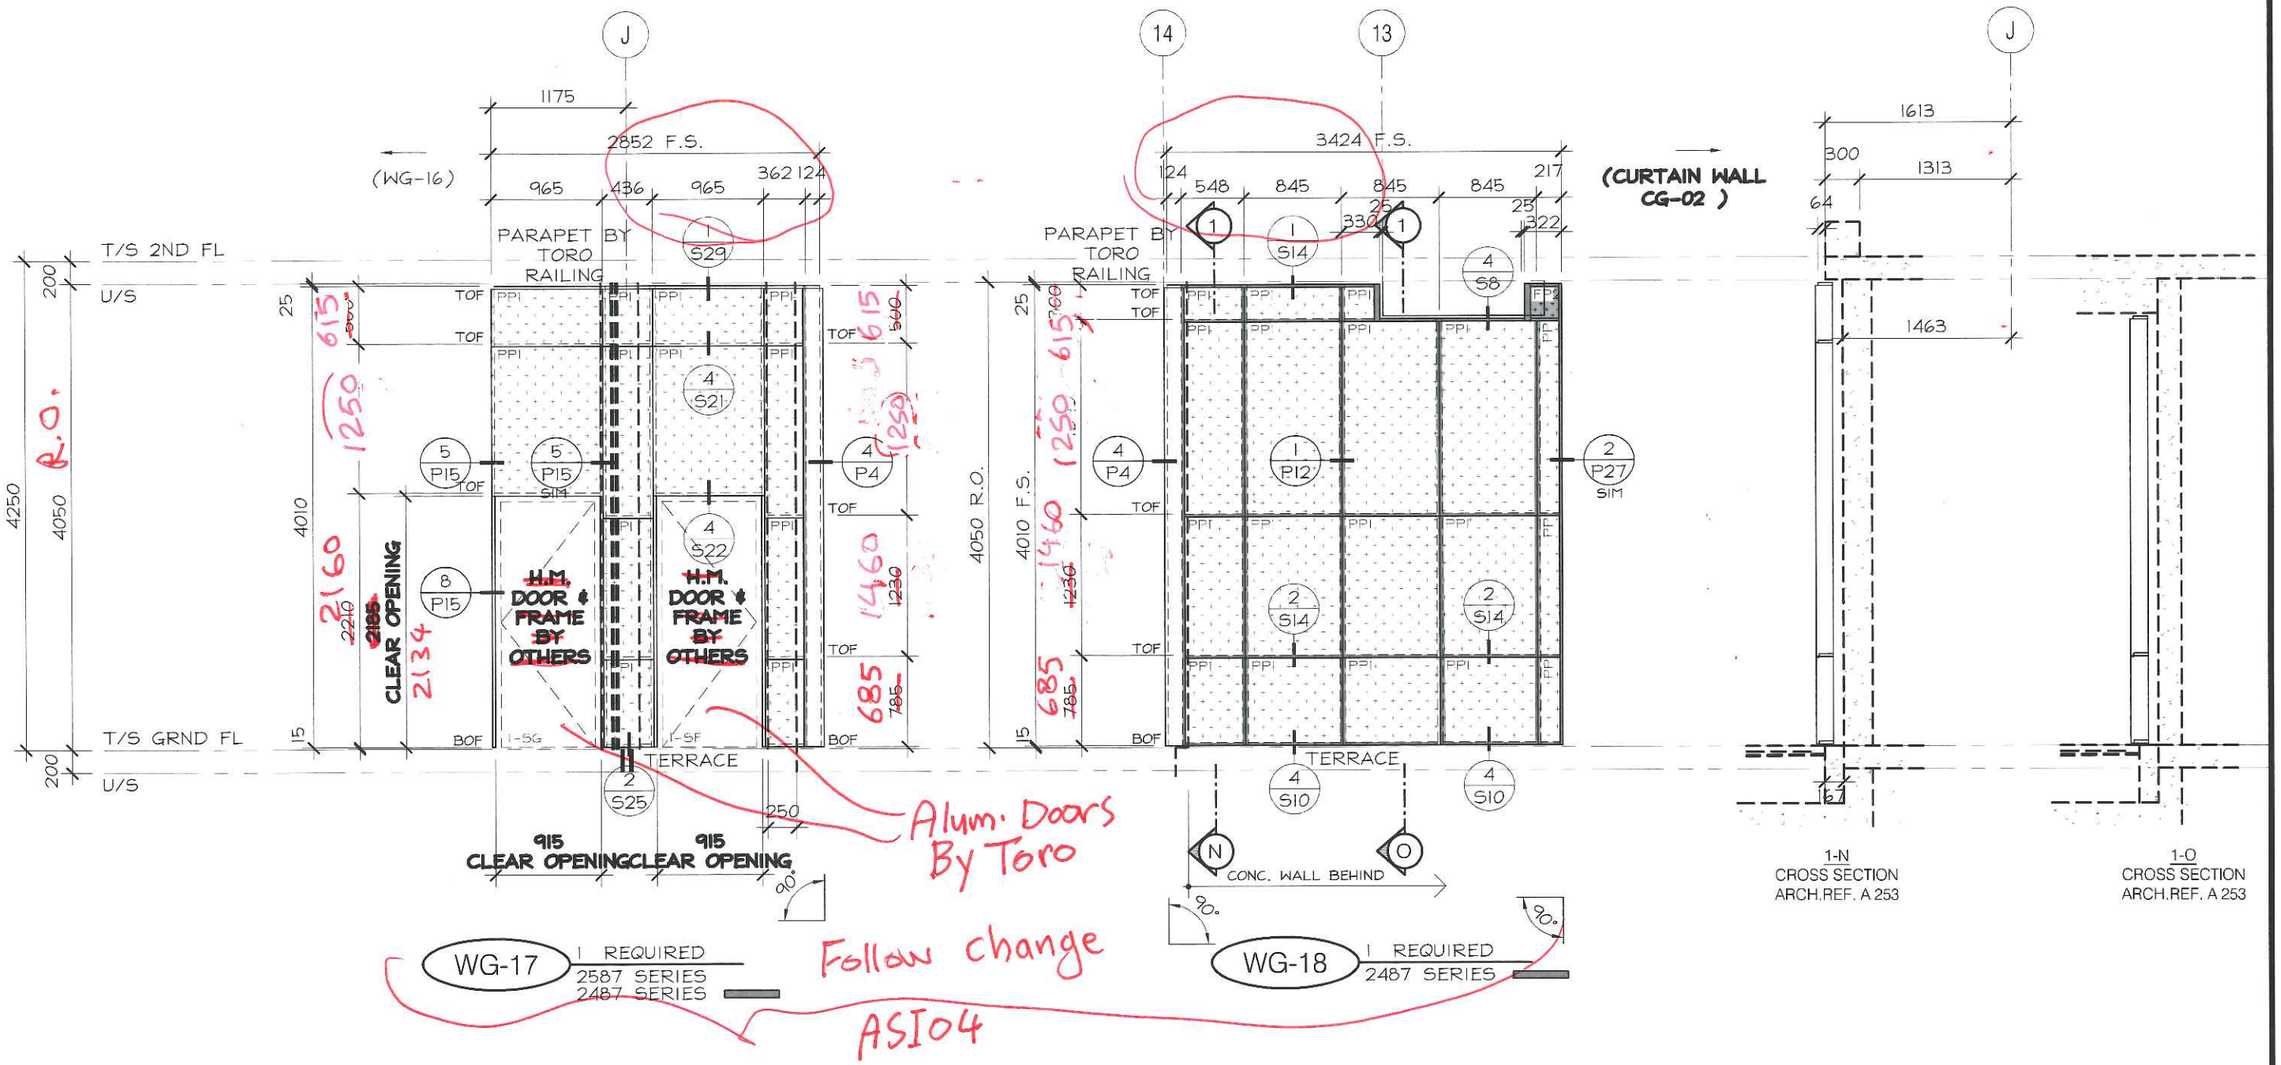


TORO ALUMINUM
COMMERCIAL INDUSTRIAL RESIDENTIAL
330 APPLEWOOD CRESCENT
CONCORD, ON, CANADA
L4K 4V2
TEL: (905)738-5220
FAX: (905)738-5481
WWW.TOROALUMINUM.COM

LICENSED PROFESSIONAL ENGINEER
06-27-15
D.T. PROHASKA
3754901
PROVINCE OF ONTARIO

No.	REVISION	BY	DATE

PROJECT NAME: SQ ALEXANDRA PARK - BLOCK11
DRAWING TITLE: GROUND FLOOR ELEVATIONS
ARCHITECT: TEEPLE ARCHITECTS
CONTRACTOR: TRIDEL
SCALE: 1:50
DRAWN BY: S.C.
DATE: MARCH 4, 2015
DRAWING No.: EG-13

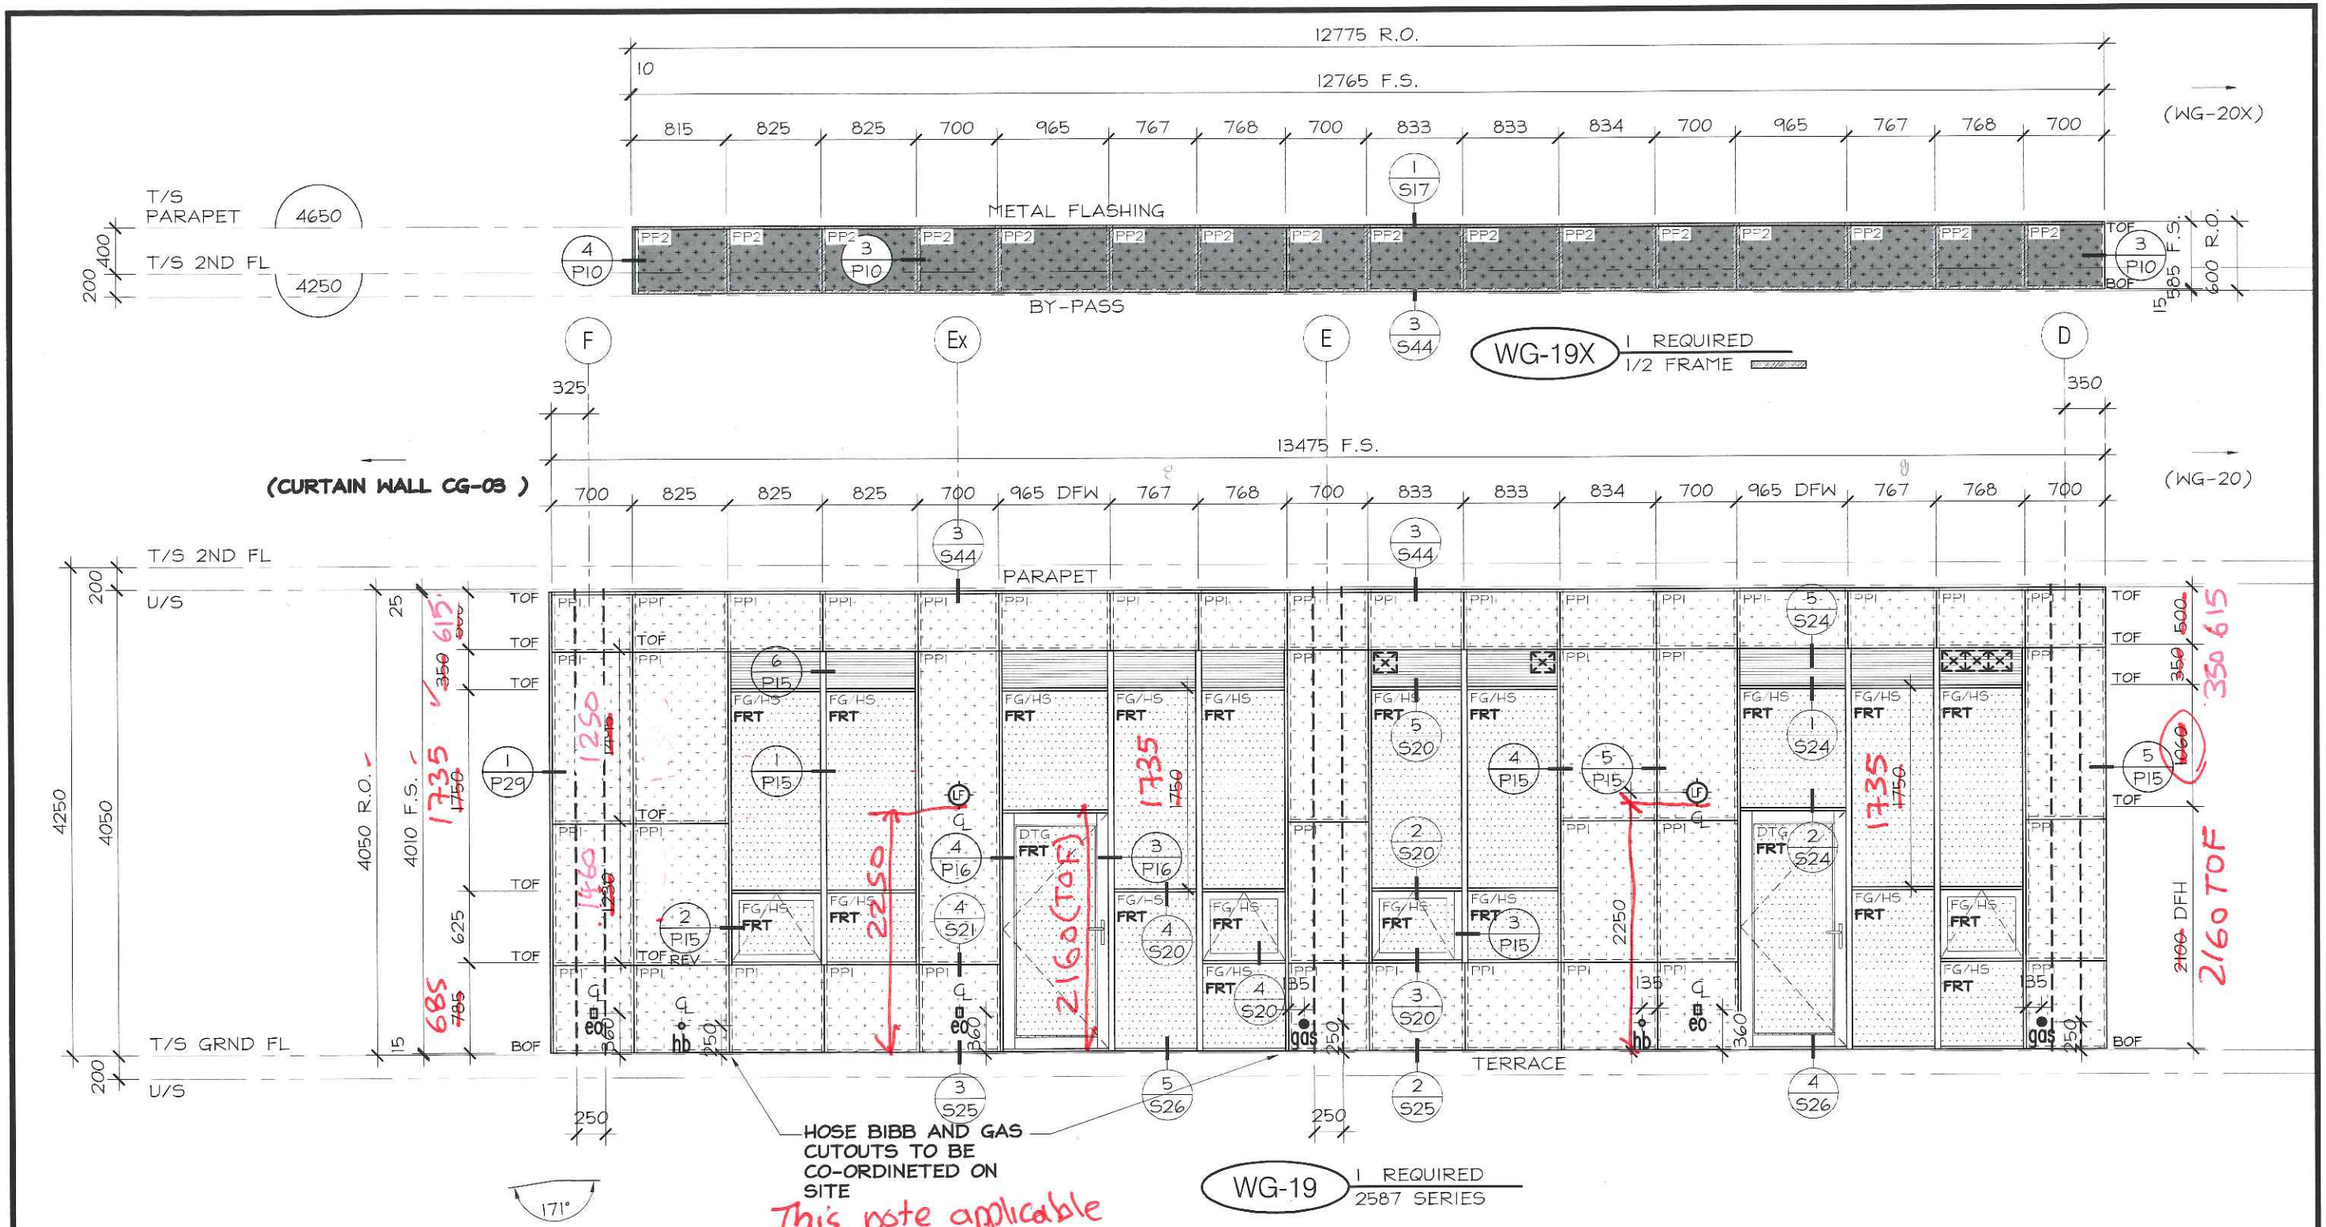


TORO ALUMINUM
COMMERCIAL INDUSTRIAL RESIDENTIAL
330 APPLEWOOD CRESCENT
CONCORD, ON, CANADA
L4K 4V2
TEL: (905)738-5220
FAX: (905)738-5481
WWW.TOROALUMINUM.COM

LICENSED PROFESSIONAL ENGINEER
06-27-15
D.T. PROHASKA
3754901
PROVINCE OF ONTARIO

No.	REVISION	BY	DATE

PROJECT NAME:	SQ ALEXANDRA PARK - BLOCK11
DRAWING TITLE:	GROUND FLOOR ELEVATIONS
ARCHITECT:	TEEPLE ARCHITECTS
CONTRACTOR:	TRIDEL
SCALE:	1:50
DRAWN BY:	S.C.
DATE:	MARCH 4, 2015
DRAWING No.:	EG-14

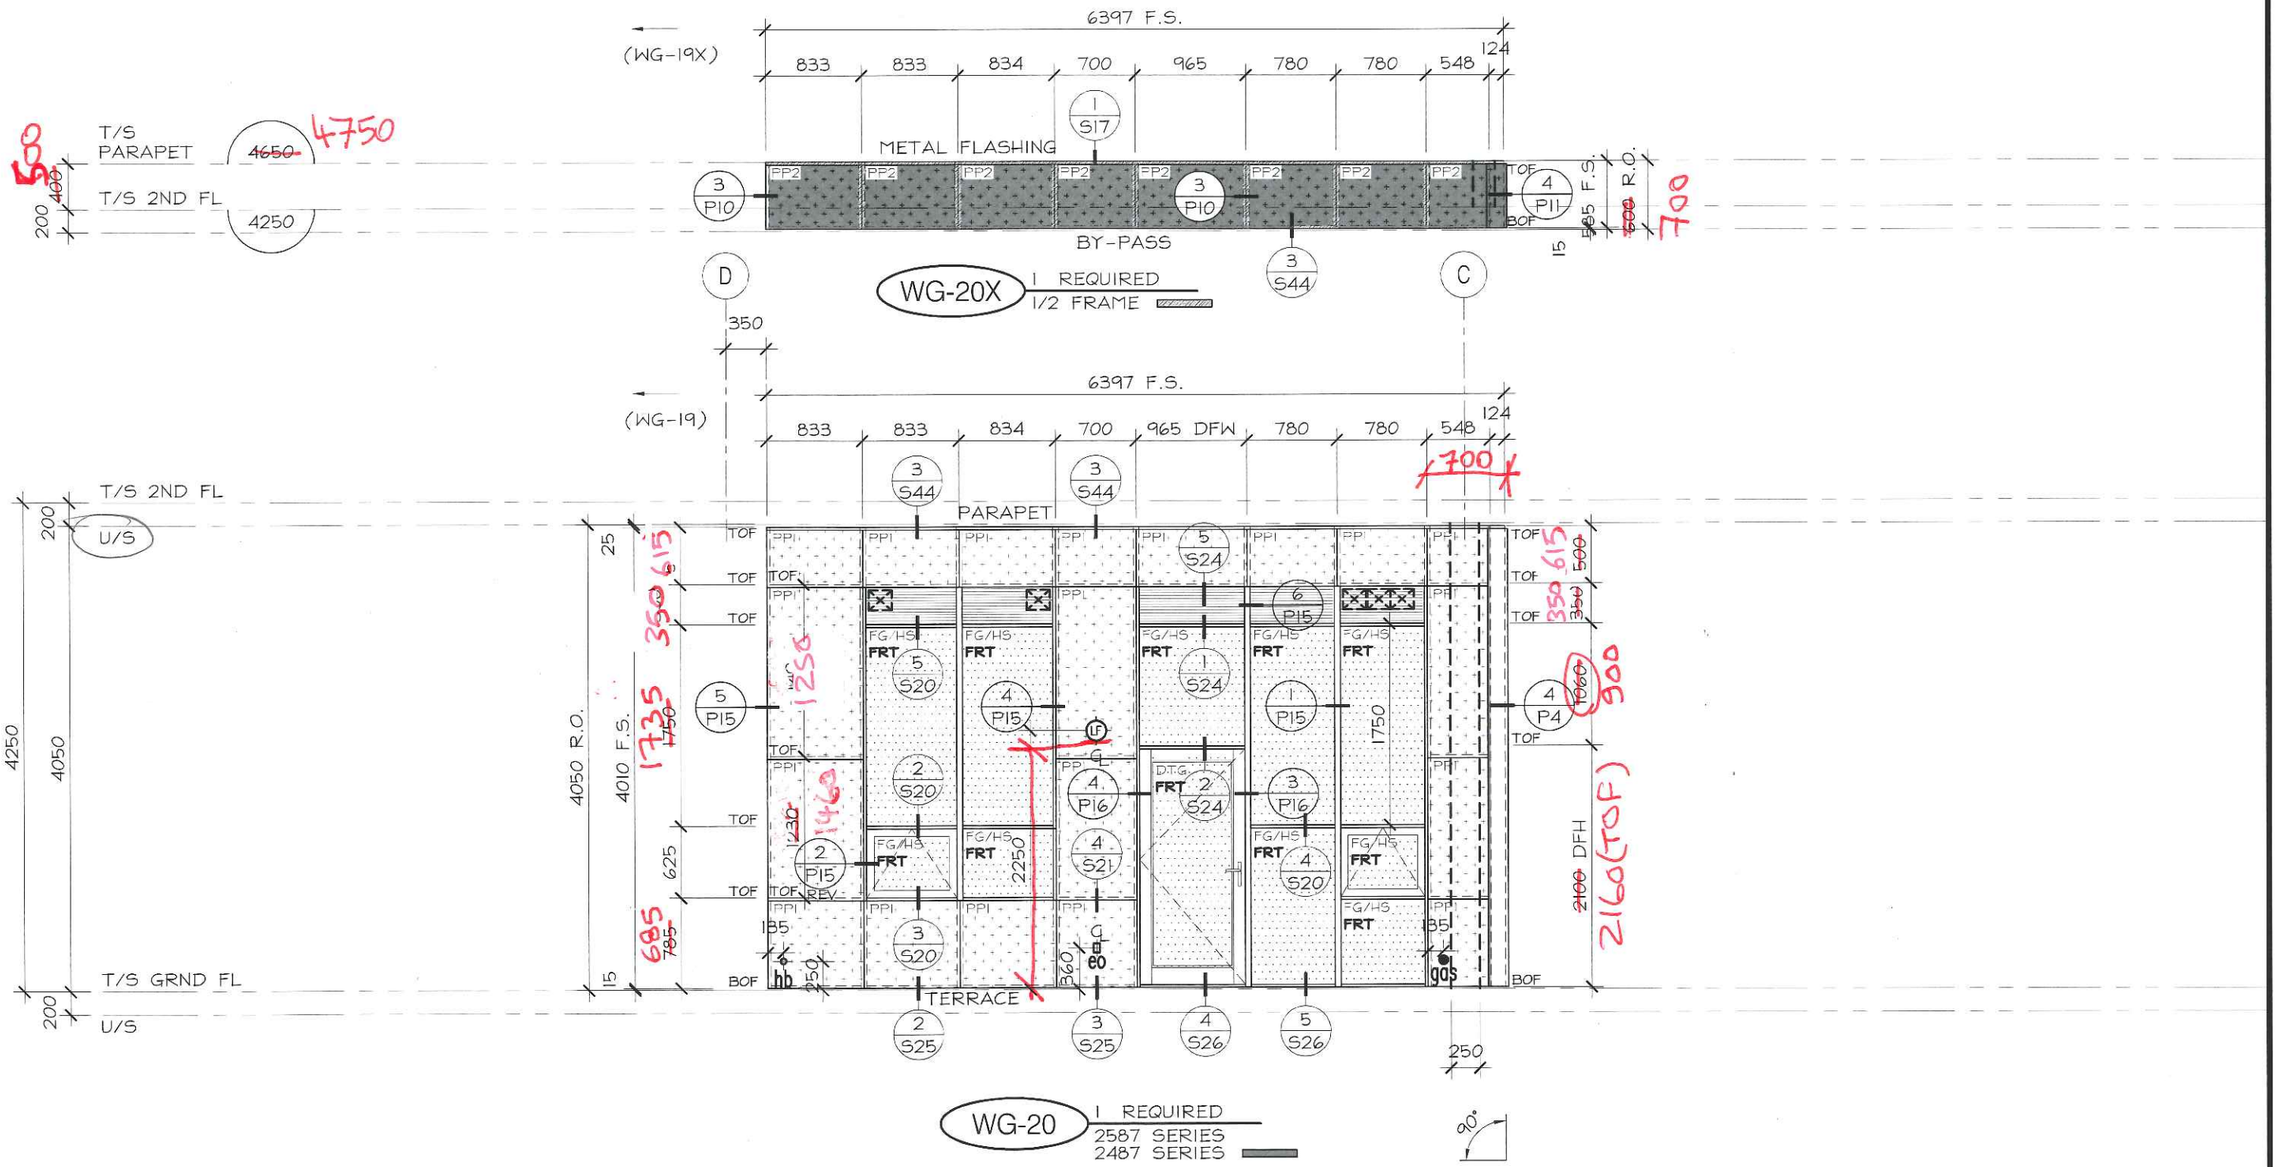


TORO ALUMINUM
COMMERCIAL INDUSTRIAL RESIDENTIAL
330 APPLEWOOD CRESCENT
CONCORD, ON, CANADA
L4K 4V2
TEL: (905)738-5220
FAX: (905)738-5481
WWW.TOROALUMINUM.COM

LICENSED PROFESSIONAL ENGINEER
06-27-15
D.T. PROHASKA
3754901
PROVINCE OF ONTARIO

No.	REVISION	BY	DATE

PROJECT NAME: SQ ALEXANDRA PARK - BLOCK11
DRAWING TITLE: GROUND FLOOR ELEVATIONS
ARCHITECT: TEEPLE ARCHITECTS
CONTRACTOR: TRIDEL
SCALE: 1:50
DRAWN BY: S.C.
DATE: MARCH 4, 2015
DRAWING No.: EG-15

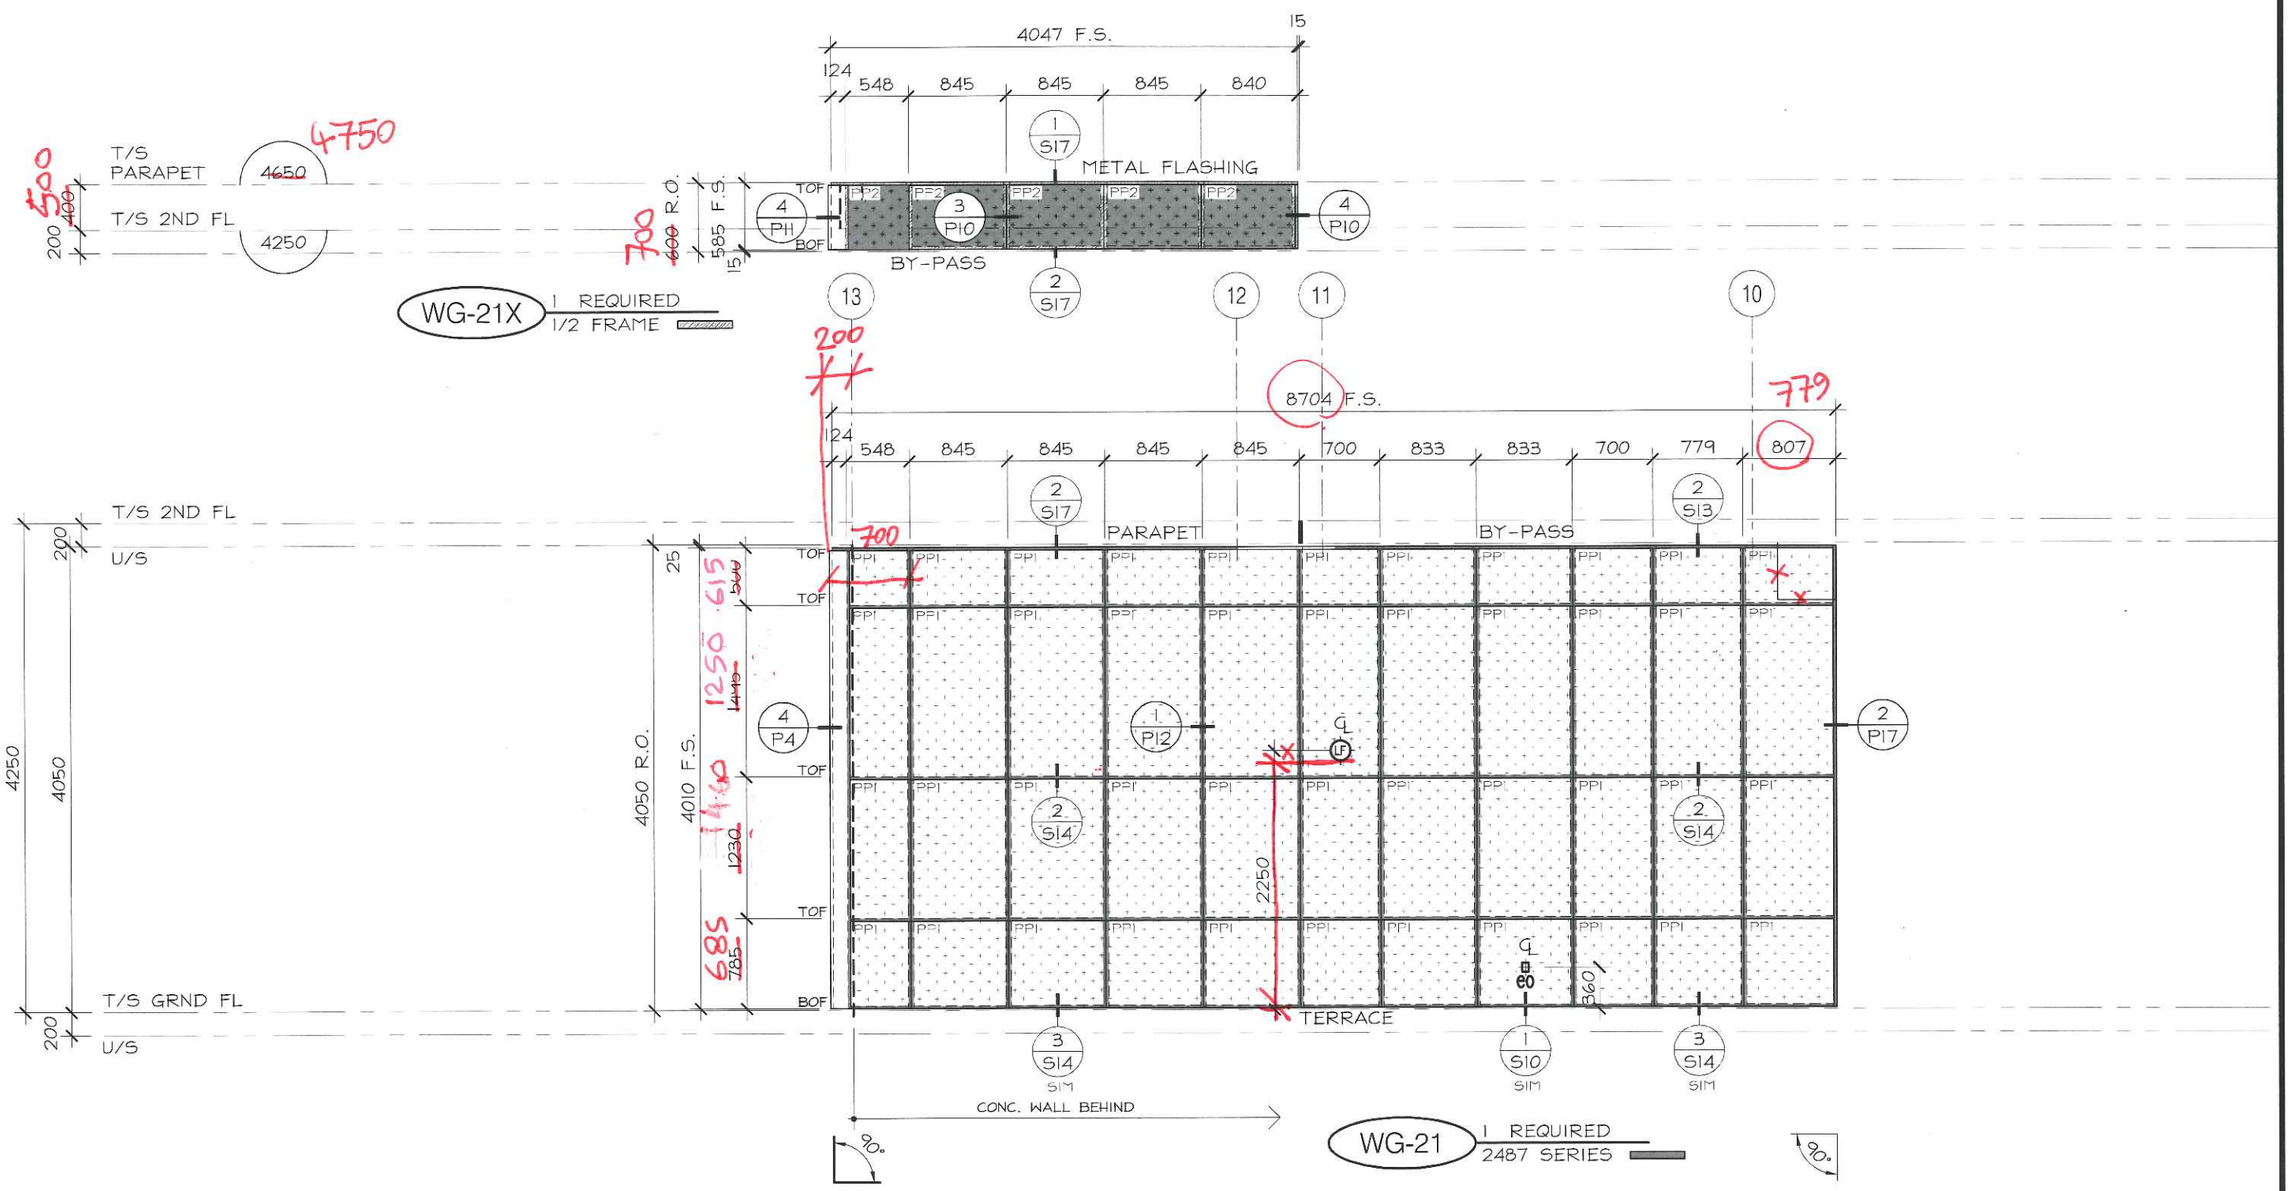


TORO ALUMINUM
COMMERCIAL INDUSTRIAL RESIDENTIAL
330 APPLEWOOD CRESCENT
CONCORD, ON, CANADA
L4K 4V2
TEL: (905)738-5220
FAX: (905)738-5481
WWW.TOROALUMINUM.COM

LICENSED PROFESSIONAL ENGINEER
06-27-15
D.T. PROHASKA
37549014
PROVINCE OF ONTARIO

No.	REVISION	BY	DATE

PROJECT NAME: SQ ALEXANDRA PARK - BLOCK11
DRAWING TITLE: GROUND FLOOR ELEVATIONS
ARCHITECT: TEEPLE ARCHITECTS
CONTRACTOR: TRIDEL
SCALE: 1:50
DRAWN BY: S.C.
DATE: MARCH 4, 2015
DRAWING No.: EG-16

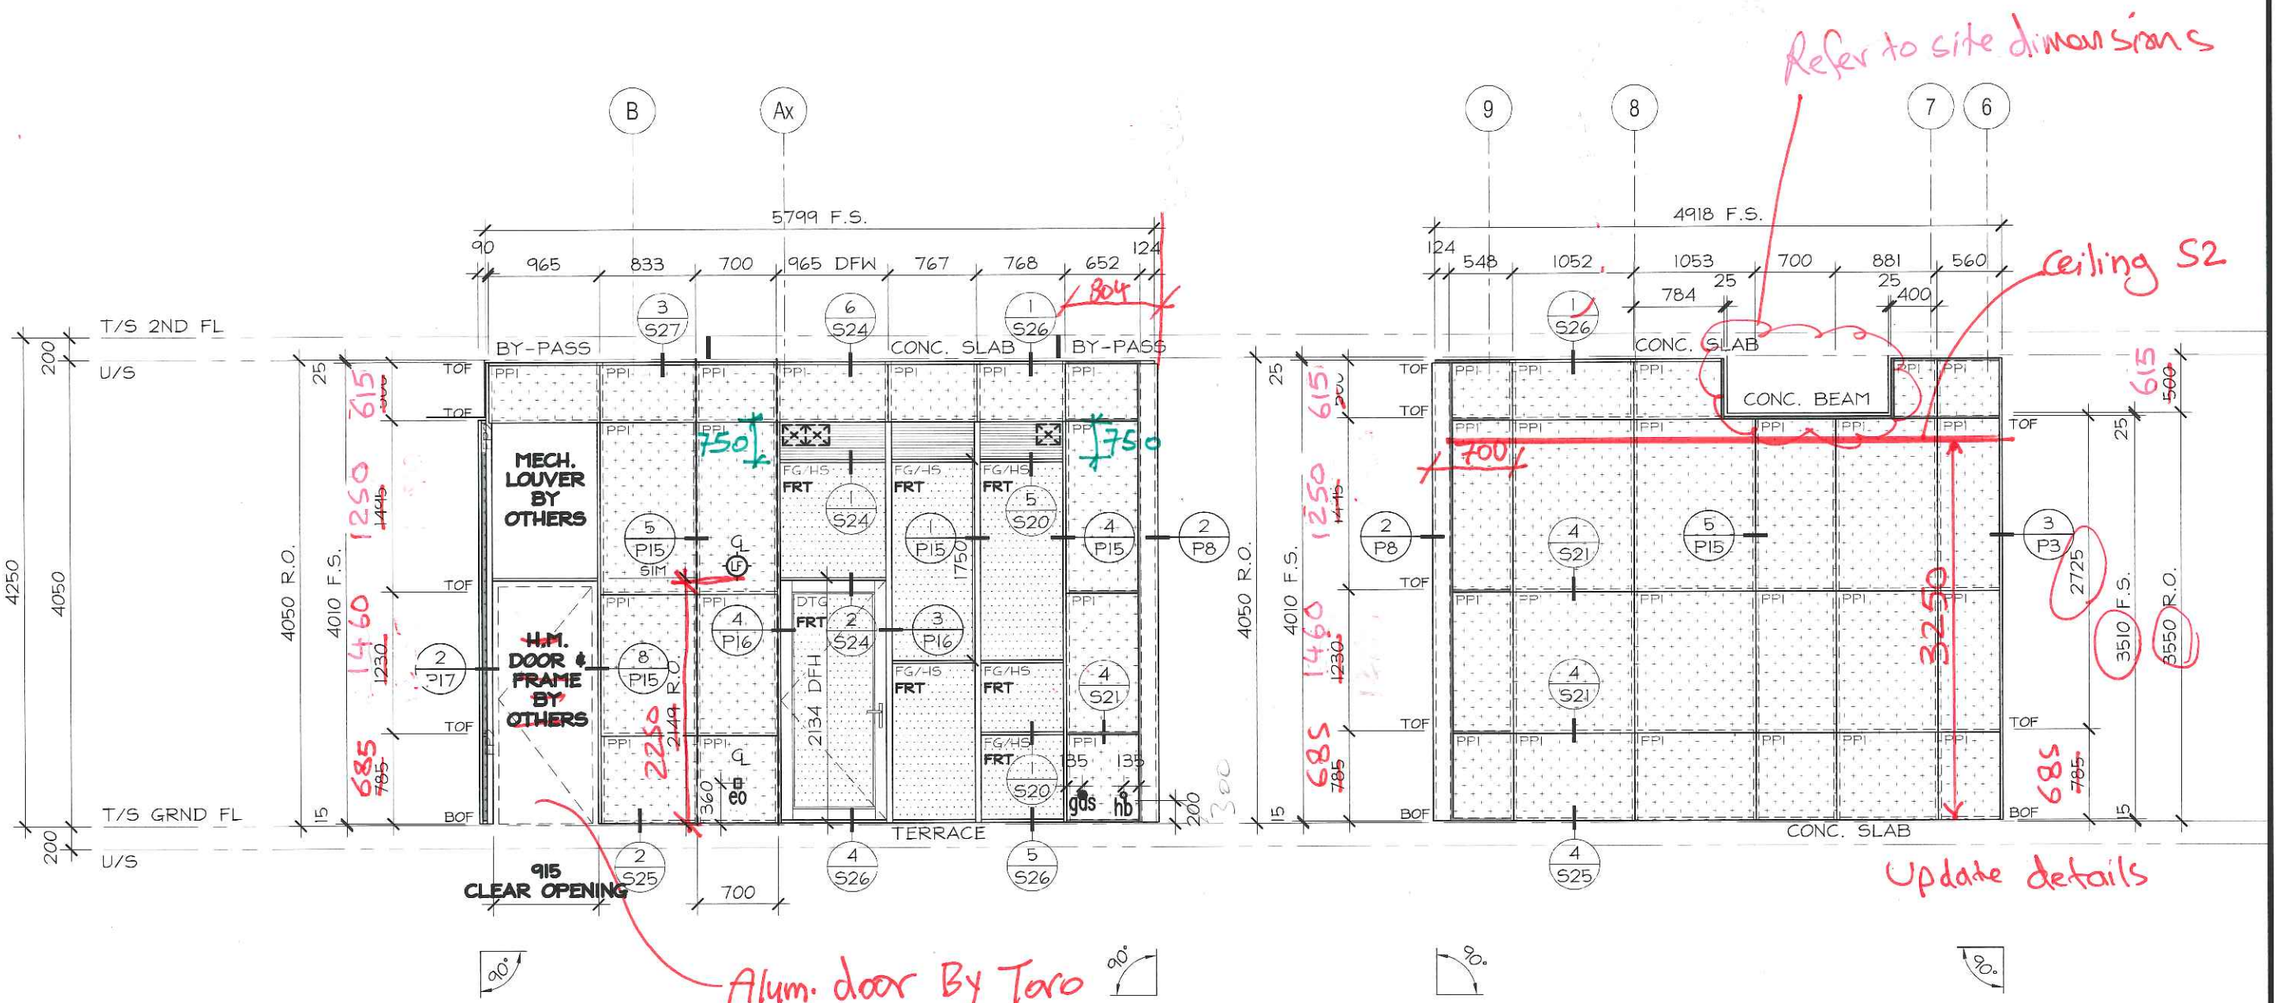

WG-22 1 REQUIRED
2587 SERIES
2487 SERIES


WG-23 1 REQUIRED
2587 SERIES
2487 SERIES

TORO ALUMINUM
COMMERCIAL INDUSTRIAL RESIDENTIAL
330 APPLEWOOD CRESCENT
CONCORD, ON, CANADA
L4K 4V2
TEL: (905)738-5220
FAX: (905)738-5481
WWW.TOROALUMINUM.COM

LICENSED PROFESSIONAL ENGINEER
06-27-15
D.T. PROHASKA
3754901
PROVINCE OF ONTARIO

No.	REVISION	BY	DATE

PROJECT NAME: SQ ALEXANDRA PARK - BLOCK11
DRAWING TITLE: GROUND FLOOR ELEVATIONS
ARCHITECT: TEEPLE ARCHITECTS
CONTRACTOR: TRIDEL
SCALE: 1:50
DRAWN BY: S.C.
DATE: MARCH 4, 2015
DRAWING No.: EG-17

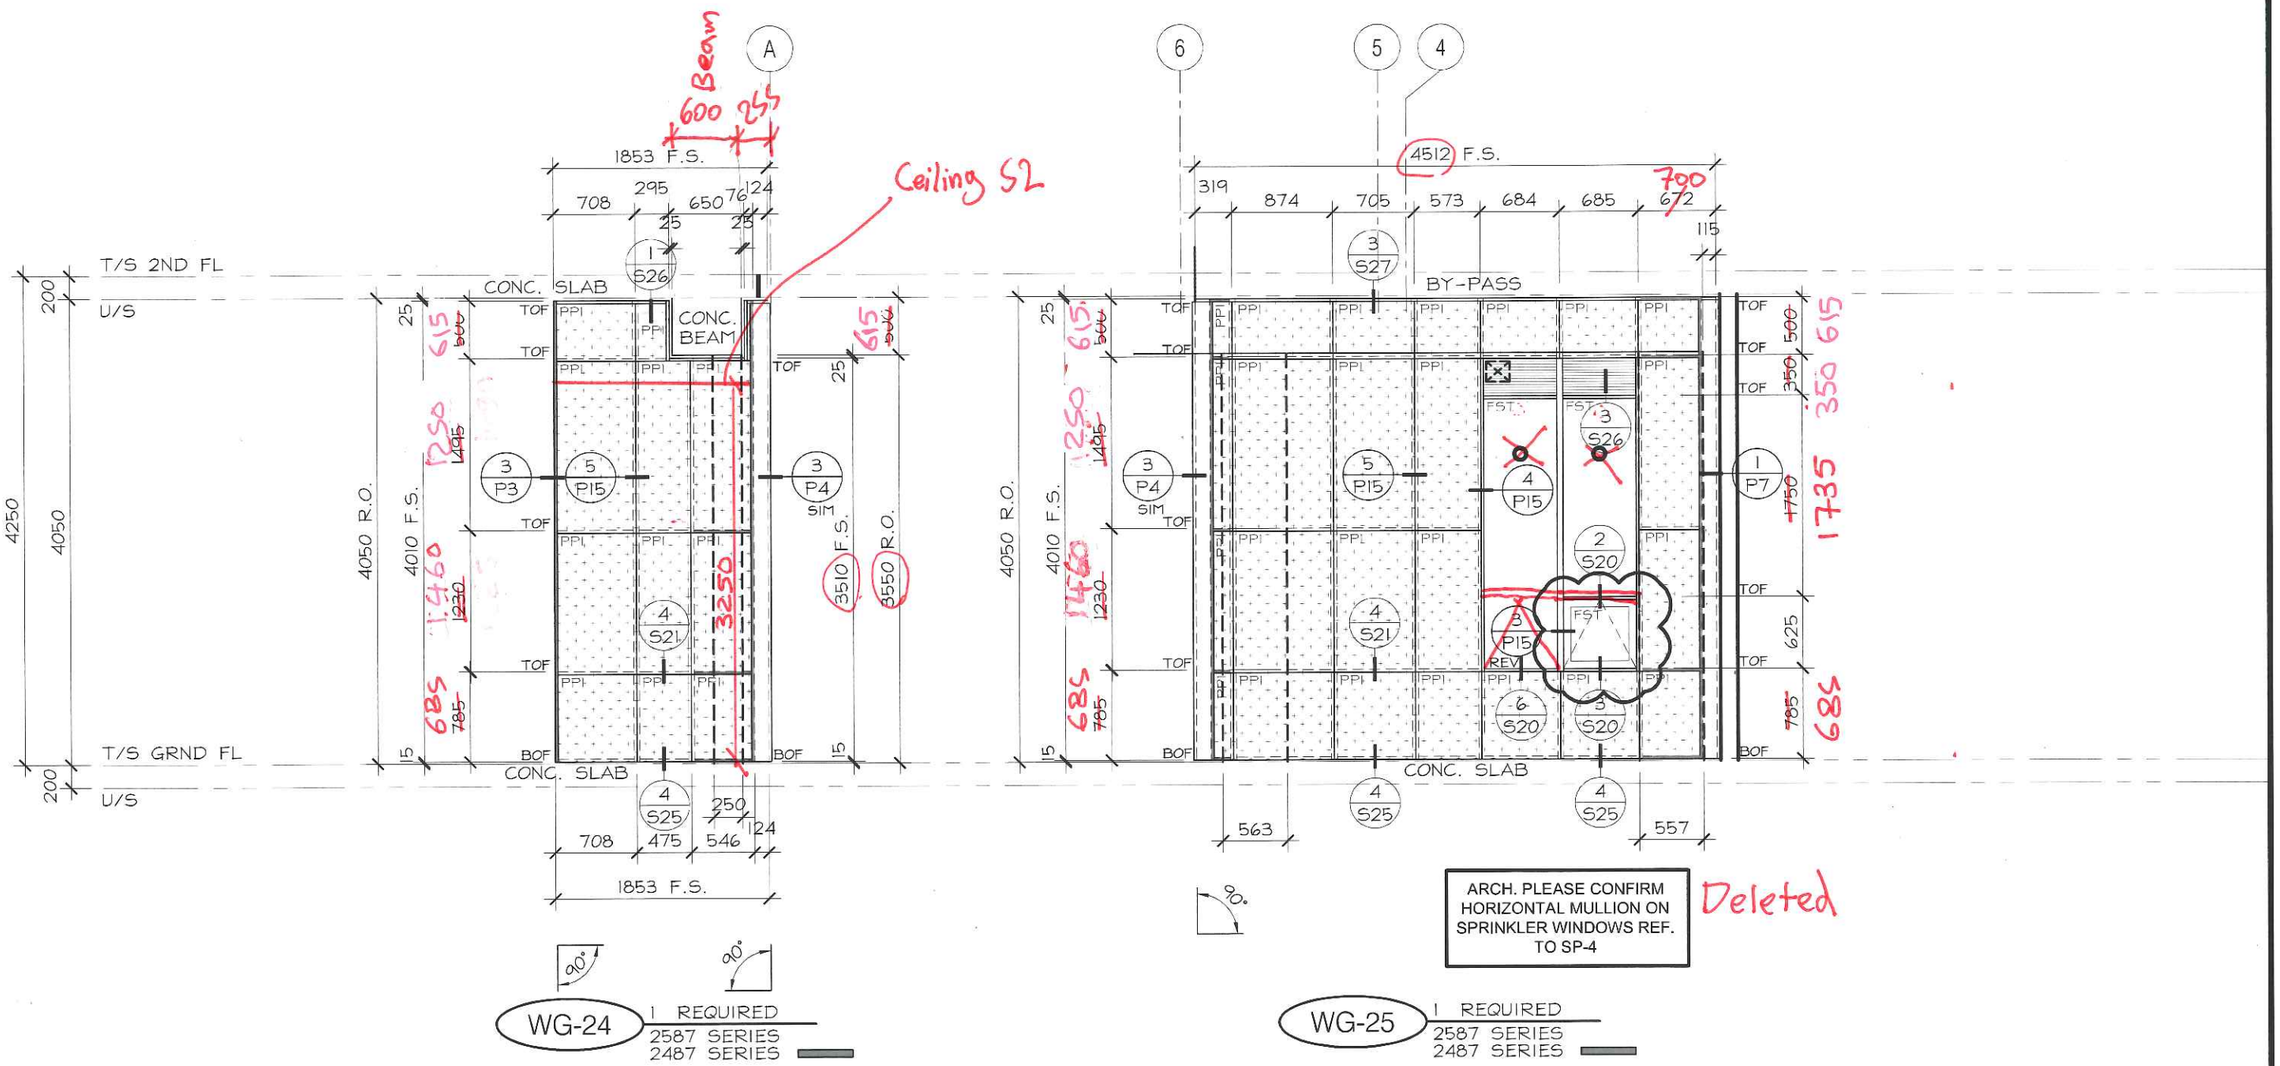

WG-24 1 REQUIRED
2587 SERIES
2487 SERIES

WG-25 1 REQUIRED
2587 SERIES
2487 SERIES

ARCH. PLEASE CONFIRM HORIZONTAL MULLION ON SPRINKLER WINDOWS REF. TO SP-4


Deleted

TORO ALUMINUM
COMMERCIAL INDUSTRIAL RESIDENTIAL
330 APPLEWOOD CRESCENT
CONCORD, ON, CANADA
L4K 4V2
TEL: (905)738-5220
FAX: (905)738-5481
WWW.TOROALUMINUM.COM

LICENSED PROFESSIONAL ENGINEER
06-27-15
D.T. PROHASKA
3754901
PROVINCE OF ONTARIO

No.	REVISION	BY	DATE

PROJECT NAME: SQ ALEXANDRA PARK - BLOCK11
DRAWING TITLE: GROUND FLOOR ELEVATIONS
ARCHITECT: TEEPLE ARCHITECTS
CONTRACTOR: TRIDEL
SCALE: 1:50
DRAWN BY: S.C.
DATE: MARCH 4, 2015
DRAWING No.: EG-18

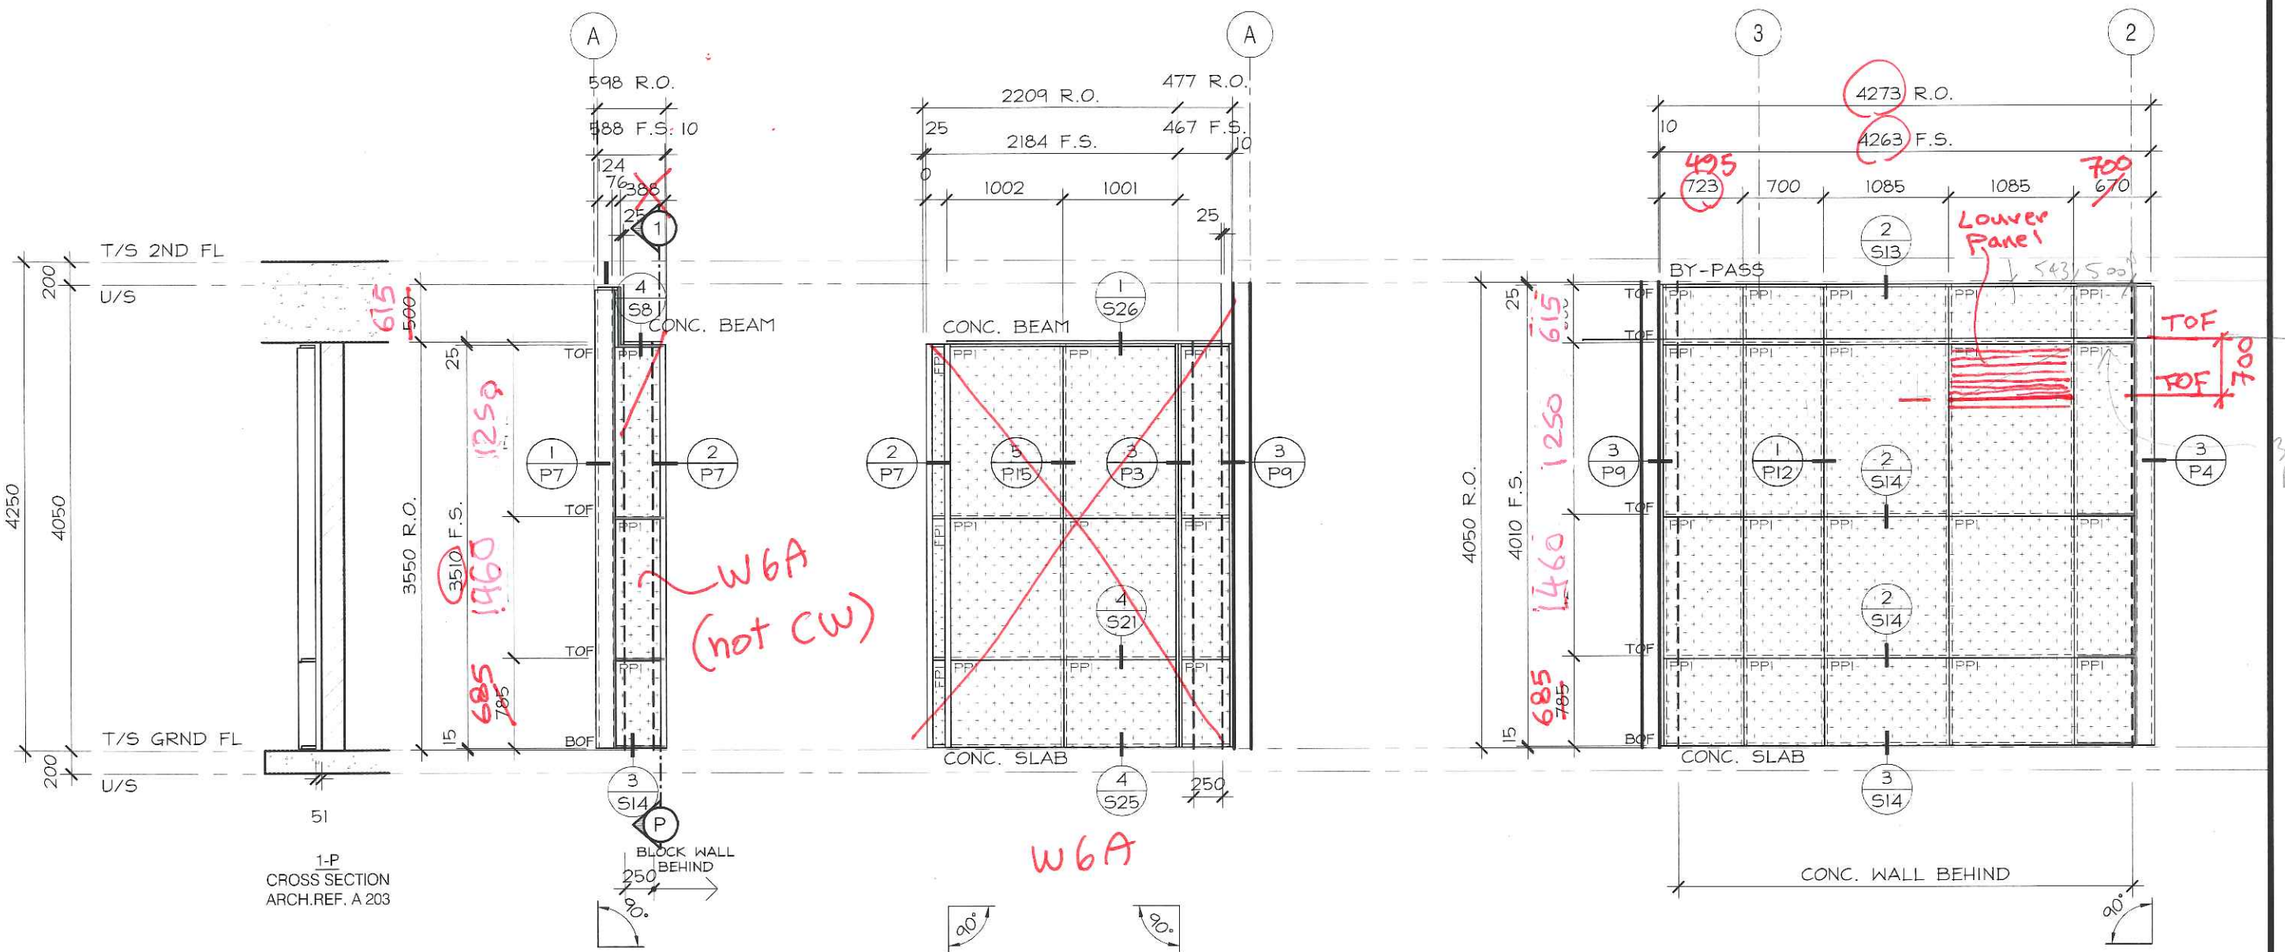

WG-26a 1 REQUIRED
2587 SERIES
2487 SERIES

WG-26b 1 REQUIRED
2587 SERIES


WG-27 1 REQUIRED
2487 SERIES

TORO ALUMINUM
COMMERCIAL INDUSTRIAL RESIDENTIAL
330 APPLEWOOD CRESCENT
CONCORD, ON, CANADA
L4K 4V2
TEL: (905)738-5220
FAX: (905)738-5481
WWW.TOROALUMINUM.COM

LICENSED PROFESSIONAL ENGINEER
06-27-15
D.T. PROHASKA
37549014
PROVINCE OF ONTARIO

No.	REVISION	BY	DATE

PROJECT NAME: SQ ALEXANDRA PARK - BLOCK11
DRAWING TITLE: GROUND FLOOR ELEVATIONS
ARCHITECT: TEEPLE ARCHITECTS
CONTRACTOR: TRIDEL
SCALE: 1:50
DRAWN BY: S.C.
DATE: MARCH 4, 2015
DRAWING No.: EG-19

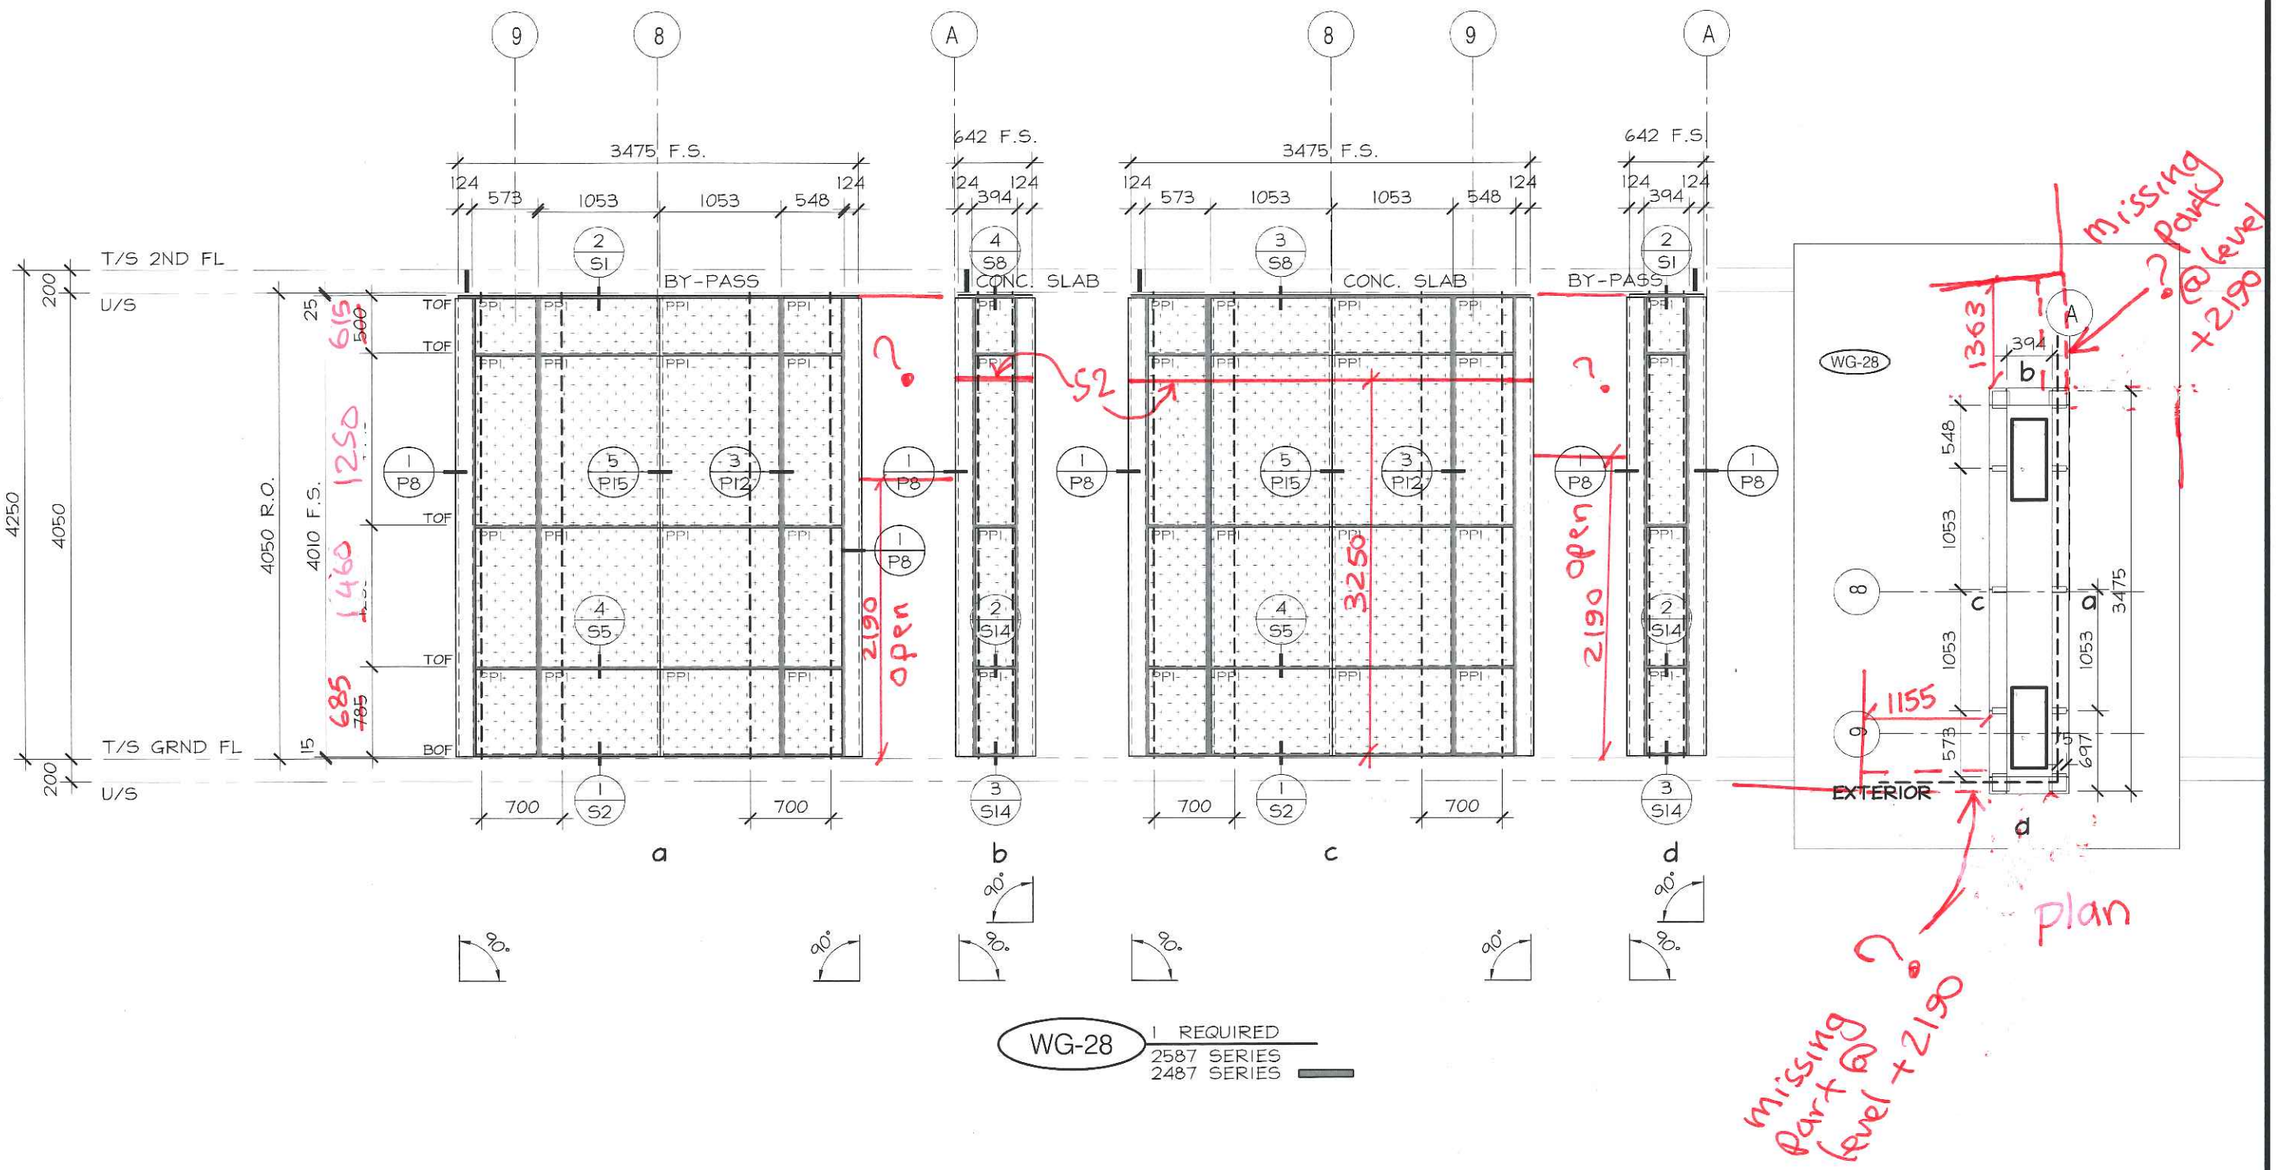



TORO ALUMINUM
COMMERCIAL INDUSTRIAL RESIDENTIAL
330 APPLEWOOD CRESCENT
CONCORD, ON, CANADA
L4K 4V2
TEL: (905)738-5220
FAX: (905)738-5481
WWW.TOROALUMINUM.COM


LICENSED PROFESSIONAL ENGINEER
06-27-15
D.T. PROHASKA
3754901
PROVINCE OF ONTARIO

No.	REVISION	BY	DATE

PROJECT NAME: SQ ALEXANDRA PARK - BLOCK11
DRAWING TITLE: GROUND FLOOR ELEVATIONS
ARCHITECT: TEEPLE ARCHITECTS
CONTRACTOR: TRIDEL
SCALE: 1:50
DRAWN BY: S.C.
DATE: MARCH 4, 2015
DRAWING No.: EG-20

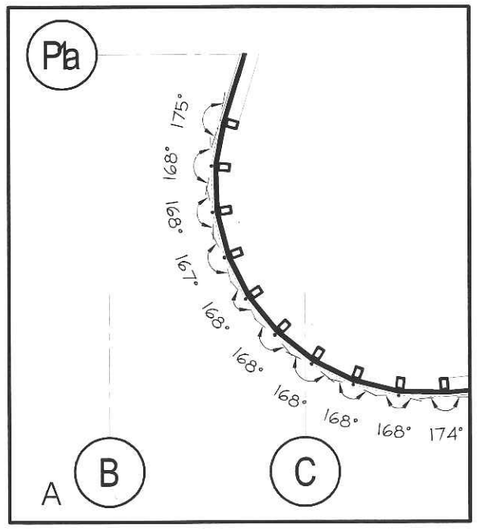

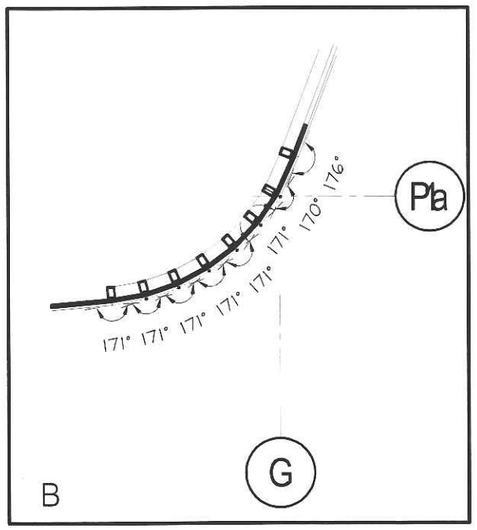

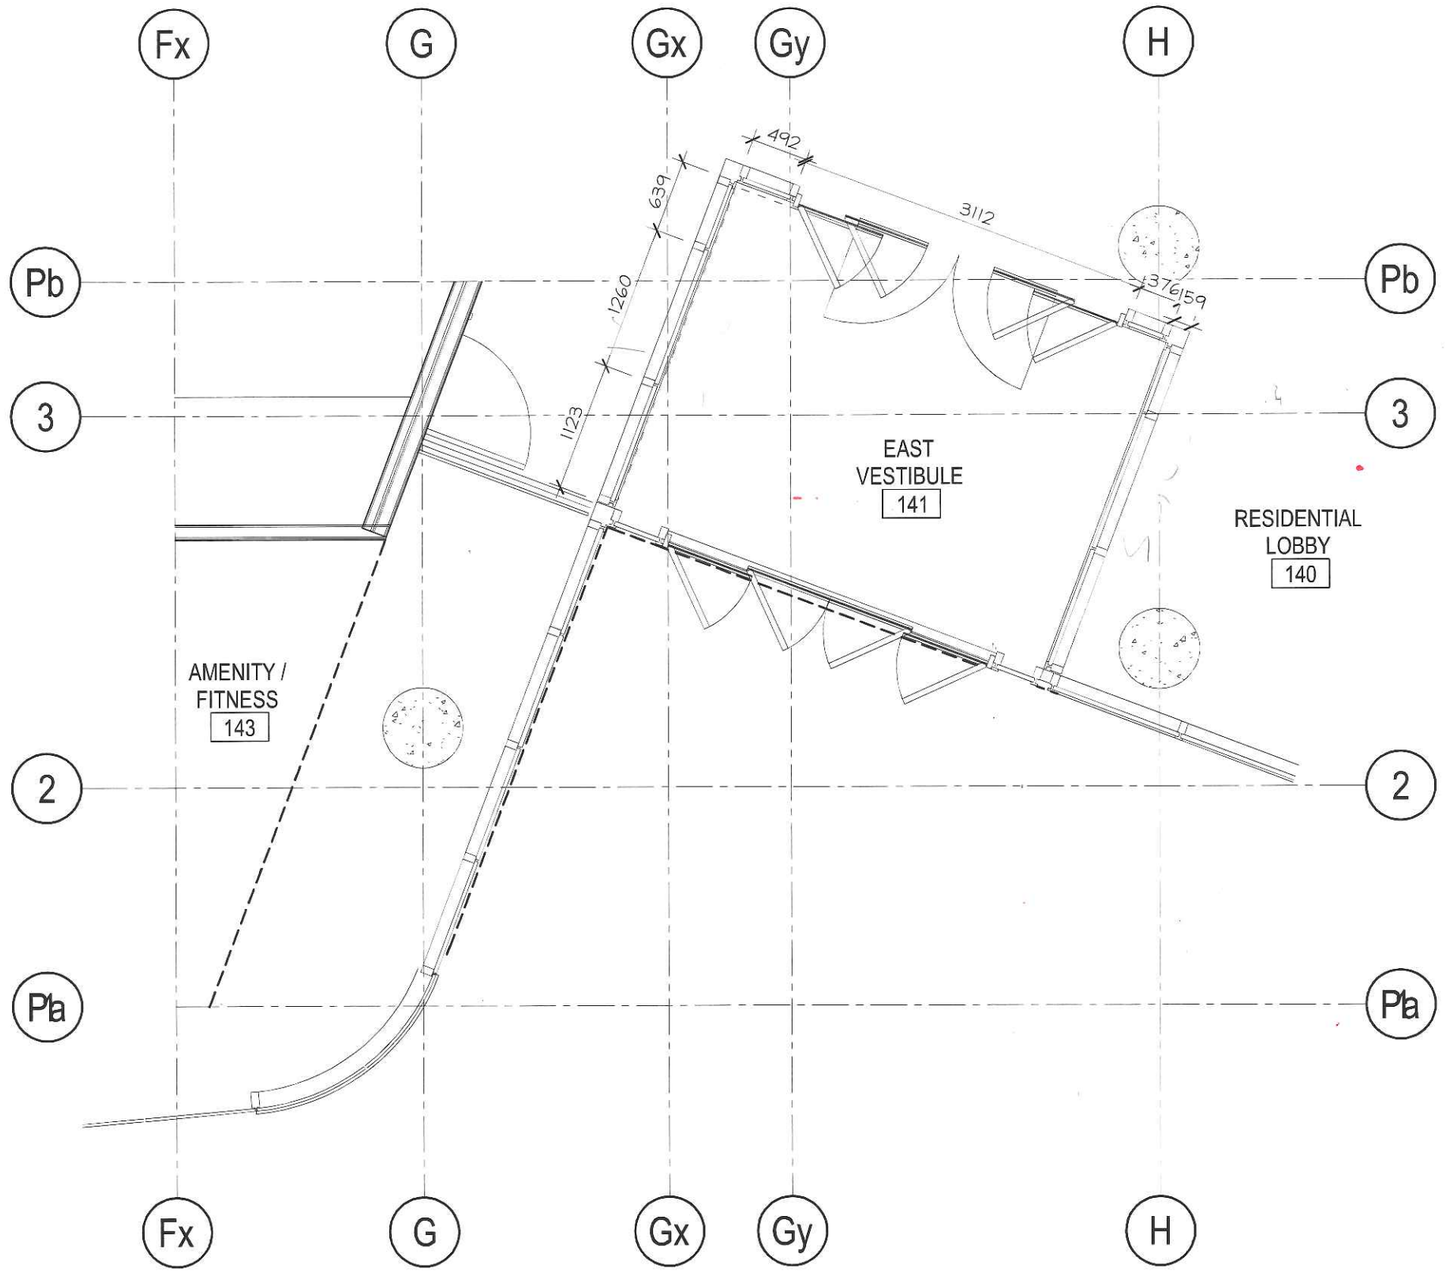

TORO ALUMINUM
COMMERCIAL INDUSTRIAL RESIDENTIAL
330 APPLEWOOD CRESCENT
CONCORD, ON, CANADA
L4K 4V2
TEL: (905)738-5220
FAX: (905)738-5481
WWW.TOROALUMINUM.COM

LICENSED PROFESSIONAL ENGINEER
06-27-15
D.T. PROHASKA
3754901
PROVINCE OF ONTARIO

No.	REVISION	BY	DATE

PROJECT NAME: SQ ALEXANDRA PARK - BLOCK11
DRAWING TITLE: GROUND FLOOR ELEVATIONS
ARCHITECT: TEEPLE ARCHITECTS
CONTRACTOR: TRIDEL
SCALE: 1:50
DRAWN BY: S.C.
DATE: MARCH 4, 2015
DRAWING No.: EG-21

Follow below dimensions

2400 R.O.
10
2390 F.S.
1150 1240 375 421 448 435 428 437 426 447 433 1050 1050 1050 1050 1050 1050
eq. eq. 8 eq.
6300 F.S.

T/S 2ND FL 4250
240
460
4010
U/ BEAM
300
SOFFIT
760 R.O.
745 F.S.
15

PARAPRT
BY-PASS
3 P6 | 4 P14 | 2 P13 | P13 | 3 P14 | 2 S19 | 3 P10 | 3 P10
75
4175

173° 168° 167° 167° 168° 167° 167° 167° 168°176°

WG-01X 1 REQUIRED 1/2 FRAME

2397 R.O.
10
2387 F.S.
1150 1237 350 405 405 405 405 405 405 405 405 1050 1050 1050 1050 1050 1050
6300 F.S.
(WCG-02)

T/S 2ND FL
200
U/S
350
U/ BEAM
300 450
SOFFIT
20
280 440
287 477
TOF TOF TOF
CONC. SLAB
300

4250
4050
3700
3700
3550 R.O.
3517 F.S.
3667
13
2750
BOF
T/S GRND FL
200
U/S
CONC. SLAB

1 P27 | 1 P28 | 2 P26 | 2 P25 | 2 P25 | 2 P25 | 2 P25 | 1 P26 | 1 P28 | 1 P28 | 1 P28 | 1 P28
4 S38 | 1 S36 | 3 S38 | 1 S36 | 4 S38 | 1 | 2 S38 | Q

1275 660 462 8@450 440 660 990 1485 1763 1763

70

1-Q
CROSS SECTION
ARCH.REF. 2/A 501
& 2/A 504

175° 168° 168° 168° 168° 168° 168° 168° 168°174°


CWG-01 1 REQUIRED
8000 SSG SERIES
2-1/2"x4" BACKSECTION
AMENITY/FITNESS(143)


TORO ALUMINUM
COMMERCIAL INDUSTRIAL RESIDENTIAL
330 APPLEWOOD CRESCENT
CONCORD, ON, CANADA
L4K 4V2
TEL: (905)738-5220
FAX: (905)738-5481
WWW.TOROALUMINUM.COM

LICENSED PROFESSIONAL ENGINEER
06-27-15
D.T. PROHASKA
37549014
PROVINCE OF ONTARIO

No.	REVISION	BY	DATE

PROJECT NAME: SQ ALEXANDRA PARK - BLOCK11
DRAWING TITLE: GROUND FLOOR ELEVATIONS
ARCHITECT: TEEPLE ARCHITECTS
CONTRACTOR: TRIDEL
SCALE: 1:50
DRAWN BY: S.C.
DATE: MARCH 4, 2015
DRAWING No.: EG-22

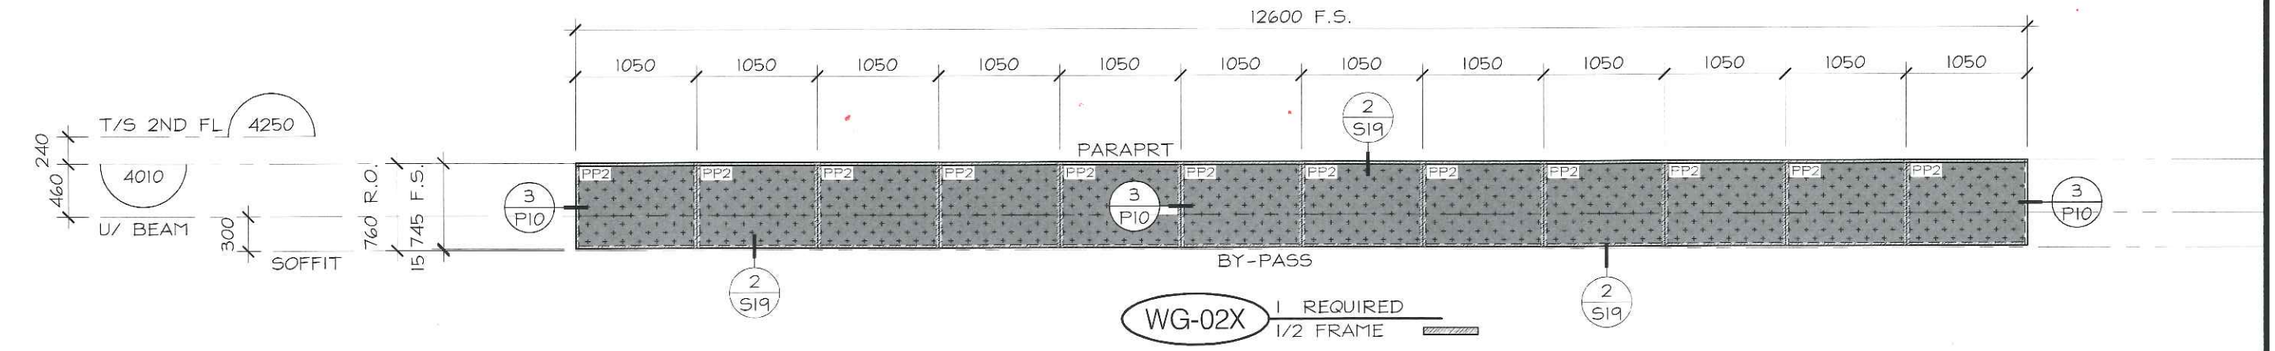

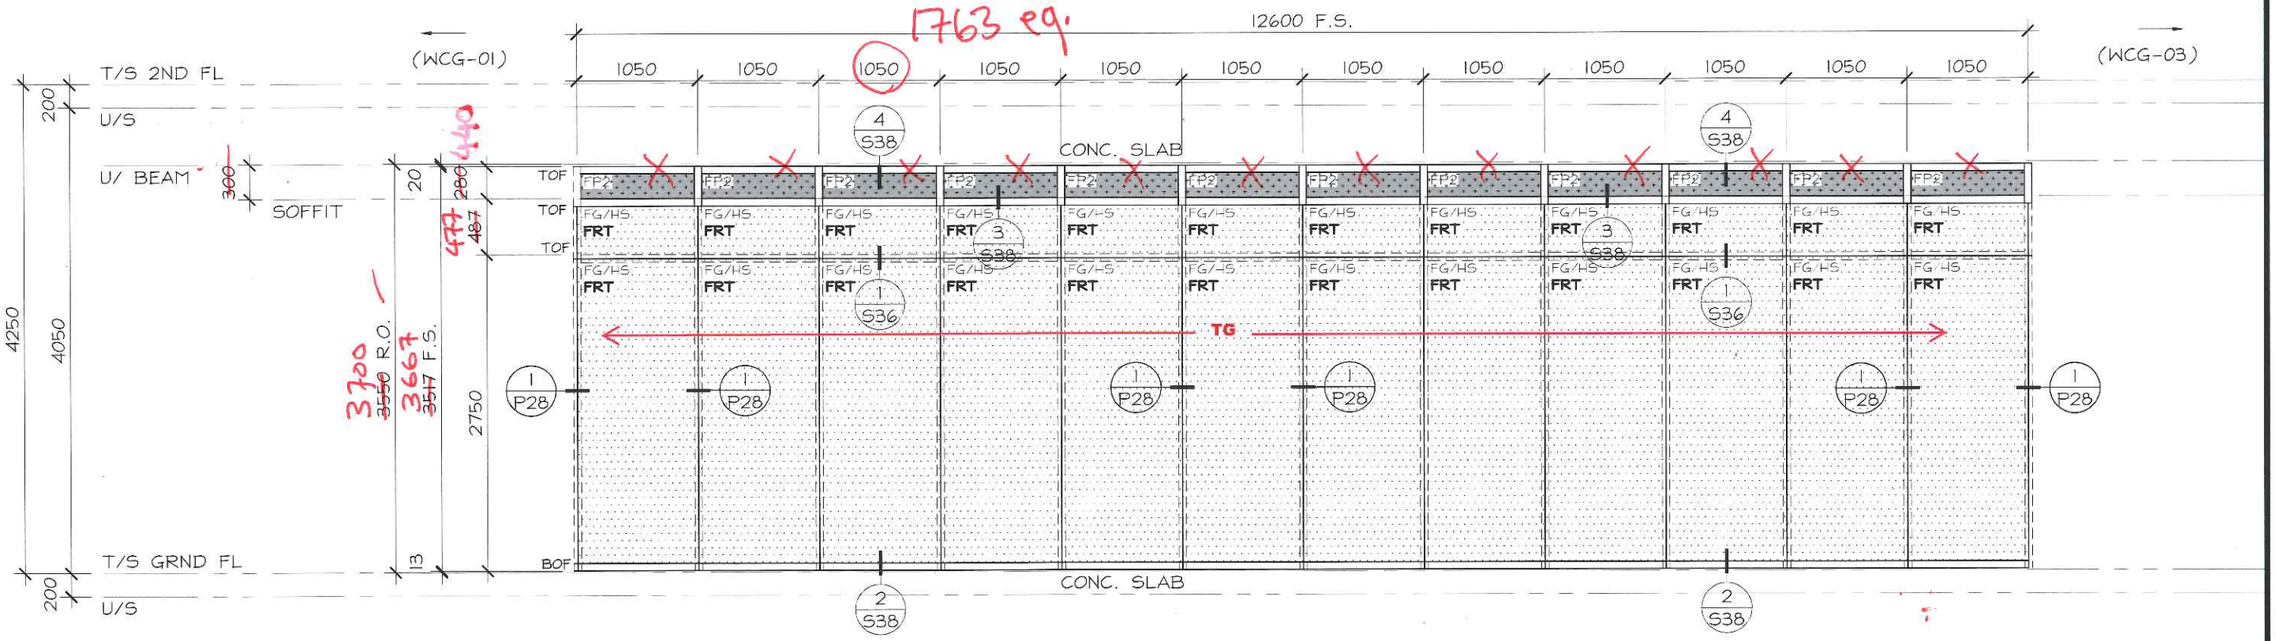


CWG-02 1 REQUIRED
8000 SSG SERIES
2-1/2"x4" BACKSECTION
AMENITY/FITNESS(143)


TORO ALUMINUM
COMMERCIAL INDUSTRIAL RESIDENTIAL
330 APPLEWOOD CRESCENT CONCORD, ON, CANADA L4K 4V2
TEL: (905)738-5220 FAX: (905)738-5481 WWW.TOROALUMINUM.COM

LICENSED PROFESSIONAL ENGINEER 06-27-15 D.T. PROHASKA 37549014 PROVINCE OF ONTARIO

No.	REVISION	BY	DATE

PROJECT NAME: SQ ALEXANDRA PARK - BLOCK11
DRAWING TITLE: GROUND FLOOR ELEVATIONS
ARCHITECT: TEEPLE ARCHITECTS
CONTRACTOR: TRIDEL
SCALE: 1:50 DRAWN BY: S.C. DATE: MARCH 4, 2015
DRAWING No.: EG-23

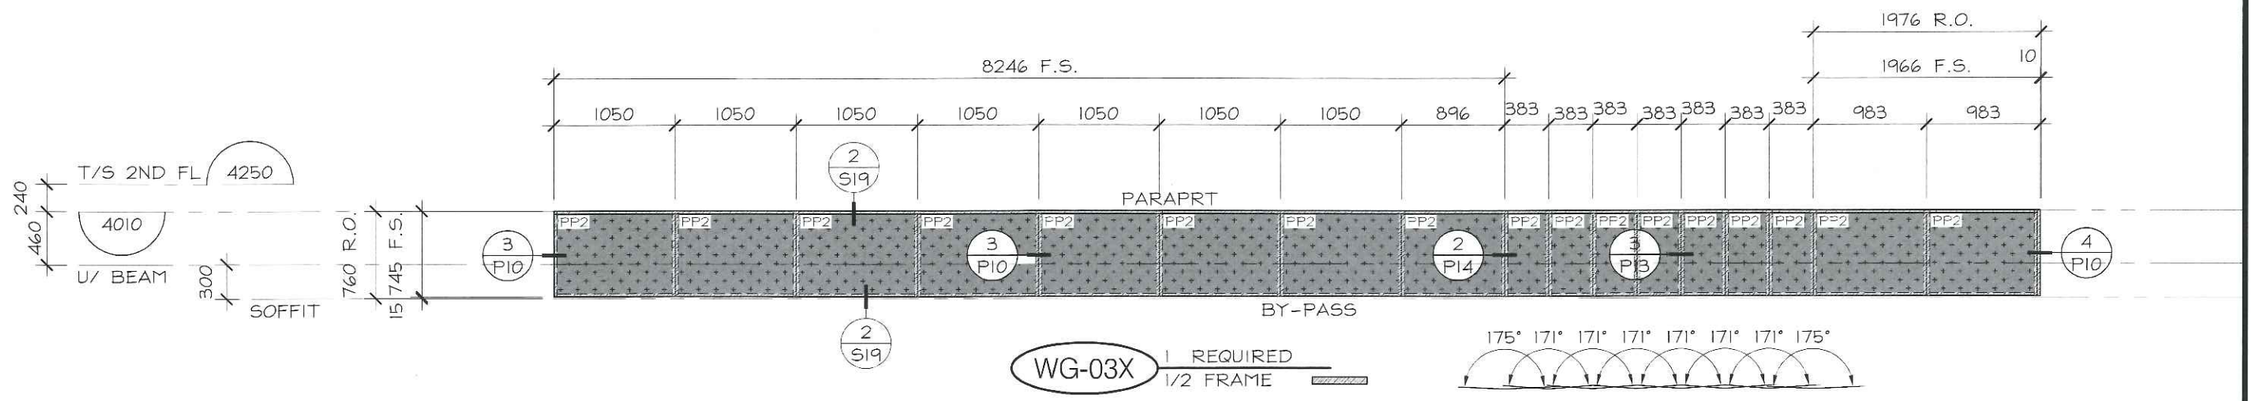

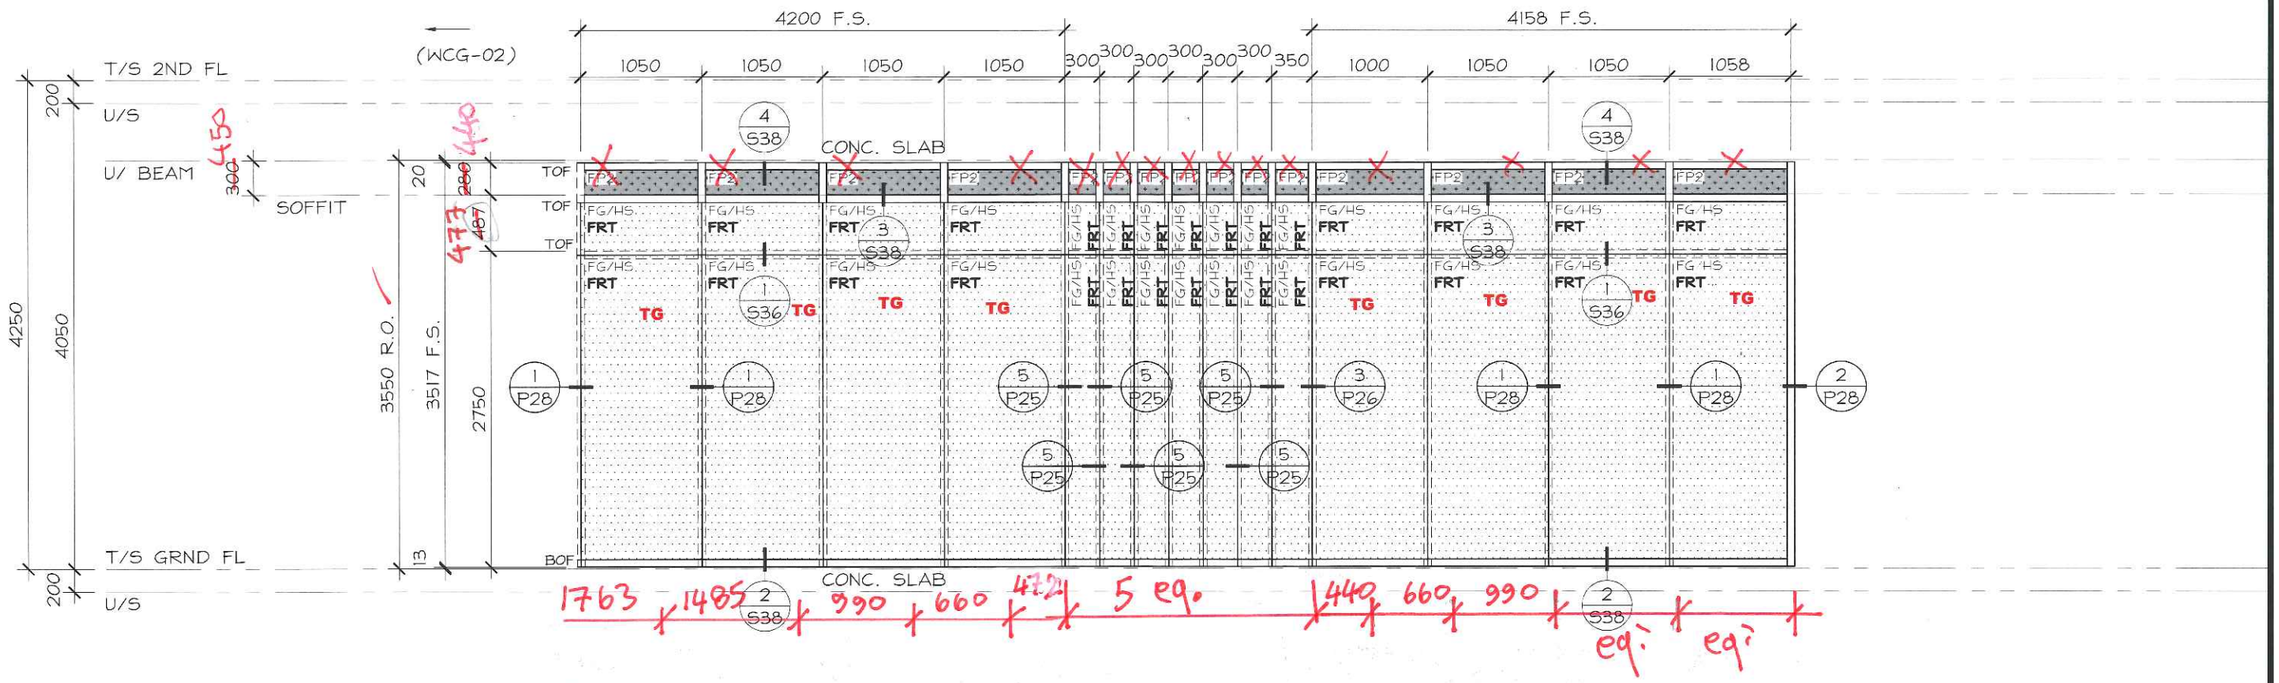


TORO ALUMINUM
COMMERCIAL INDUSTRIAL RESIDENTIAL
330 APPLEWOOD CRESCENT
CONCORD, ON, CANADA
L4K 4V2
TEL: (905)738-5220
FAX: (905)738-5481
WWW.TOROALUMINUM.COM

LICENSED PROFESSIONAL ENGINEER
06-27-15
D.T. PROHASKA
3754901
PROVINCE OF ONTARIO

No.	REVISION	BY	DATE

PROJECT NAME: SQ ALEXANDRA PARK - BLOCK11
DRAWING TITLE: GROUND FLOOR ELEVATIONS
ARCHITECT: TEEPLE ARCHITECTS
CONTRACTOR: TRIDEL
SCALE: 1:50
DRAWN BY: S.C.
DATE: MARCH 4, 2015
DRAWING No.: EG-24

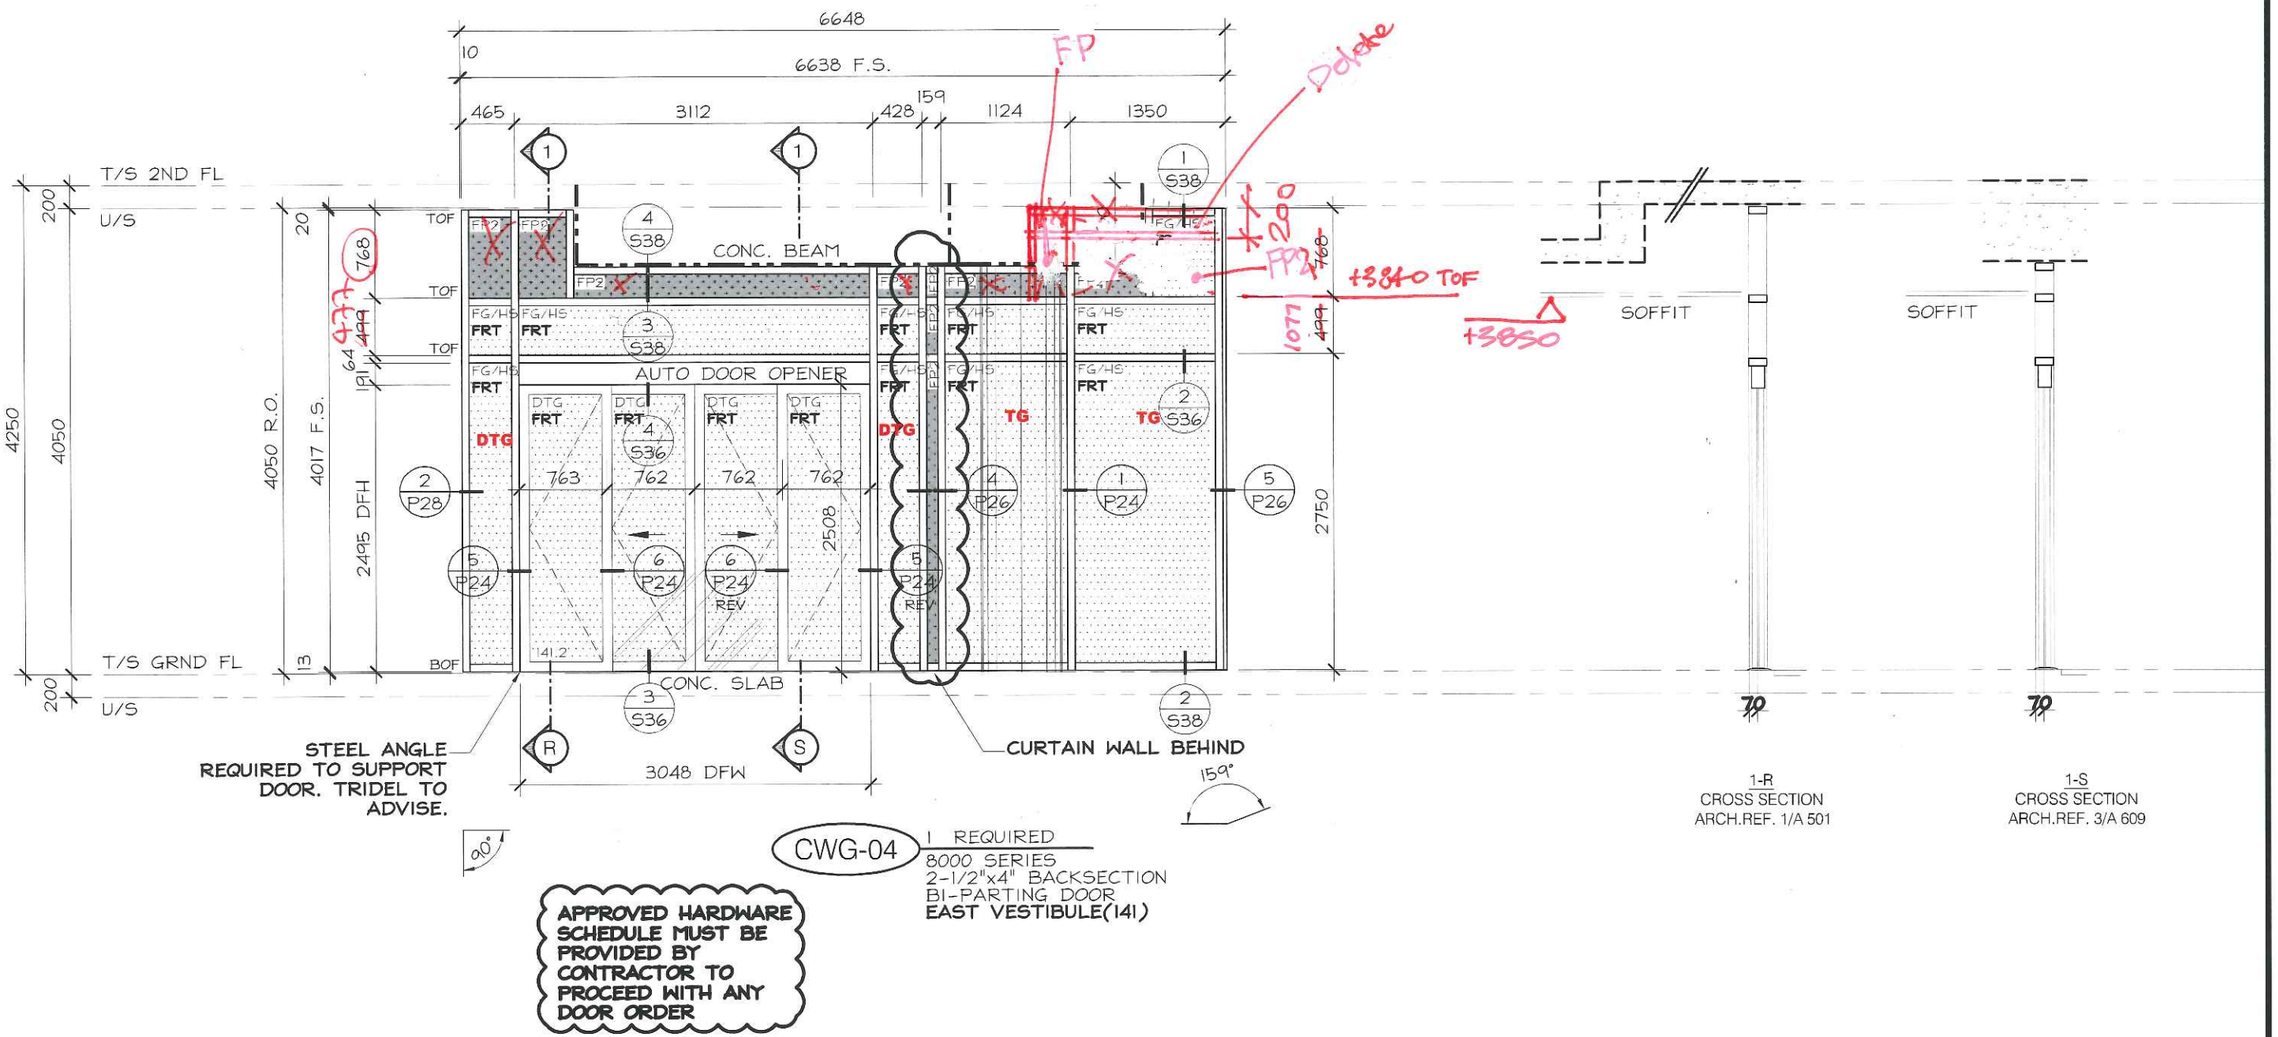


TORO ALUMINUM
COMMERCIAL INDUSTRIAL RESIDENTIAL
330 APPLEWOOD CRESCENT
CONCORD, ON, CANADA
L4K 4V2
TEL: (905)738-5220
FAX: (905)738-5481
WWW.TOROALUMINUM.COM

LICENSED PROFESSIONAL ENGINEER
06-27-15
D.T. PROHASKA
3754901
PROVINCE OF ONTARIO

No.	REVISION	BY	DATE

PROJECT NAME:	SQ ALEXANDRA PARK - BLOCK11
DRAWING TITLE:	GROUND FLOOR ELEVATIONS
ARCHITECT:	TEEPLE ARCHITECTS
CONTRACTOR:	TRIDEL
SCALE: 1:50	DRAWN BY: S.C.
DATE: MARCH 4, 2015	
DRAWING No.:	EG-25

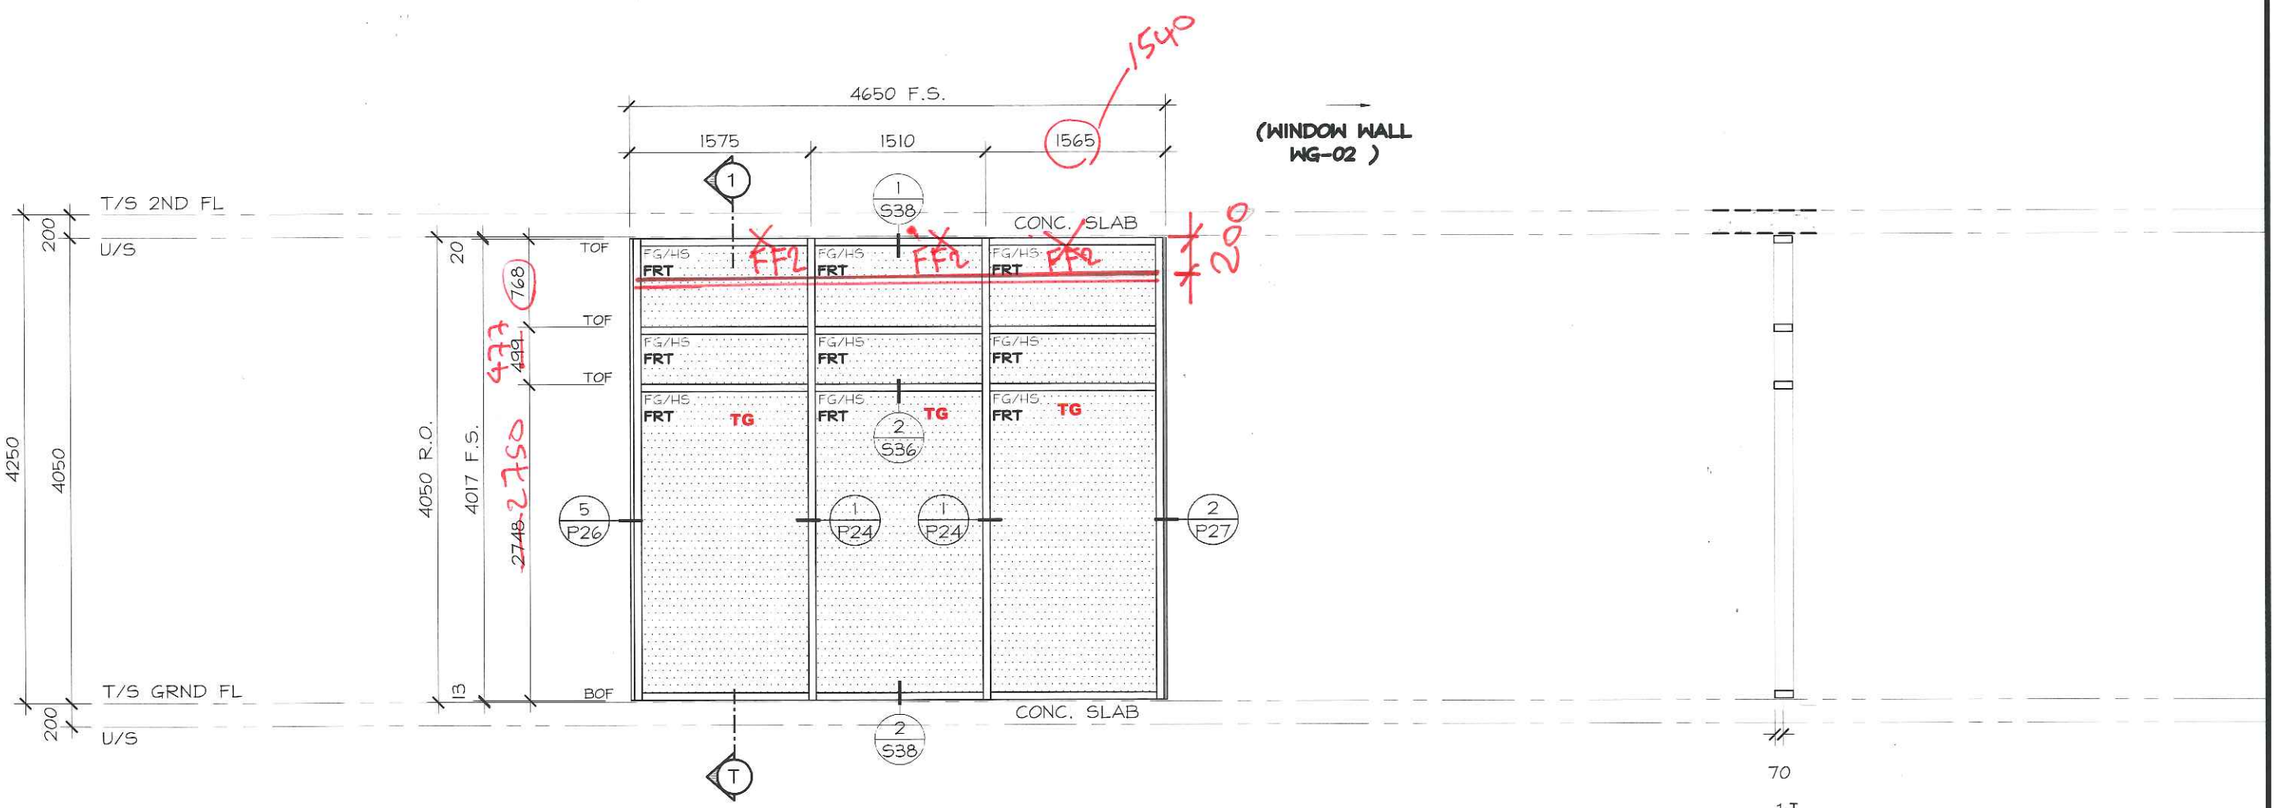



TORO ALUMINUM
COMMERCIAL INDUSTRIAL RESIDENTIAL
330 APPLEWOOD CRESCENT
CONCORD, ON, CANADA
L4K 4V2
TEL: (905)738-5220
FAX: (905)738-5481
WWW.TOROALUMINUM.COM

LICENSED PROFESSIONAL ENGINEER
06-27-15
D.T. PROHASKA
3754901
PROVINCE OF ONTARIO

No.	REVISION	BY	DATE

PROJECT NAME: SQ ALEXANDRA PARK - BLOCK11
DRAWING TITLE: GROUND FLOOR ELEVATIONS
ARCHITECT: TEEPLE ARCHITECTS
CONTRACTOR: TRIDEL
SCALE: 1:50
DRAWN BY: S.C.
DATE: MARCH 4, 2015
DRAWING No.: EG-26

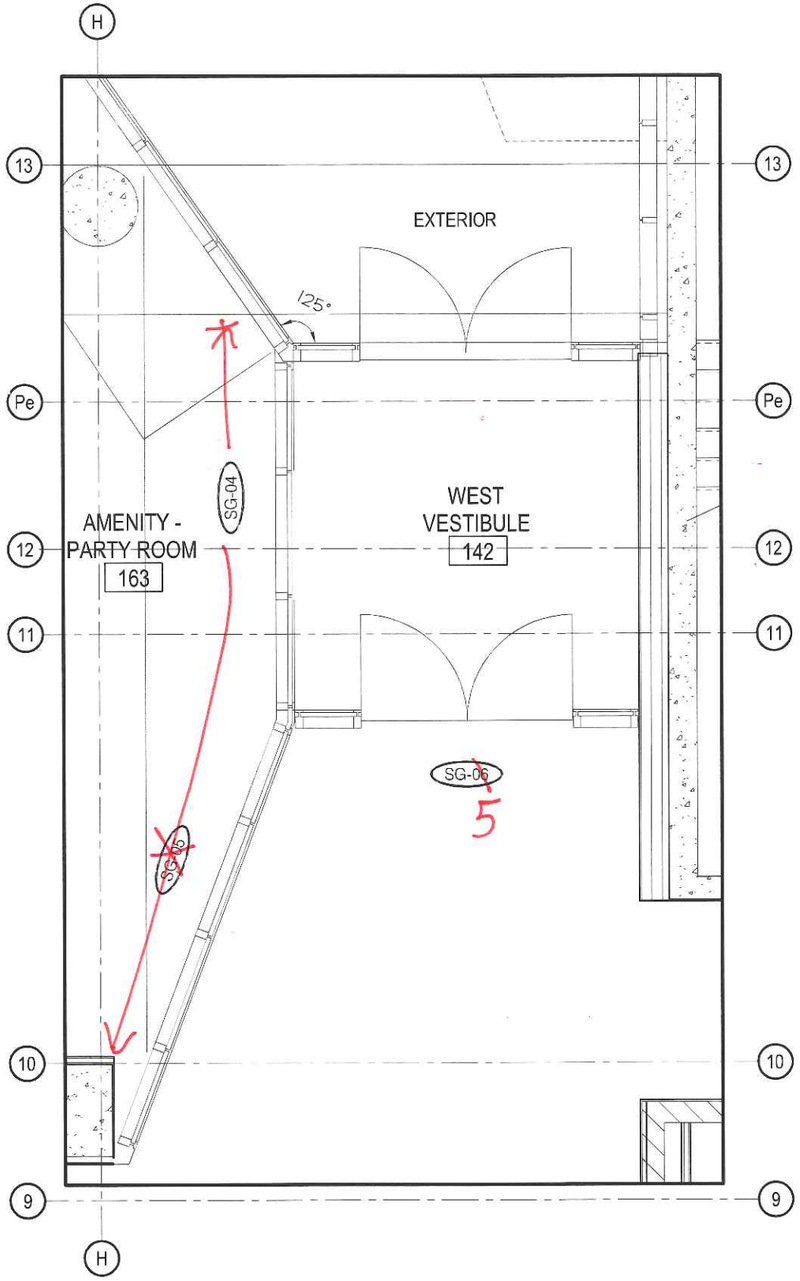

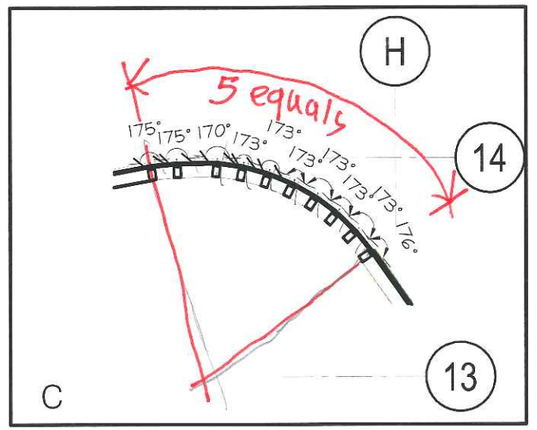


TORO ALUMINUM
COMMERCIAL INDUSTRIAL RESIDENTIAL
330 APPLEWOOD CRESCENT
CONCORD, ON, CANADA
L4K 4V2
TEL: (905)738-5220
FAX: (905)738-5481
WWW.TOROALUMINUM.COM


LICENSED PROFESSIONAL ENGINEER
06-27-15
D.T. PROHASKA
3754901
PROVINCE OF ONTARIO

No.	REVISION	BY	DATE

PROJECT NAME: SQ ALEXANDRA PARK - BLOCK11
DRAWING TITLE: GROUND FLOOR ELEVATIONS
ARCHITECT: TEEPLE ARCHITECTS
CONTRACTOR: TRIDEL
SCALE: 1:50
DRAWN BY: S.C.
DATE: MARCH 4, 2015
DRAWING No.: EG-27


APPROVED HARDWARE SCHEDULE MUST BE PROVIDED BY CONTRACTOR TO PROCEED WITH ANY DOOR ORDER

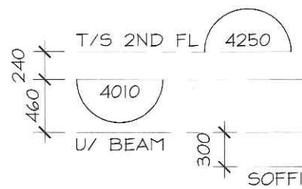

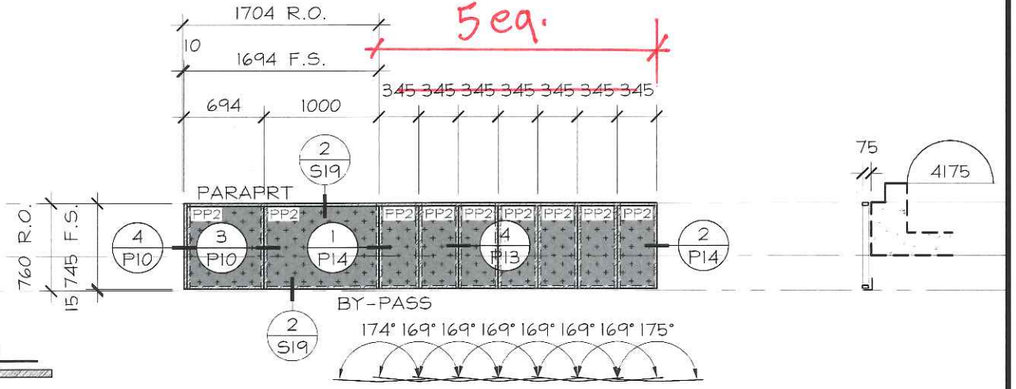

WG-18aX — 1 REQUIRED — 1/2 FRAME

(WINDOW WALL WG-18)

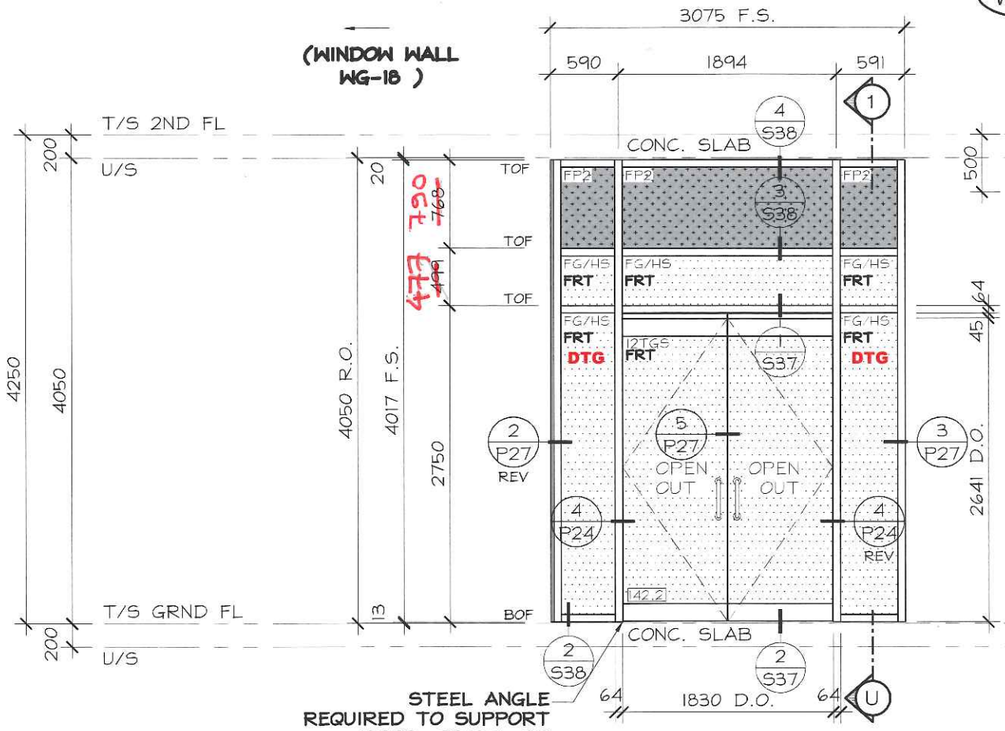


STEEL ANGLE REQUIRED TO SUPPORT DOOR. TRIDEL TO ADVISE.


CWG-06 — 1 REQUIRED
8000 SERIES
2-1/2"x4" BACKSECTION
FRAMELESS DOOR
2487 SERIES
WEST VESTIBULE(142)

1-U
CROSS SECTION
ARCH.REF. 3&4/A 504

(WCG-08)

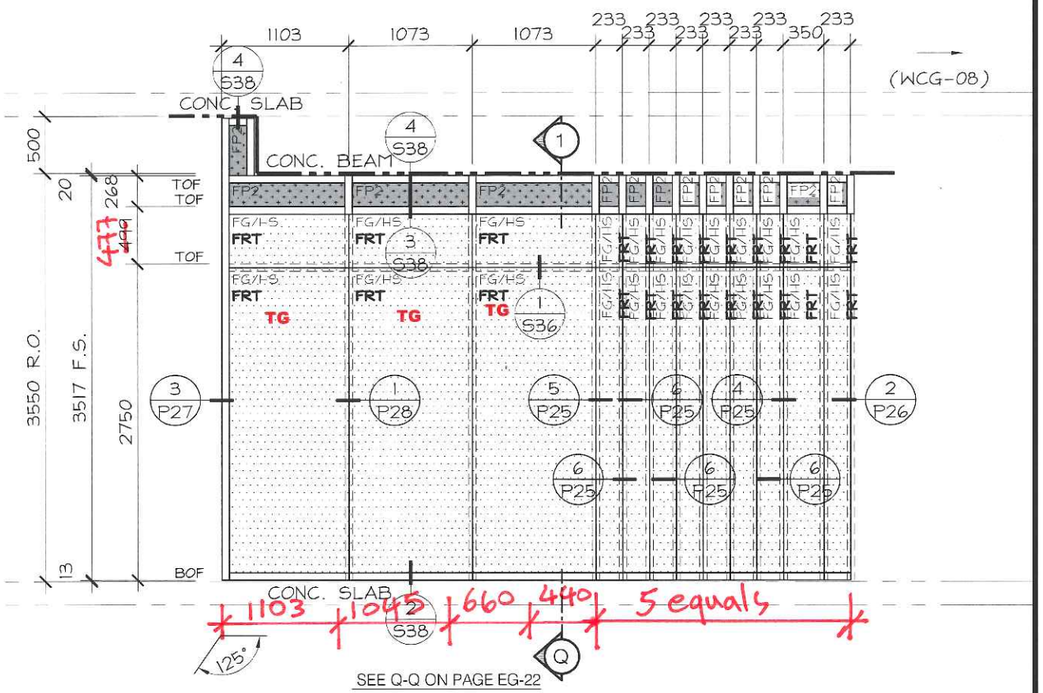

CWG-07 — 1 REQUIRED
8000 SSG SERIES
2-1/2"x4" BACKSECTION
260 SERIES DOORS
AMENITY/PARTY ROOM(163)

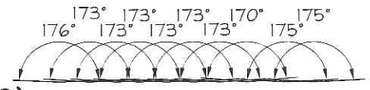


TORO ALUMINUM
COMMERCIAL INDUSTRIAL RESIDENTIAL
330 APPLEWOOD CRESCENT
CONCORD, ON, CANADA
L4K 4V2
TEL: (905)738-5220
FAX: (905)738-5481
WWW.TOROALUMINUM.COM

LICENSED PROFESSIONAL ENGINEER 06-27-15 D.T. PROHASKA 37549017 PROVINCE OF ONTARIO

No.	REVISION	BY	DATE

PROJECT NAME: SQ ALEXANDRA PARK - BLOCK11
DRAWING TITLE: GROUND FLOOR ELEVATIONS
ARCHITECT: TEEPLE ARCHITECTS
CONTRACTOR: TRIDEL
SCALE: 1:50 | DRAWN BY: S.C. | DATE: MARCH 4, 2015
DRAWING No.: EG-28

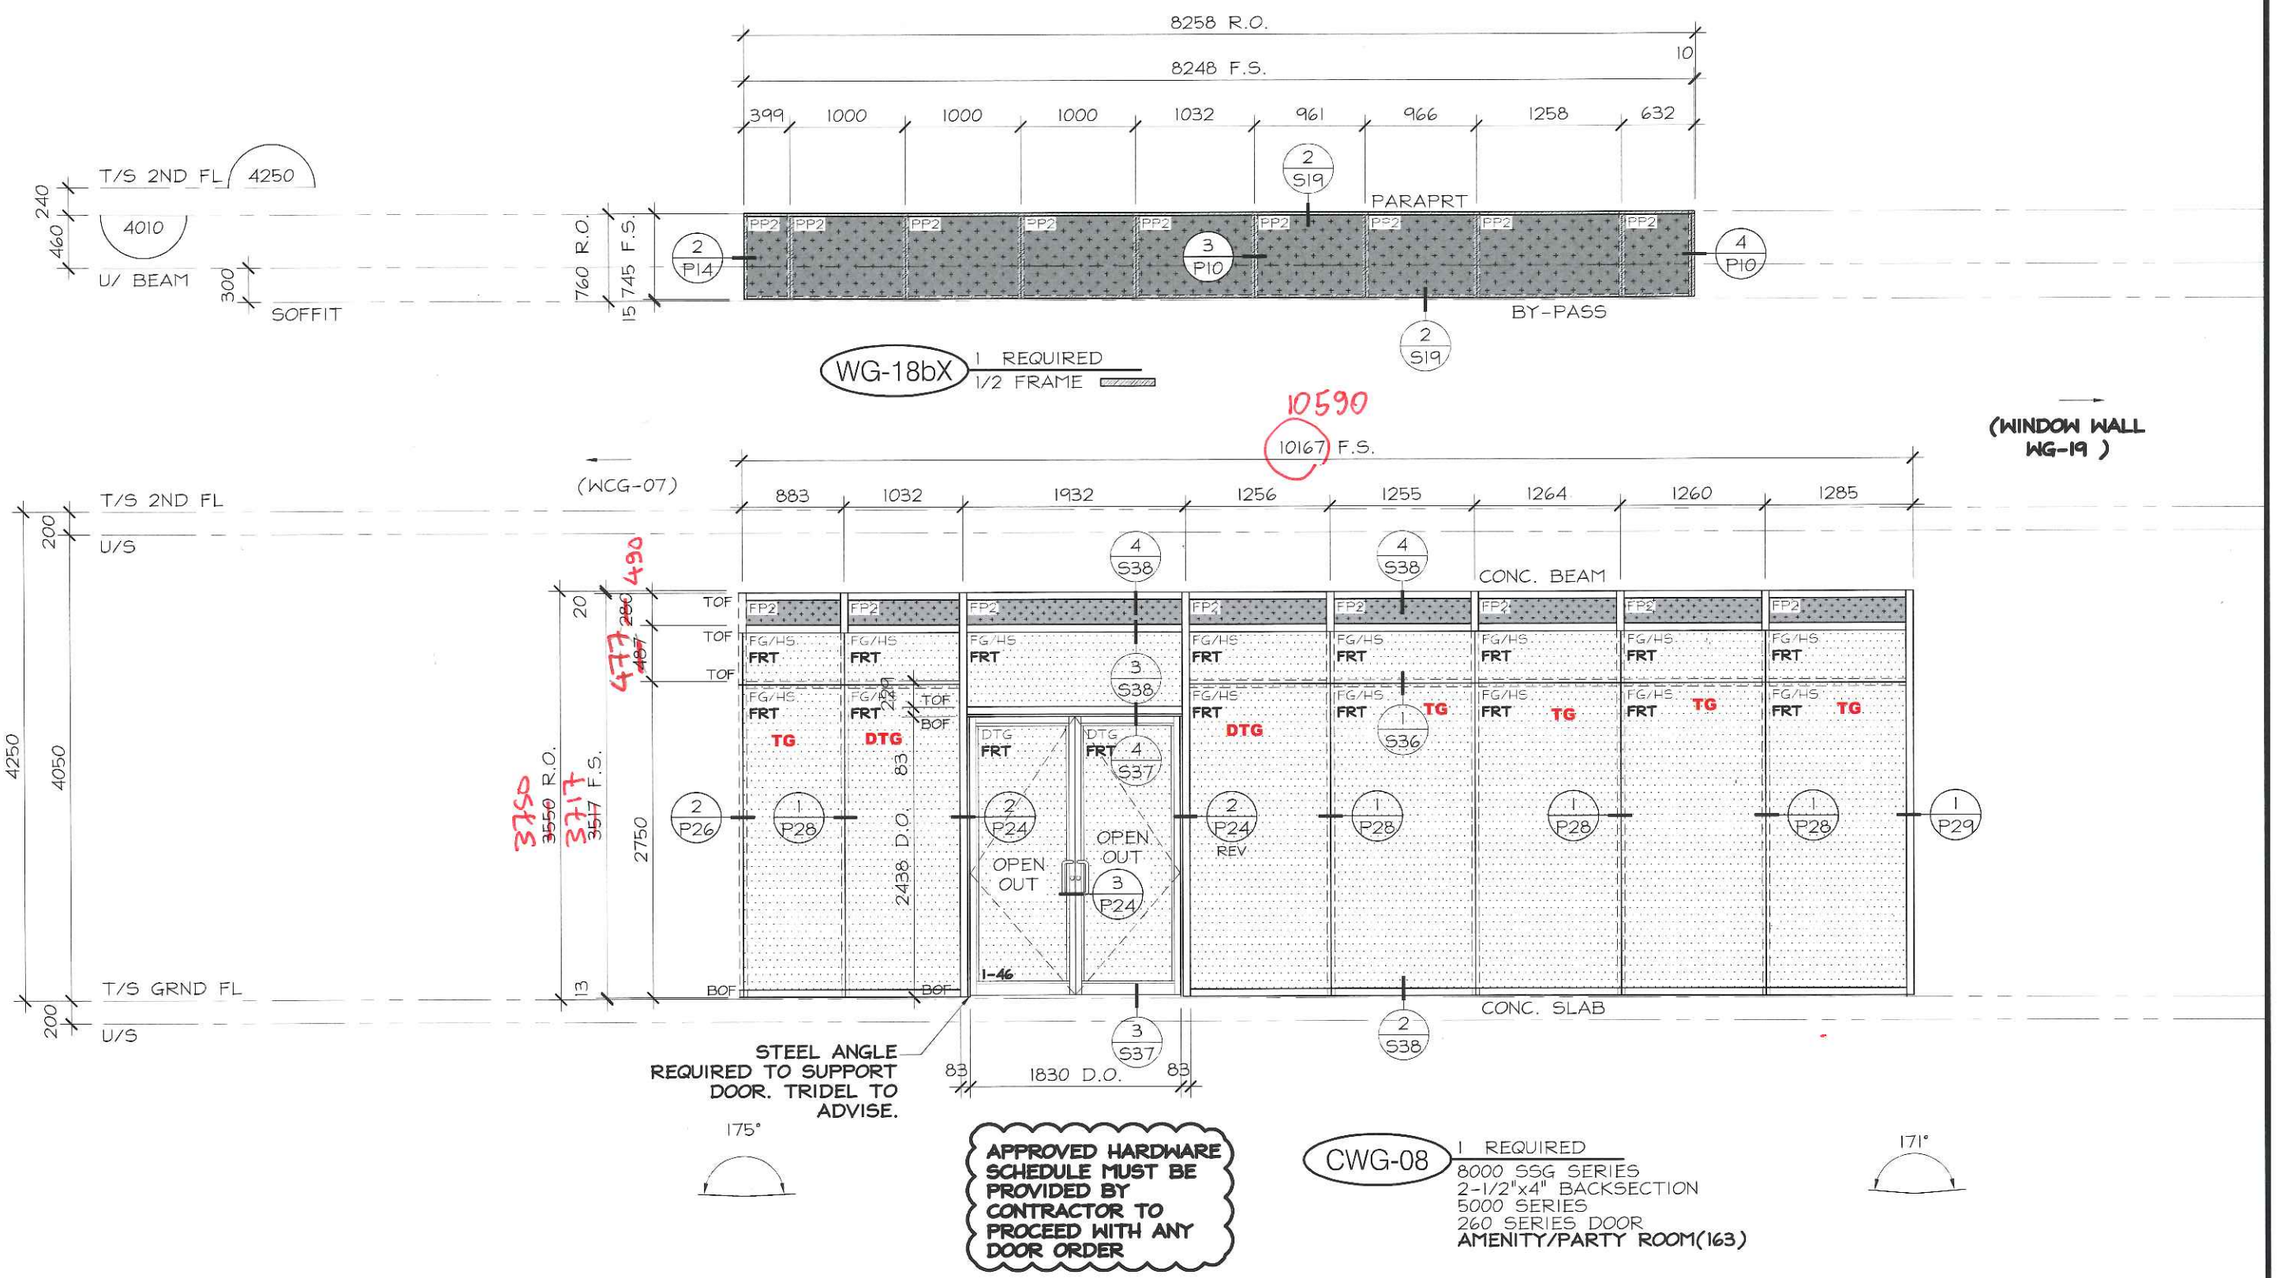


TORO ALUMINUM
COMMERCIAL INDUSTRIAL RESIDENTIAL
330 APPLEWOOD CRESCENT
CONCORD, ON, CANADA
L4K 4V2
TEL: (905)738-5220
FAX: (905)738-5481
WWW.TOROALUMINUM.COM

LICENSED PROFESSIONAL ENGINEER
06-27-15
D.T. PROHASKA
PROVINCE OF ONTARIO

No.	REVISION	BY	DATE

PROJECT NAME:	SQ ALEXANDRA PARK - BLOCK11
DRAWING TITLE:	GROUND FLOOR ELEVATIONS
ARCHITECT:	TEEPLE ARCHITECTS
CONTRACTOR:	TRIDEL
SCALE:	1:50
DRAWN BY:	S.C.
DATE:	MARCH 4, 2015
DRAWING No.:	EG-29

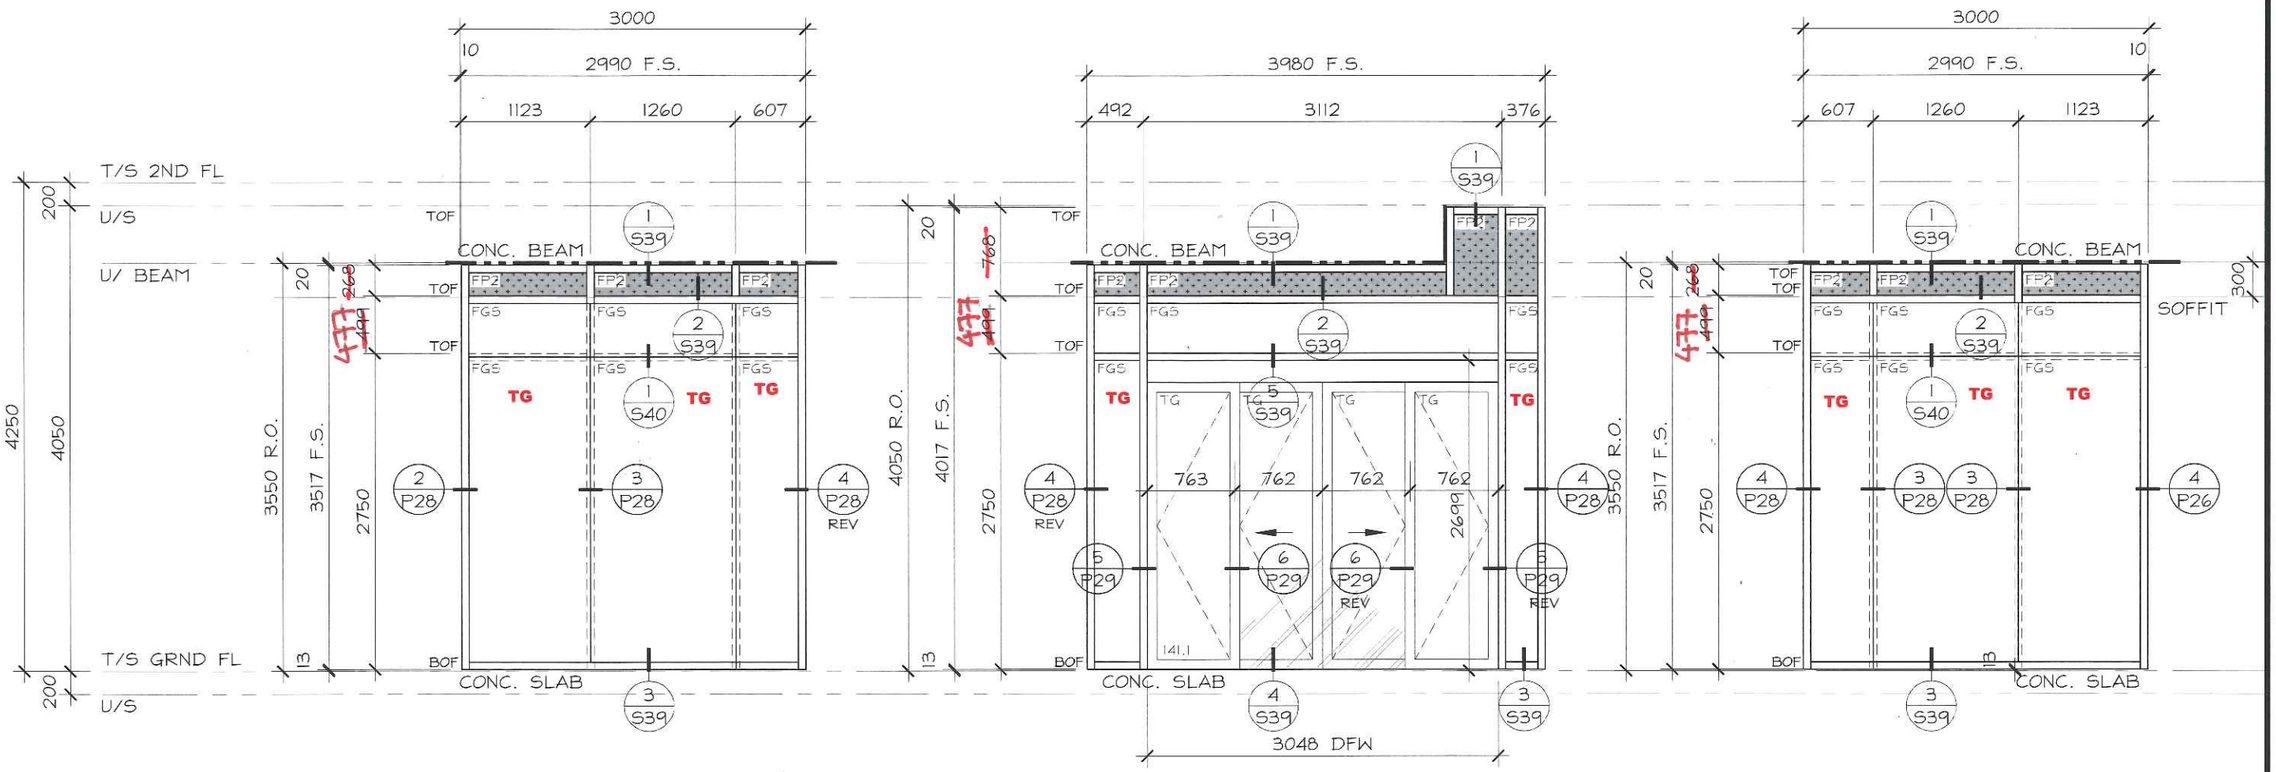

SG-01 — 1 REQUIRED
8000 SERIES
2-1/2"x4" BACKSECTION
EAST VESTIBULE(141)

SG-02 — 1 REQUIRED
8000 SERIES
2-1/2"x4" BACKSECTION
BI-PARTING DOOR
EAST VESTIBULE(141)

APPROVED HARDWARE SCHEDULE MUST BE PROVIDED BY CONTRACTOR TO PROCEED WITH ANY DOOR ORDER


SG-03 — 1 REQUIRED
8000 SERIES
2-1/2"x4" BACKSECTION
EAST VESTIBULE(141)

TORO ALUMINUM
COMMERCIAL INDUSTRIAL RESIDENTIAL
330 APPLEWOOD CRESCENT
CONCORD, ON, CANADA
L4K 4V2
TEL:(905)738-5220
FAX:(905)738-5481
WWW.TOROALUMINUM.COM

LICENSED PROFESSIONAL ENGINEER
06-27-15
D.T. PROHASKA
37549011
PROVINCE OF ONTARIO

No.	REVISION	BY	DATE

PROJECT NAME: SQ ALEXANDRA PARK - BLOCK11
DRAWING TITLE: GROUND FLOOR ELEVATIONS
ARCHITECT: TEEPLE ARCHITECTS
CONTRACTOR: TRIDEL
SCALE: 1:50
DRAWN BY: S.C.
DATE: MARCH 4, 2015
DRAWING No.: EG-30

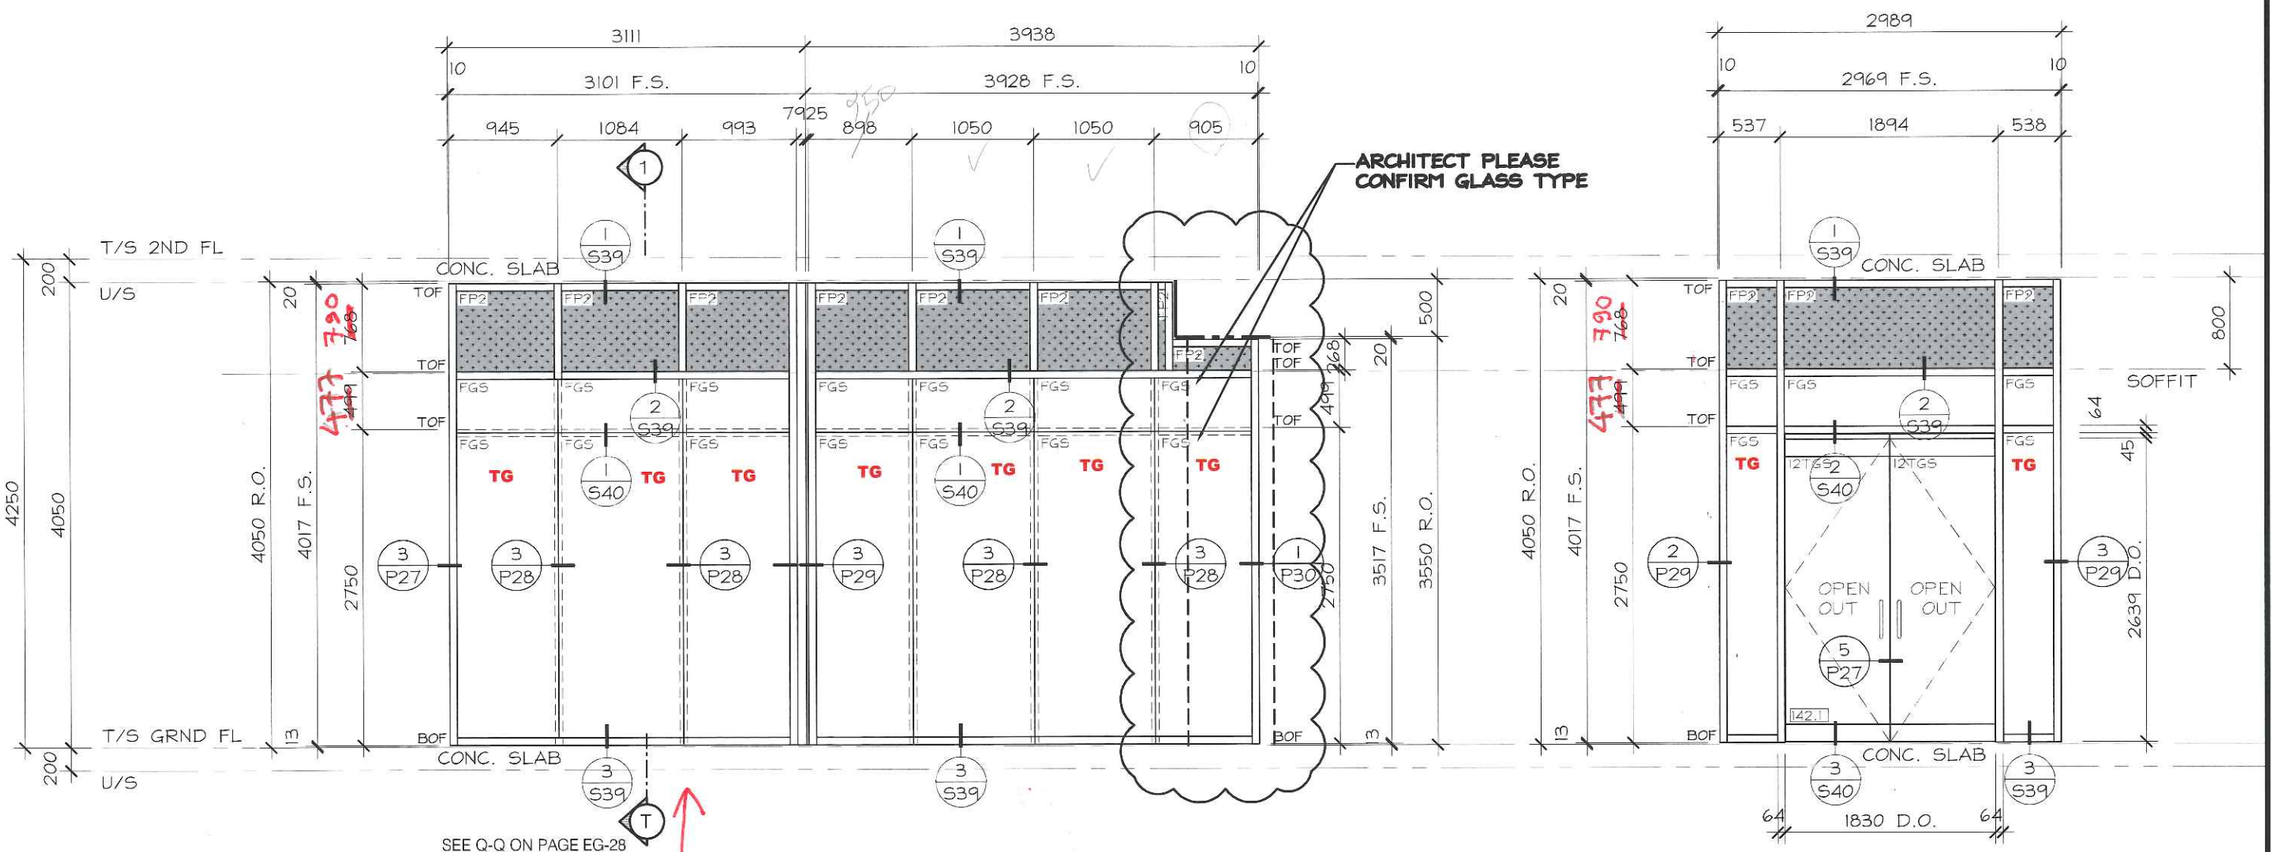

SG-04 — 1 REQUIRED
8000 SERIES
2-1/2"x4" BACKSECTION
AMENITY/PARTY ROOM(163)

APPROVED HARDWARE SCHEDULE MUST BE PROVIDED BY CONTRACTOR TO PROCEED WITH ANY DOOR ORDER

SG-05 — 1 REQUIRED
8000 SERIES
2-1/2"x4" BACKSECTION
FRAMELESS DOOR
EAST VESTIBULE(142)


TORO ALUMINUM
COMMERCIAL INDUSTRIAL RESIDENTIAL
330 APPLEWOOD CRESCENT
CONCORD, ON, CANADA
L4K 4V2
TEL: (905)738-5220
FAX: (905)738-5481
WWW.TOROALUMINUM.COM


LICENSED PROFESSIONAL ENGINEER
06-27-15
D.T. PROHASKA
3754901
PROVINCE OF ONTARIO


No.	REVISION	BY	DATE


PROJECT NAME: SQ ALEXANDRA PARK - BLOCK11
DRAWING TITLE: GROUND FLOOR ELEVATIONS
ARCHITECT: TEEPLE ARCHITECTS
CONTRACTOR: TRIDEL
SCALE: 1:50
DRAWN BY: S.C.
DATE: MARCH 4, 2015
DRAWING No.: EG-31

INTERIOR WINDOWS REF. THE INTERIOR DESIGN DRAWINGS FOR HEIGHT AND WIDTHS. DOOR HEIGHT & WIDTH REF. TO ARCHITECTURAL DRAWING A1001 DOOR SCHEDULE

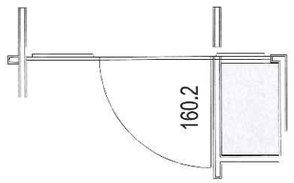

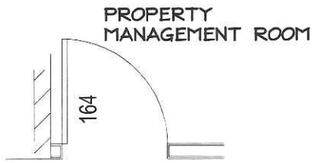

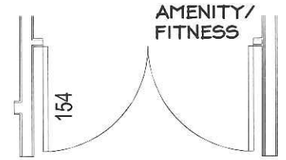

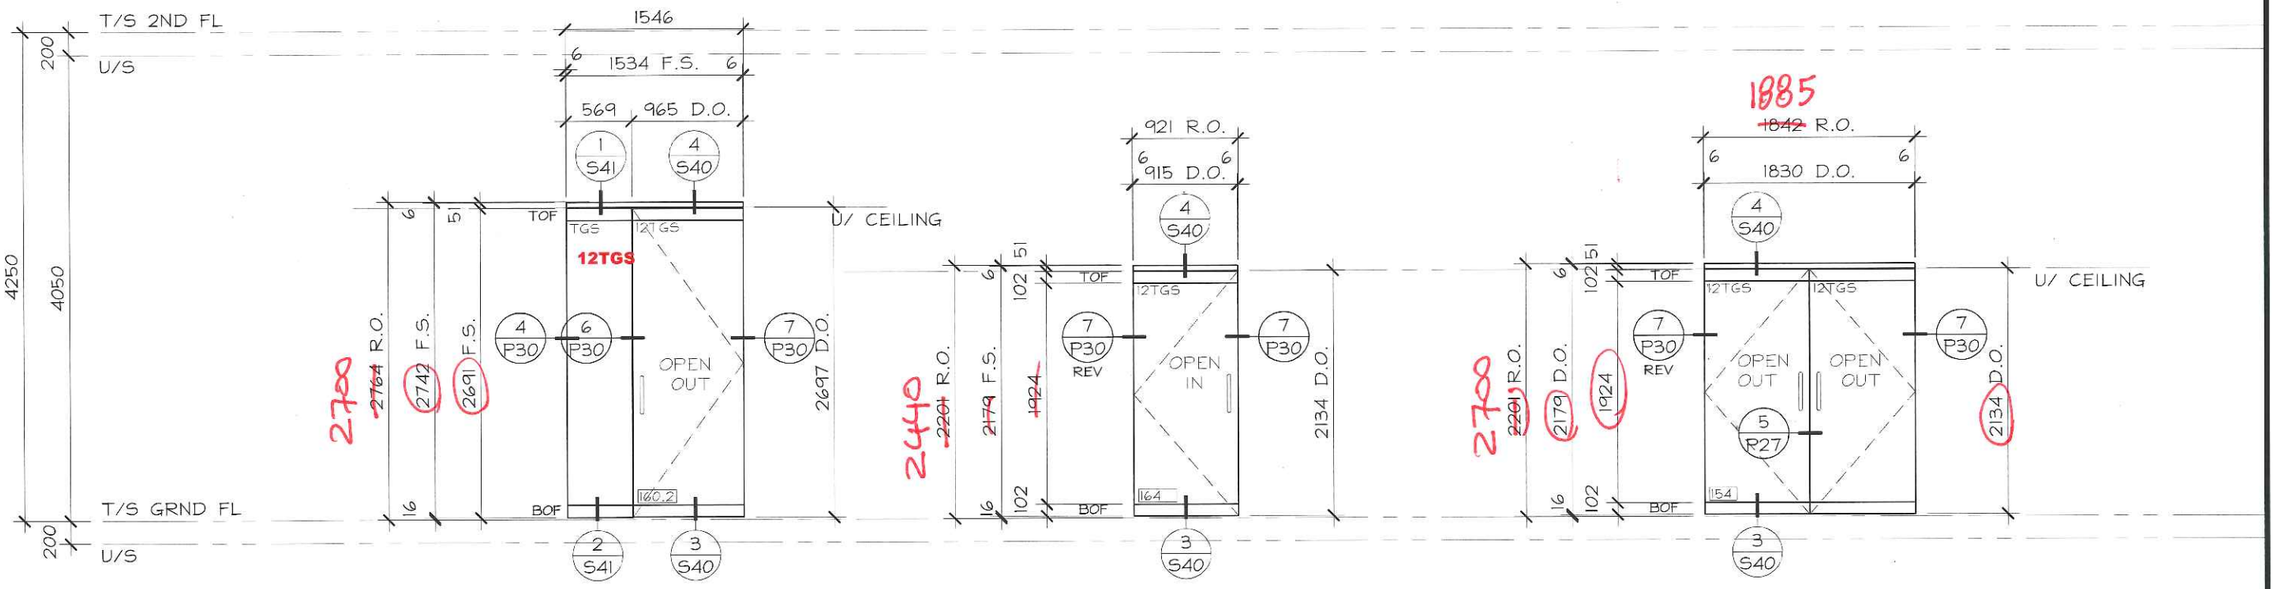

SG-06 — 1 REQUIRED
FRAMELESS
12mm GLASS TEMPERED
FRAMELESS DOOR
AMENITY/PARTY ROOM(163)

SG-07 — 1 REQUIRED
FRAMELESS
12mm GLASS TEMPERED
FRAMELESS DOOR
PROPERTY MANAGEMENT ROOM(164)

SG-08 — 1 REQUIRED
FRAMELESS
12mm GLASS TEMPERED
FRAMELESS DOOR
~~PROPERTY MANAGEMENT ROOM(164)~~
CORRIDOR D (154)


TORO ALUMINUM
COMMERCIAL INDUSTRIAL RESIDENTIAL
330 APPLEWOOD CRESCENT
CONCORD, ON, CANADA
L4K 4V2
TEL: (905)738-5220
FAX: (905)738-5481
WWW.TOROALUMINUM.COM

LICENSED PROFESSIONAL ENGINEER
06-27-15
D.T. PROHASKA
3754901
PROVINCE OF ONTARIO


No.	REVISION	BY	DATE

PROJECT NAME: SQ ALEXANDRA PARK - BLOCK11
DRAWING TITLE: GROUND FLOOR ELEVATIONS
ARCHITECT: TEEPLE ARCHITECTS
CONTRACTOR: TRIDEL
SCALE: 1:50
DRAWN BY: S.C.
DATE: MARCH 4, 2015
DRAWING No.: EG-32

WHIRLPOOL SPA

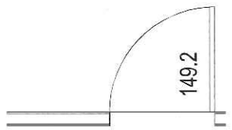

INTERIOR WINDOWS REF. THE INTERIOR DESIGN DRAWINGS FOR HEIGHT AND WIDTHS. DOOR HEIGHT & WIDTH REF. TO ARCHITECTURAL DRAWING A1001 DOOR SCHEDULE

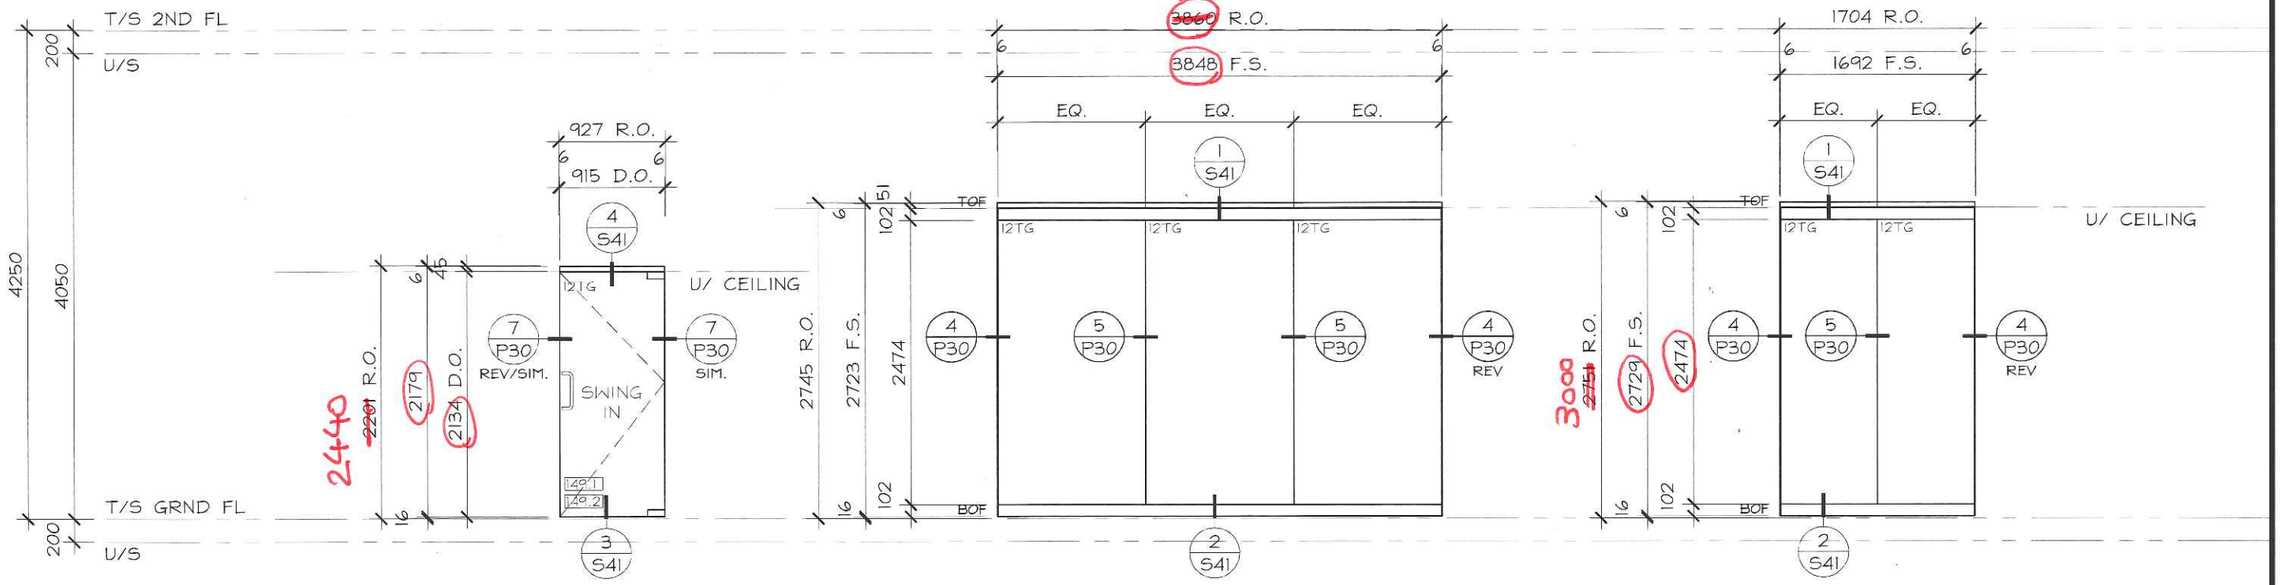

SEE PLAN ON PAGE EG-21

SG-09 1 REQUIRED
FRAMELESS
INTERIOR LOCATION
12mm GLASS TEMPERED
WHIRLPOOL SPA

SG-09R 1 REQUIRED
FRAMELESS
INTERIOR LOCATION
12mm GLASS TEMPERED
WHIRLPOOL SPA

SG-10 1 REQUIRED
FRAMELESS
EXTERIOR LOCATION
12mm GLASS TEMPERED

SG-11 1 REQUIRED
FRAMELESS
EXTERIOR LOCATION
12mm GLASS TEMPERED

TORO ALUMINUM
COMMERCIAL INDUSTRIAL RESIDENTIAL
330 APPLEWOOD CRESCENT
CONCORD, ON, CANADA
L4K 4V2
TEL: (905)738-5220
FAX: (905)738-5481
WWW.TOROALUMINUM.COM

LICENSED PROFESSIONAL ENGINEER
06-27-15
D.T. PROHASKA
3754901
PROVINCE OF ONTARIO

No.	REVISION	BY	DATE

PROJECT NAME: SQ ALEXANDRA PARK - BLOCK11
DRAWING TITLE: GROUND FLOOR ELEVATIONS
ARCHITECT: TEEPLE ARCHITECTS
CONTRACTOR: TRIDEL
SCALE: 1:50 | DRAWN BY: S.C. | DATE: MARCH 4, 2015
DRAWING No.: EG-33