


R RIGGING SLEEVE MODEL ARS-10-1

1 WC2.03 DETAIL Scale 1:8

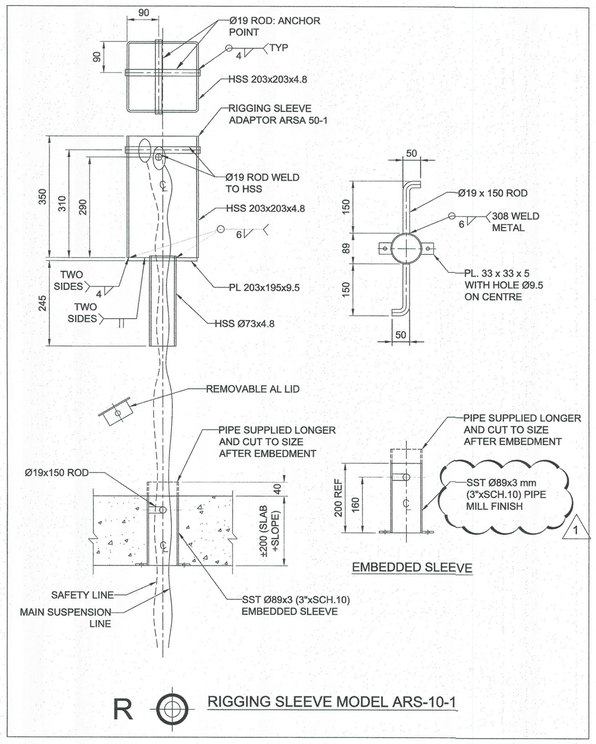


DAVIT D27.5

SCALE: 1:20

DAVIT D27.5 WITH DAVIT BASE D27.5-TB1

SCALE: 1:20 R0

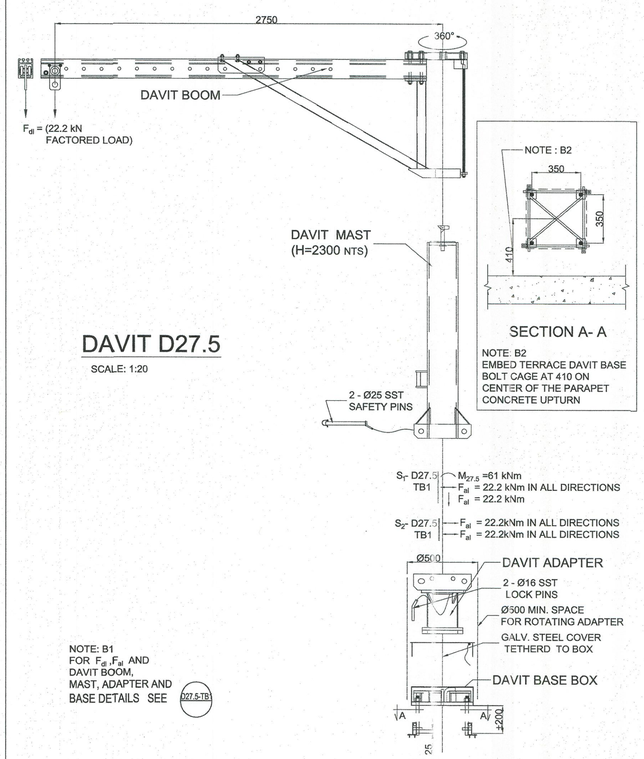


D D27.5-TB DAVIT D27.5 WITH DAVIT BASE D27.5-TB1

SCALE: 1:20 DAVIT BOOM, MAST,BASE AND ADAPTOR DETAILS R0

3 WC2.03 DETAIL Scale 1:20

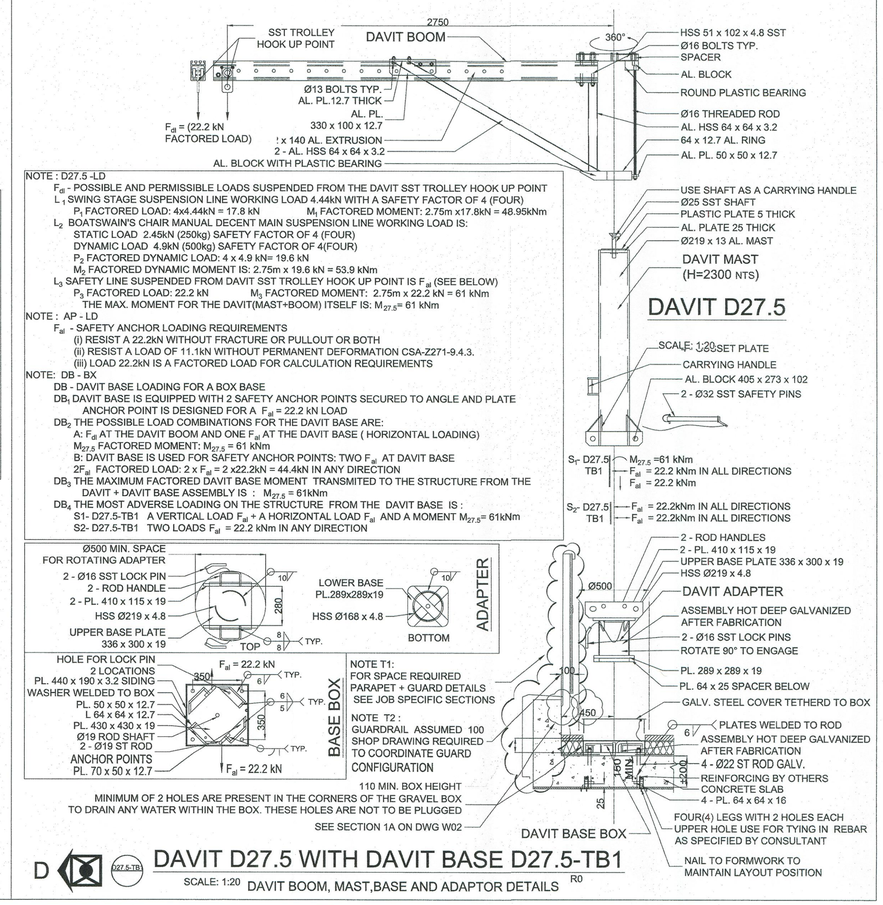


D D27.5-TB DAVIT BASE D27.5-TB1 @ TERRACE

4 WC2.03 SECTION Scale 1:8




R RIGGING SLEEVE MODEL ARS-10-1 @ BALCONY

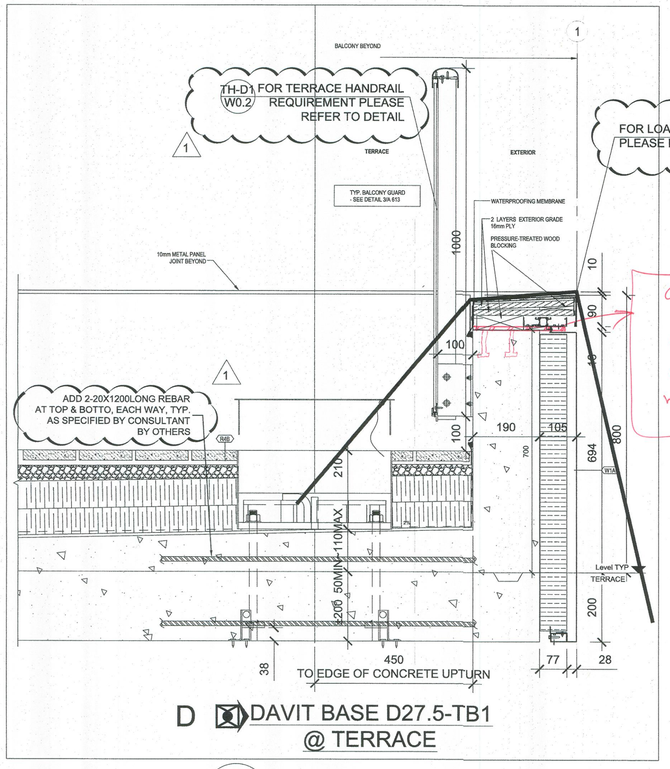2 WC2.03 SECTION Scale 1:8

| NO. | DATE | REVISIONS | BY |
|---|---|---|---|
| 1 | OCT 20/2015 | UPDATED AS PER REVIEW COMMENTS ON 2015-07-02 | H.L. |
| 0 | JAN 12/2015 | SHOP DWGS ISSUED | H.L. |

UNITS ARE IN MM UNLESS OTHERWISE NOTED

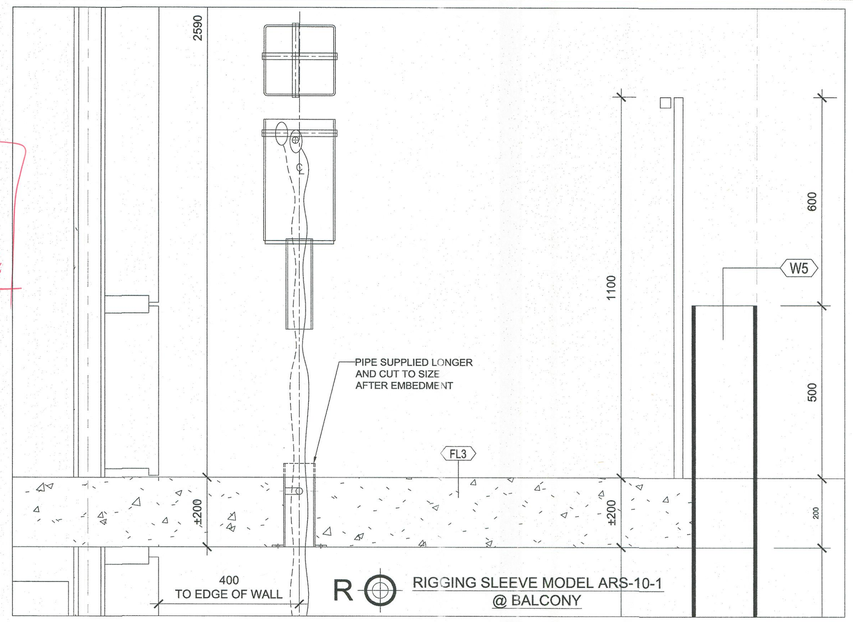N

LICENSED PROFESSIONAL ENGINEER J.J. BUDZIAK OCT 27 2015 PROVINCE OF ONTARIO

DRAWING REVIEW

The review of this drawing does not in any way relieve the contractor of responsibility for its accuracy or for compliance with the contract documents.

| | | | |
|---|---|---|---|
| | No Comment | ✓ | See Comment |
| | Amend & Resubmit | | Rejected See Remarks |

Submission No.
Project No. 13015
By HP
Date May 27, 2015
JABLONSKY ASH & PARTNERS Consulting Engineers 1129 Leslie St. Don Mills ON M3C 2K5


ANKOR ENGINEERING SYSTEMS LTD.
BUILDING FACADE & SAFETY SYSTEMS ENGINEERING, MANUFACTURING, & INSTALLATION
ADDRESS: 32 PENN DRIVE, TORONTO ON, M9L 2A9
TELEPHONE: (416) 740-5781
FAX: (416) 740-5850
EMAIL: ANKORENG@ANKOR.CA
WEB: WWW.ANKOR.CA


| | |
|---|---|
| TITLE: | SECTIONS AND DETAILS |
| PROJECT: | SQ ALEXANDRA PARK - BLOCK 11<br>38 CAMERON ST., TORONTO, ON. |
| CLIENT: | TRIDEL |

| | | | |
|---|---|---|---|
| SCALE: | AS SHOWN | DATE: | JAN 12/2015 |
| DRAWN: | H.L. | CHECKED: | J.B. |
| JOB No.: | J14096 | DWG No.: | WC2.03 |