


SECTION 1  
SCALE 1:20  
S-301

SECTION 2  
SCALE 1:20  
S-301

SECTION 3  
SCALE 1:20  
S-301

SECTION 4  
SCALE 1:20  
S-301

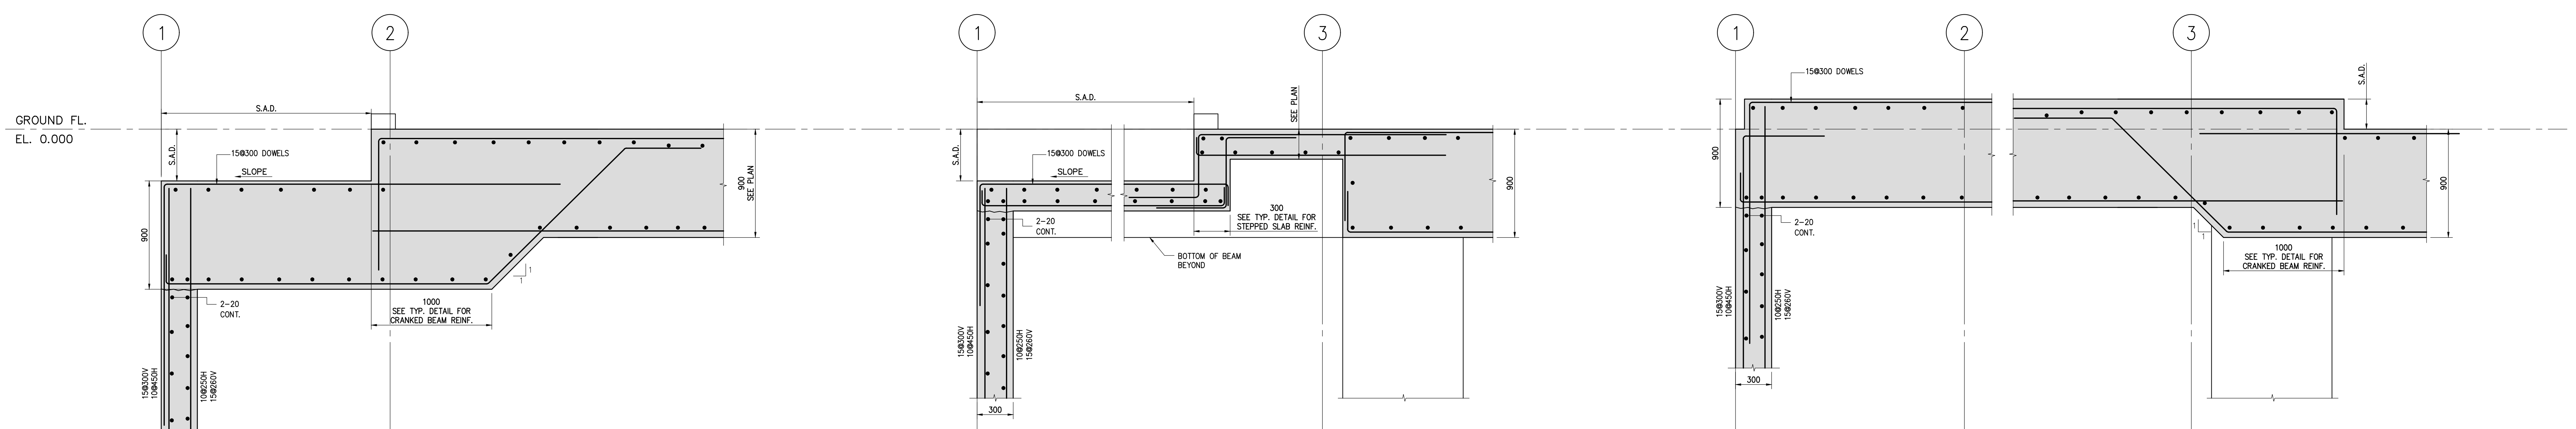

SECTION 5  
SCALE 1:20  
S-301

SECTION 6  
SCALE 1:20  
S-301

SECTION 7  
SCALE 1:20  
S-301

Jablonsky, Ast  
and Partners  
CONSULTING  
ENGINEERS  
1128 LESLIE STREET  
DON MILLS, ON, M3C 2K5  
TEL: 416-447-7400  
FAX: 416-447-2771  
E-mail: jsp@ast.on.ca



FIRST FLOOR ELEV. 93.60m

NO.	ISSUED / REVISED	DATE
1	ISSUED FOR PERMIT	2014-05-03
2	RE ISSUED FOR PERMIT	2014-07-01
3	ISSUED FOR FORMING TRENCH	2014-08-27
4	CONSTRUCTION REVIEW	2015-01-23
5	RE ISSUED FOR PERMIT	2015-01-27
6	ISSUED FOR CONSTRUCTION	2015-03-11
7	UPDATED - IFC	2015-04-03
8	UPDATED - IFC	2015-05-21
9	ISSUED FOR B.P.	2015-07-03
11	ISSUED FOR B.I.I	2015-11-04

ALEXANDRA PARK - BLOCK 11  
TORONTO, ONTARIO

project no: 13015  
scale: 1:25  
drawn by: H.W.  
reviewed by:  
date stamped: MARCH 2014

FOUNDATION SECTION